

CERTIFIED LAND CORNER RESTORATION

Index No. **H 17**

State of Wisconsin }
County of Forest } ss.


I William B. Cochrane, do hereby certify that on the 20 th day of August, 1977, I found evidence of the South Quarter corner of Section 23 Township 37 North, North, Range 12 East, Fourth Principal Meridian, as described hereon; and that from this evidence I established a new monument and accessories as described hereon to perpetuate the original location of this corner.

Resident witnesses:

Miles H. Cochrane

Brian James

FORM 985 H. C. MILLER CO., MILWAUKEE

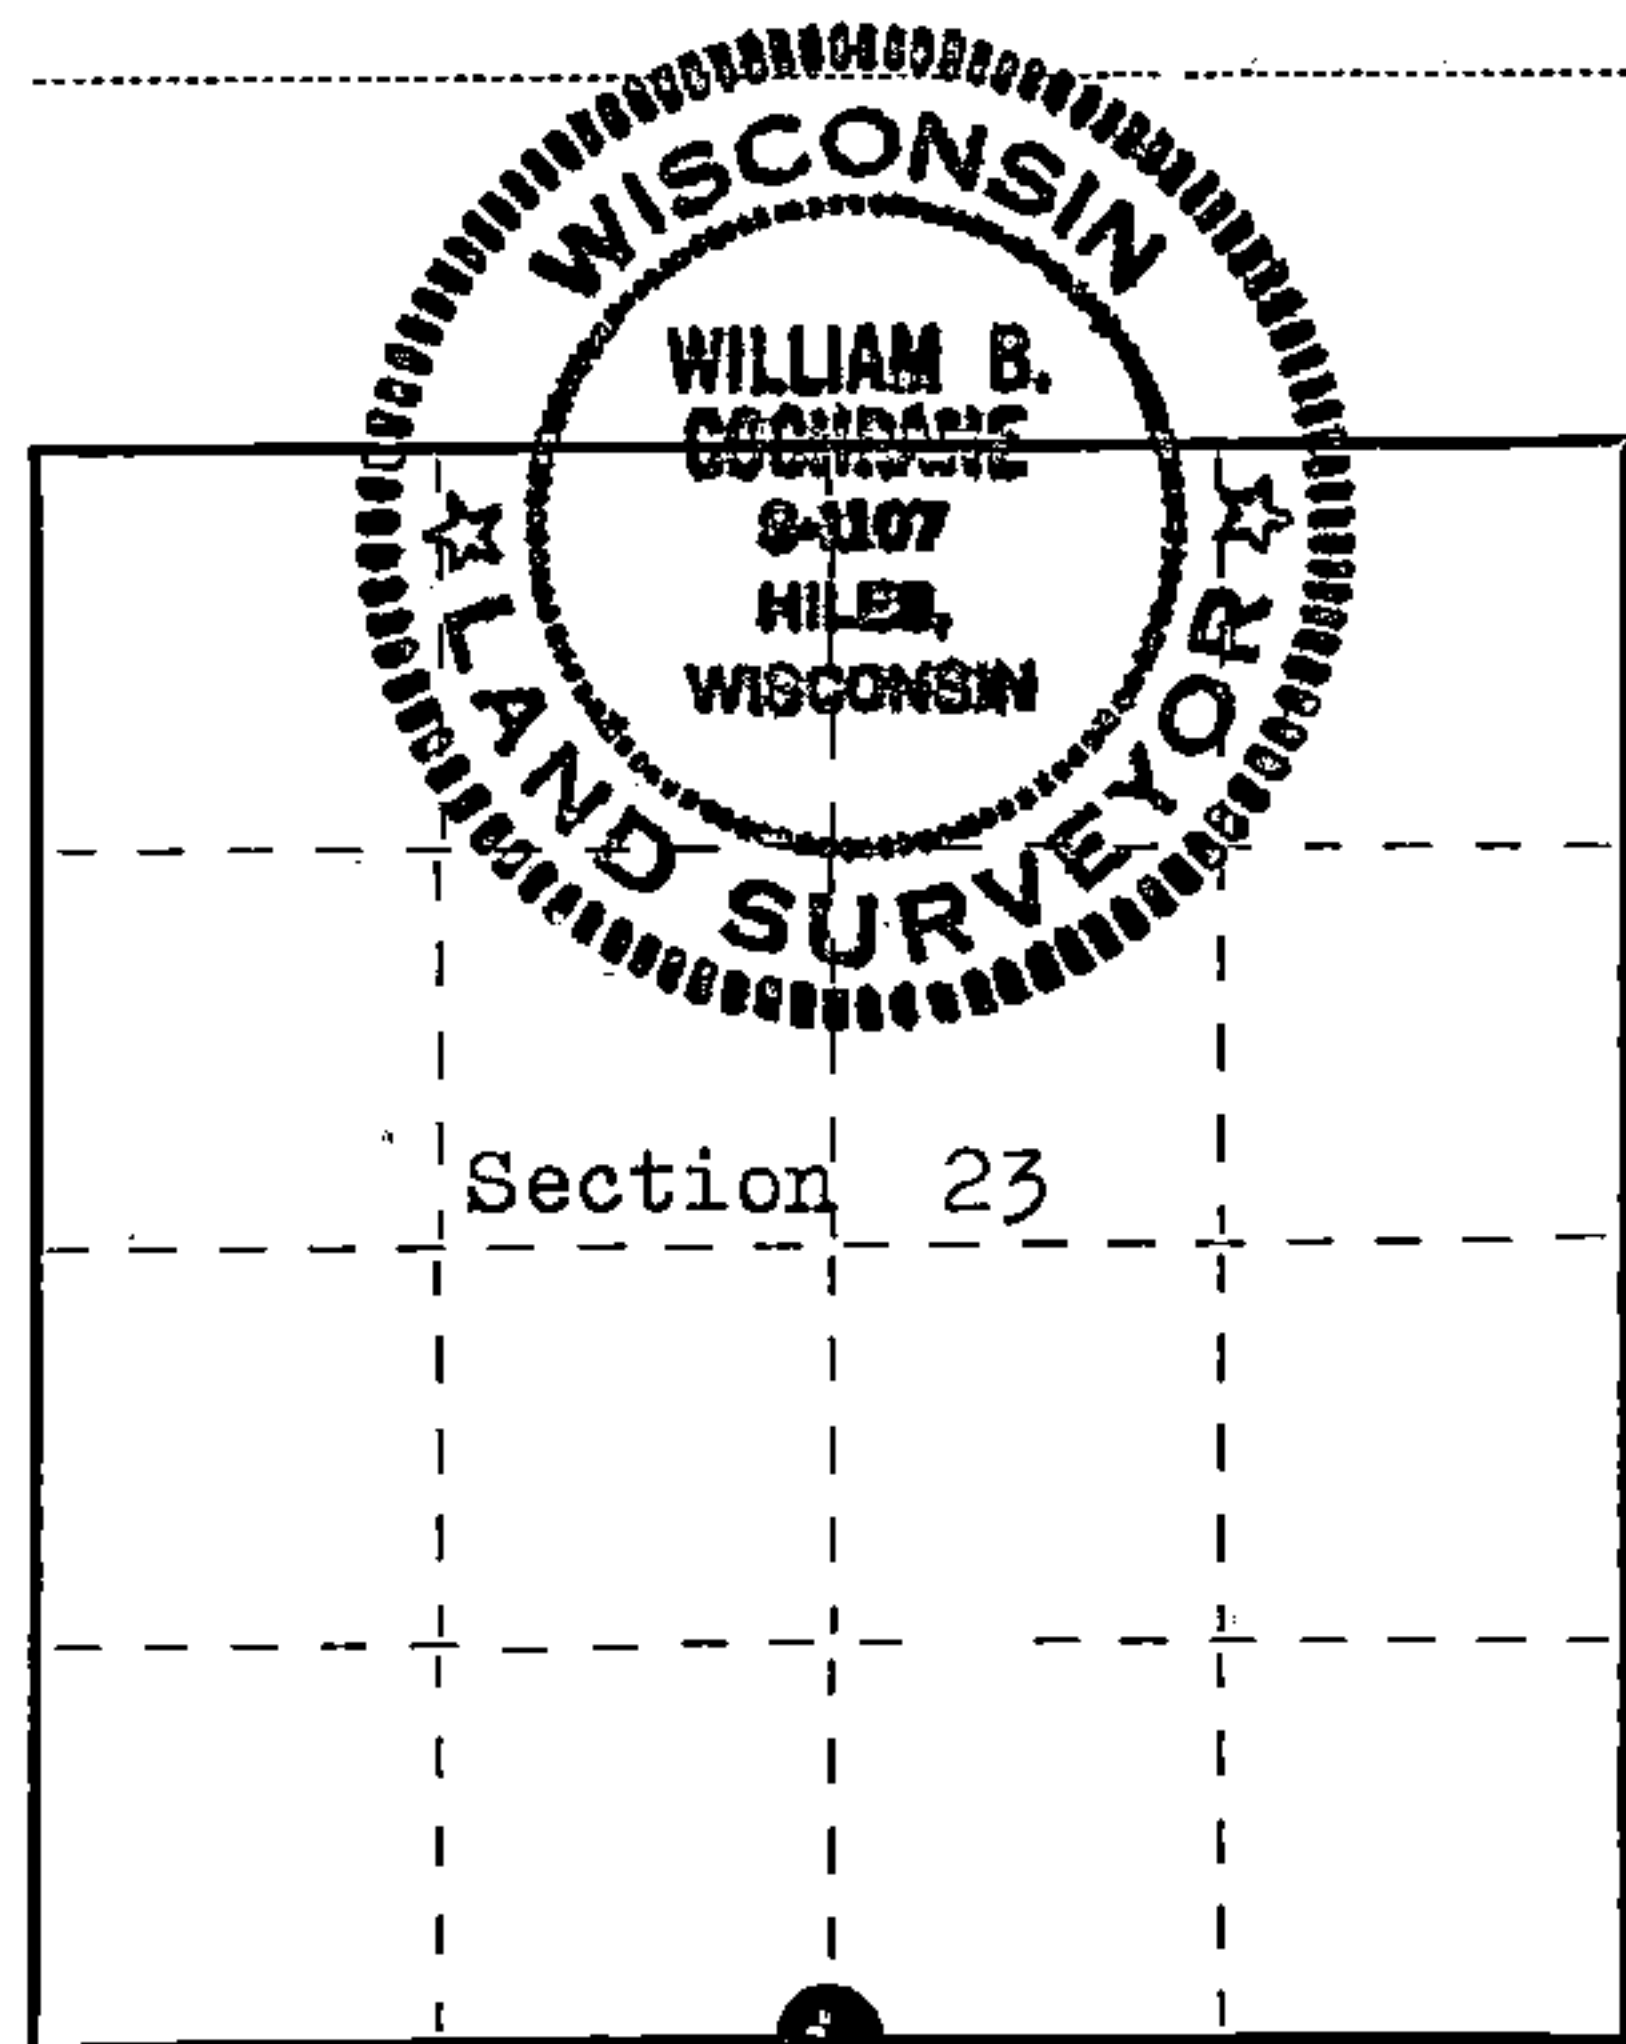

○ = Corner monument restored.

History of original corner establishment:

Surveyed in 1859 by Wm. E. Daugherty West Corrected between Sections 23 and 26. 40.00 chs. Set Quarter Section Post Hemlock, 12", N 82° W, 32 lks. Birch, 10", S 25° W, 23 lks.

Description of corner evidence found:

No original evidence of the corner was found. The corner area has been farmed and logged many times.

I set the position for the Quarter Corner at the midpoint on line between the Southeast and Southwest Sections Corners of Section 23.

Description of monument and accessories I established to perpetuate the original location of this corner.

At the corner position, I set a 2½" Berntsen, A-1 Federal Monument, 30 inches long, with cap stamped:

T37N R12E, ¼, S23, S26, 1977, S-1107

From which the following bear:

Maple, 6", N 75° W, 33.34 feet
Maple, 7", S 22° W, 27.93 feet

N 86° 15' 54" E, 2662.30 feet to the Southeast Section Corner of Section 23.

S 86° 15' 54" W, 2662.30 feet to the Southwest Section Corner.

Dated at Hiles, Wis., this 23 rd day of August, 1977.

Signature William B. Cochrane Title Land Surveyor Registration No. S-1107
(County Surveyor, Registered Land Surveyor, or other duly authorized official)

Office of Register of Deeds, County of FOREST, I hereby certify that the within instrument was filed in this office for record on the 24 th day of AUGUST, 1977 at 10:20 clock A. M.

Eugene Stutzman
(Register of Deeds)

DOCUMENT NUMBER **112189**

By _____ Deputy

43712230020