

CERTIFIED LAND CORNER RESTORATION


State of Wisconsin }
County of Forest } ss.

I Philip T. Hansen, do hereby certify that on the 8th day of October, 1975, I found evidence of the W-1/16 corner of Sections 6 and 31 Township 36 and 37 North, Range 12 East, Fourth Principal Meridian, as described hereon; and that from this evidence I established a new monument and accessories as described hereon to perpetuate the original location of this corner.


Resident witnesses:

Glen Barker

Jim Claflin

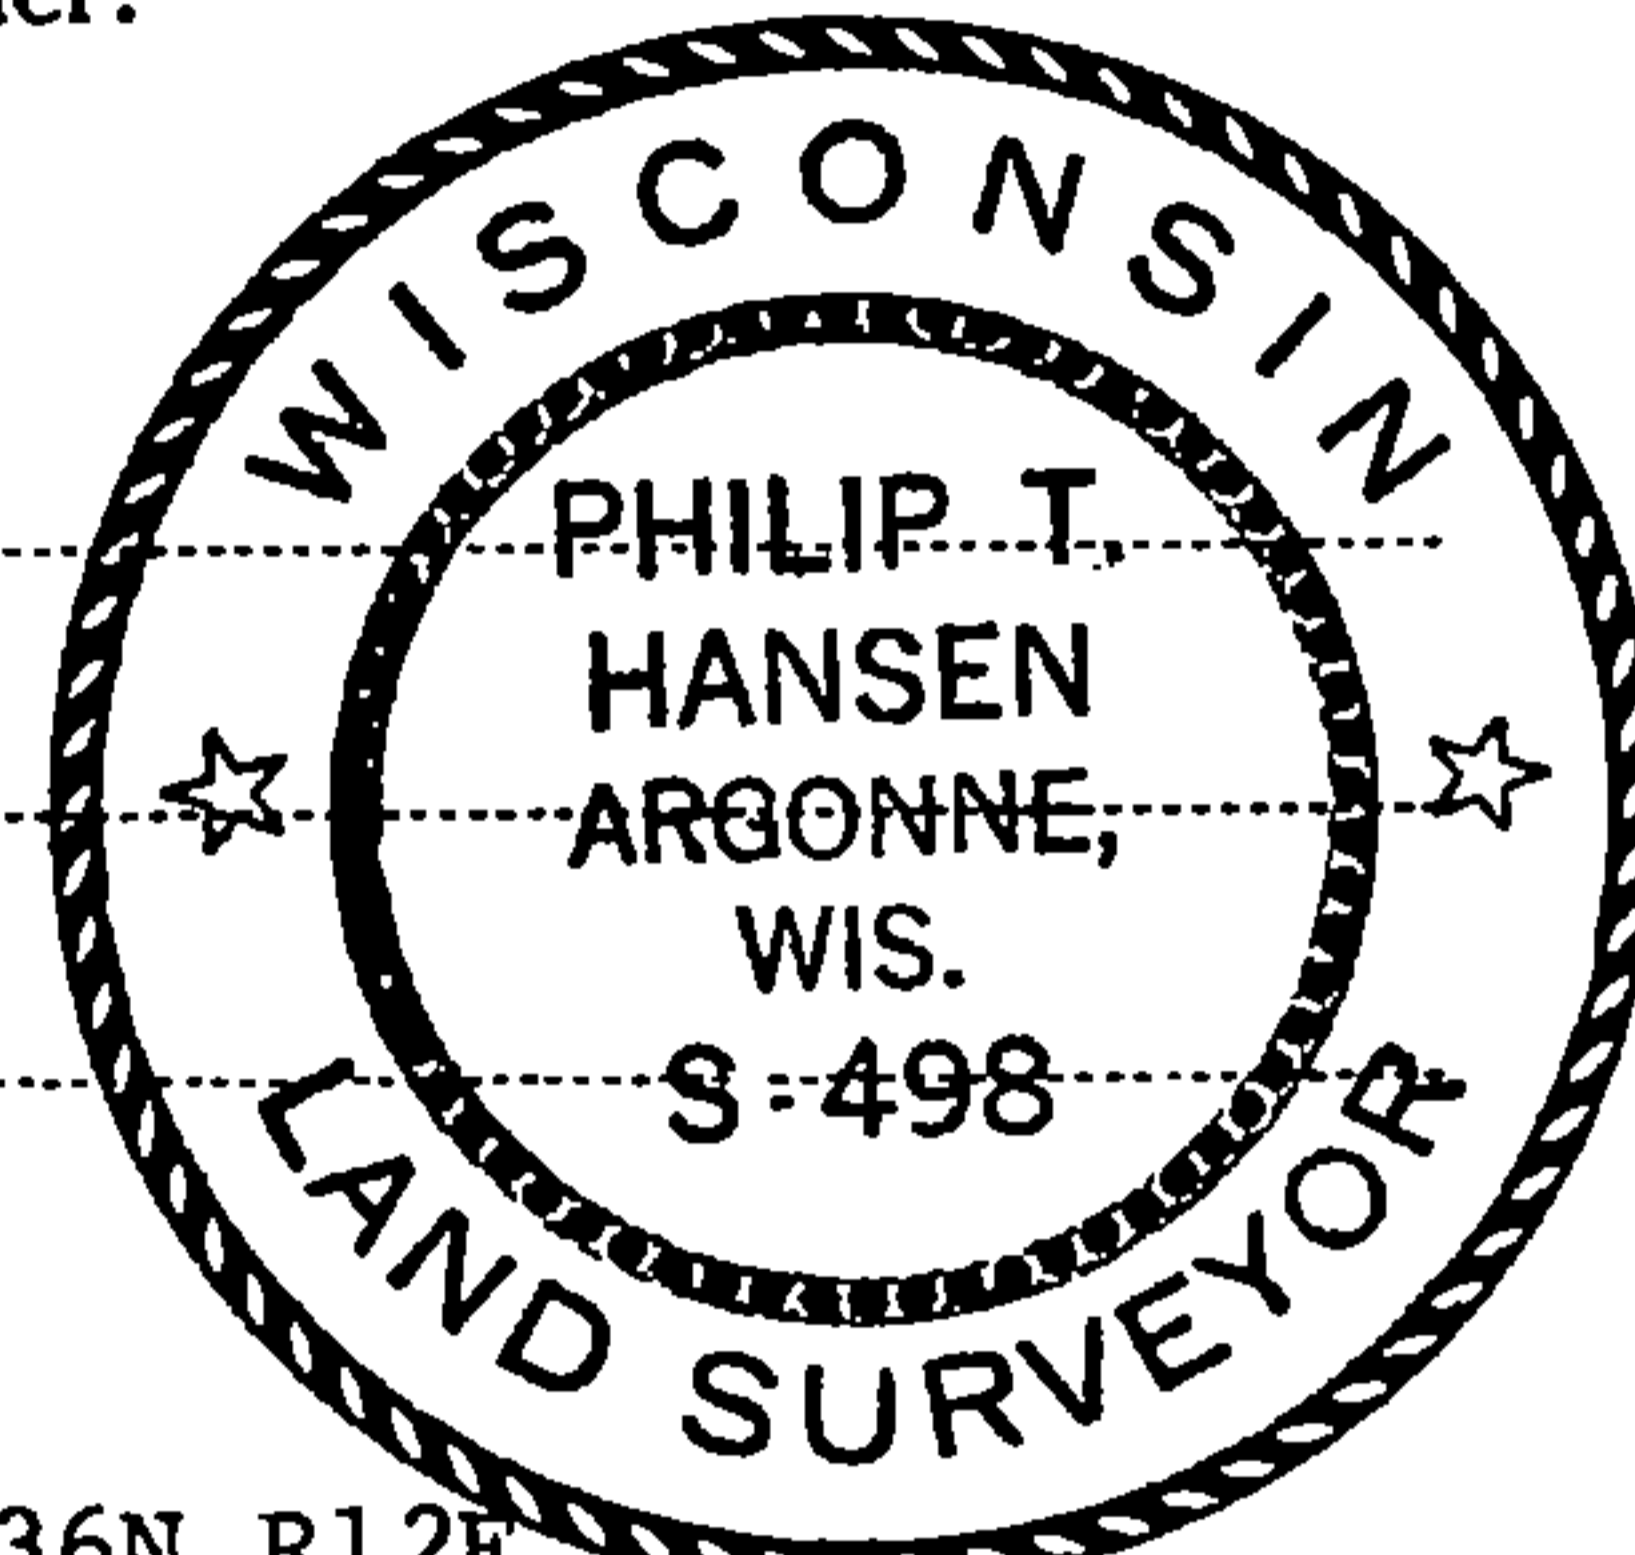

FORM 985 H. C. MILLER CO., MILWAUKEE

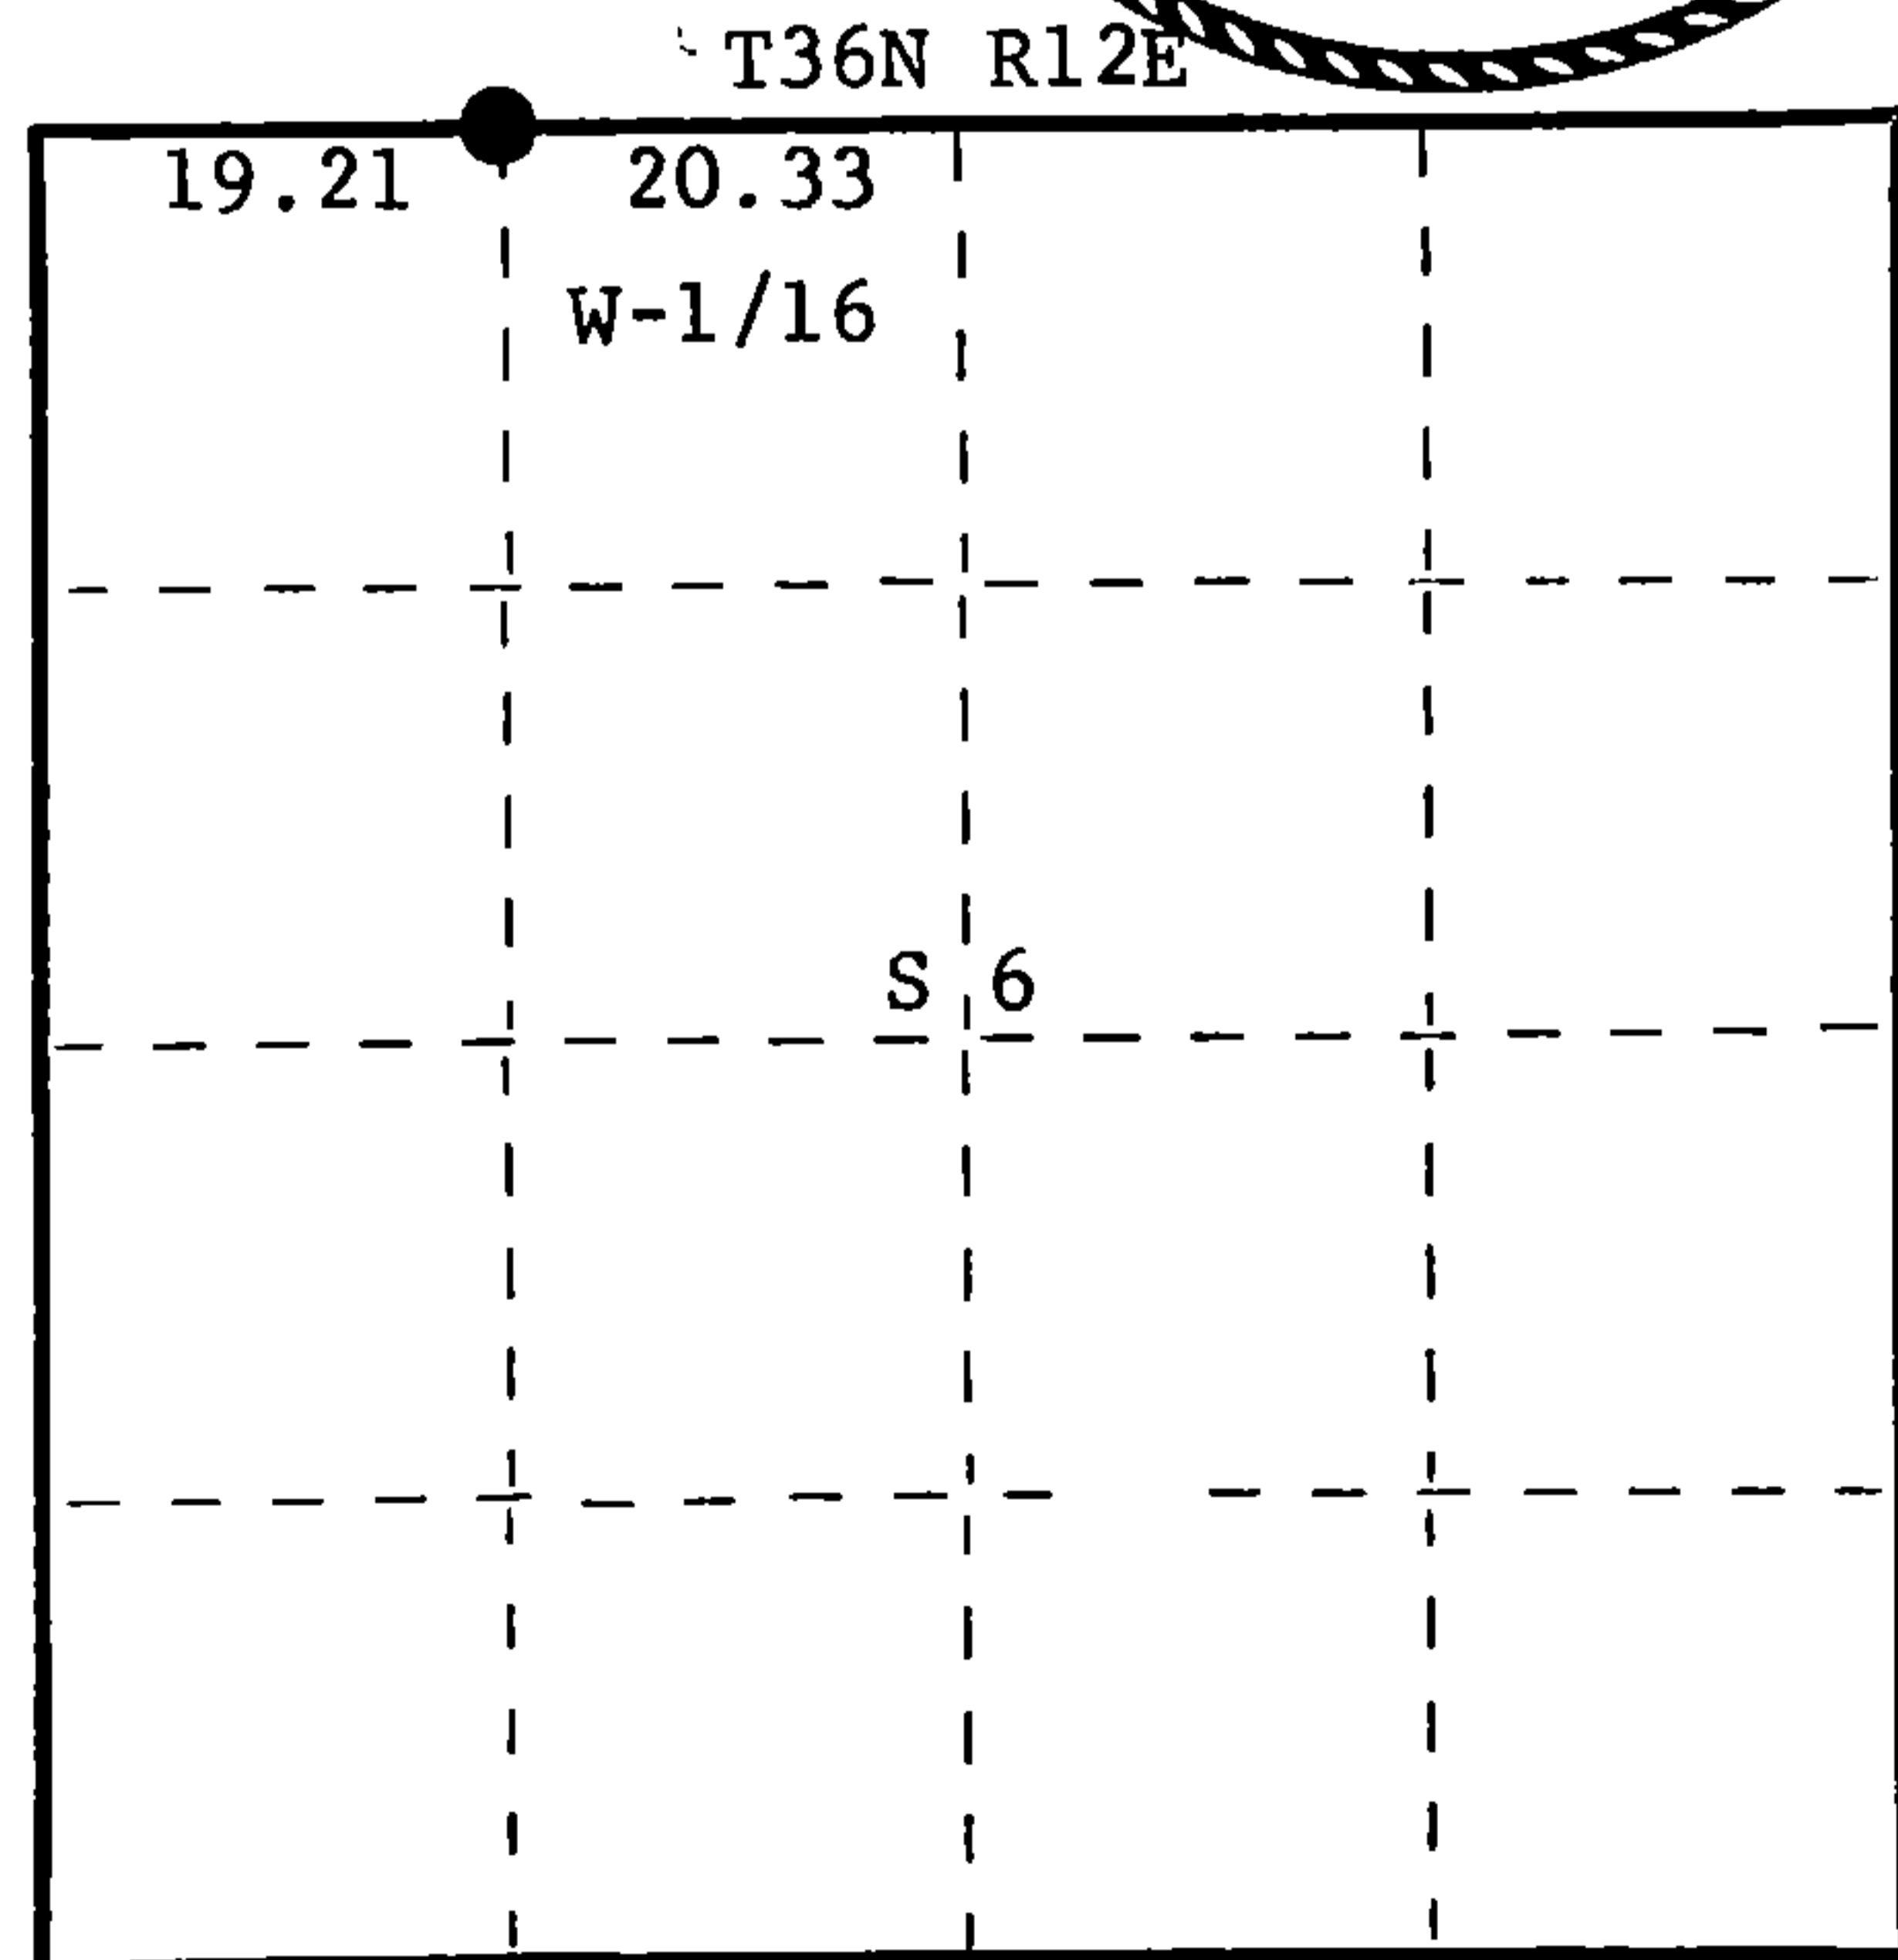

○ = Corner monument restored.

History of original corner establishment:

Corner established by H.C. Lawrence, Registered Land Surveyor, in 1956. From Section Corner at Township Corner, which he recovered in 1950, he ran east 39.54 chains to a point 1.43 chains north of established 1/4 corner. Set 5" hemlock post at 19.21 chains east of Town Corner and 69-1/2 links south from random line. Corrected bearing of line, N87°04'E. Set 5" hemlock post and marked elm 14", N34°W, 37 links and hemlock 18", S76°E, 29 links.

Description of corner evidence found:

Recovered 4" hemlock post, squared and scribed W-1/16 S6, W-1/16 S31 in fair condition.
Recovered OBT's: Elm 14" (15") N34°W (N31°W) 37 links - scribing grown over.
Hemlock 18" S76°W (S78°W) 29 links - scribed W-1/16 S6 BT.

Description of monument and accessories I established to perpetuate the original location of this corner.

Replaced 4" hemlock post with 1-1/2" OD iron pipe with 2" brass cap stamped - S498
Pipe projects 18" above ground. T37N R12E
NBT: Sugar 8" S9°E 17.2 links - scribed 1/16 BT.
Pipe and BT painted blue.

W-1/16 $\frac{S}{S}$ $\frac{31}{6}$
T36N
1975

Dated at Argonne, Wis., this 13th day of October, 1975.

Signature *Philip T. Hansen* Title Registered Land Surveyor Registration No. S-498
(County Surveyor, Registered Land Surveyor, or other duly authorized official)

Office of Register of Deeds, County of Forest, I hereby certify that the within instrument was filed in this office for record on the 16th day of October, 1975 at 2:30 o'clock P.M.

Eugene Stutzman
(Register of Deeds) DOCUMENT NUMBER **107984**

By _____ Deputy

43712310030