

U.S. PUBLIC LAND SURVEY MONUMENT RECORD

Index No. G-13

State of Wisconsin }
County of Forest } ss.

History of original corner establishment:
Original Government Survey in 1865 by J.L. Nowlin.

I, Gary L. Pisoni, do hereby certify that on the 15th day of March, 1993, I found evidence of the East Quarter corner of Section 9 Township 37, North, Range 13 East, Fourth Principal Meridian, as described hereon; and that from this evidence I established a new monument and accessories as described hereon to perpetuate the original location of this corner.

In 1984, Milo Stefan, a Land Surveyor with the U.S. Forest Service, found a squared stake and a blazed line to the South. In place of stake, he set a 2"x60" aluminum pipe monument stamped to identify the corner. Blazed and scribed the following bearing trees;

Cedar	10"	S83°E	37.45 feet
Cedar	12"	S49°W	42.70 feet
Cedar	10"	N72°W	35.94 feet
Steel Sign Post		South	1.60 feet

Description of corner evidence found:


Found monument as described and in place, from which the following bear;

Cedar (dead)		S83°E	37.45 feet
Cedar	14"	S47°W	42.76 feet
Cedar	12"	N70°W	35.94 feet
Steel Sign Post		South	1.60 feet

Resident witnesses:

Description of monument and accessories I established to perpetuate the original location of this corner.
Blazed and scribed the following new bearing tree;

Cedar	10"	S09°E	47.73 Feet
Steel Sign Post		West	1.47 feet

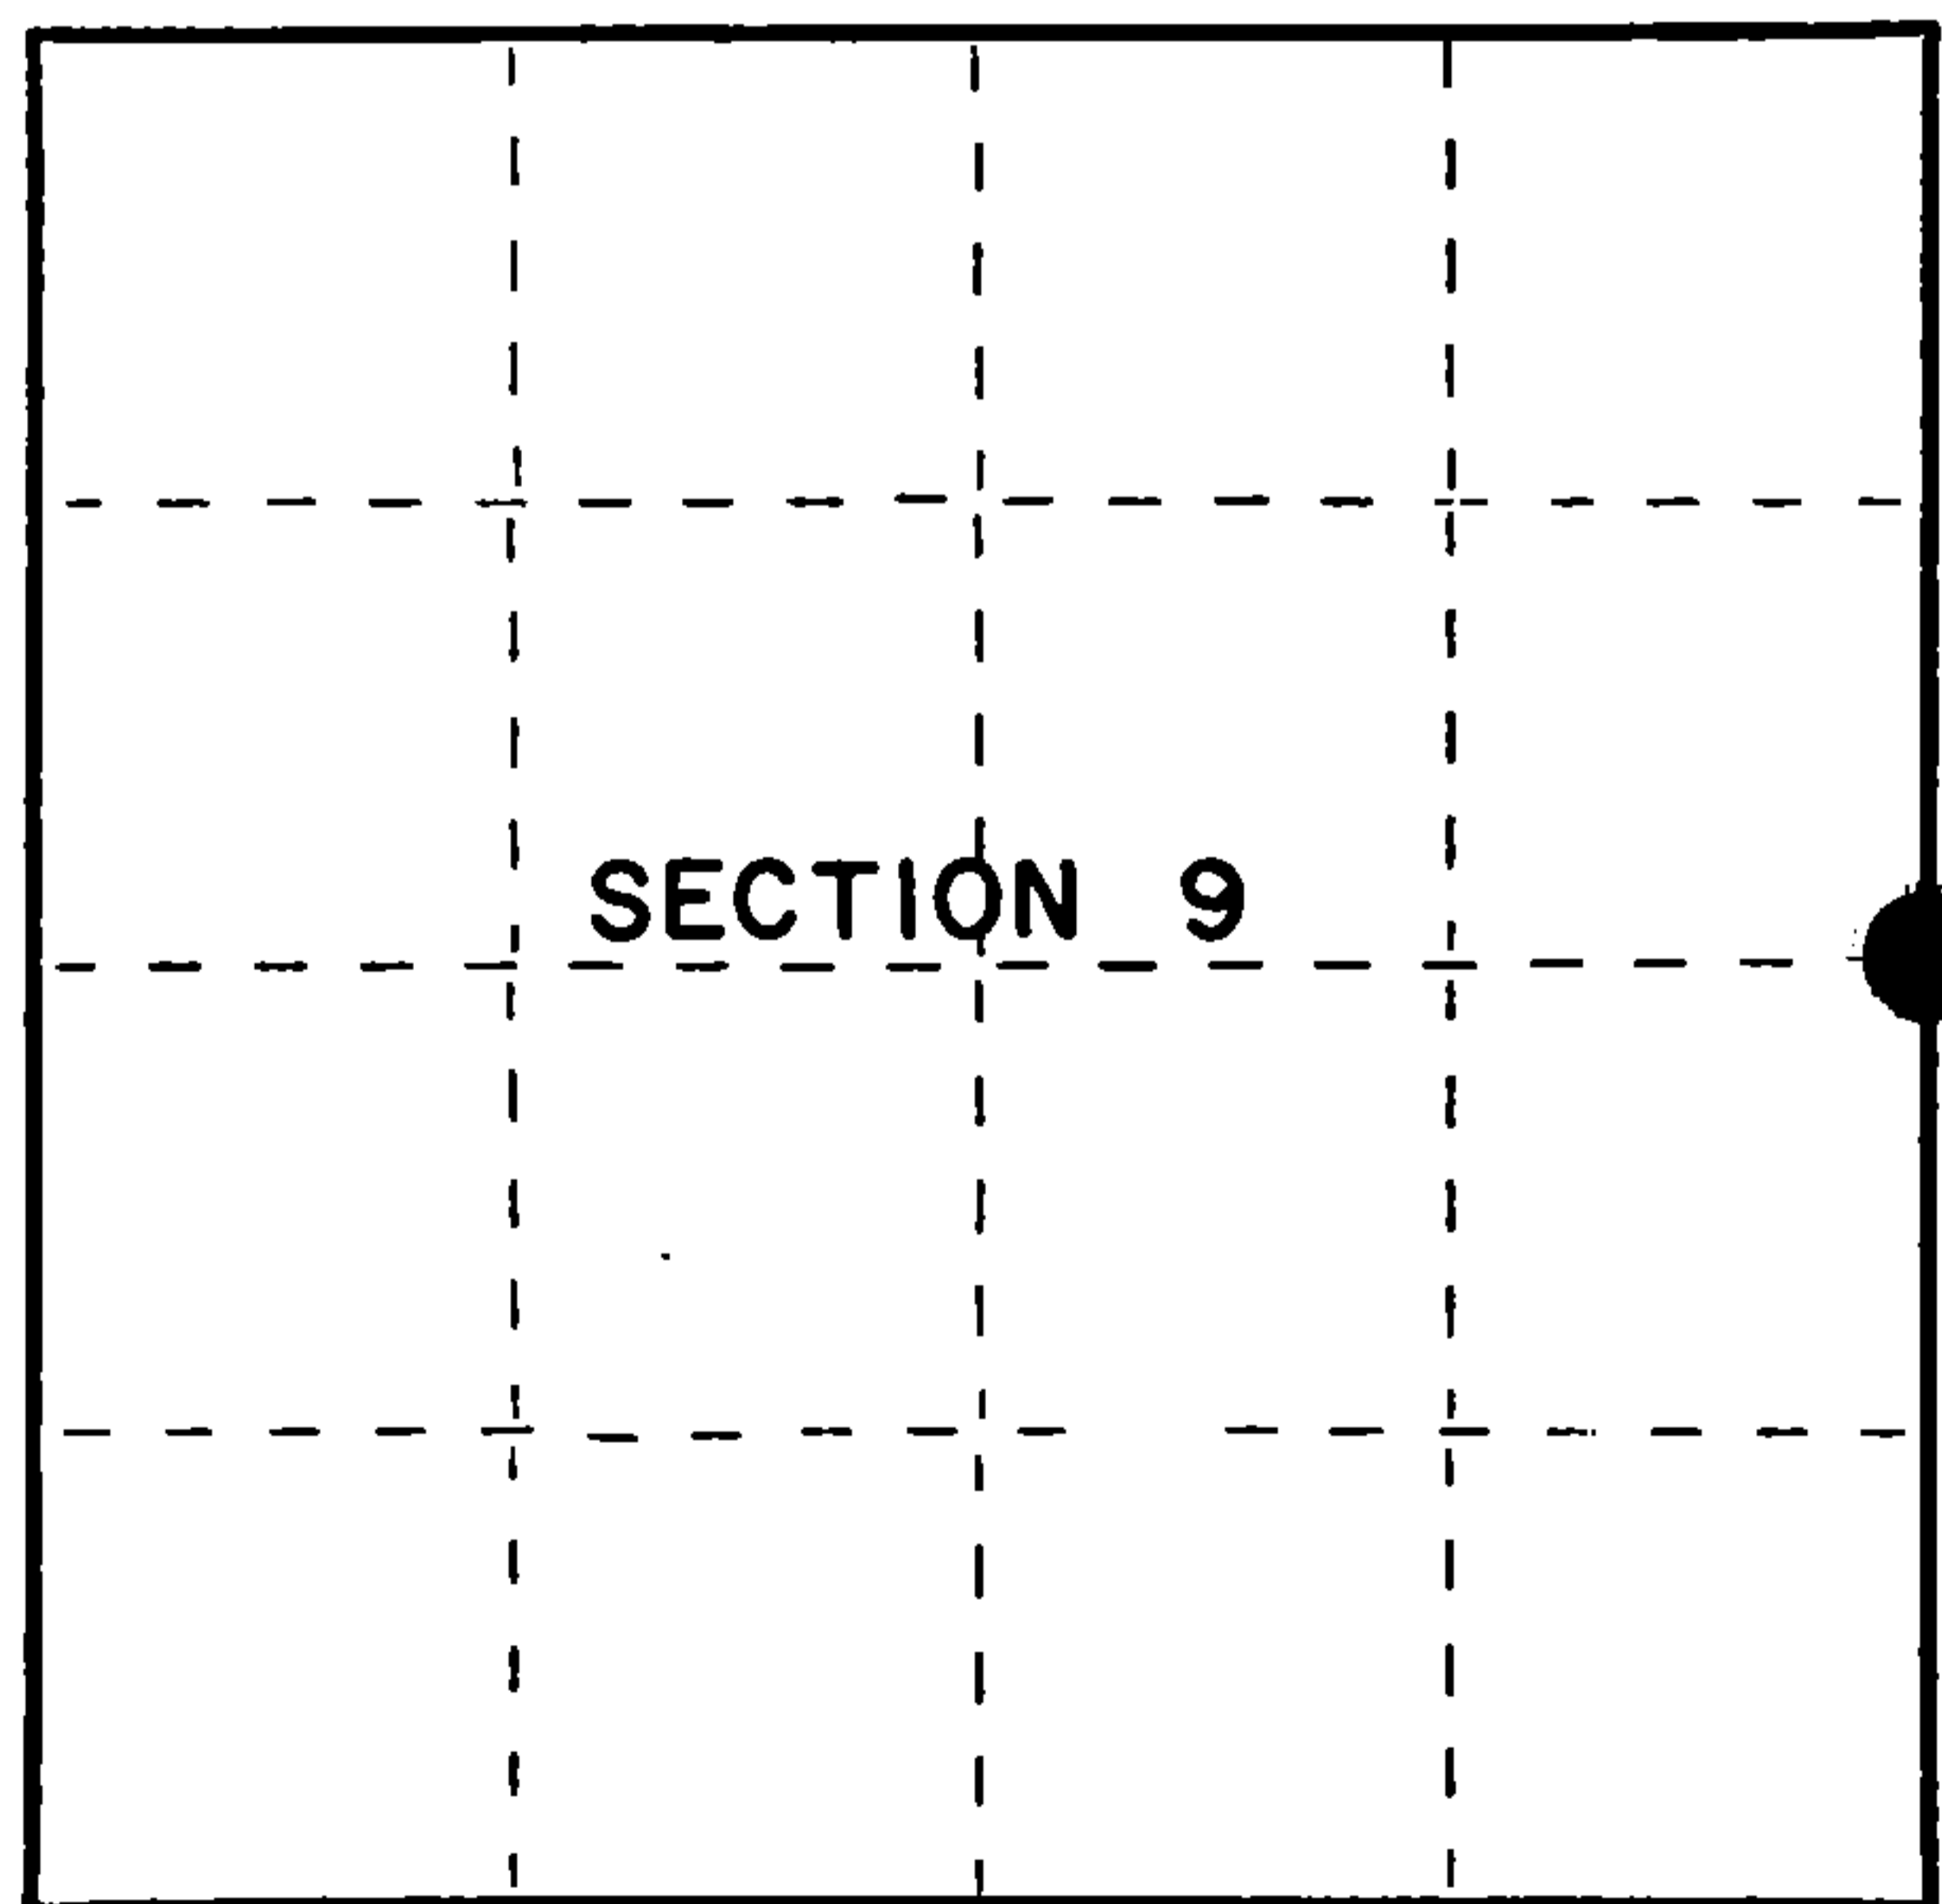

● = Corner monument restored.

Dated at Iron River, MI, this 22nd day of April, 1993.

Signature Gary L. Pisoni Title Land Surveyor Registration No. S-1634
(County Surveyor, Registered Land Surveyor, or other duly authorized official)

Office of Register of Deeds, County of Forest, I hereby certify that the within instrument was filed in this office for record on the 12th day of August, 1993 at 1:25 o'clock P M.

(Register of Deeds)
By [Signature] Deputy

FORM NO. 985-A



Stock No. 26273
DOCUMENT NUMBER
148144

4371309200

(e) Describe any material discrepancy between the location of the corner as restored or reestablished and the location of that corner as previously restored or reestablished by distance and direction. Show the discrepancy on the plan view drawing under (d), above. Show the distances between the corner as previously restored or reestablished and (1) the corner as restored or reestablished, and (2) to at least 2 of the witness monuments shown on the drawing in (d), above.

See Drawing below.

(f) Was the corner restored through acceptance of (1) an obliterated evidence location, or, (2) a found perpetuated location?

Restored through acceptance of a found perpetuated location.

(g&h) Was the corner reestablished through lost corner proportionate methods? If so, show the method, including the directions and distances to other public land survey corners used as evidence or used for proportioning in determining the corner location?

12" Cedar
N70°W, 35.94 feet

Steel Sign Post,
West, 1.47 feet

Quarter Corner S9 | S10

Steel Sign Post,
South, 1.60 feet

10" Cedar (Dead)
S83°E, 37.45 feet

14" Cedar
S47°W, 42.76 feet

10" Cedar (NBT)
S09°E, 47.73 feet



(i) I, Gary L. Pisoni
(type or print name) certify that the corner location shown on this record was determined by me or under my direction and control and that this U.S. Public Land Survey Monument Record is correct and complete to the best of my knowledge and belief.

Signature

Date

Survey requested by:

Sue Vap
District Ranger

8/12/93
Date


U. S. PUBLIC LAND SURVEY MONUMENT RECORD

INSTRUCTIONS: This record shall show the location of the corner and shall include all of the following nine elements (a through i).

(a) Identify the corner by reference to the U.S. public land survey system.

○ = Corner monument restored.

Quarter corner to Sections 9 and 10, T.37N., R.13E.

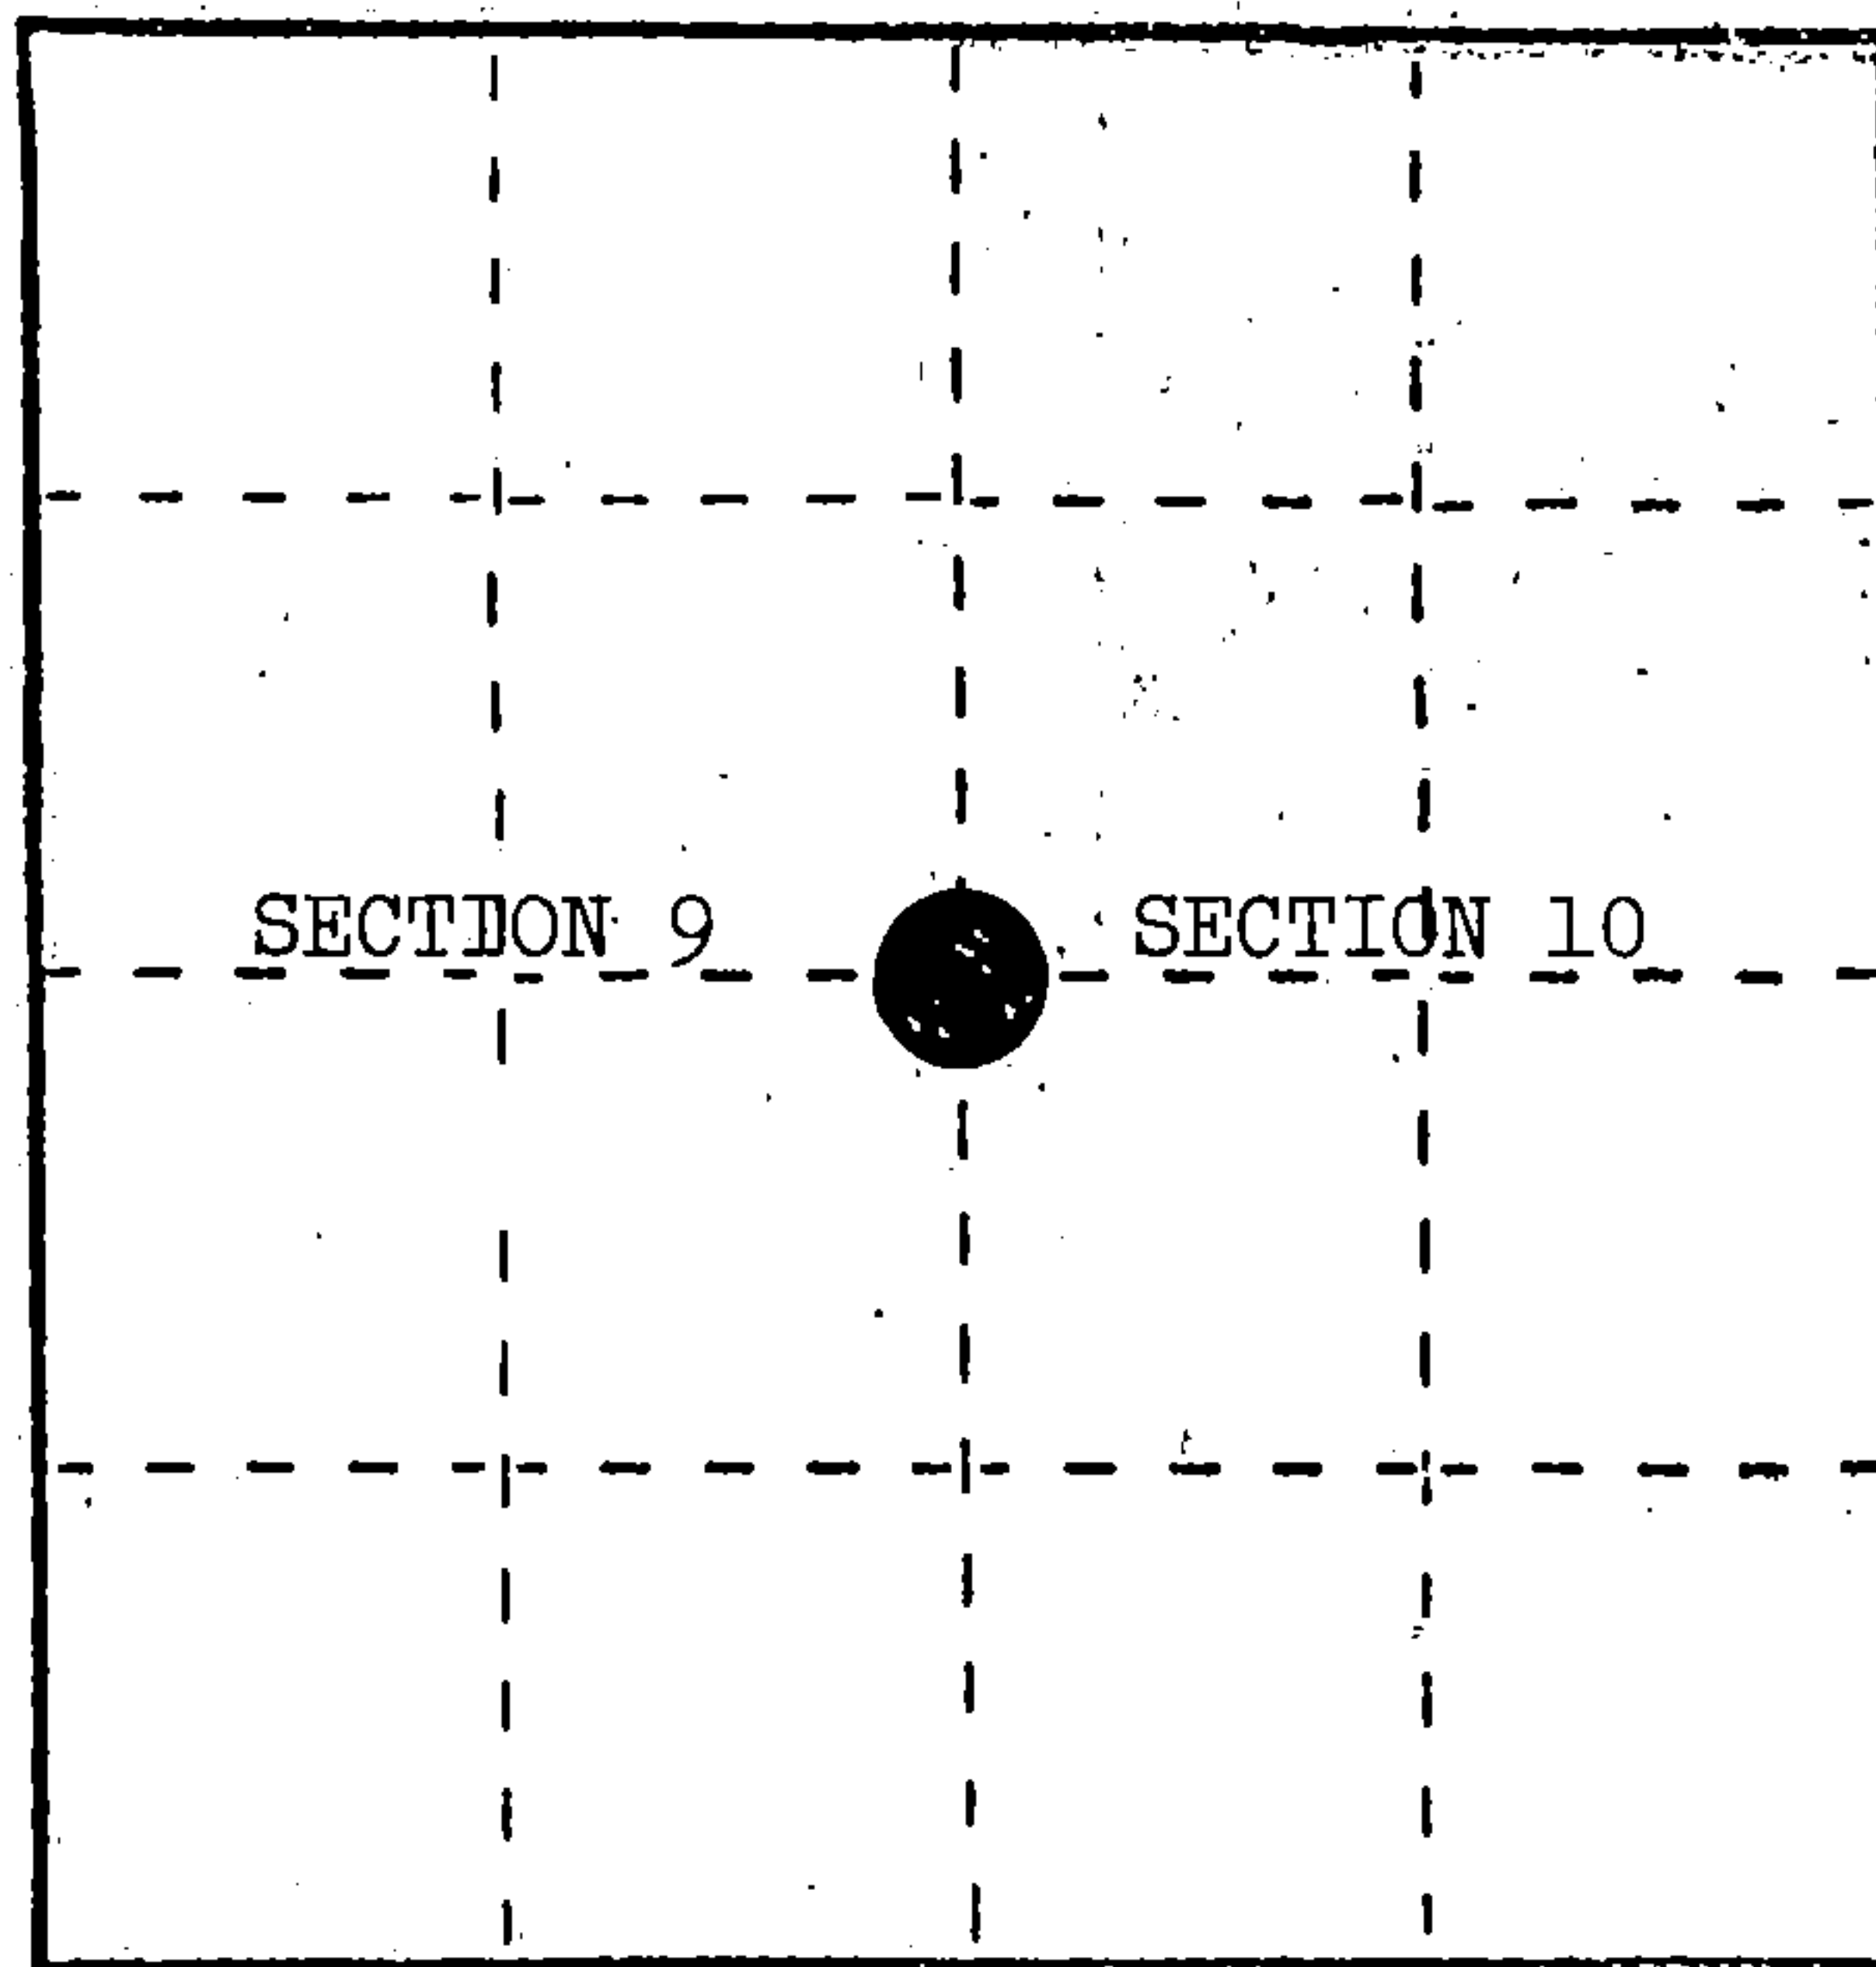

(b) Describe any record evidence, monument evidence, occupational evidence, testimonial evidence or any other material evidence you considered, and whether the monument was found or placed.


In 1865, J. L. Nowlin set $\frac{1}{4}$ section post with the following BTs: Tamarack, 12", S42°E., 25 links; Tamarack, 15", N.70°W., 15 links.

May 31, 1984, Milo Stefan found a 3" x 3" x 4" squared-up stake fallen with point in swamp; also, 3" x 3" x 12" old stake alongside. Very old blazed line southerly. Accepted old stake as the best remaining evidence of this corner and placed a 2" x 60" aluminum monument in post hole.

(c) In the plan view drawing below, provide reference ties to at least 4 witness monuments, or, if the location is within a municipality, to at least 2 witness monuments. (Witness monuments shall be made of concrete, natural stone, iron or other equally durable material.) Describe witness monuments.

(d) Show a plan view drawing depicting the relevant monuments and reference ties which is sufficient in detail to enable accurate relocation of the corner monument if the corner monument is disturbed. Indicate north.

1. Cedar, 10", S.83°E., 37.45'
2. Cedar, 12", S.49°W., 42.70'
3. Cedar, 10", N.72°W., 35.94'
4. Steel Sign Post, South, 1.6'
5. 2" x 60" aluminum monument stamped to identify corner.

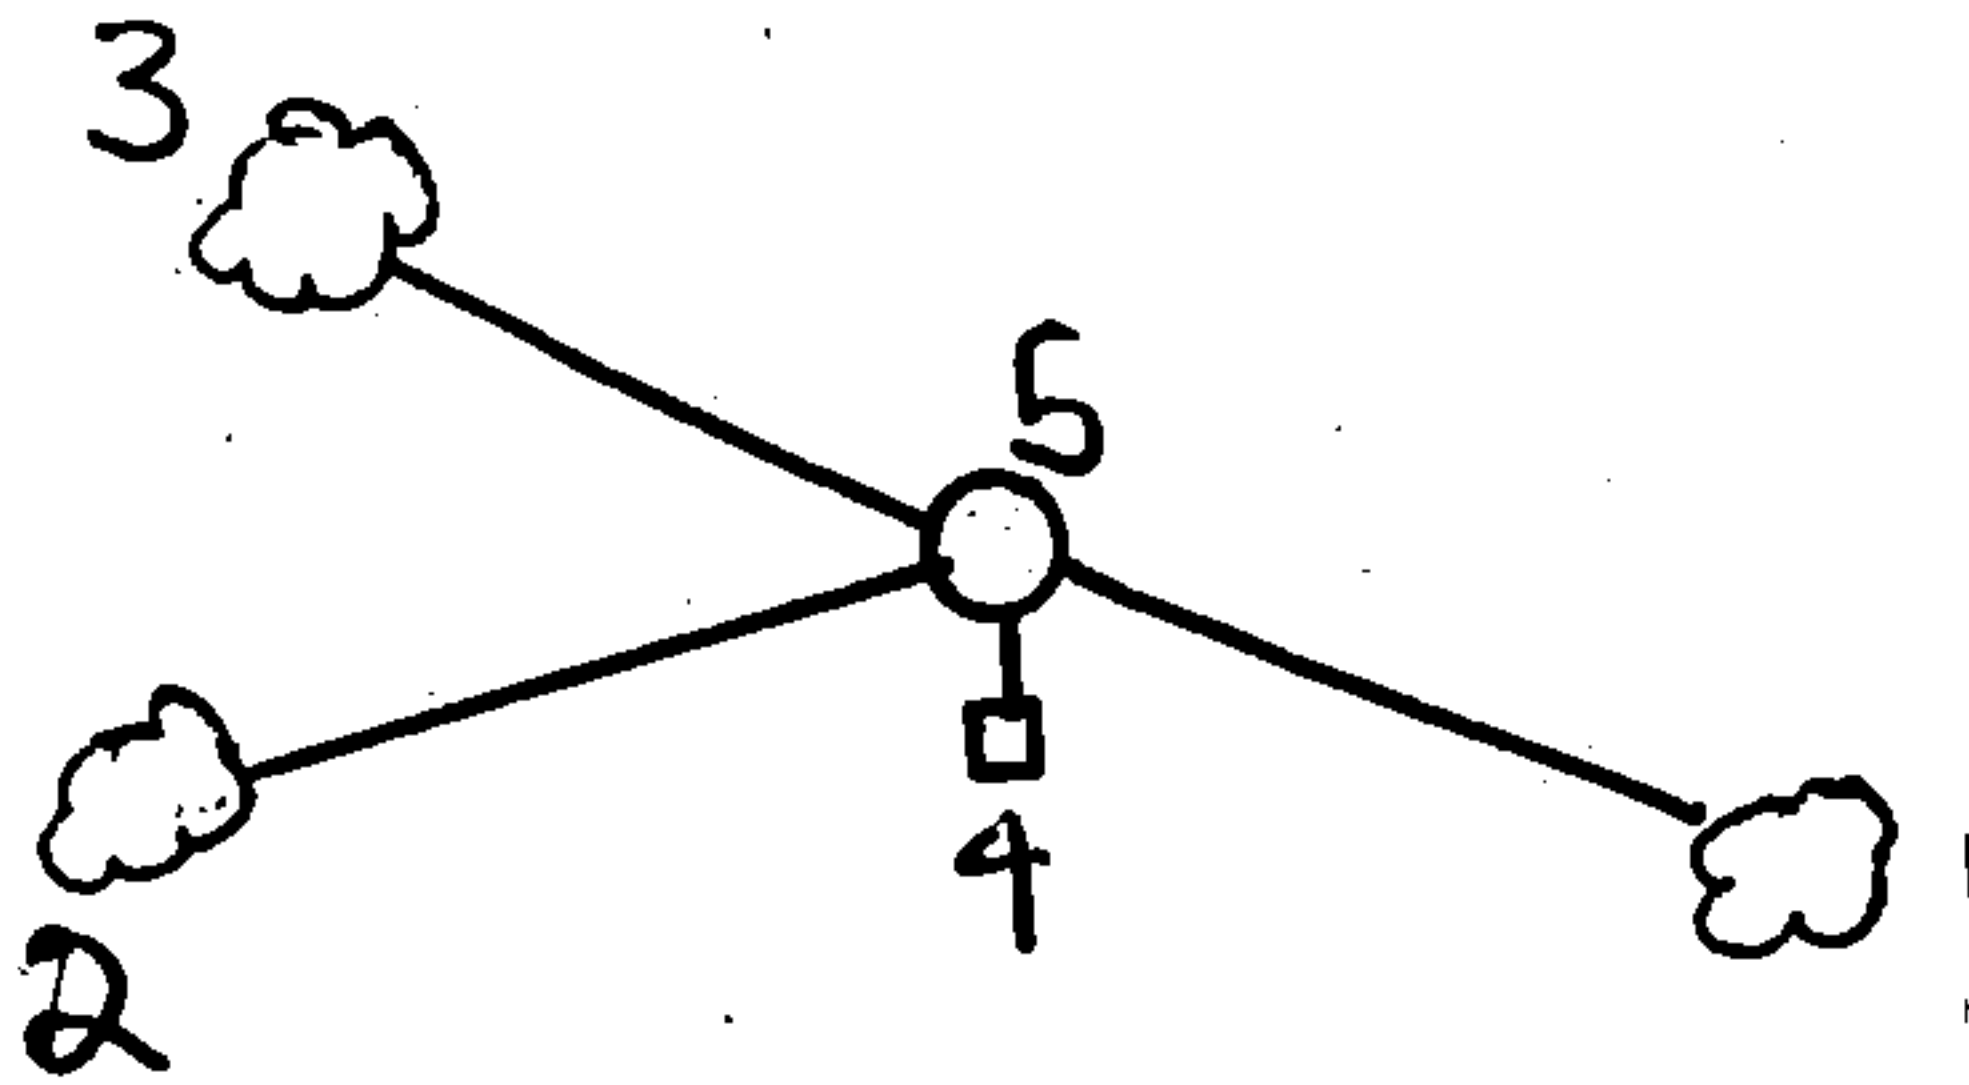

REGISTER'S OFFICE }
 Forest County, Wis. }
 Received for record this... 23rd day
 of January.....A. D., 1985 at
9:00..o'clock.....A.....M. and
 recorded in Vol.. CORNER RESTORATION
 on page G-13.....
Paul A. Schreiner
 REGISTER

43713092000

G 13

(e) Describe any material discrepancy between the location of the corner as restored or reestablished and the location of that corner as previously restored or reestablished by distance and direction. Show the discrepancy on the plan view drawing under (d), above. Show the distances between the corner as previously restored or reestablished and (1) the corner as restored or reestablished, and (2) to at least 2 of the witness monuments shown on the drawing in (d), above.

(f) Was the corner restored through acceptance of (1) an obliterated evidence location, or, (2) a found perpetuated location?

(2) a found perpetuated location.

(g&h) Was the corner reestablished through lost corner proportionate methods? If so, show the method, including the directions and distances to other public land survey corners used as evidence or used for proportioning in determining the corner location?

No.

Affix Land Surveyor Seal



(1) I, Milo E. Stefan
(Type or print name) certify that the corner location shown on this record was determined by me or under my direction and control and that this U.S. Public Land Survey Monument Record is correct and complete to the best of my knowledge and belief.

Milo E. Stefan
Signature

12/24/84
Date