

CERTIFIED LAND CORNER RESTORATION

Index No. R-13

State of Wisconsin }  
County of Forest } ss.

History of original corner establishment:

I Philip T. Hansen, do hereby certify that on the 10th day of June, 1980, I ~~found~~ established ~~the~~ corner of Sections 21, 22, 27, 28 Township 37, North, Range 13, Fourth Principal Meridian, as described hereon; and that from this evidence I established a new monument and accessories as described hereon to perpetuate the original location of this corner.


Description of corner evidence found:

No evidence of any corner recovered.

Accepted the intersection of the centerline of the town road, south along the section line, with an old fence line west as the corner. Old residences have accepted this as the corner for 50 years.

Resident witnesses:

Philip T. Hansen

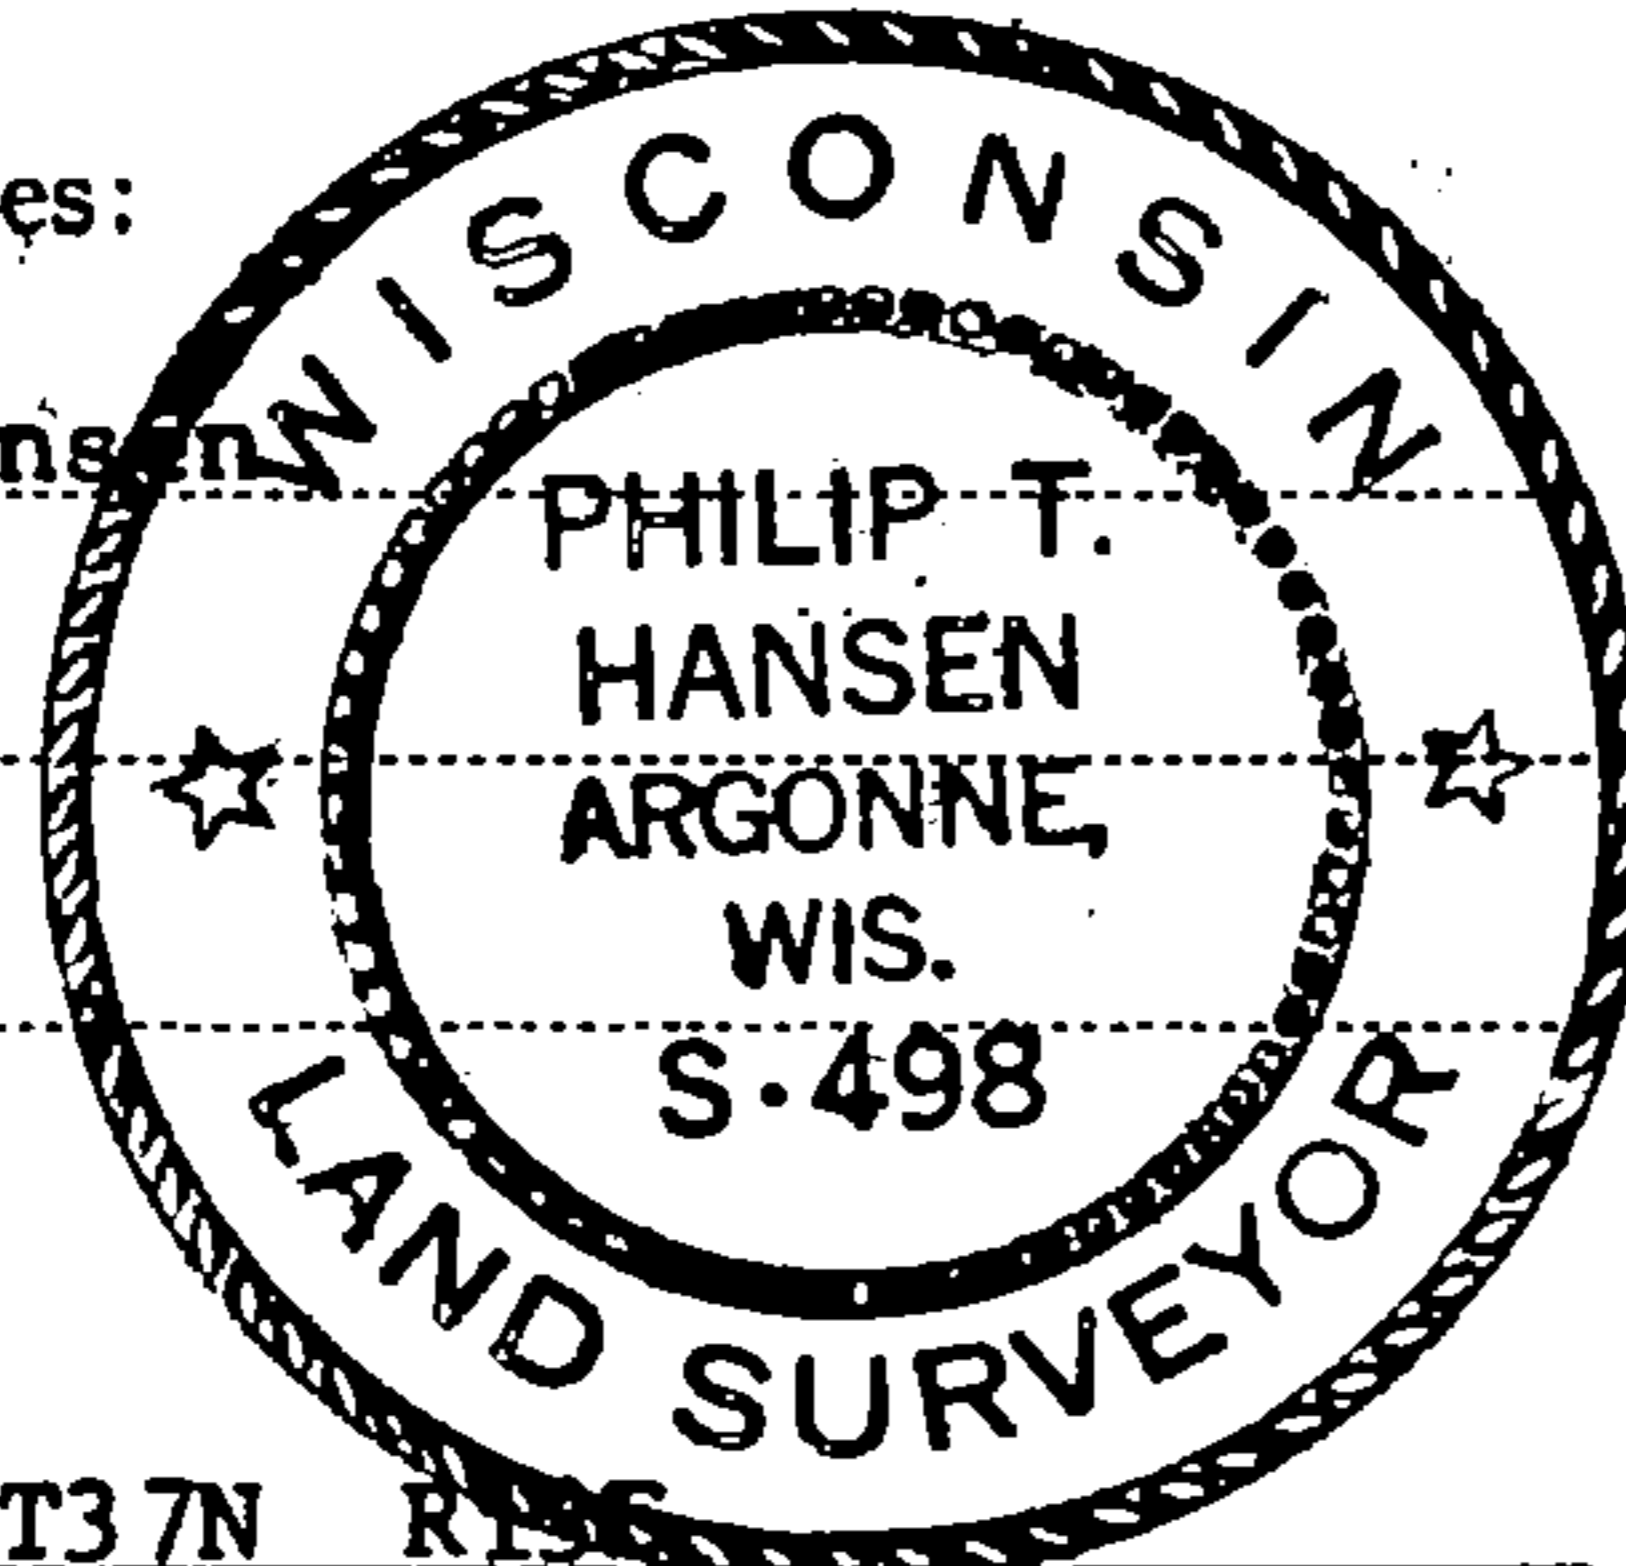

Description of monument and accessories I established to perpetuate the original location of this corner.

Set a 1" x 18" iron pipe for corner, 4 inches below the surface for true corner.


Set a 2-1/2" Berntsen A-1 Federal Monument for witness corner due east.

Monument projects 18" above ground, cap stamped:

Marked NBT - Cherry 8" S23°E 33.1 feet.

Power Pole N11°W 55.35 feet.

S.C.  
21 + 22  
28 + 27  
T37N R13E  
18.72 to cor.  
S498

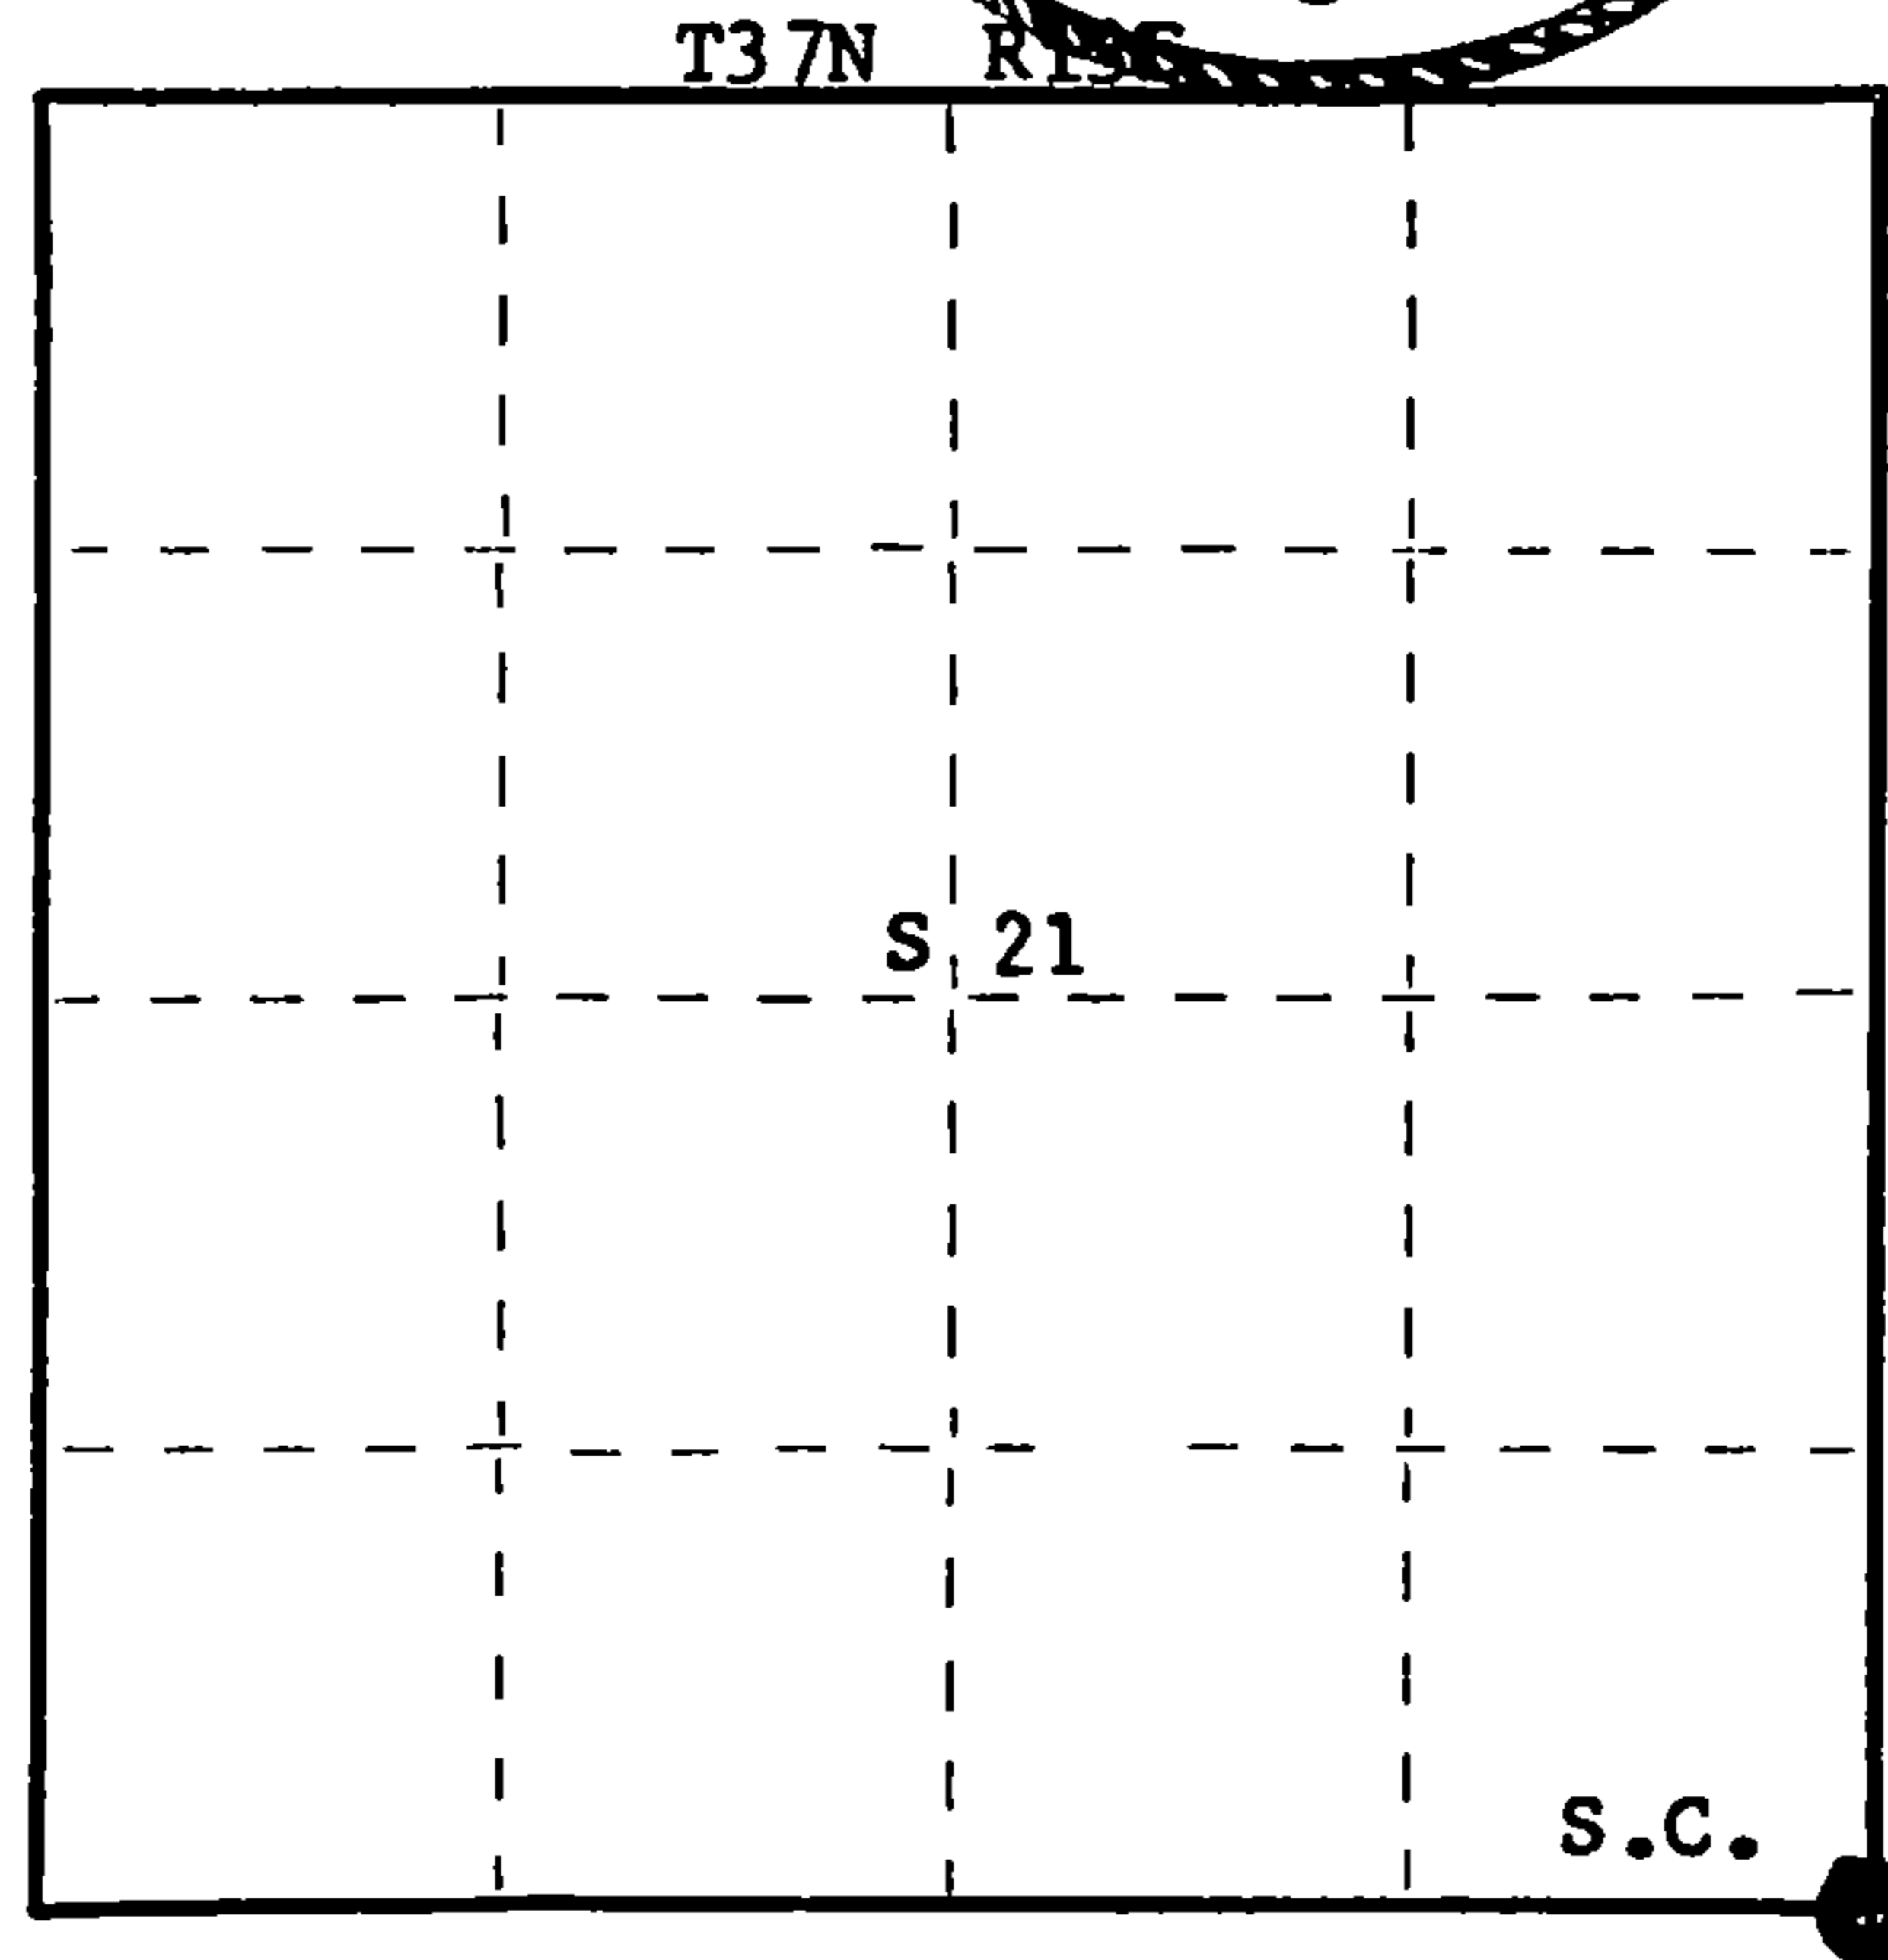

○ = Corner monument restored.

Dated at Argonne, Wis., this 30th day of June, 19 80.

Signature Philip T. Hansen Title Registered Land Surveyor Registration No. S-498  
(County Surveyor, Registered Land Surveyor, or other duly authorized official)

Office of Register of Deeds, County of Forest, I hereby certify that the within instrument was filed in this office for record on the 1st day of July, 19 80 at 8:30 o'clock A. M.

Eugene Stutzman  
(Register of Deeds)

DOCUMENT NO. **118206**

By \_\_\_\_\_ Deputy

FORM 985 H. C. MILLER CO., MILWAUKEE

4371321 0000