

CERTIFIED LAND CORNER RESTORATION

State of Wisconsin

County of Forest

ss.

I Jean F. Resvick, do hereby certify that on the 21st day of July, 1970, I found evidence of the East quarter corner of Section 24 Township 37 North, Range 13 East, Fourth Principal Meridian, as described hereon; and that from this evidence I established a new monument and accessories as described hereon to perpetuate the original location of this corner:

Description of original monument and accessories and subsequent restorations:

Township lines surveyed in 1858 by Alfred Millard. North between Sections 19 and 24. 40.00 chains set post.

Tamarack 12, N57E, 25 lks.

Spruce 10, S86W, 13 lks.

8.00 chains North leave swamp bears SW NE


12.00 chains South enter alder bottom in swamp bears East and West.

Description of corner evidence found:

2 inch diameter iron pipe driven along side an old post. From which a Tamarack stump bears N57E, 25 lks. Stump has overgrowth of what would be the lower part of the bottom blaze. The 2 inch iron pipe was driven into an old post point which was older than the post found. 8 chains North leave swamp.

Description of monument and accessories I established to perpetuate the original location of this corner:


Replaced iron pipe found with a 2 inch inside diameter galvanized wrought iron pipe, 5 feet long, filled with concrete with a brass cap stamped.

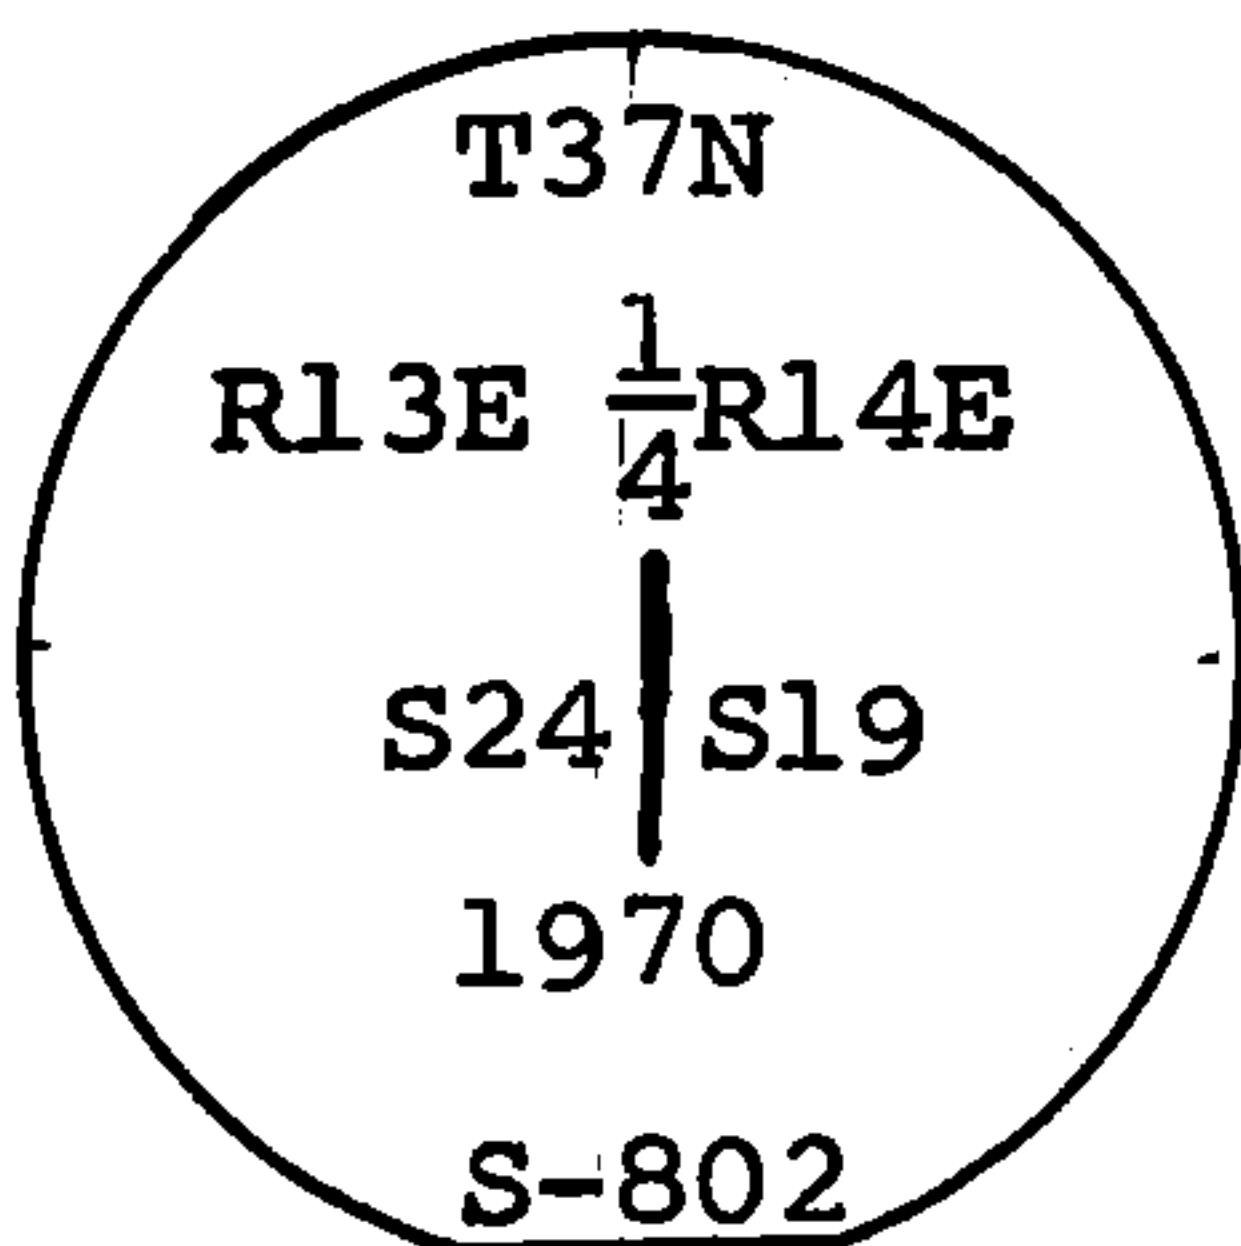

From which the following bear:

Balsam 4, bears N59E, 8.68 feet

Spruce 5, bears S 8W, 33.65 feet

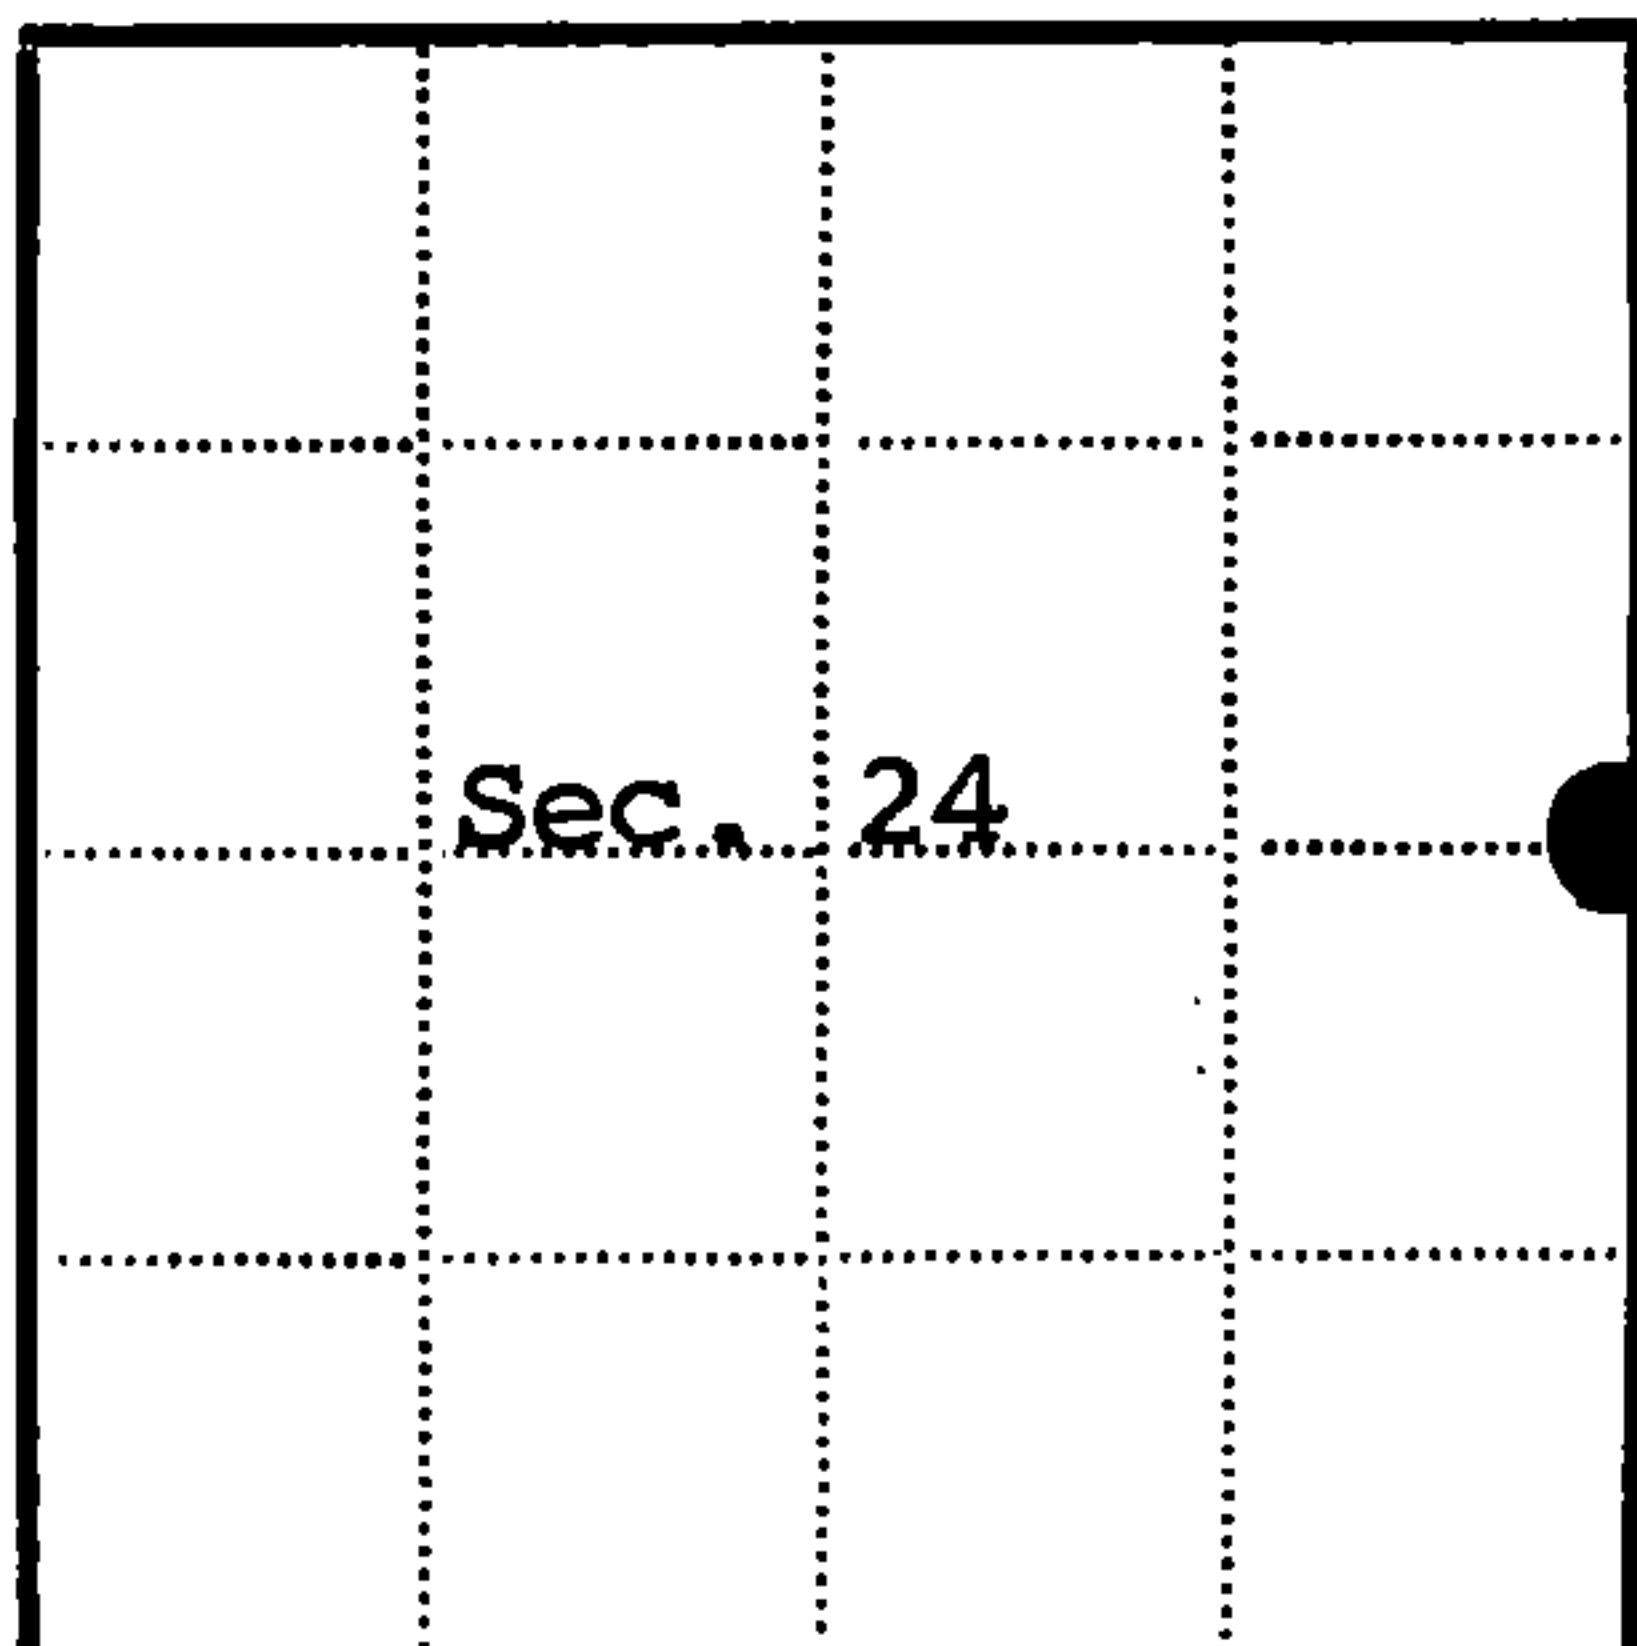

● = Corner monument restored

□ =

Resident witnesses

Dated at Rhinelander

Wisconsin, this 21st day of July

1970

Signature Jean F. Resvick

Title Cadastral Surveyor

(County Surveyor, Registered Land Surveyor, or other duly authorized official)

Surveyors Registration No. S-802

DOCUMENT NO.

98920

Office of Register of Deeds

County of Forest

I hereby certify that the within instrument was filed in this office for record on the 23rd day of October, 1970, and was filed in Book

No. CORNER Page No. P-25 of County Records.

RESTORATIONS

Signature

Title Register of Deeds

Township 37 North, Range 13 East, Section 24, Index No. P-25, Page No.

43713242000

P25