

CERTIFIED LAND CORNER RESTORATION

✓-1 Index No. **V I**

State of Wisconsin }
County of Forest } ss.

I Philip T. Hansen, do hereby certify that on the 22nd day of September, 1975, I found evidence of the Section Corner corner of S25-36, 30, and 31 Township 37, North, Range 13 and 14E, Fourth Principal Meridian, as described hereon; and that from this evidence I established a new monument and accessories as described hereon to perpetuate the original location of this corner.


Resident witnesses:

Glen Barker

Jim Claflin



FORM 985 H. C. MILLER CO., MILWAUKEE

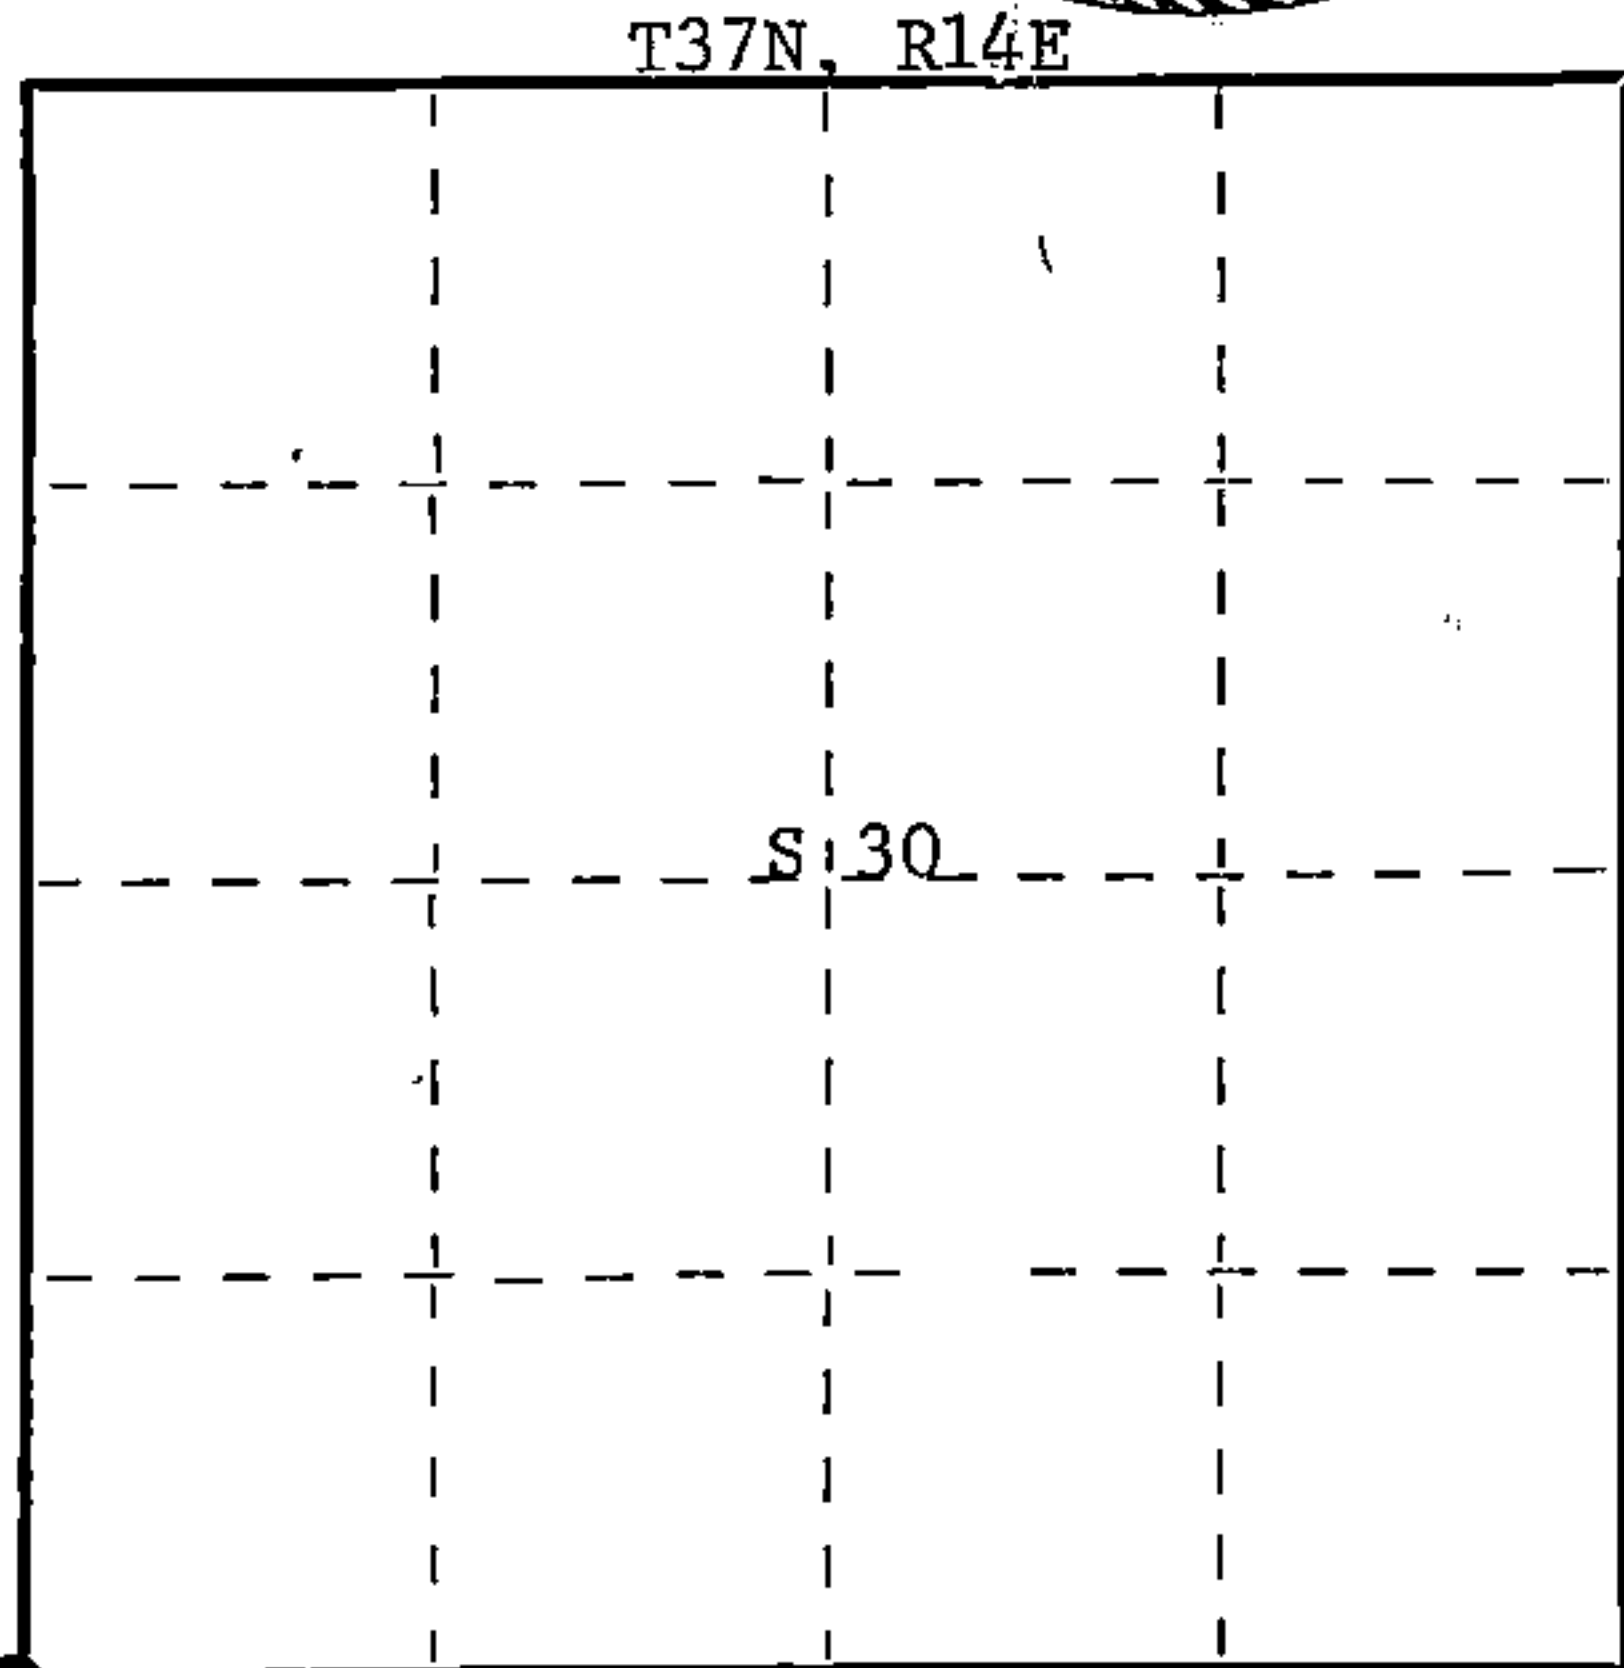

○ = Corner monument restored.

History of original corner establishment:

Original corner established by Alfred Millard, Gov. Deputy Surveyor, in 1858 from which cedar 10" bears N65°E 19 links, hemlock 10" bears N22°W 35 links, hemlock 10" bears S17°W 24 links, and cedar 12" bears S27°E 24 links.

Corner recovered by E.B. Hurst, Consolidated Forester, and P.T. Hansen, Reg. Land Surveyor, in 1933 during mapping. Corner recovered in fair condition.

Restored in 1950 by Ray Leigh, Company Forester. Set new post.

Description of corner evidence found:

Recovered 4" cedar post, squared and scribed S25, S30, S31, and S36 in poor condition. No evidence of OBT's.

Description of monument and accessories I established to perpetuate the original location of this corner. Replaced wooden post with 2-1/2" x 30" Berntsen A-1 federal monument aluminum post with magnet installed in cap and base. Corner post projects 6" above ground. Cap stamped.

NBT's - Black spruce 7" N4°E 51.2 links scribed SC BT
Black spruce 6" N46°E 18.4 links scribed SC BT
Black spruce 6" S88°W 32.6 links scribed SC BT

S498
T37N
R13E 25 | 30 R14E
36 | 31
1975

Post and BT's painted blue.

Dated at Argonne, Wis., this 26th day of September, 1975

Signature Philip T. Hansen Title Registered Land Surveyor Registration No. S-498
(County Surveyor, Registered Land Surveyor, or other duly authorized official)

Office of Register of Deeds, County of Forest, I hereby certify that the within instrument was filed in this office for record on the 30th day of September, 1975 at 3:15 o'clock P. M. DOCUMENT NUMBER -- **107879**

Eugene Stutzman
(Register of Deeds)
By _____ Deputy

4371325000

CERTIFIED LAND CORNER RESTORATION

Index No. **V-25**


State of Wisconsin }
County of Forest } ss.

I Daniel K. Pleoger, do hereby
certify that on the 20 day
of October, 19 81, I found
evidence of the Section
corner of Section 24, 25, - 19, 30
Township 37, North, Range
13 & 14 East, Fourth Principal Meridian,
as described hereon; and that from this evidence
I established a new monument and accessories
as described hereon to perpetuate the original
location of this corner.

Resident witnesses:



FORM 985 H. C. MILLER CO., MILWAUKEE

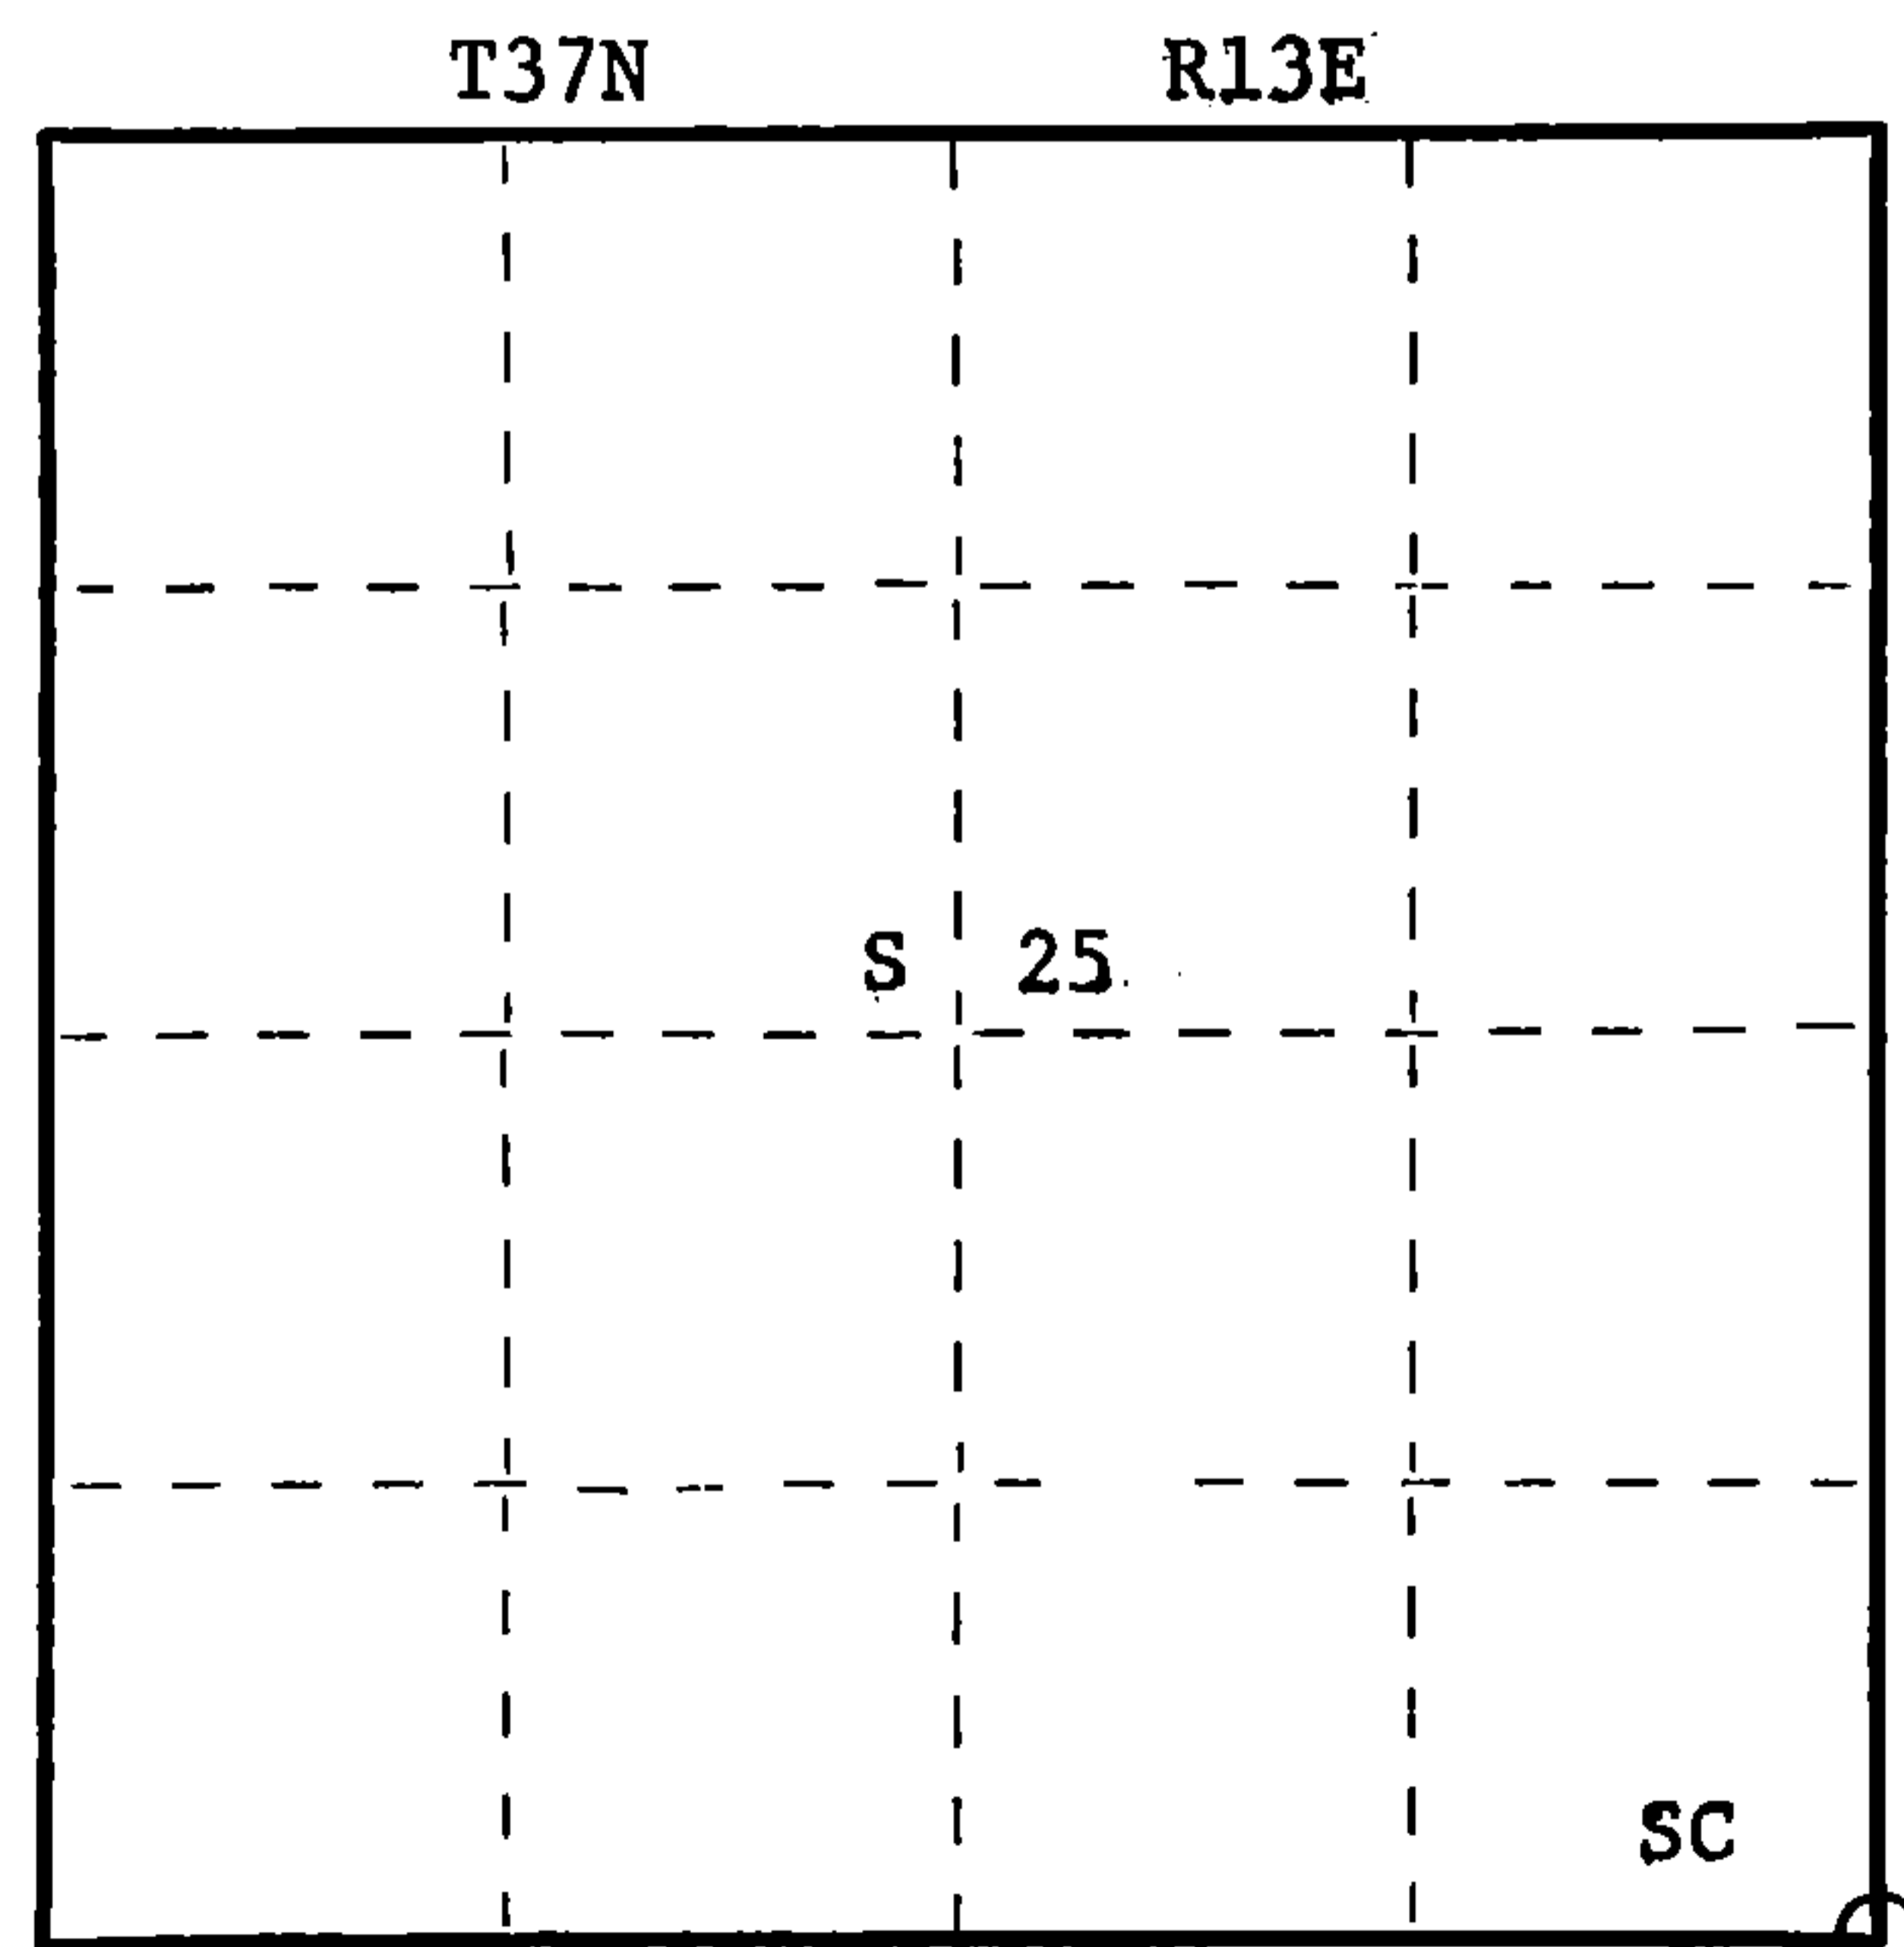

○ = Corner monument restored.

History of original corner establishment:

Original corner established by Alfred Millard, Gov. Deputy Surveyor in 1857
from which spruce 6" bears N20E 28 lks - spruce 5" N30W 14 lks - spruce 6" S65E 21 lks
and spruce 6" bears S55W 21 lks.

Description of corner evidence found:

Recovered a 2½" o.d. iron pipe driven in ground - also, an old cedar post
lying alongside pipe. Remains of old fence running north.

Recovered OBT

Spruce stump 7" S11W 9.70 ft - Scribed S25 - BT

Description of monument and accessories I established to perpetuate the original location of this corner.

Replaced iron pipe with a 2½" aluminum A-1 Federal monument with alloy cap stamped:

Monument projects 8" above ground

Marked NBTs:

- Black spruce 5" S10E 4.97 ft.
 - Black spruce 4" S77W 18.52 ft.
 - Black spruce 5" N5°W 18.62 ft.
 - Black spruce 6" N61E 5.38 ft.
- Scribed S.C. - B.T.

R13E - T37N R14E

24	19
25	30

S1537 = 1981

Dated at Rhineland, Wis., this 3rd day of November, 1981

Signature Daniel K. Pleoger Title Registered Land Surveyor Registration No. 1537
(County Surveyor, Registered Land Surveyor, or other duly authorized official)

Office of Register of Deeds, County of Forest, I hereby certify that the within
instrument was filed in this office for record on the 9th day of April, 1982
at 11:00 o'clock A. M.

DOCUMENT NO. **121390**

By _____ Deputy

43713250000