

U.S. PUBLIC LAND SURVEY MONUMENT RECORD
FOREST COUNTY

TYPE OF MONUMENT: 3" MAG SURVEY SPIKE
WISCONSIN COUNTY COORDINATE SYSTEM (FOREST)
DATUM: NAD 83 (2011 ADJUSTMENT)
NORTHING 600298.03
EASTING 841207.92
DRAWN BY: ANDREW HUNTER

CORNER INDEX NO. V-9
SECTION 29
TOWN 37 NORTH
RANGE 13 EAST



BASIS FOR MONUMENT LOCATION

HISTORY OF ORIGINAL CORNER ESTABLISHMENT AND SUBSEQUENT RESTORATIONS AND DESCRIPTION OF ANY RECORD, MONUMENT, OCCUPATIONAL, TESTIMONIAL OR OTHER EVIDENCE CONSIDERED:

PREVIOUS TIE SHEETS PREPARED BY PHILLIP T. HANSEN DATED NOVEMBER 17, 1977 AND R. JOHNSON DATED FEBRUARY 28, 1992 BOTH CALL FOR A 1/2" X 6" SURVEY SPIKE.

I COMPLETED A FIELD SURVEY PRIOR TO HIGHWAY CONSTRUCTION ALONG S.T.H. "32" AND DID NOT FIND THE CALLED FOR MONUMENT BUT INSTEAD FOUND THE SHAFT OF A MAG NAIL IN ASPHALT.

4 WITNESS TIES WERE LOCATED AND 1 OF THEM MEASURED AS RECORDED, SO THE FOUND MAG NAIL SHAFT WAS ACCEPTED AS THE TRUE CORNER LOCATION. I SET A 3" MAG SURVEY SPIKE AFTER CONSTRUCTION WAS COMPLETED AND TIED OFF THE 4 REMAINING WITNESS MONUMENTS.

SEAL:




CERTIFIED CORRECT:

Andrew L. Hunter
PROFESSIONAL LAND SURVEYOR


DATE OCTOBER 14, 2022

TIE SKETCH

SHOW AT LEAST FOUR TIES, ALSO FENCE LINES, ROADS, TOPO, SIZE AND TYPE OF WITNESS TREES AND ANY OTHER PERTINENT SITE DETAILS. IF OFF THE ROAD, THE BEST WAY TO ARRIVE AT THE CORNER.

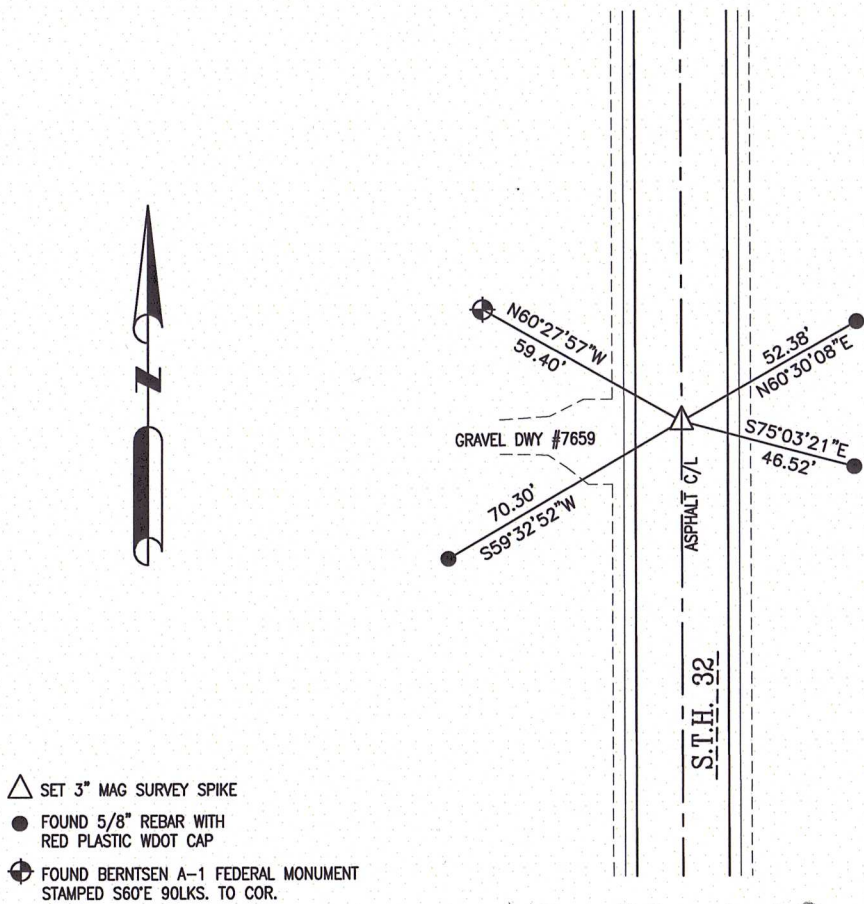

- △ SET 3" MAG SURVEY SPIKE
- FOUND 5/8" REBAR WITH RED PLASTIC WDOT CAP
- ⊕ FOUND BERNTSEN A-1 FEDERAL MONUMENT STAMPED S60°E 90LKS. TO COR.

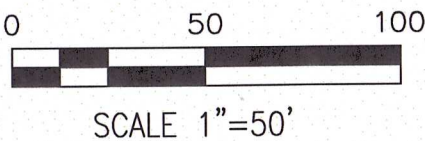

43713290000



ORIGINAL ON FILE IN CO CLERK'S OFFICE
COPY HERE FOR REFERENCE

RECORD AND CERTIFICATION OF U.S.
PUBLIC LAND SURVEY CONTROL STATION
E-D-716-72

State of Wisconsin / Department of Transportation

District 7	Project I. D. 9131-05-00	Located by R. JOHNSON SURVEY CREW CHIEF			
Corner SE. 29 SECTION	Township 37 N	Range (E,W) 13 E	County FOREST		
Wisconsin Coordinates CORNER	East (X)	North (Y)	Elevation (Z)	Zone	
Control Station Name	East (X)	North (Y)	Elevation (Z)	Zone	
Horizontal — NORTH AMERICAN, 1927		CONTROL DATUM Vertical — MEAN SEA LEVEL, 1929 ADJUSTMENT			
Horizontal — _____ Order		SURVEY CONTROL Vertical — _____ Order			

SKETCH

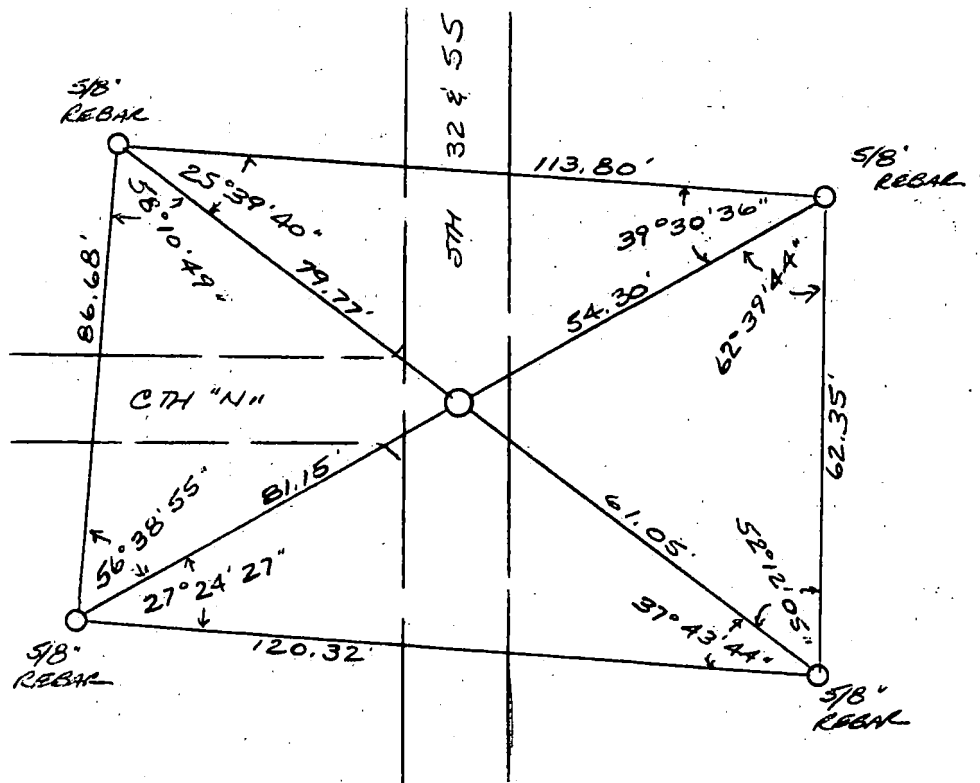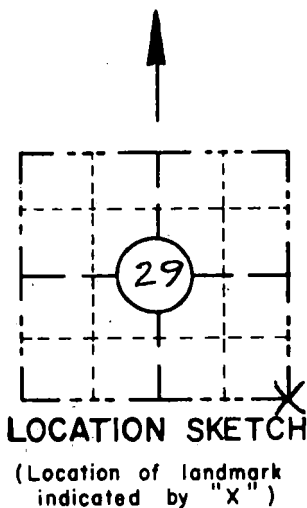

I hereby certify that on the 28th day of FEBRUARY 1992, that I did locate the above corner which was evidenced by 1/2" x 6" SPIKE; I further certify that to perpetuate the location of such corner I did, at the exact location thereof, place a permanent marker consisting of _____

_____ ; I further certify that I did establish 4 references or witness monuments consisting of 5/8" x 24" REINFORCING BARS WITH RED PLASTIC WDOT CAPS located as shown above:

SEAL

Signature Registered Land Surveyor	Registration No. S --	Title
------------------------------------	--------------------------	-------

43713 29 0000

CORNER
SECTION
29
TOWN
37 N
RANGE
13 E
V-9

CERTIFIED LAND CORNER RESTORATION

Index No. V-9

State of Wisconsin }
County of Forest } ss.



I Philip T. Hansen, do hereby
certify that on the 14th day
of November, 1977, I found
evidence of the Section
corner of Sec. 28, 29, 32, 33
Township 37, North, Range
13 East, Fourth Principal Meridian,
as described hereon; and that from this evidence
I established a new monument and accessories
as described hereon to perpetuate the original
location of this corner.

Resident witnesses:

Glen Barker

Jim Claflin

Herb Wagoner

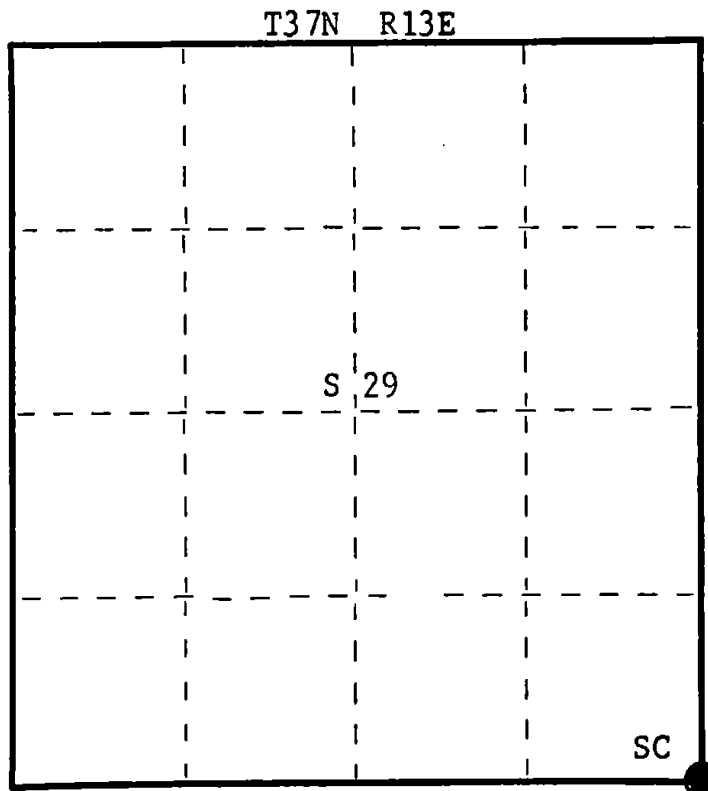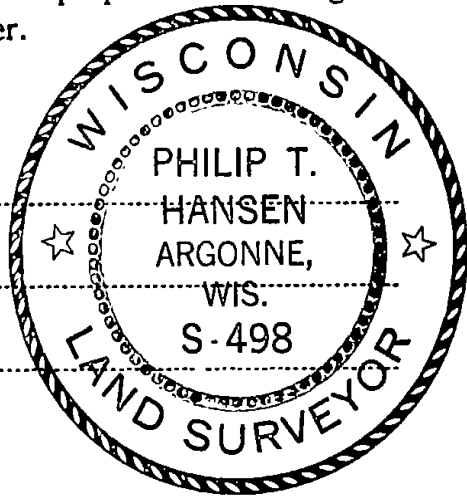

○ = Corner monument restored.

History of original corner establishment:
No record of any survey subsequent to the original survey.

Description of corner evidence found:

Recovered P.K. in the centerline of state highway 32 and 55, in line with section line
fence running east and also in line with old section line road running west.

Description of monument and accessories I established to perpetuate the original location of this corner.

Replaced P.K. nail with 1/2" x 6" survey spike.

Set a 2 1/2" Berntsen A-1 Federal Monument with magnet in cap and base for witness corner
S 60°E, 90 links.

Monument projects 12" above ground. Cap stamped:

Marked B.O.'s - Power pole 3713 - 32E1 S30°W, 91.7 links (spike)
Power pole 3713 29R12 N9°W, 360.9 links (spike)
1" iron pipe due east 51.3 links

T37N R13E
Sec. 29 + 28 W.C.
32 + 33
S498 - 1977
N60°W 90 lks. to Cor.

Dated at Rhineland, Wis., this 16th day of November, 1977.

Signature Philip T. Hansen Title Registered Land Surveyor Registration No. S-498
(County Surveyor, Registered Land Surveyor, or other duly authorized official)

Office of Register of Deeds, County of Forest, I hereby certify that the within
instrument was filed in this office for record on the 17th day of November, 1977
at 4:00 o'clock P. M.

Eugene Stutzman
(Register of Deeds)
By _____ Deputy

DOCUMENT Number
112820

FORM 985 M. C. MILLER CO., MILWAUKEE

4351329000