

CERTIFIED LAND CORNER RESTORATION

Index No. Y-7

State of Wisconsin }
County of Forest } ss.


I Philip T. Hansen, do hereby certify that on the 29th day of November, 19 77, I ~~found~~ established ~~the~~ Quarter corner of Section 29 - 32 Township 37, North, Range 13 East, Fourth Principal Meridian, as described hereon; and that from this evidence I established a new monument and accessories as described hereon to perpetuate the original location of this corner.

Resident witnesses:


Glen Barker

Jim Claflin

Herb Wagoner

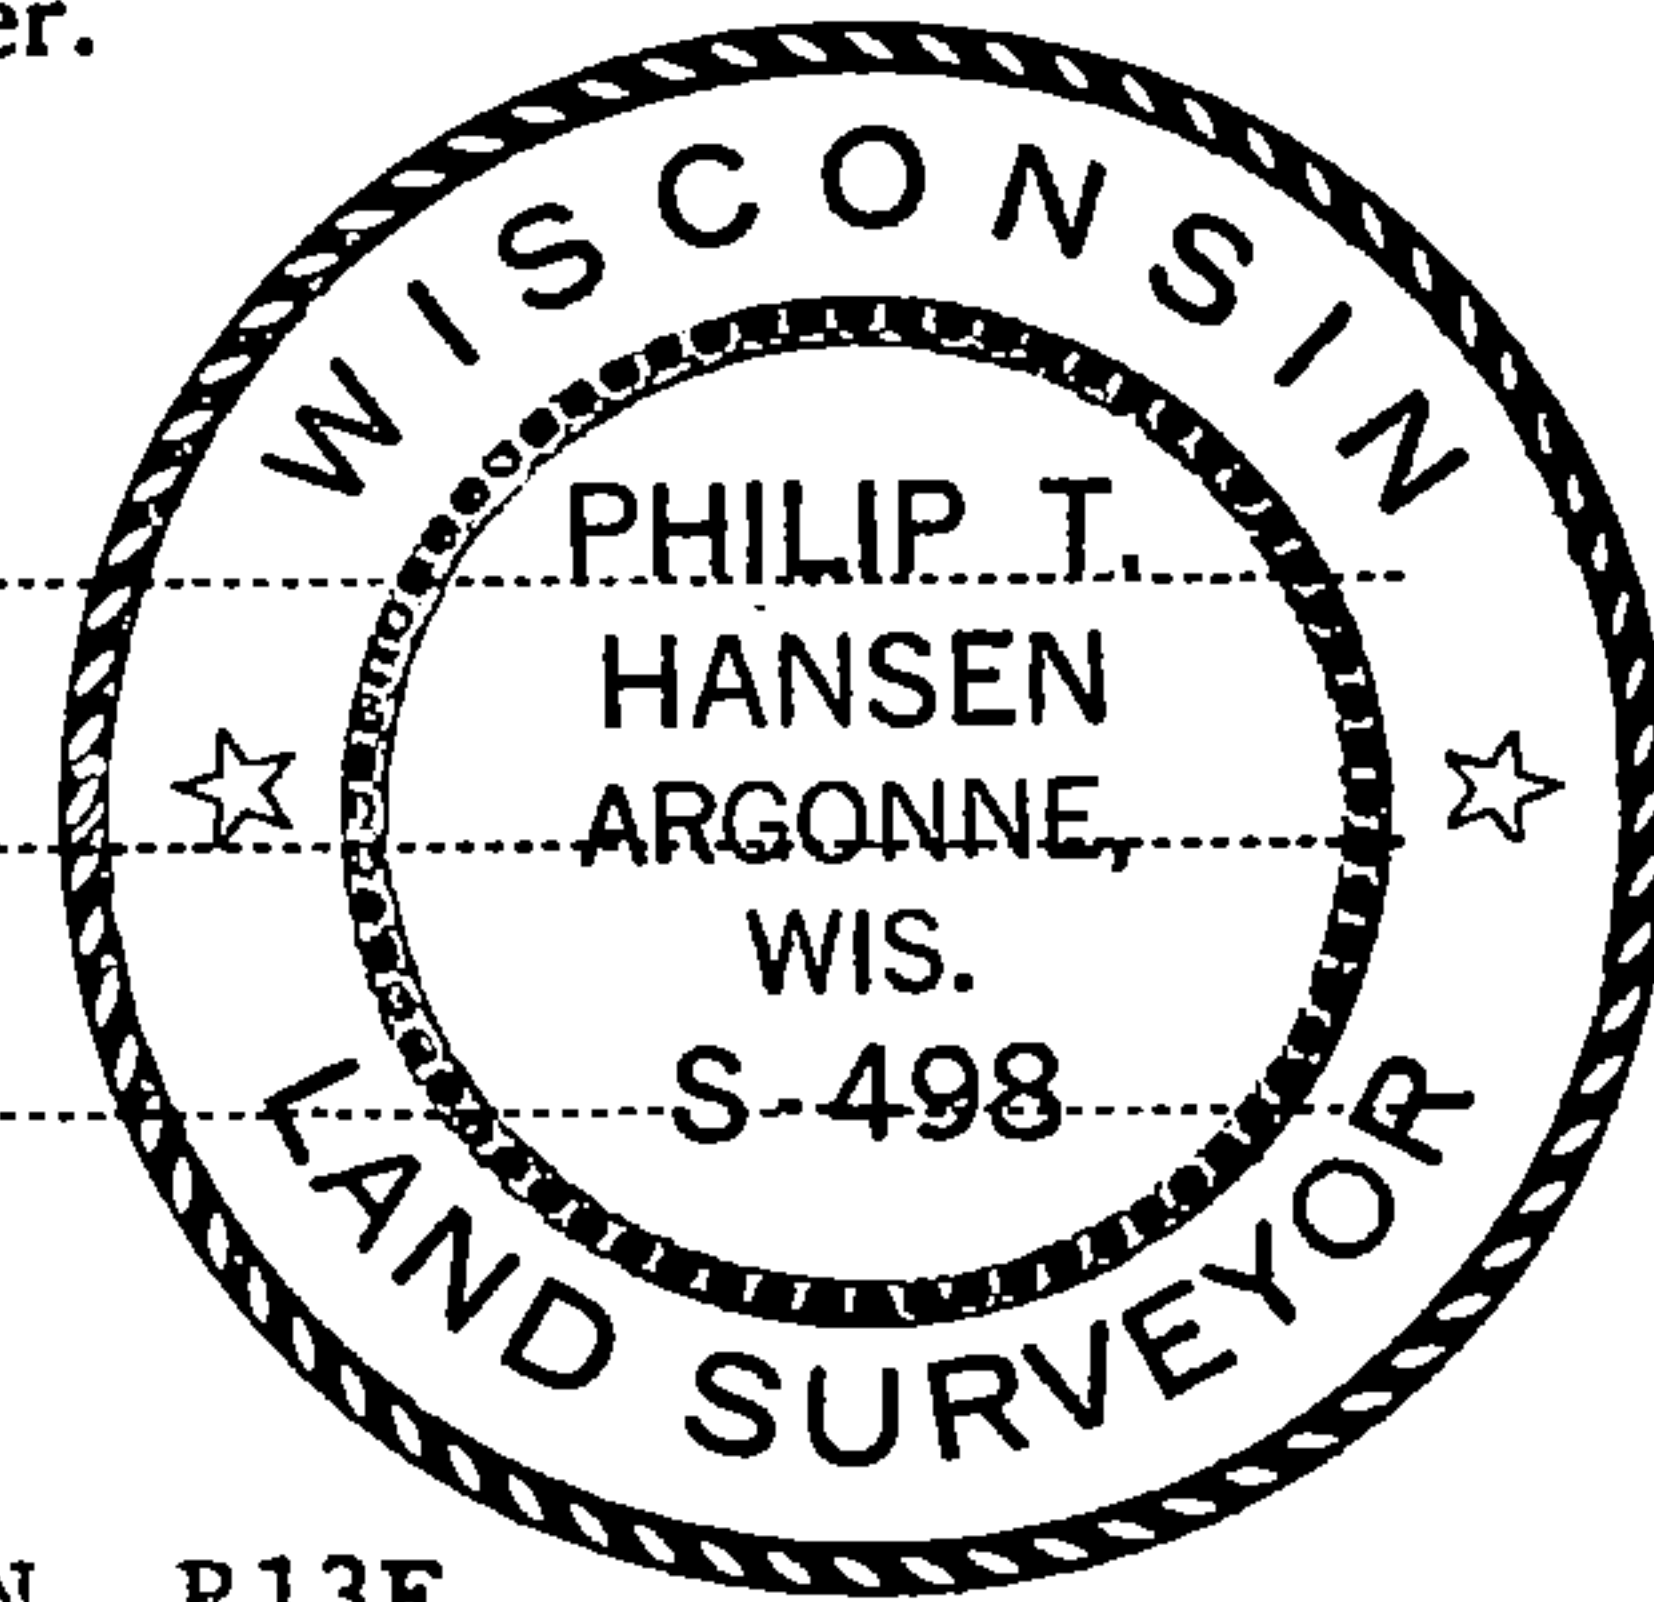

FORM 985 H. C. MILLER CO., MILWAUKEE

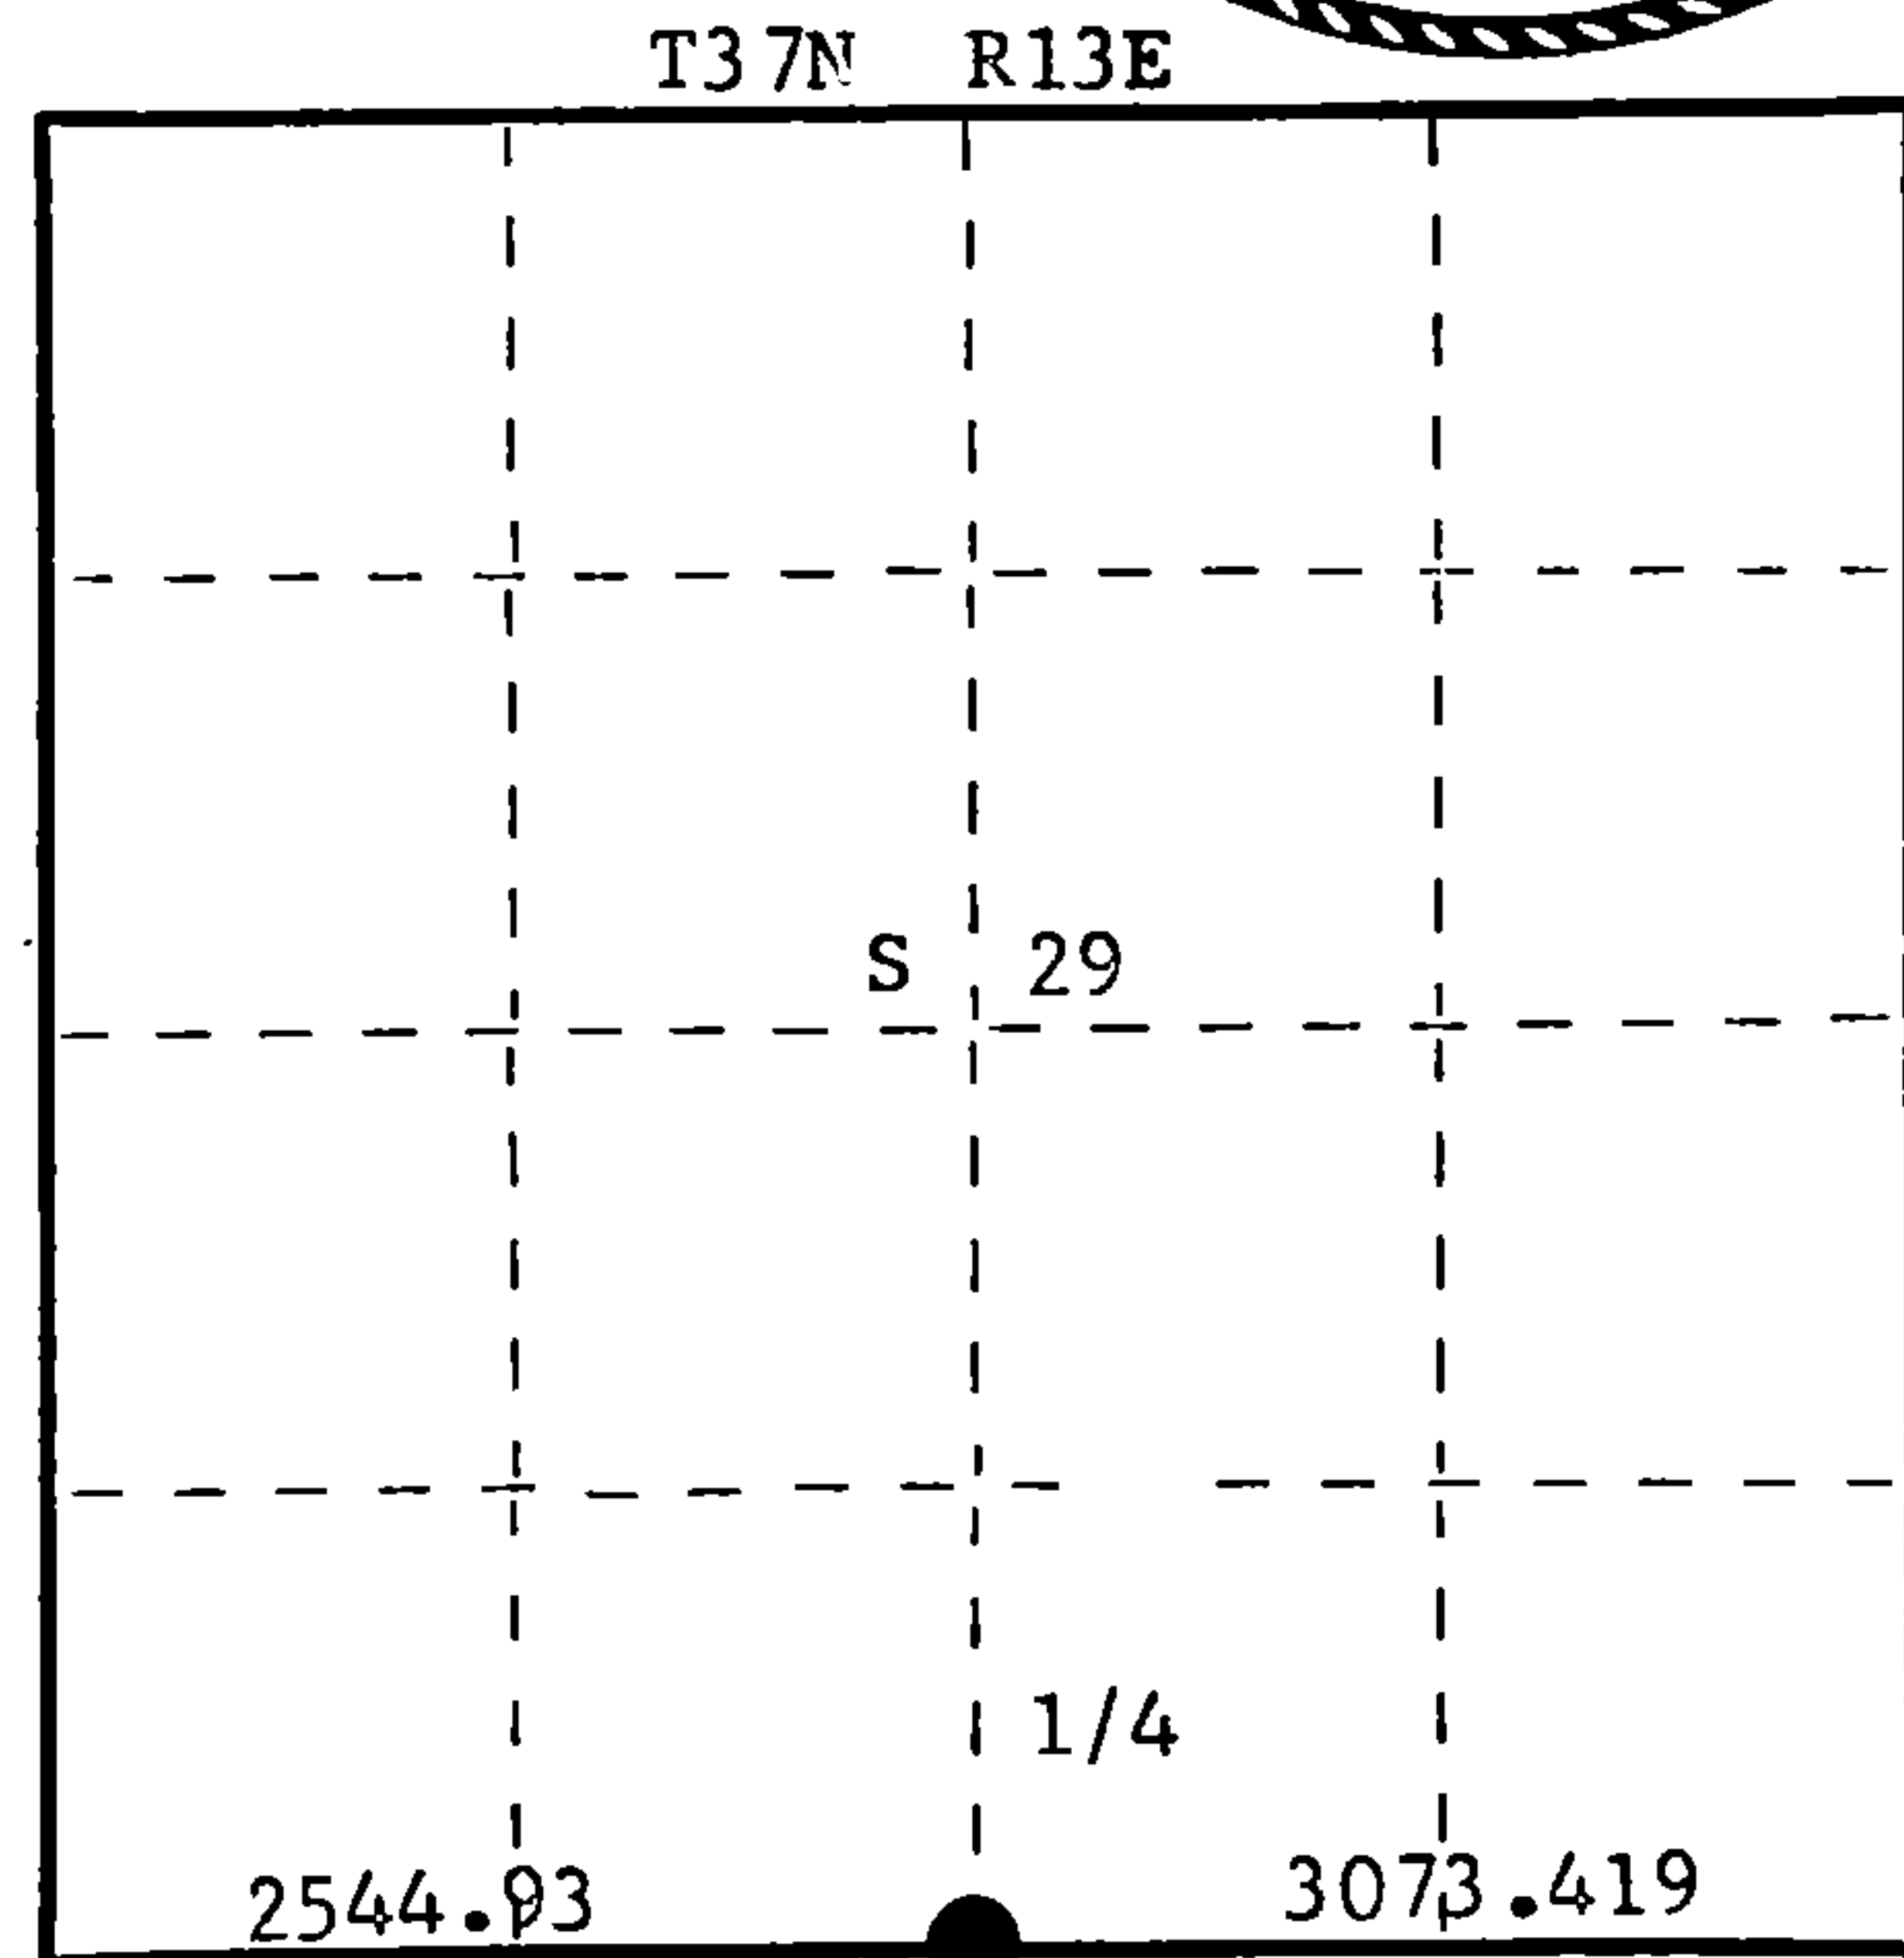

○ = Corner monument restored.

History of original corner establishment:

Original corner established by J.L. Nowlin, Deputy Surveyor, in 1859.

No records of any subsequent survey.

Description of corner evidence found:

No evidence of any corner recovered. Corner set by proportional measurement. From C 1/4 corner, section 32, ran traverse to recovered NC 1/16 corner. Computed distance 1305.125 ft. bearing N 5° 24' 17" W. Set N 1/4 section 32 at 2610.252 ft. on same bearing. This line follows cleared fields of adjacent property owners in section 32.

Description of monument and accessories I established to perpetuate the original location of this corner.

Set 2 1/2" Berntsen A-1 Federal Monument, aluminum with magnet in cap and base projecting 18" above ground. Cap stamped:
Marked NBTs - Tamarack 6" N26°W, 30.2 links
Tamarack 5" S10°E, 21.5 links
Black Spruce 7" S22°W, 9.1 links,
scribed 1/4 BT.

T37N R13E
1/4 S²⁹
S³²
S498 - 1977

Corner sets approximately 40' north of old E-W section line road.

Dated at Rhineland, Wis., this 3rd day of December, 19 77

Signature Philip T. Hansen Title Registered Land Surveyor Registration No. S-498
(County Surveyor, Registered Land Surveyor, or other duly authorized official)

Office of Register of Deeds, County of Forest, I hereby certify that the within instrument was filed in this office for record on the 11th day of December, 19 77 at 3:00 o'clock P. M.

Eugene Stutzman
(Register of Deeds)

DOCUMENT NUMBER **112969**

By _____ Deputy

43713290020