

CERTIFIED LAND CORNER RESTORATION

Index No. T-7

State of Wisconsin }
County of Forest } ss.


I, Philip T. Hansen, do hereby certify that on the 30th day of November, 1977, I ~~restored~~ established ~~corner~~ of the C 1/4 corner of Section 29 Township 37, North, Range 13 East, Fourth Principal Meridian, as described hereon; and that from this evidence I established a new monument and accessories as described hereon to perpetuate the original location of this corner.

Resident witnesses:


Glen Barker

Jim Claflin

Herb Wagoner

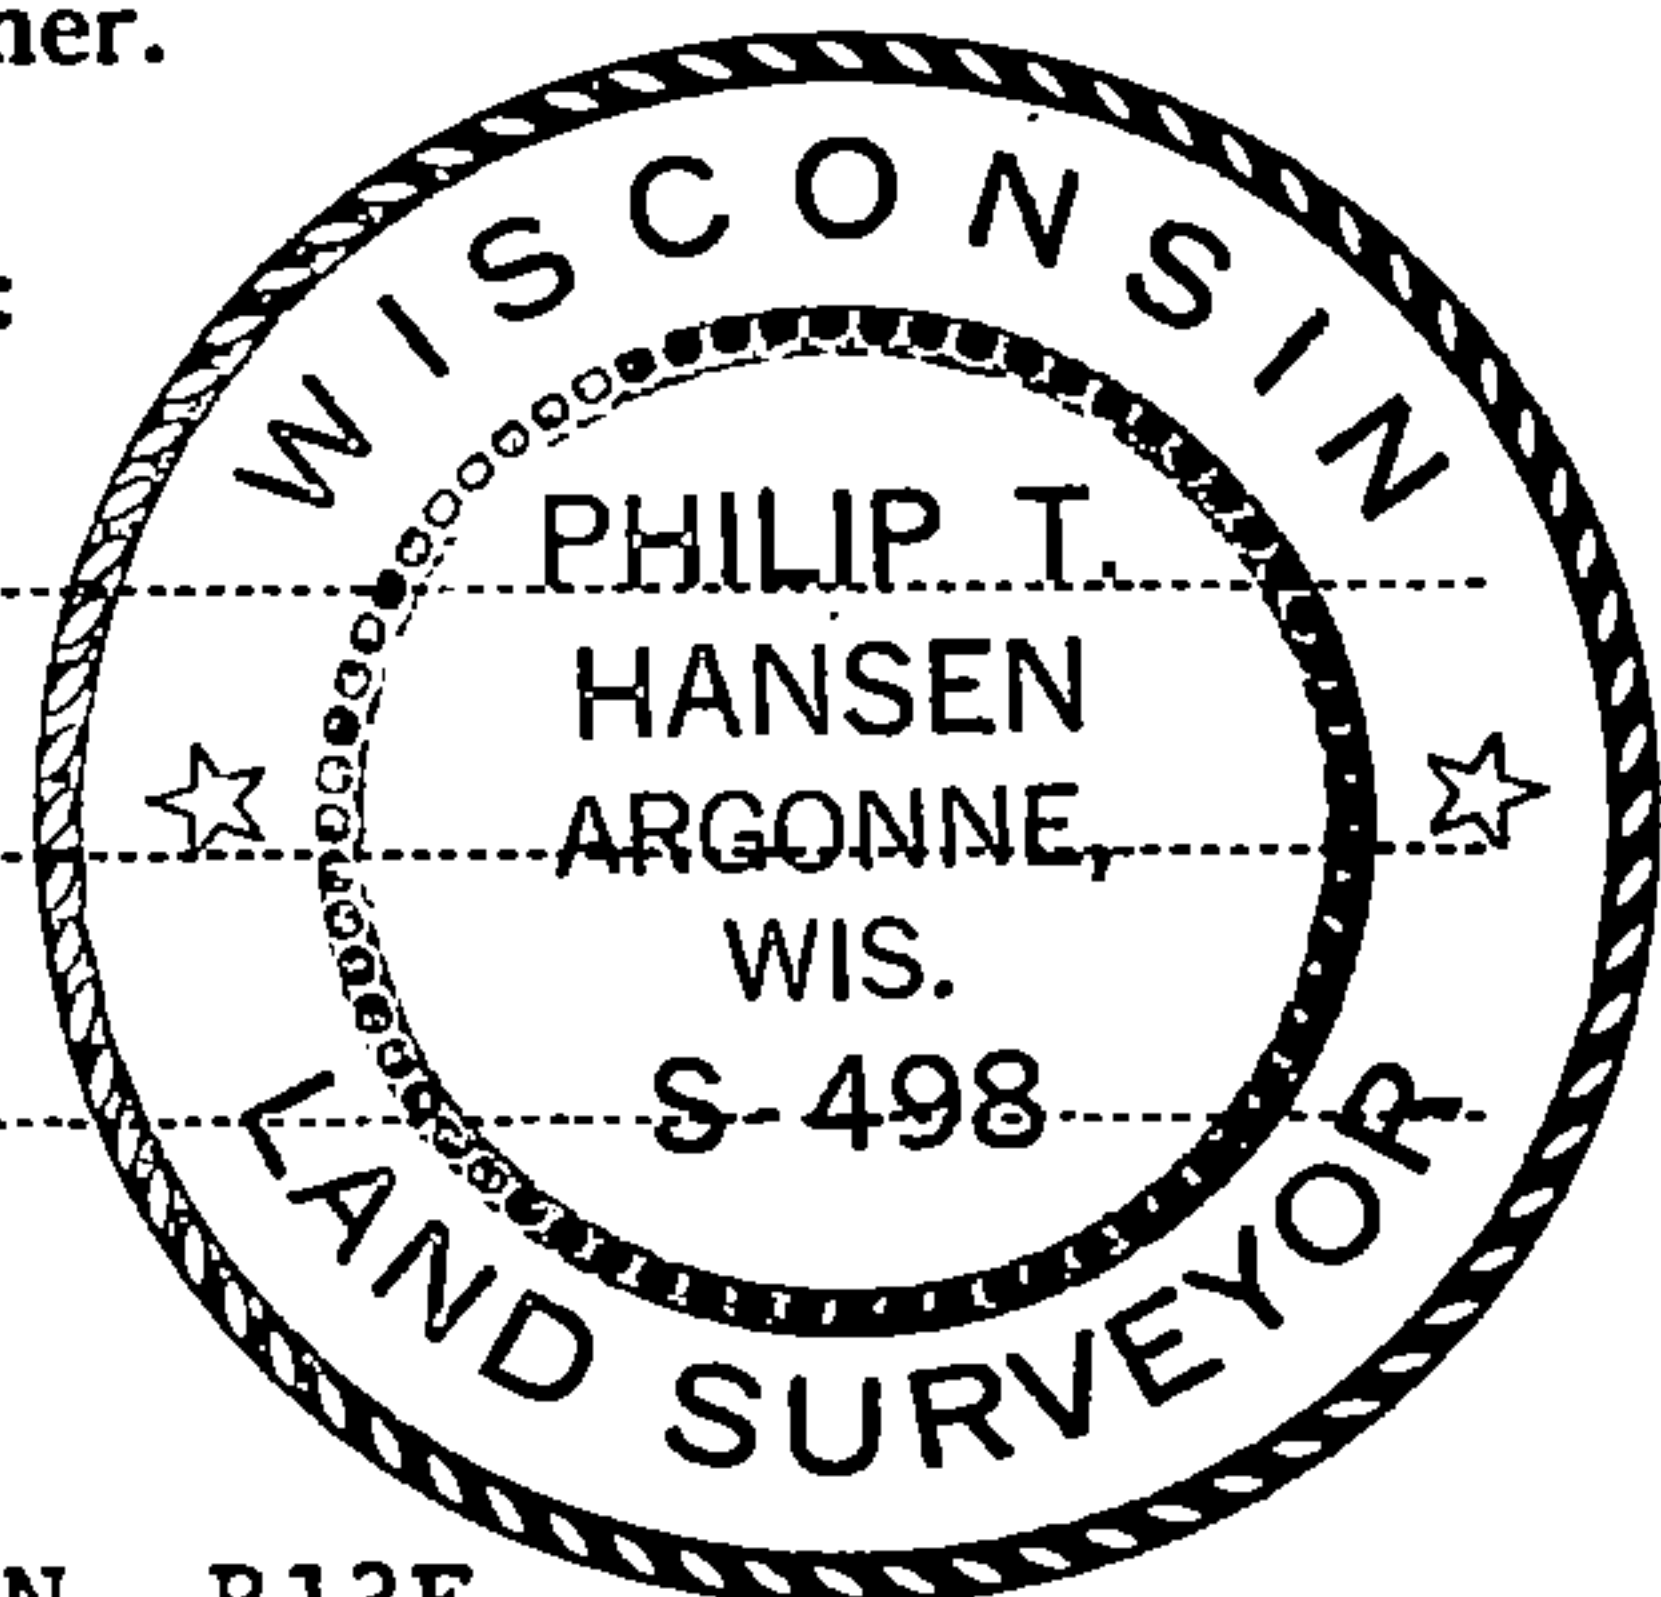

FORM 985 H. C. MILLER CO., MILWAUKEE

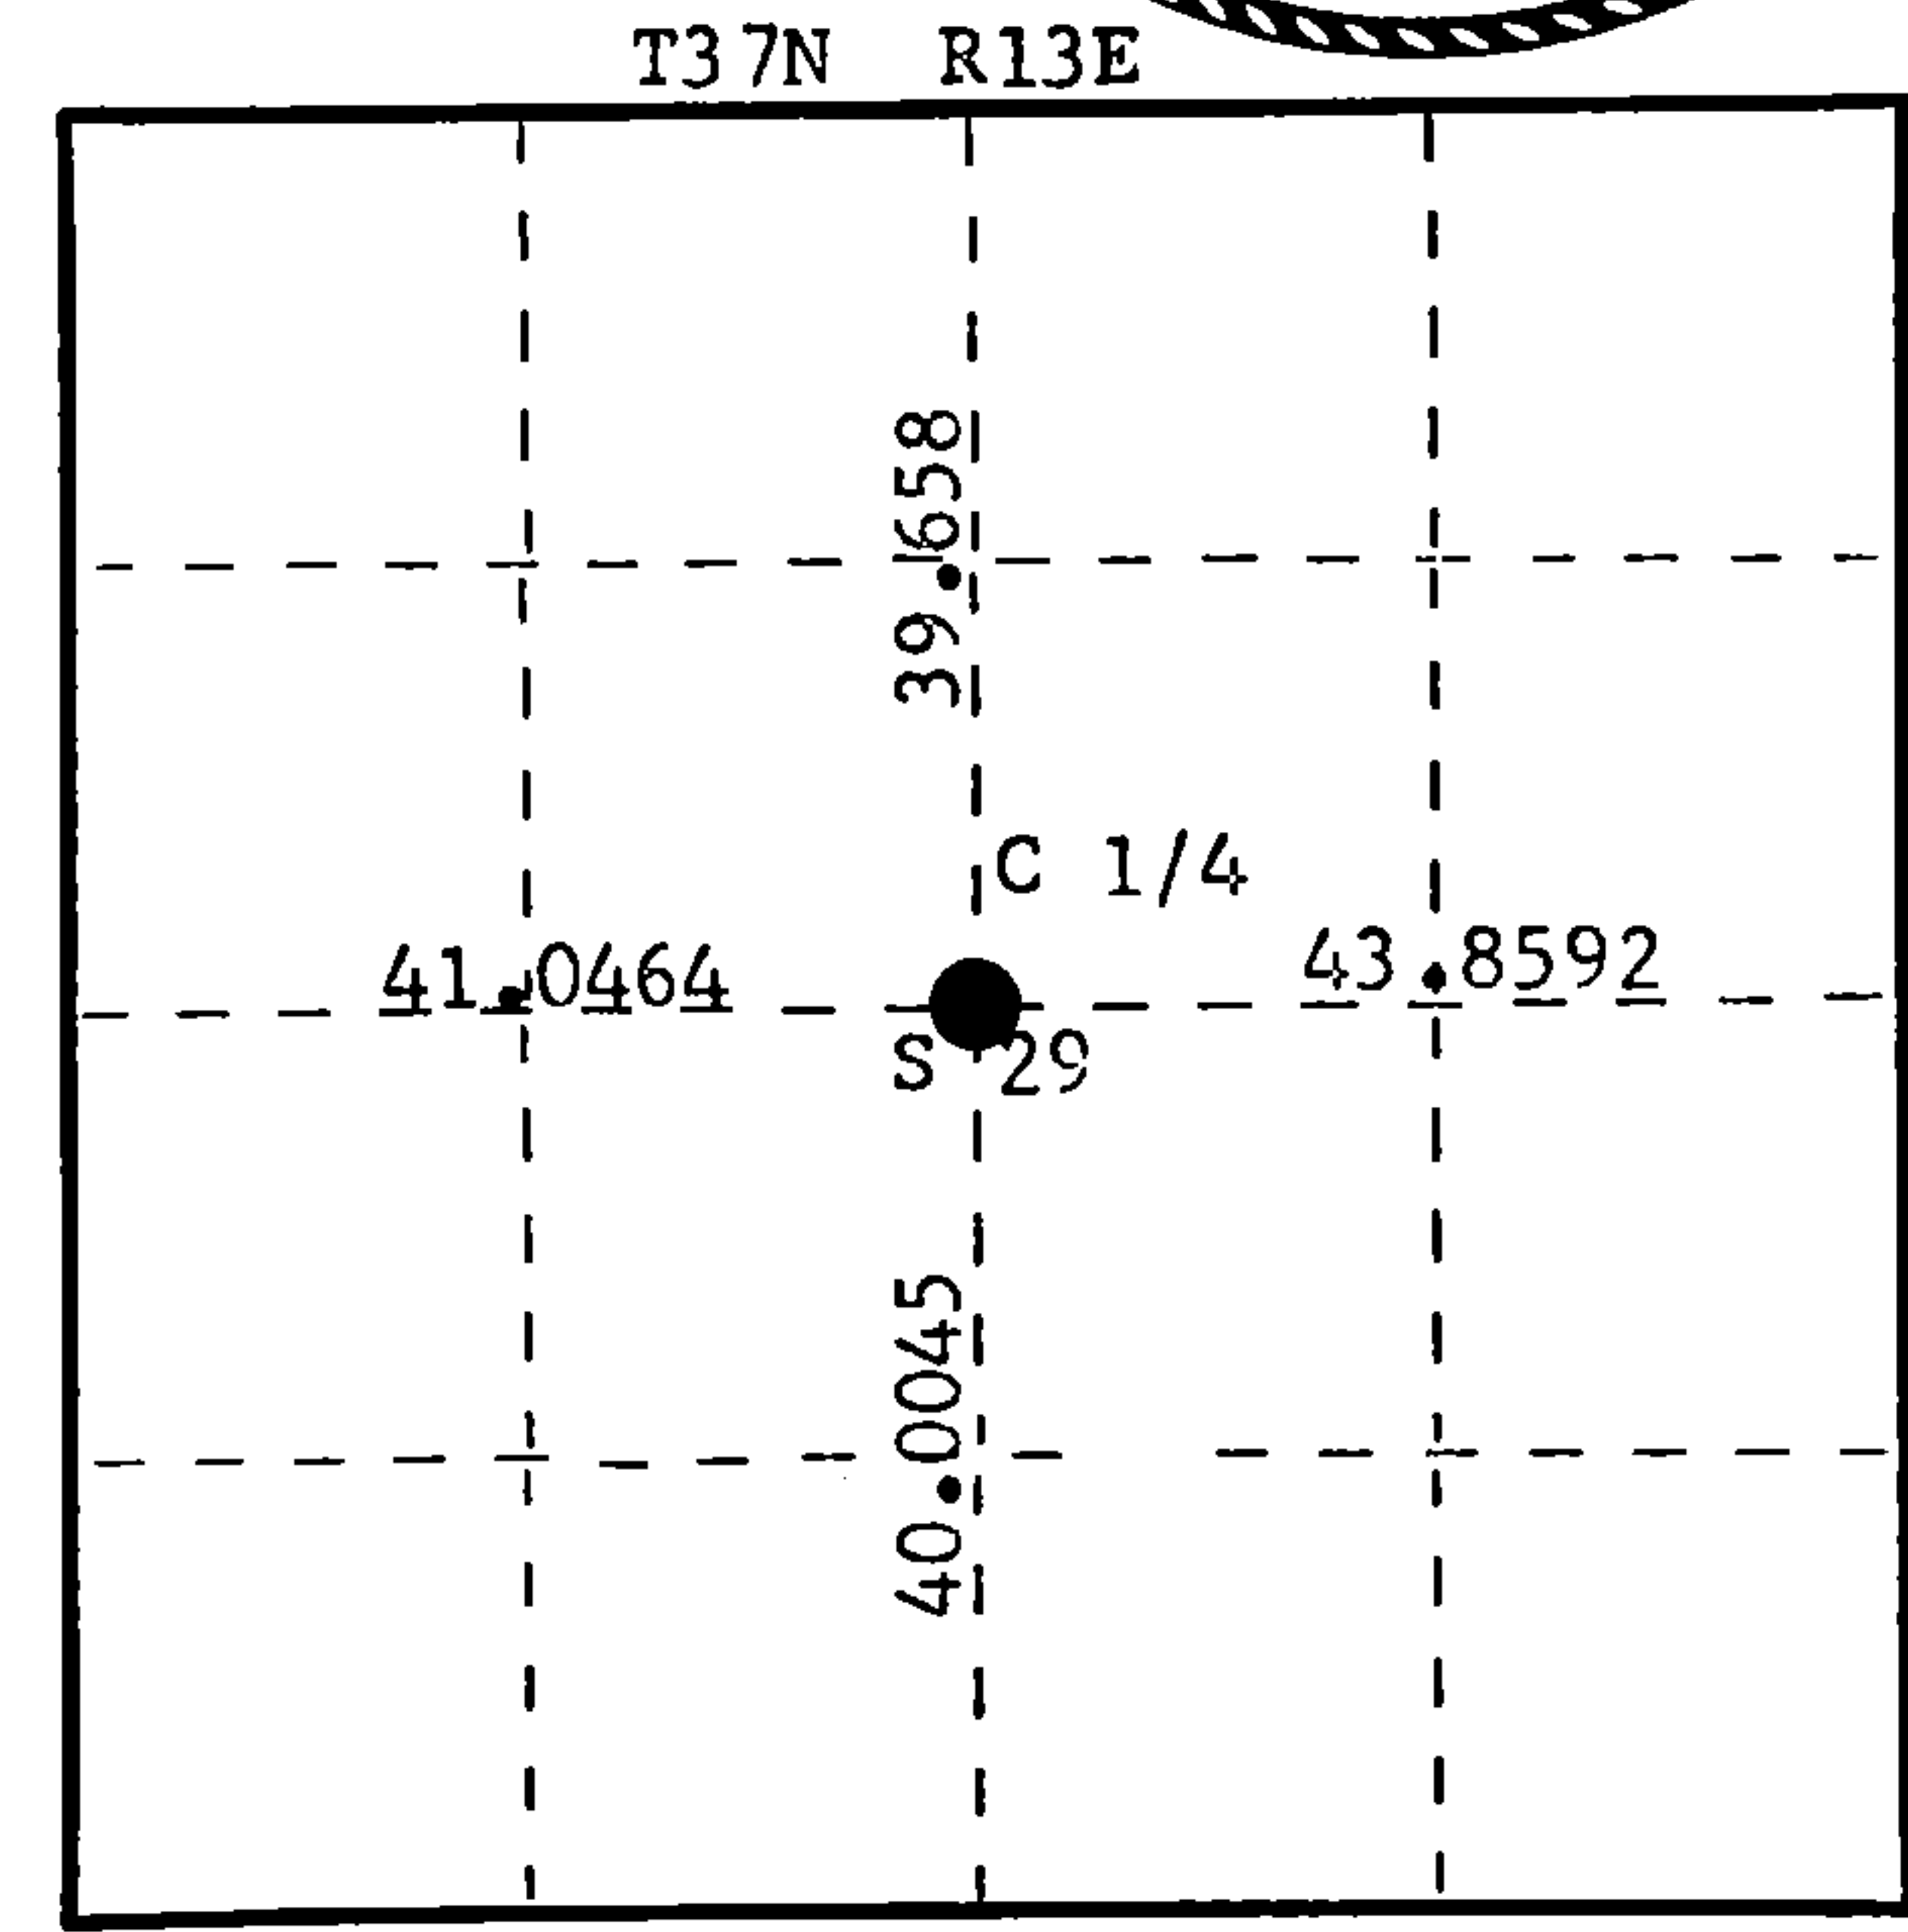

○ = Corner monument restored.

History of original corner establishment:
No records of any previous survey.

Description of corner evidence found:

No evidence of any corner recovered.
Corner established by subdivision of section 29. Ran traverse around the east, north and west side of section 29. Computed position of S 1/4 corner. Computed N-S 1/4 line from S 1/4 to N 1/4. Ran east-west 1/4 line from E 1/4 corner to west 1/4 corner. Corner established in the north ditch line of E-W 1/4 line road.

Description of monument and accessories I established to perpetuate the original location of this corner.

Drove a 1 1/2" x 18" iron pipe in north ditch line for true corner.
Set 2 1/2" Berntsen A-1 federal monument north 55 links for witness corner.
Monument projects 12" above ground. Cap stamped:
Marked NBTs to true corner.

- Tamarack 6" N23°E, 27.55 links
- Tamarack 8" N40°W, 59.6 links
- Tamarack 10" S22°W, 65.6 links, scribed C 1/4 BT.

T37N R13E
C 1/4 ~~29~~ W.C.
S 55 lks to Cor.
S498 - 1977

Dated at Rhineland, Wis., this 3rd day of December, 1977.

Signature Philip T. Hansen Title Registered Land Surveyor Registration No. S-498
(County Surveyor, Registered Land Surveyor, or other duly authorized official)

Office of Register of Deeds, County of Forest, I hereby certify that the within instrument was filed in this office for record on the 11th day of December, 1977 at 3:00 o'clock P. M.

Eugene Stutzman
(Register of Deeds)
By _____ Deputy

DOCUMENT NUMBER ----- **112967**

4371329202D