

CERTIFIED LAND CORNER RESTORATION

Index No. W-5

State of Wisconsin }
County of Forest } ss.


I Philip T. Hansen, do hereby certify that on the 29th day of November, 1977, I ~~found~~ established ~~evidence of the~~ N 1/16 corner of Section 31 & 32 Township 37, North, Range 13 East, Fourth Principal Meridian, as described hereon; and that from this evidence I established a new monument and accessories as described hereon to perpetuate the original location of this corner.

Resident witnesses:


Glen Barker

Jim Claflin

Herb Wagoner

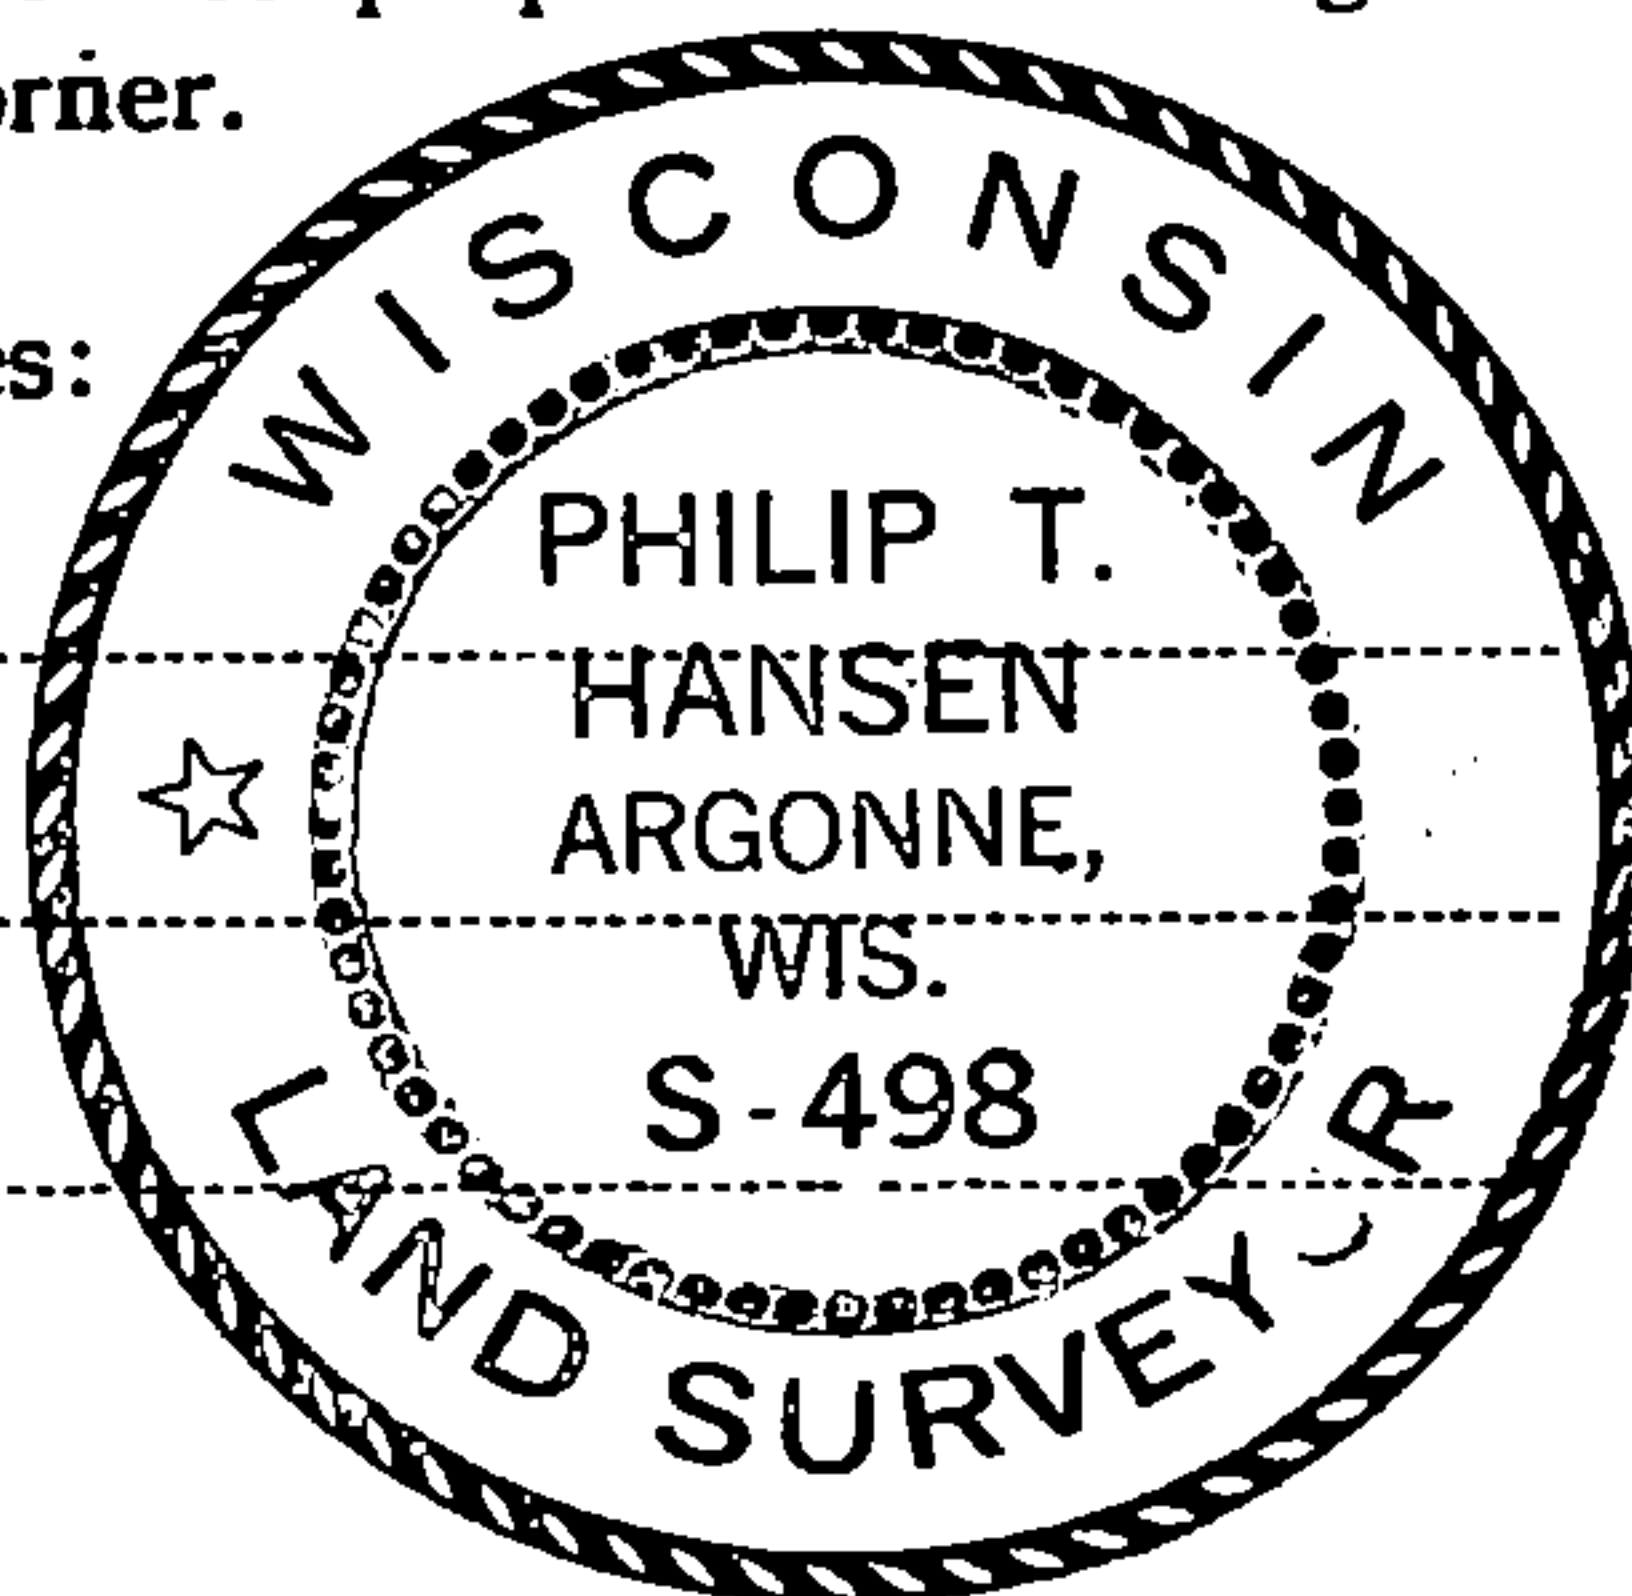

FORM 985 M. C. MILLER CO., MILWAUKEE

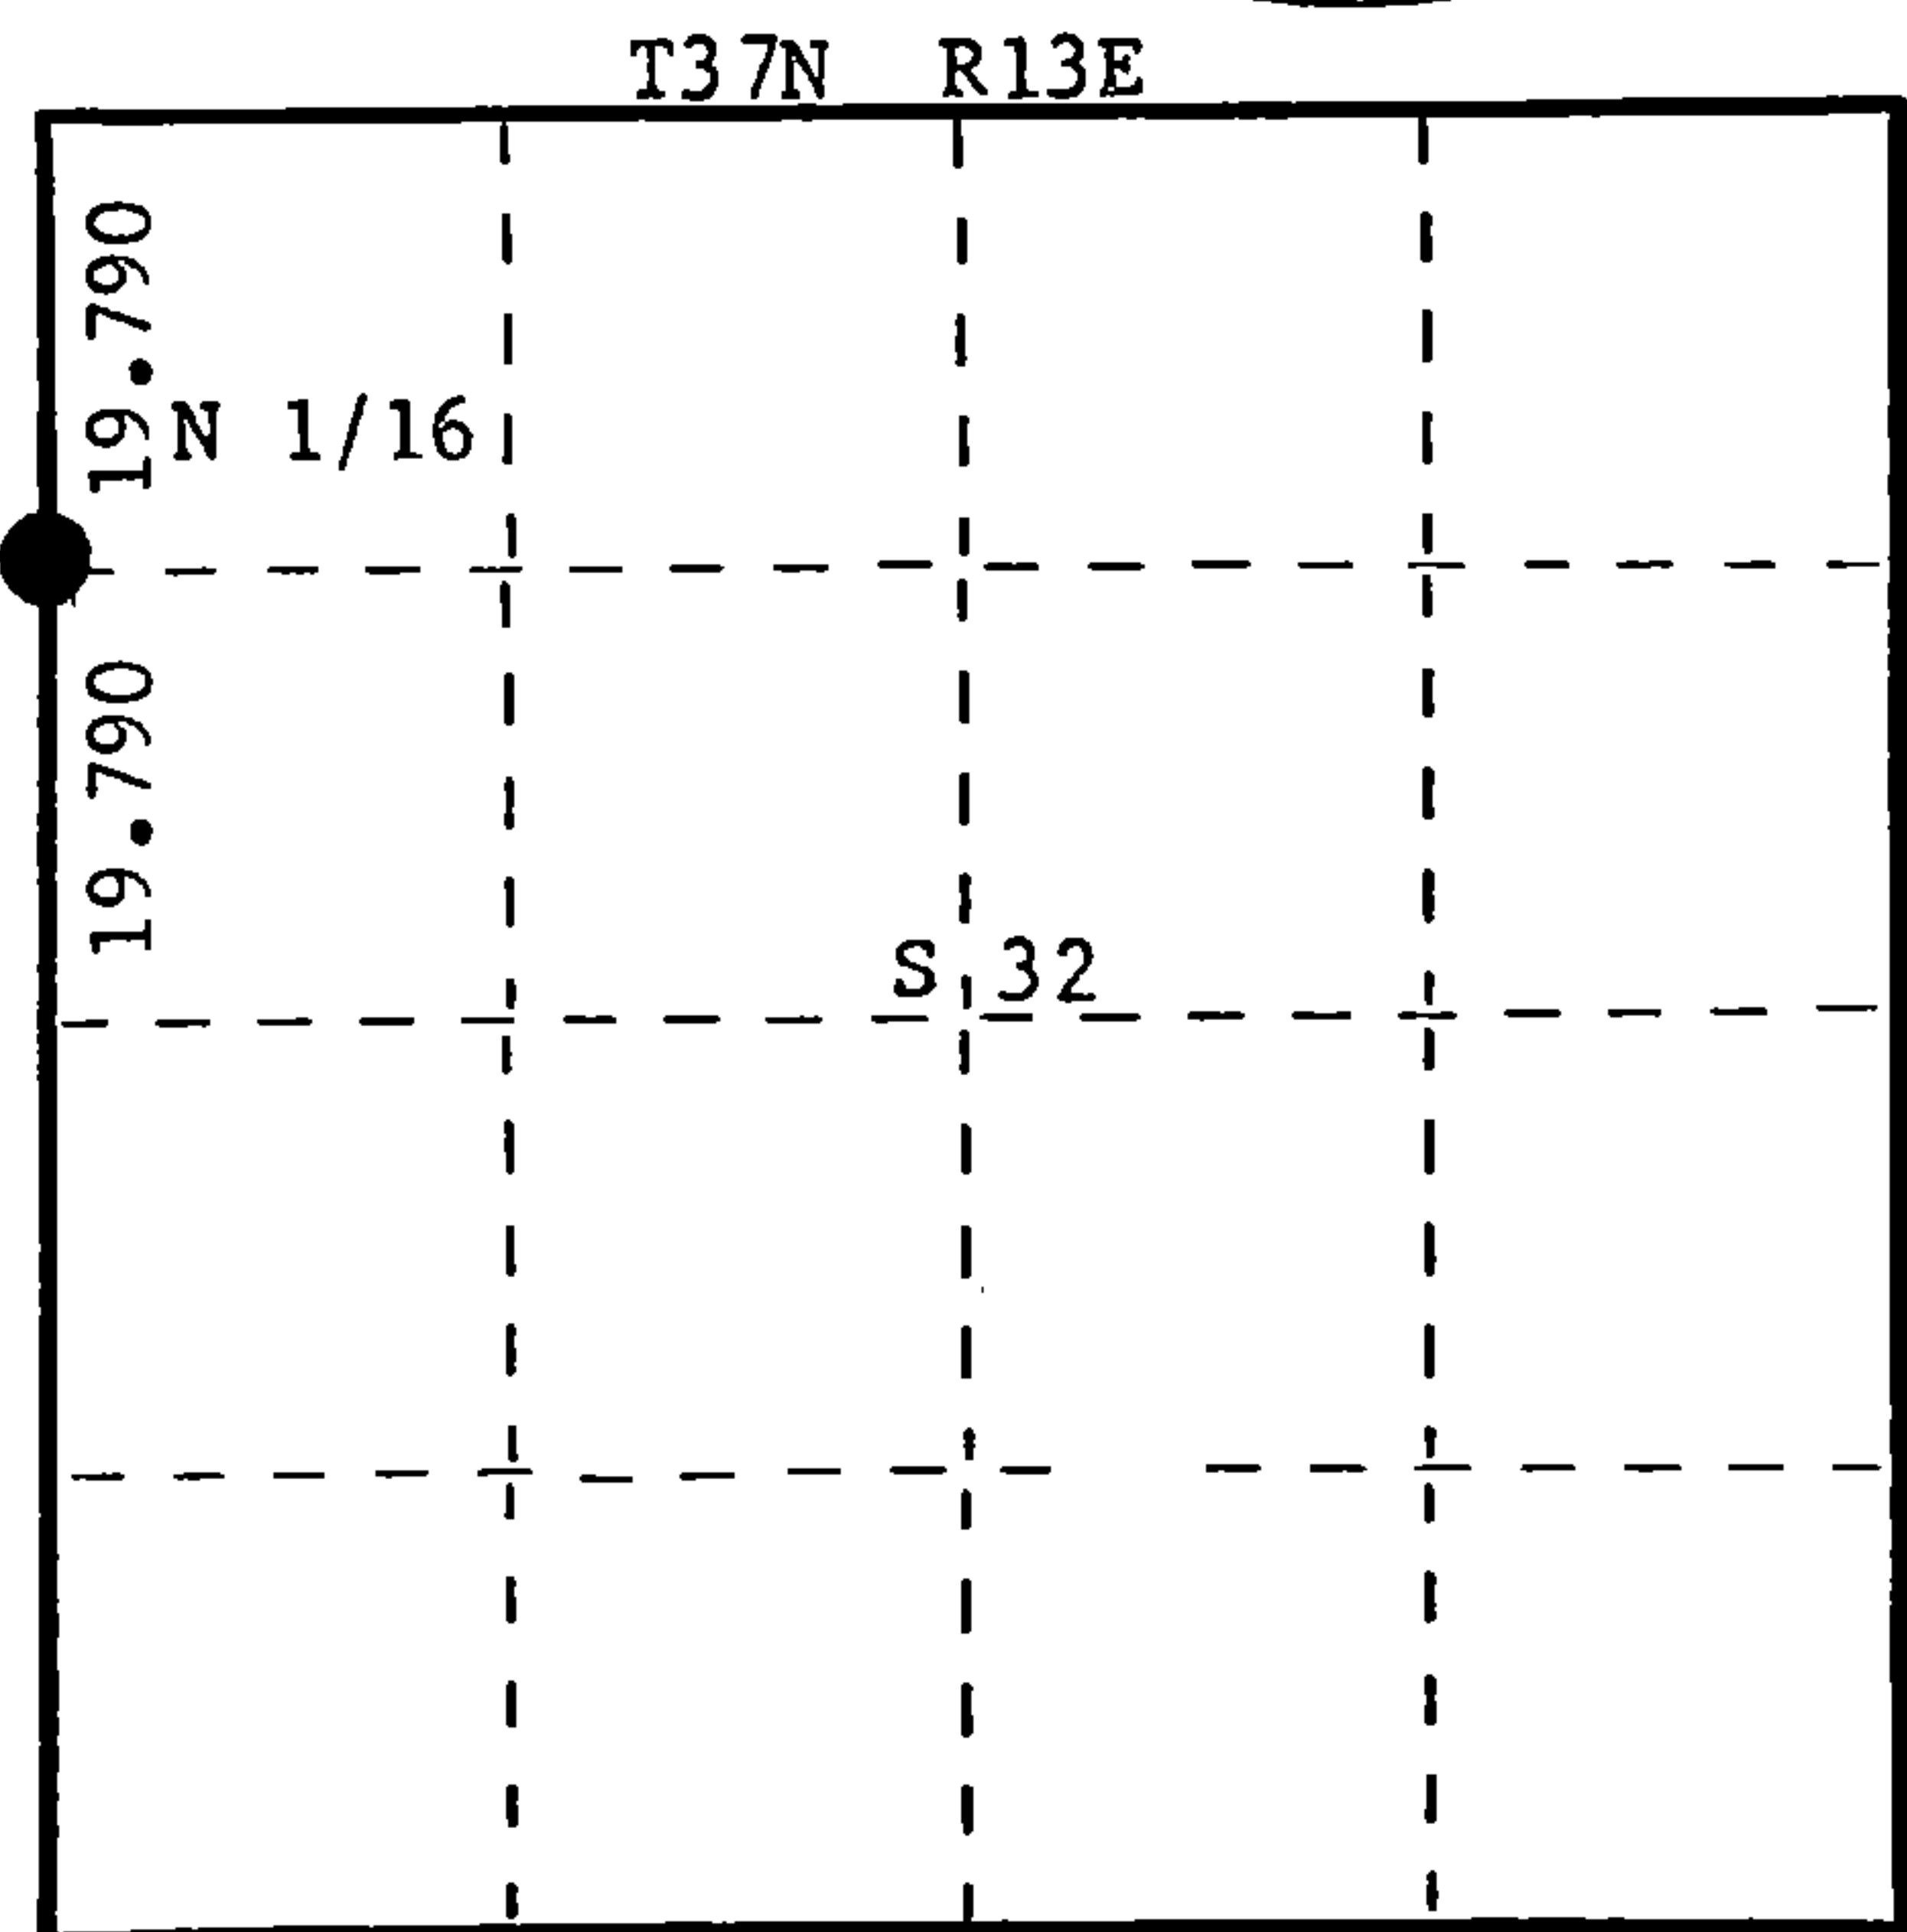

○ = Corner monument restored.

History of original corner establishment:

No record of any previous survey.

Description of corner evidence found:

No evidence of any corner recovered.

Corner established by traverse and proportional measurement. Ran traverse from previously established 1/4 corner between Sections 31 & 32 to Section Corner 29, 30, 31 & 32. Computed distance 2612.23' (39.579 chains), at bearing N 4° 36' 27" W. Established N 1/16 at 19.7896 chains intermediate.

Description of monument and accessories I established to perpetuate the original location of this corner.

Set 1 1/2" iron pipe with 2" brass cap, stamped:

Corner sets in old N-S section line road.

Monument projects 1 ft. above ground.

Drove support stakes beside iron pipe to support it in soft muck. N 1/16

Marked NBTs - Tamarack 14" S23°W, 79.6 links

Tamarack 6" N32°W, 56.7 links, scribed 1/16 BT.

S498

T37N R13E

31 + 32

CPI-1977

Dated at Rhineland, Wis., this 3rd day of December, 1977

Signature Philip T. Hansen Title Registered Land Surveyor Registration No. S-498
(County Surveyor, Registered Land Surveyor, or other duly authorized official)

Office of Register of Deeds, County of Forest, I hereby certify that the within instrument was filed in this office for record on the 11th day of December, 1977 at 3:00 o'clock P. M.

Eugene Staszny
(Register of Deeds)

DOCUMENT NUMBER **112970**

By _____ Deputy

43713313000