

CERTIFIED LAND CORNER RESTORATION

Index No. W-7

State of Wisconsin }
County of Forest } ss.

I Philip T. Hansen, do hereby certify that on the 29th day of November, 19 77, I found evidence of the NC 1/16 corner of Section 32 Township 37, North, Range 13 East, Fourth Principal Meridian, as described hereon; and that from this evidence I established a new monument and accessories as described hereon to perpetuate the original location of this corner.

History of original corner establishment:
No records of any previous survey.

Description of corner evidence found:


Recovered very old 3" squared tamarack post in muck at north end of N-S 1/4 line fence. Also found a 3" squared cedar stake east 38.3 links with scribing visible. Accepted the older post at termination of fence line as the NC 1/16 corner.

Resident witnesses:

Glen Barker

Jim Claflin

Herb Wagoner

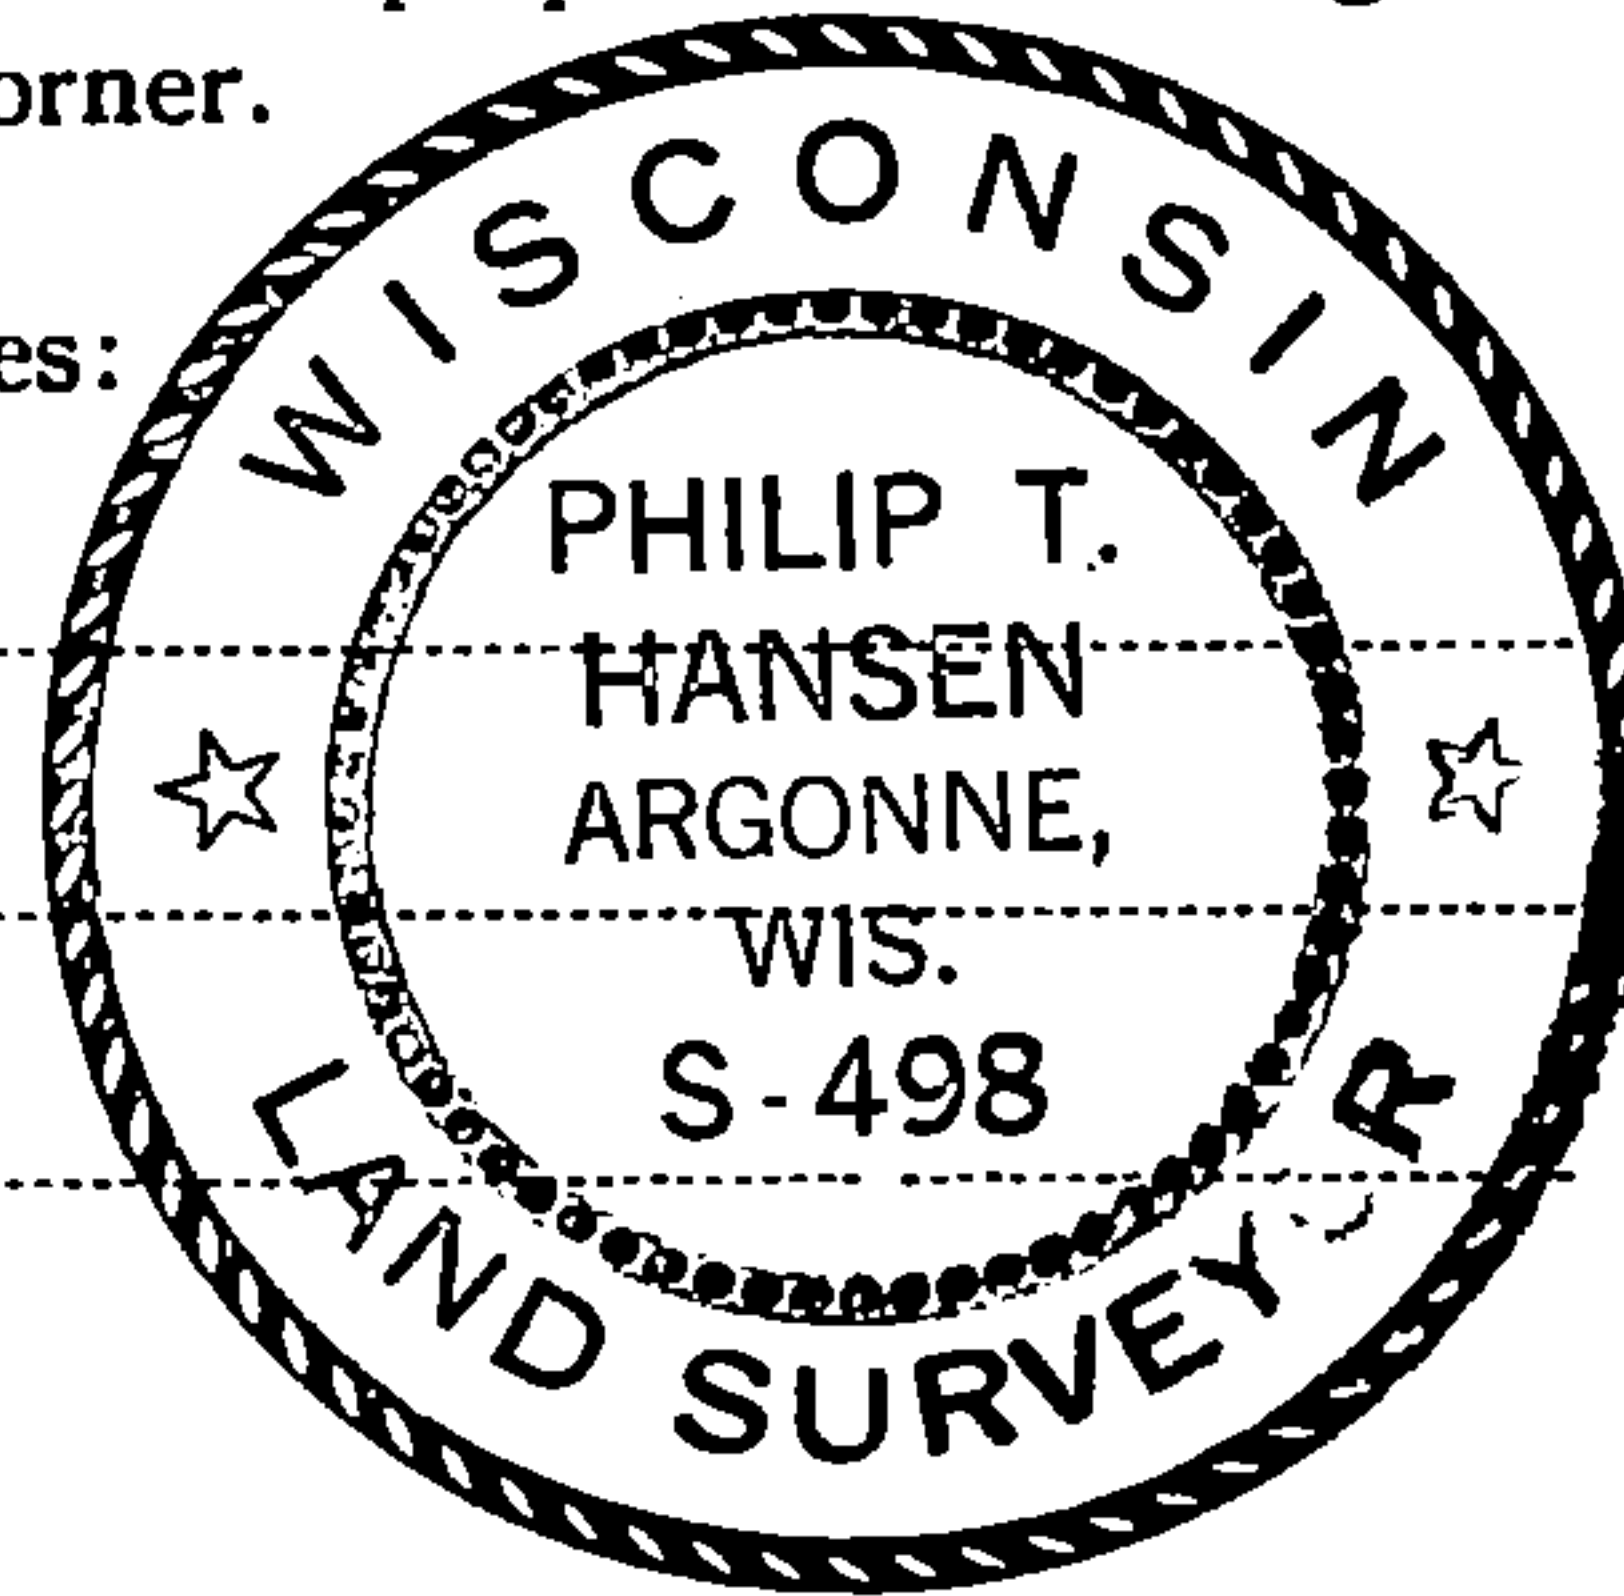


Description of monument and accessories I established to perpetuate the original location of this corner.

Replaced old tamarack post with 1 1/2" iron pipe with 2" brass cap, stamped: Monument projects 1' above ground. Marked NBT - Cedar 5" N13°W, 109.5 links. Corner sets in a small black spruce swamp. No other BTs suitable.

S498
T37N R13E
NC 1/16 S 32
CPI-1977

FORM 985 H. C. MILLER CO., MILWAUKEE

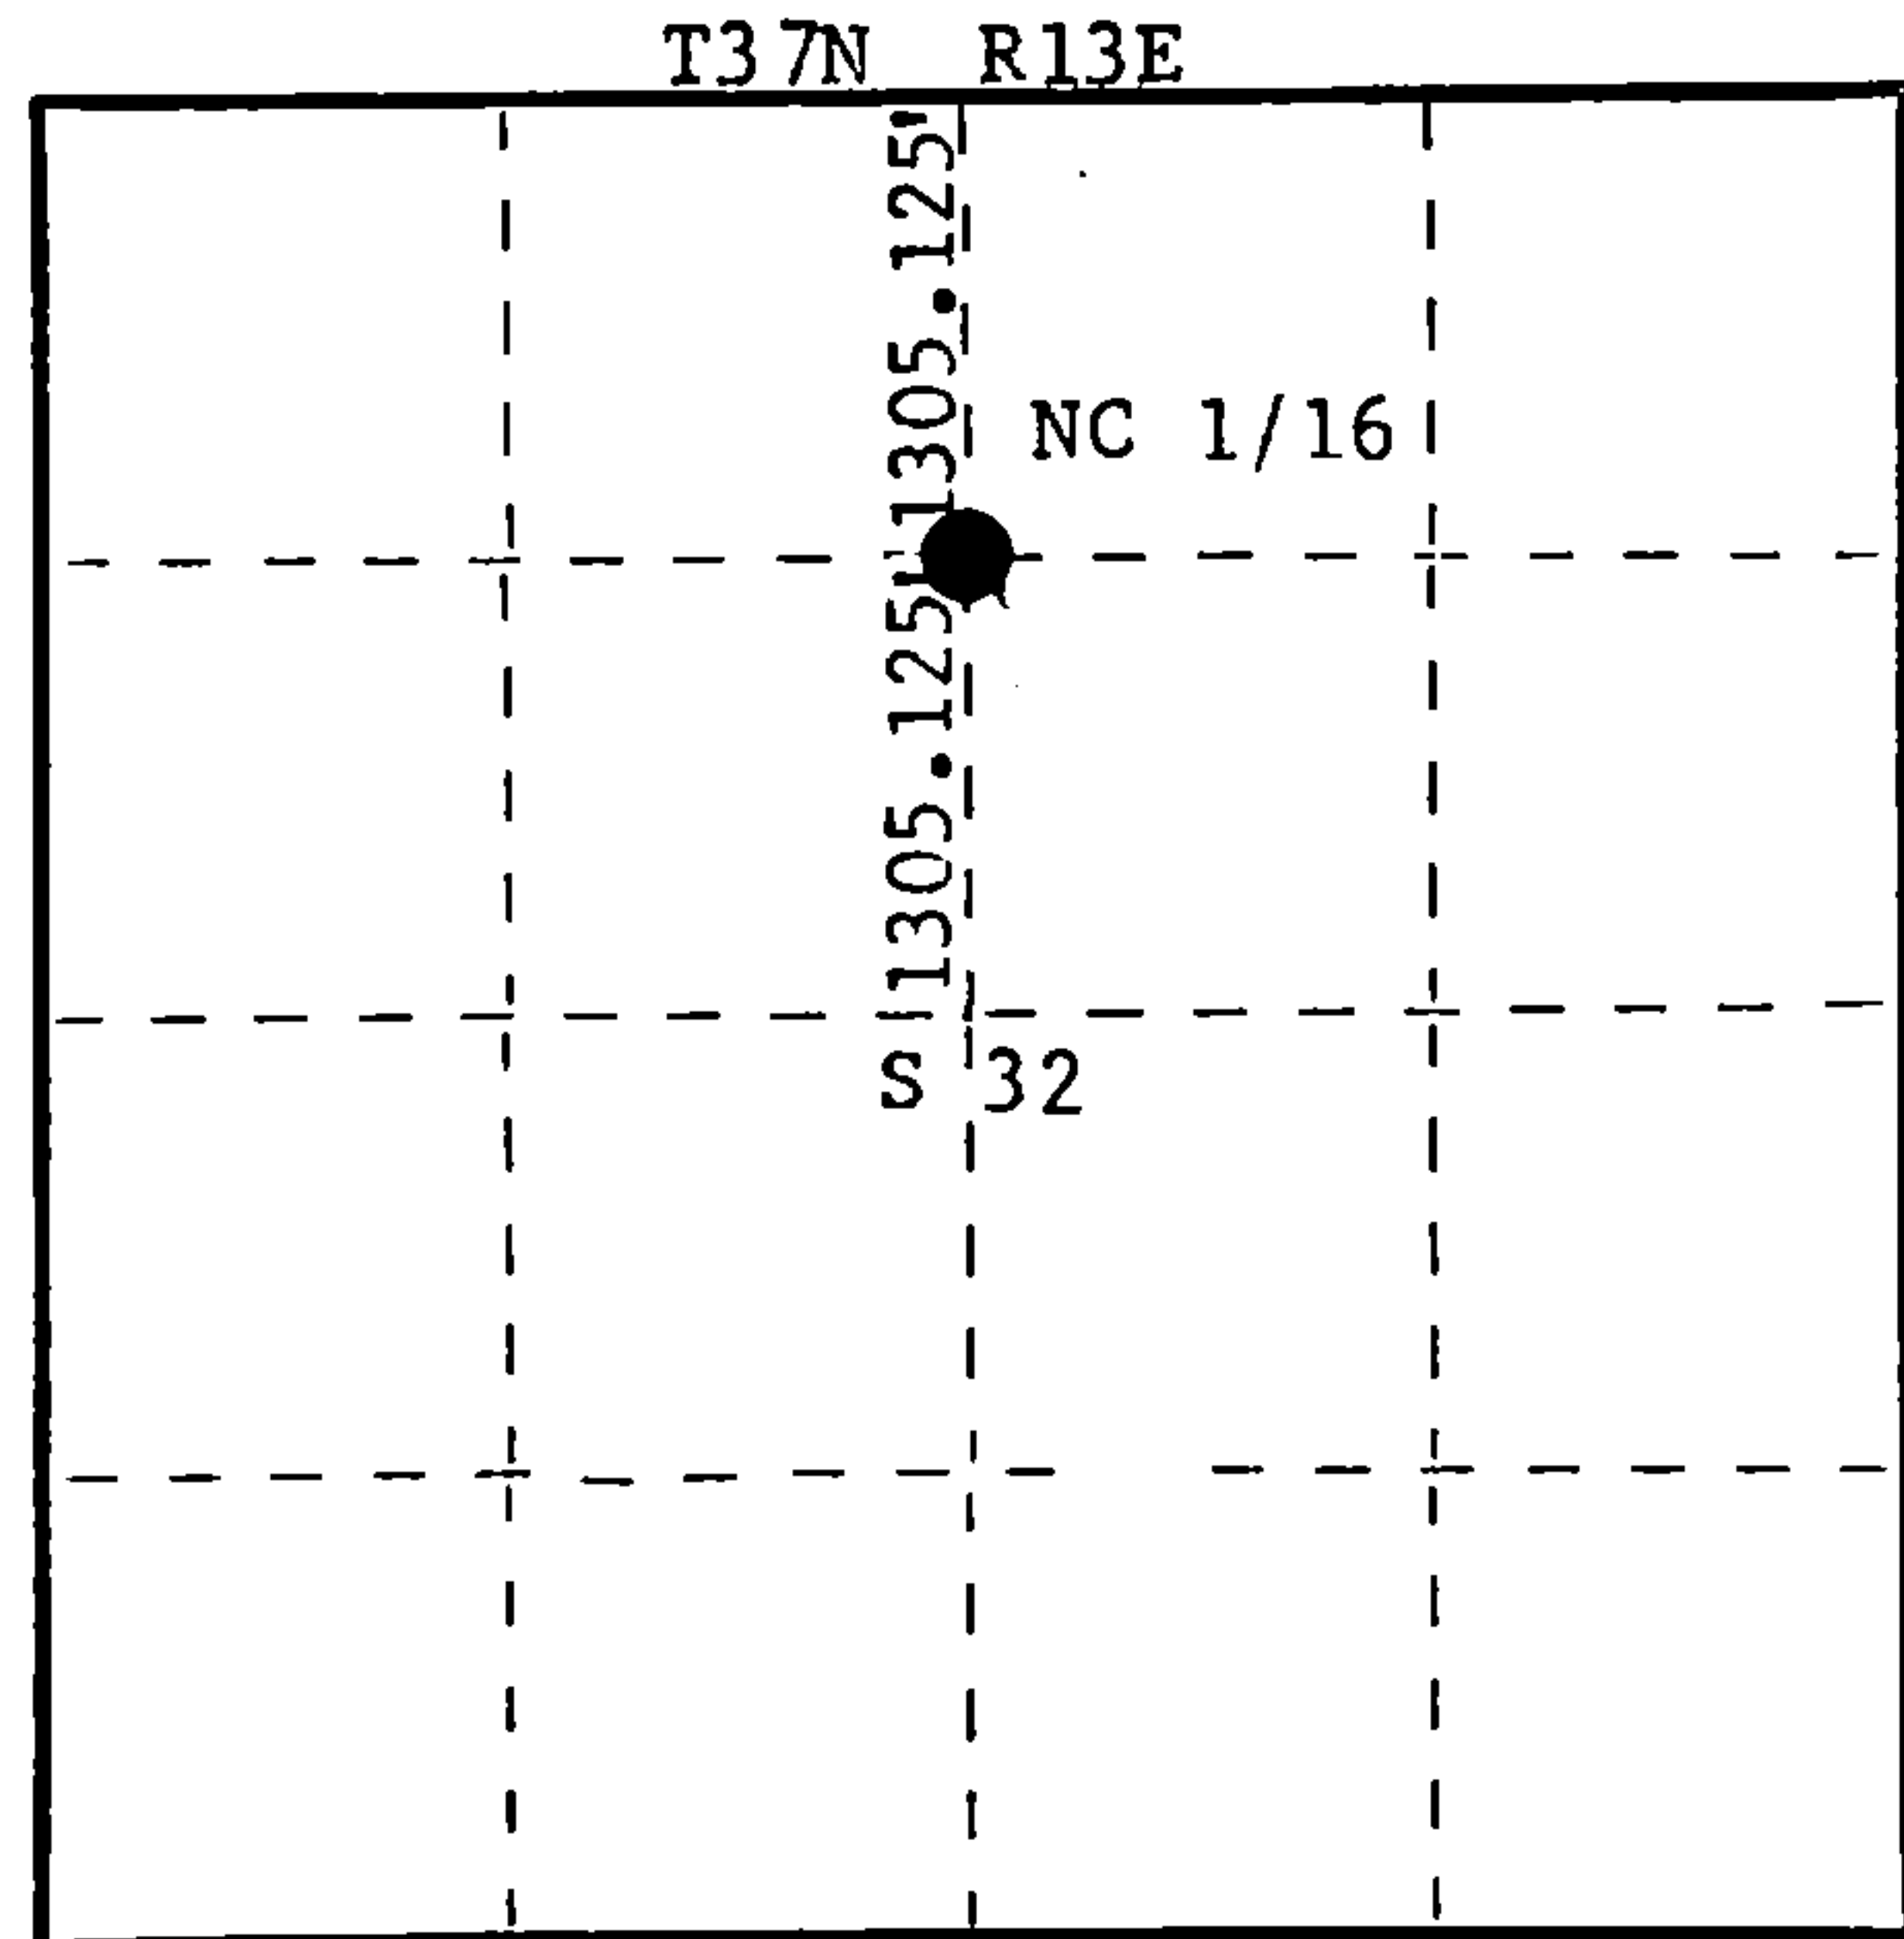

○ = Corner monument restored.

Dated at Rhineland, Wis., this 3rd day of December, 19 77

Signature Philip T. Hansen Title Registered Land Surveyor Registration No. _____
(County Surveyor, Registered Land Surveyor, or other duly authorized official)

Office of Register of Deeds, County of Forest, I hereby certify that the within instrument was filed in this office for record on the 14th day of December, 19 77 at 3:00 o'clock P. M.

Eugene Stetson
(Register of Deeds)
By _____ Deputy

DOCUMENT NUMBER - - - **112971**

43713323020