

CERTIFIED LAND CORNER RESTORATION


Index No. **A 21**

State of Wisconsin }
County of Forest } ss.

I Thomas R. Arnott, do hereby
certify that on the 17th day
of October, 19 75, I found
evidence of the section
corner of sections 1, 2, 35 & 36
Township 36-37, North, Range
13 E, Fourth Principal Meridian,
as described hereon; and that from this evidence
I established a new monument and accessories
as described hereon to perpetuate the original
location of this corner.

Resident witnesses:

Herbert Wagoner

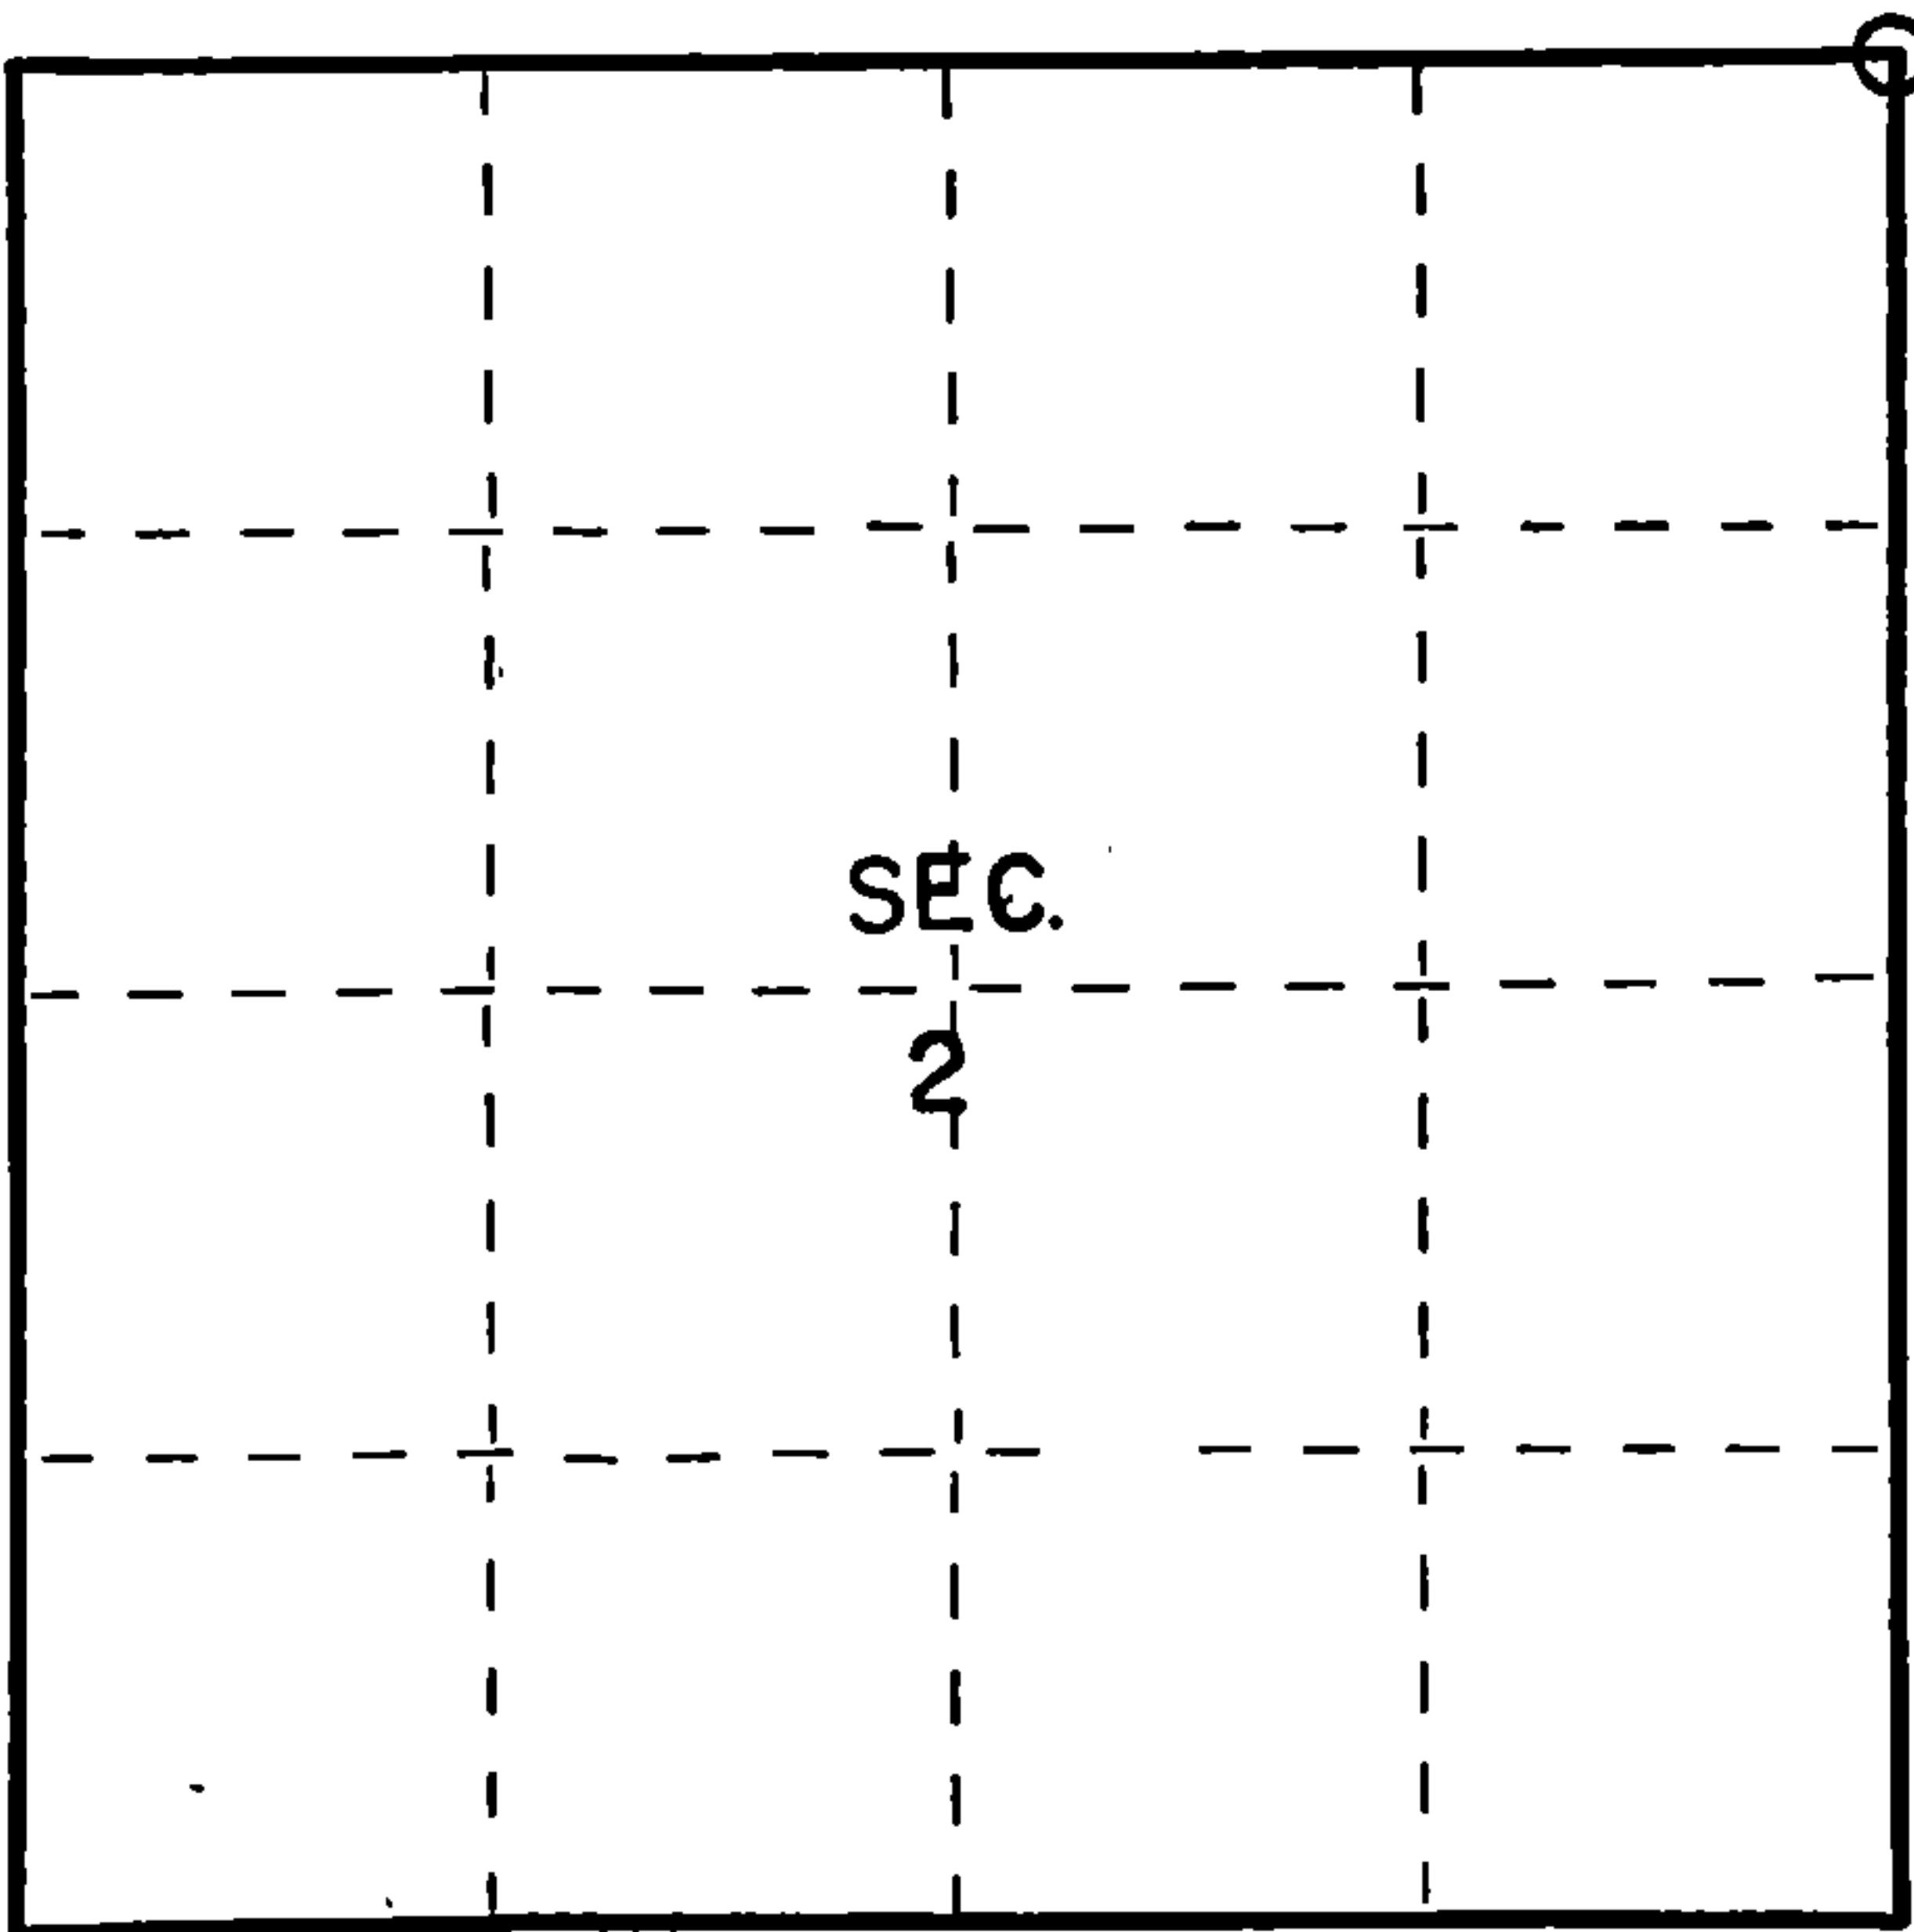

○ = Corner monument restored.

History of original corner establishment:

Elm	12	N24W	28	Lks.
Elm	15	N44E	54	Lks.
Y. Birch	12	S55E	45	Lks.
Y. Birch	22	S20W	7	Lks.

Description of corner evidence found:

**2" iron pipe 5' long set by C.E. Walker in 1938 with brass cap
Offset 25 feet west of corner**

Description of monument and accessories I established to perpetuate the original location of this corner.

**Left monument set by Walker
Set 1 1/4" iron pipe at corner to ground level
Ties:
Walker Mon. West 25 feet
guy pole (3613-2E1) S29W 37.65 feet
power pole (3613-1W1) S38E 41.85 feet**



Dated at Crandon Wis., this 23rd day of October, 1975

Signature Thomas R. Arnott Title Land Surveyor Registration No. S-887
(County Surveyor, Registered Land Surveyor, or other duly authorized official)

Office of Register of Deeds, County of Forest, I hereby certify that the within
instrument was filed in this office for record on the 27th day of October, 1975
at 8:30 o'clock A. M.

Eugene Staszny Document Number **108046**
(Register of Deeds)
By _____ Deputy

FORM 985 H. C. MILLER CO., MILWAUKEE

4371335000