


CERTIFIED LAND CORNER RESTORATION

Index No. **X21**


State of Wisconsin }
County of Forest } ss.

I Daniel K. Pleoger, do hereby
certify that on the 23 day
of October, 19 81, I found
Est. ~~evidence~~ of the Quarter
corner of Sections 35 & 36
Township 37
13 East, Fourth Principal Meridian,
as described hereon; and that from this evidence
I established a new monument and accessories
as described hereon to perpetuate the original
location of this corner.

Resident witness:

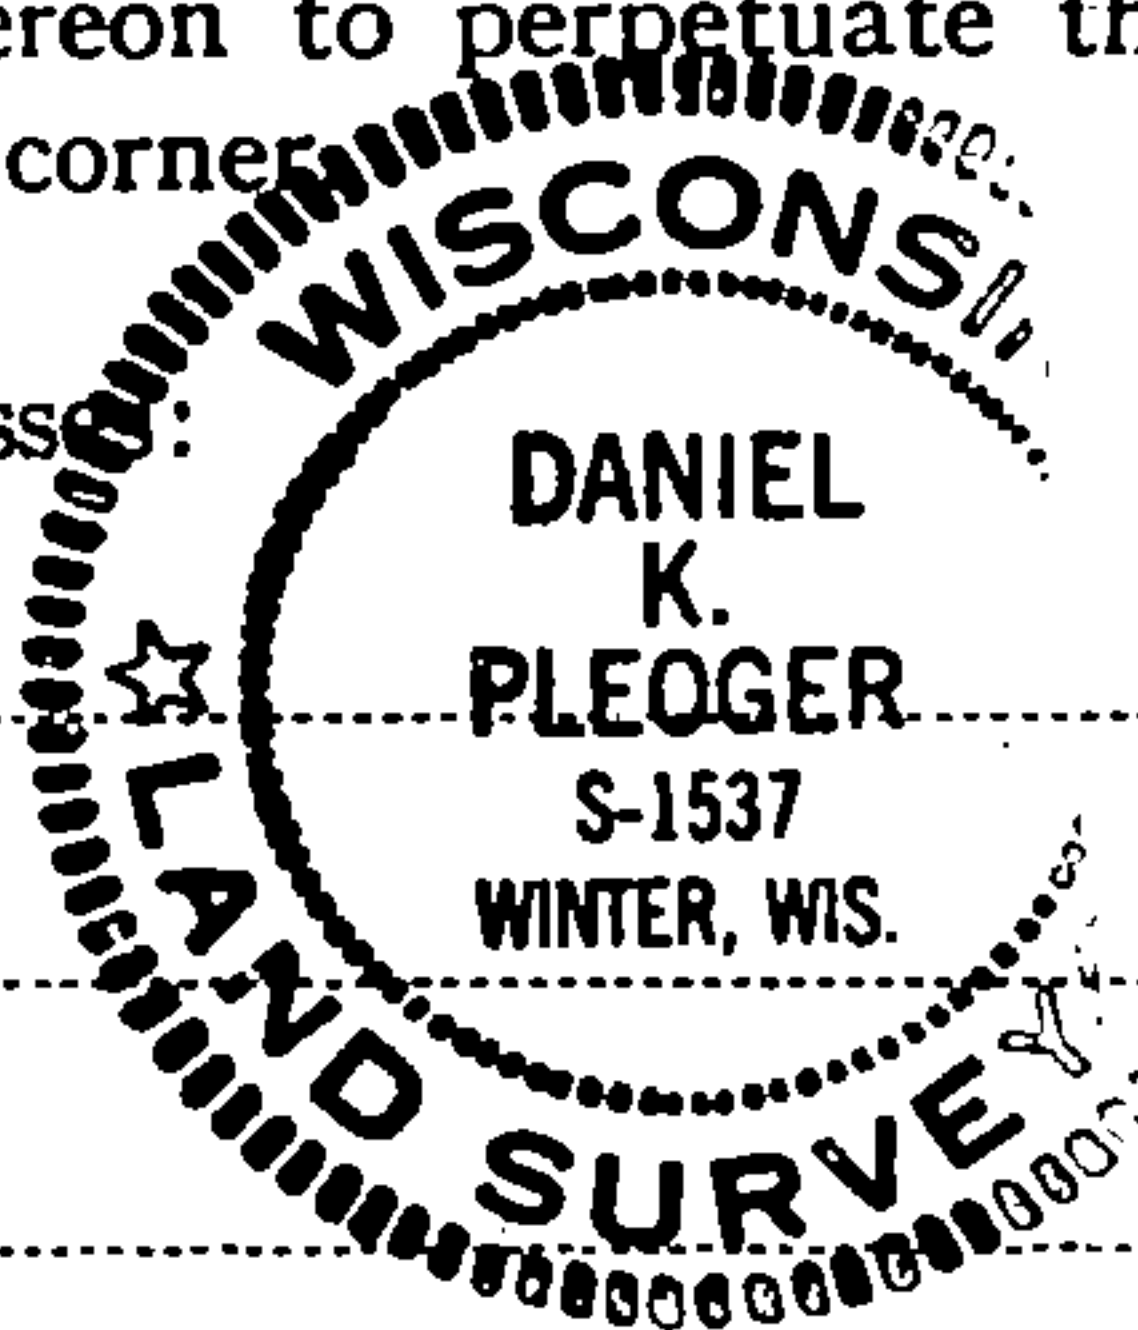

FORM 985 M.C. MILLER CO., MILWAUKEE

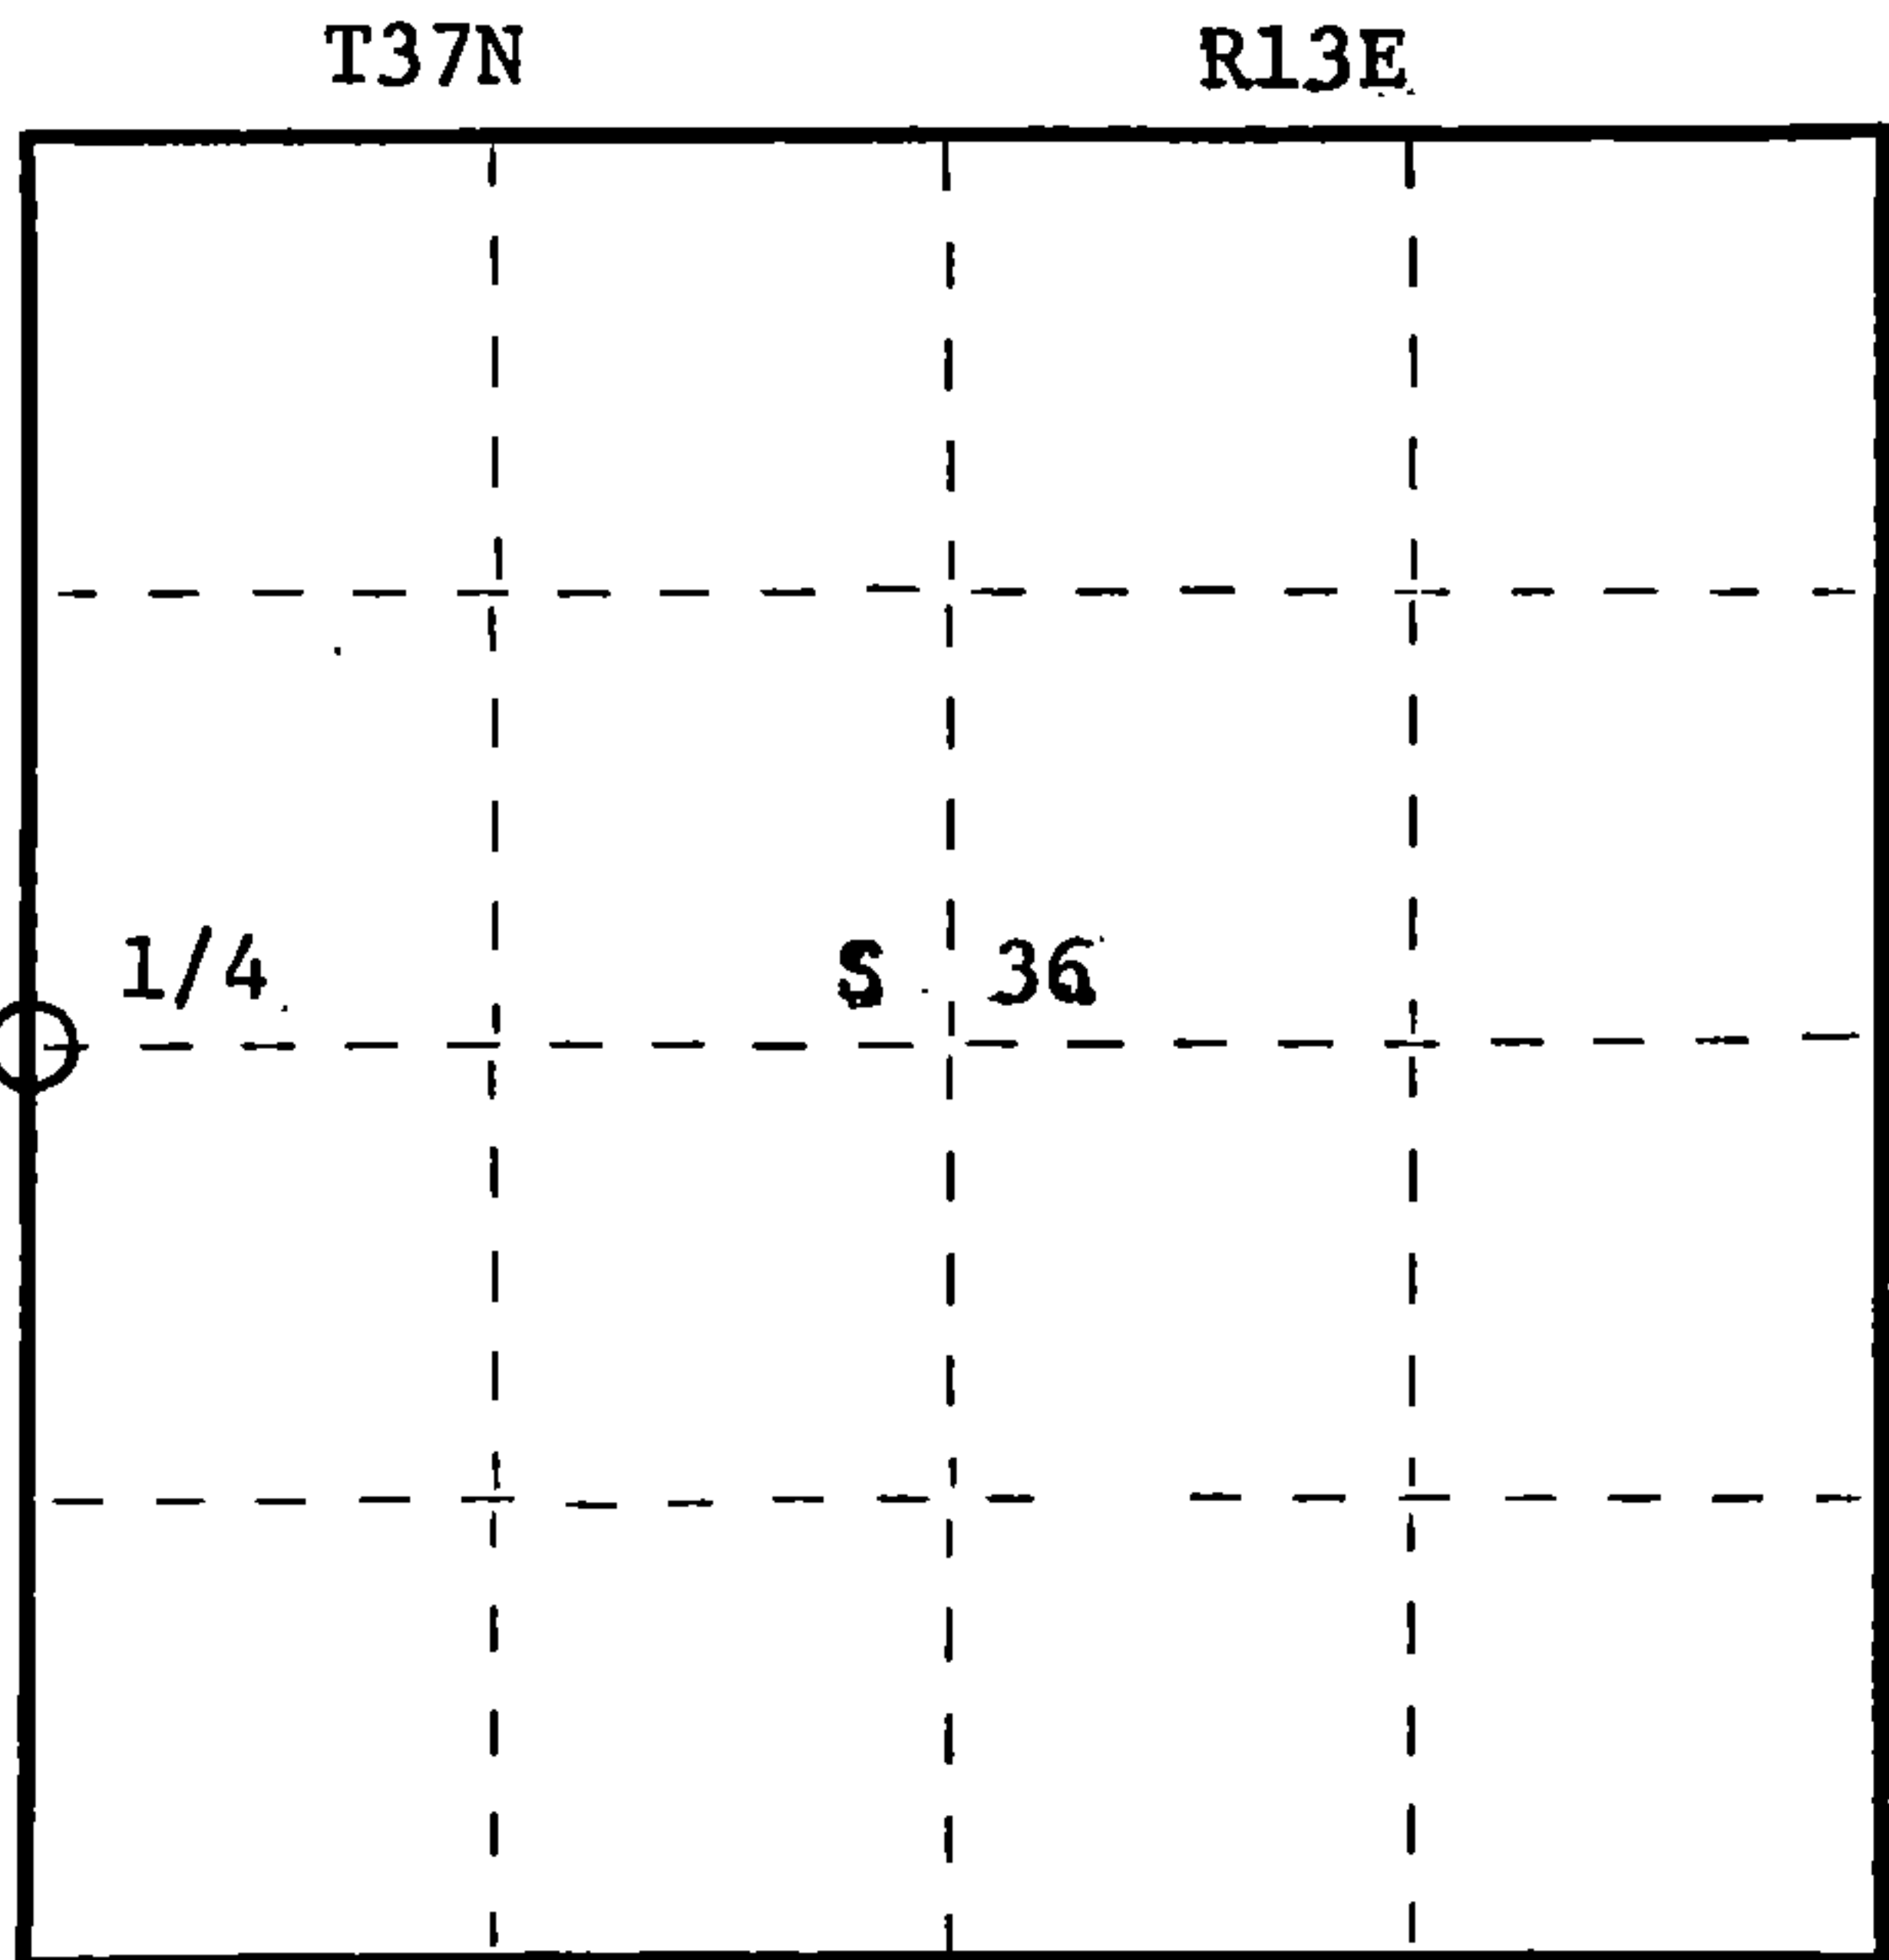

○ = Corner monument restored.

History of original corner establishment:

Original corner established by James L. Nowlin, Gov. Deputy Surveyor in 1865 from which
hemlock 12" S32E 18 lks and hemlock 8" bears N36W 40 lks.

Description of corner evidence found:

Established corner in intersection of C.T.H. "P" running west and north and Hageman
Lane running south and new fence built over an old fence running east.

Description of monument and accessories I established to perpetuate the original location of this corner.

Set a railroad spike in black top surface for true corner.
Set a 2½" aluminum A-1 Federal monument 21.88 ft. east of true corner, for
witness corner cap stamped:

Monument projects 18" above ground
Marked NBT to true corner
Cherry 7" S48E 58.22 ft.
B.O. - power pole #3713 - 36W10 N15E 101.94 ft. (nail)

T37N R13E
1/4 35 36 W.C.
W. 21.88 ft. to Cor.
S1537 - 1981

Dated at Rhinelander, Wis., this 3rd day of November, 19 81.

Signature Daniel K. Pleoger Title Registered Land Surveyor Registration No. 1537
(County Surveyor, Registered Land Surveyor, or other duly authorized official)

Office of Register of Deeds, County of Forest, I hereby certify that the within
instrument was filed in this office for record on the 9th day of April, 19 82
at 11:00 o'clock A. M.

(Register of Deeds)

DOCUMENT NO. **121387**

By _____ Deputy

43713352000