

CERTIFIED LAND CORNER RESTORATION

Index No. **A 23**


State of Wisconsin }
County of Forest } ss.

I Philip T. Hansen, do hereby certify that on the 31st day of December, 19 75, I found evidence of the Quarter corner of Section 1 and 36 Township 36 & 37, North, Range 13 East, Fourth Principal Meridian, as described hereon; and that from this evidence I established a new monument and accessories as described hereon to perpetuate the original location of this corner.


Resident witnesses:

Glen Barker

Jim Claflin

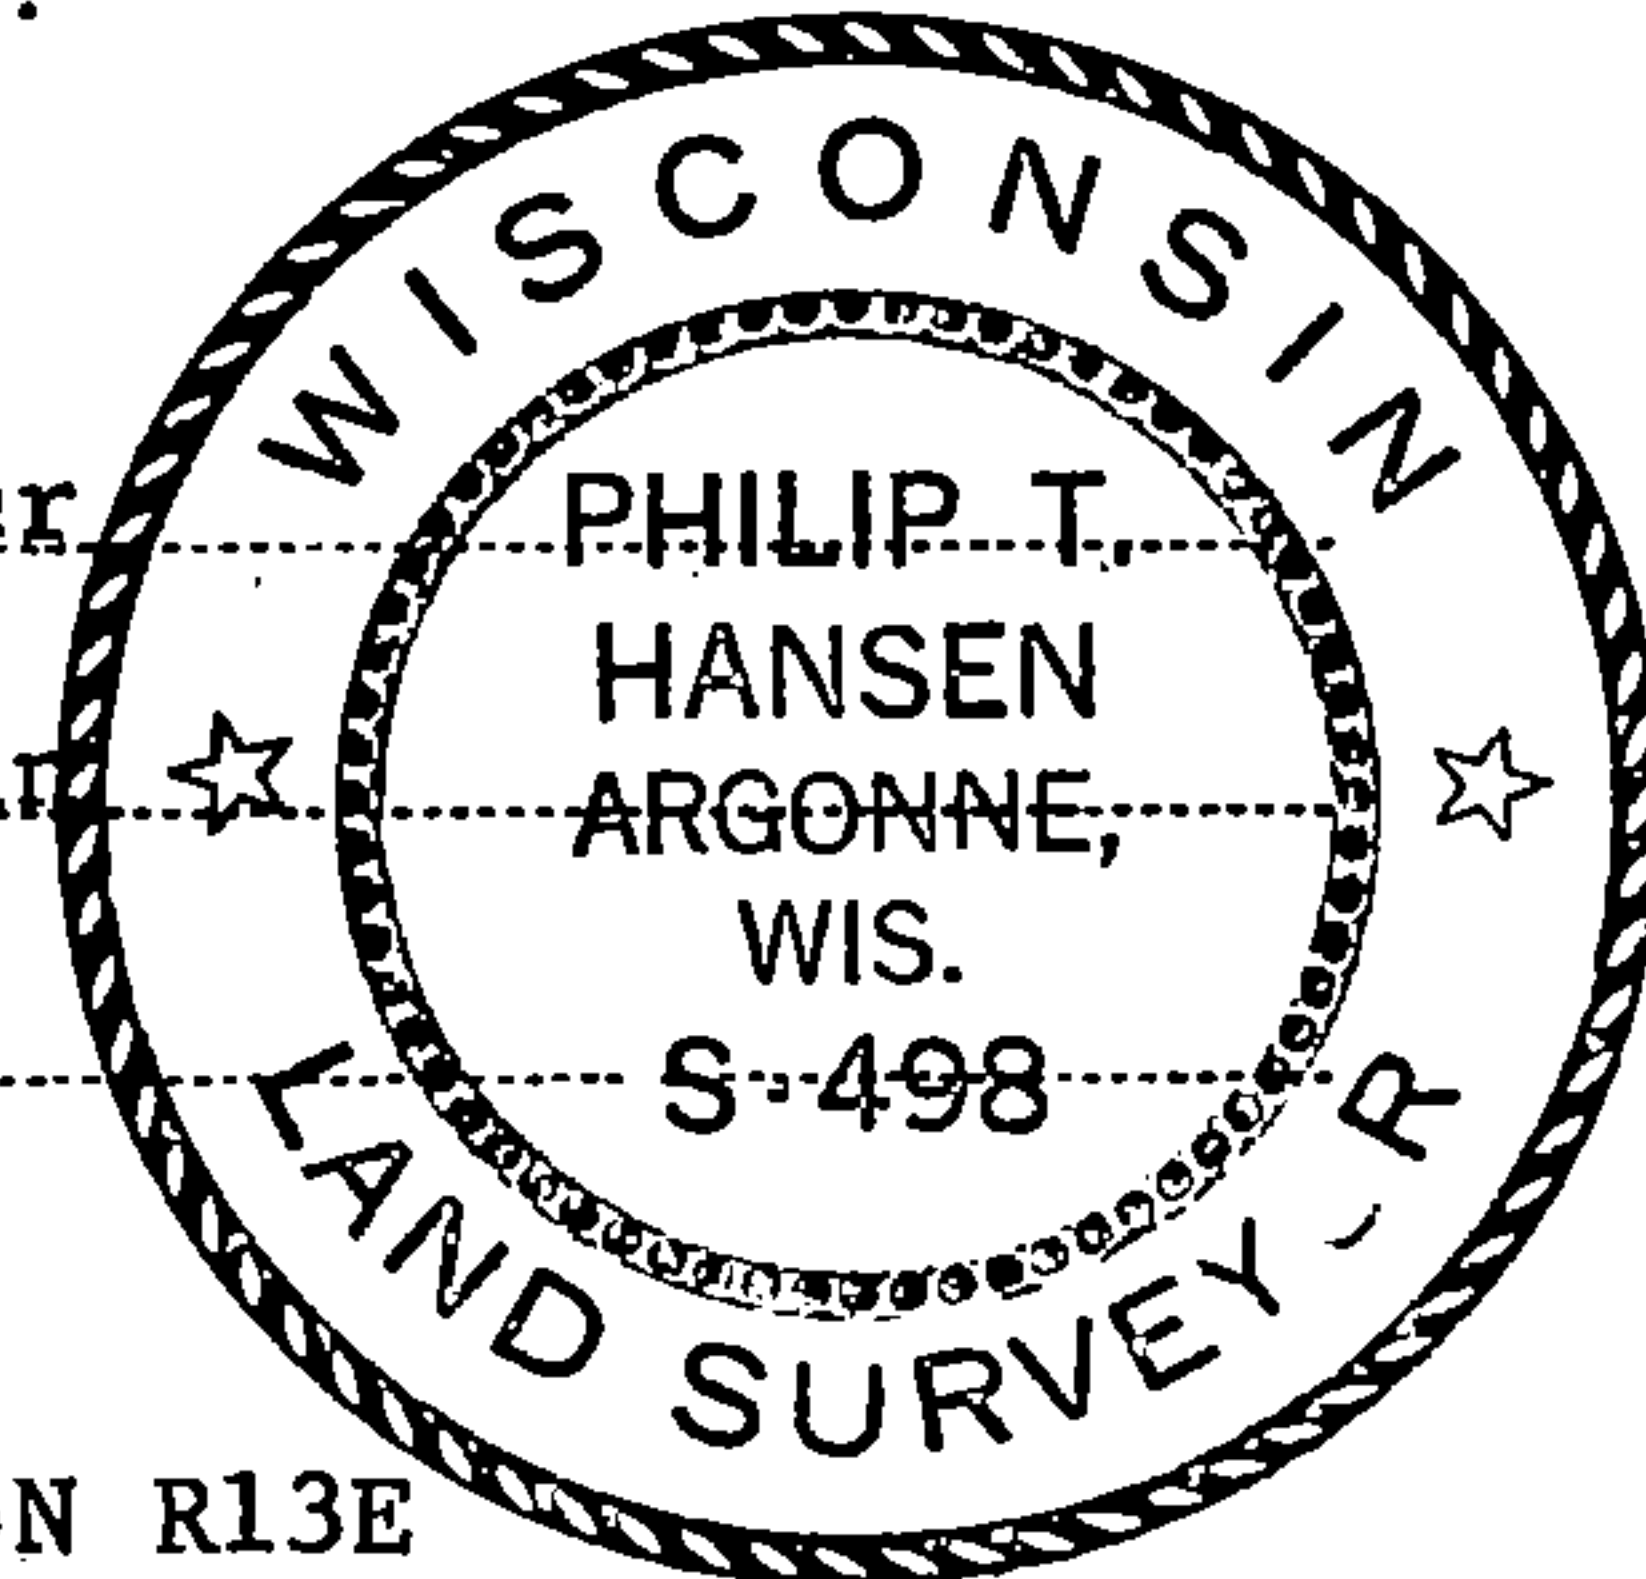

T36N R13E

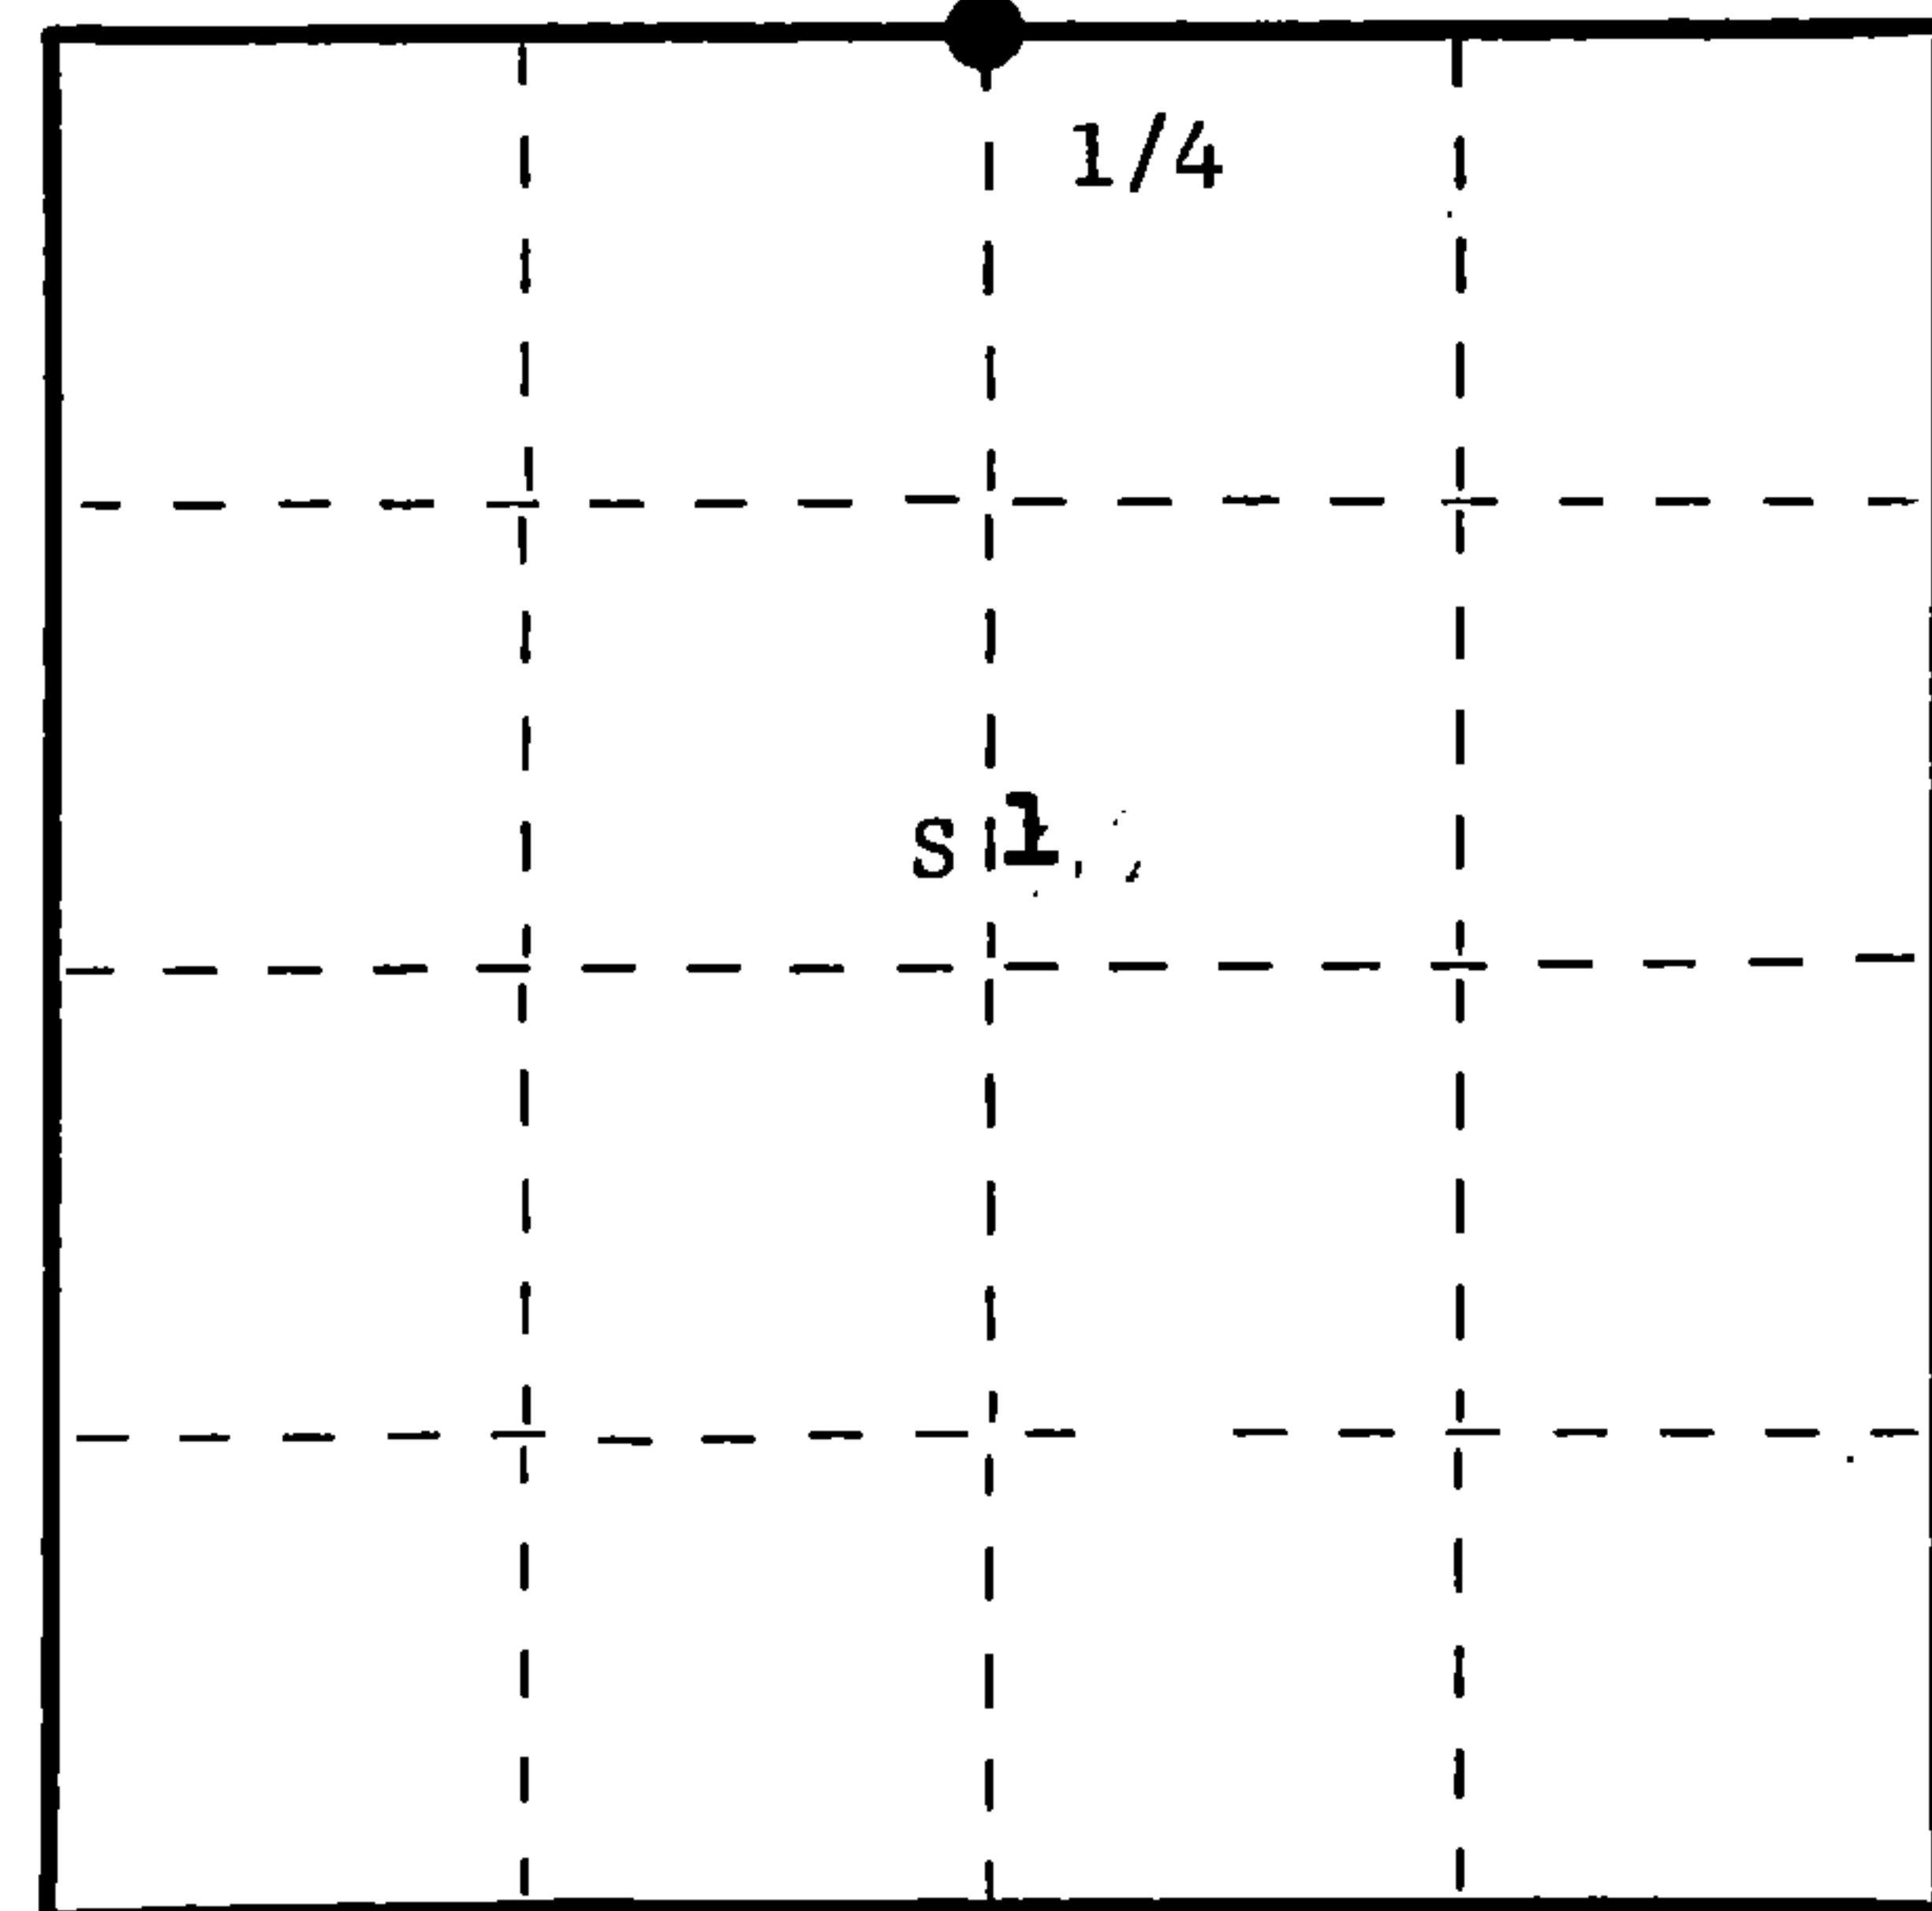

○ = Corner monument restored.

History of original corner establishment: Original corner established by A. Curtiss, Deputy Surveyor, in 1857 from which yellow birch 22" bears S70°W, 40 links, hemlock 12" bears N29°E, 36 links.

Corner recovered by C.E. Walker, County Surveyor, in 1938. Set 2-1/2" iron pipe with brass cap projecting 2 feet above ground. No record of BT's.

Description of corner evidence found: Recovered Walker's iron pipe with brass cap stamped - Pipe projects about two feet above ground.

No evidence of OBT's visible.

Forest Co. Forest Crop
Survey
T 37 R13E
36
1/4 Cor. 36
1

C.E. Walker
10-5-38

Description of monument and accessories I established to perpetuate the original location of this corner. As monument was recovered in perfect condition, it was left as found.

NBT's - White spruce 10" N26°E 83.3 links scribed 1/4 BT
White spruce 11" S33°W 97 links scribed 1/4 BT

Monument and BT's were painted blue.

Dated at Argonne, Wis., this 9th day of January, 19 76.

Signature Philip T. Hansen Title Registered Land Surveyor Registration No. S-498
(County Surveyor, Registered Land Surveyor, or other duly authorized official)

Office of Register of Deeds, County of Forest, I hereby certify that the within instrument was filed in this office for record on the 4th day of February, 19 76 at 4:00 o'clock P. M. DOCUMENT NUMBER **108693**

Eugene Staszny
(Register of Deeds)
By _____ Deputy

FORM 985 H. C. MILLER CO., MILWAUKEE

43713360020