

CERTIFIED LAND CORNER RESTORATION

Index No. Y-25


State of Wisconsin }
County of Forest } ss.

I Daniel K. Pleoger, do hereby certify that on the 25 day of September, 1981, I found evidence of the S 1/16 corner of Sections 31 & 36 Township 37 North, Range 13 & 14 East, Fourth Principal Meridian, as described hereon; and that from this evidence I established a new monument and accessories as described hereon to perpetuate the original location of this corner.

Resident witnesses:



FORM 985 H. C. MILLER CO., MILWAUKEE

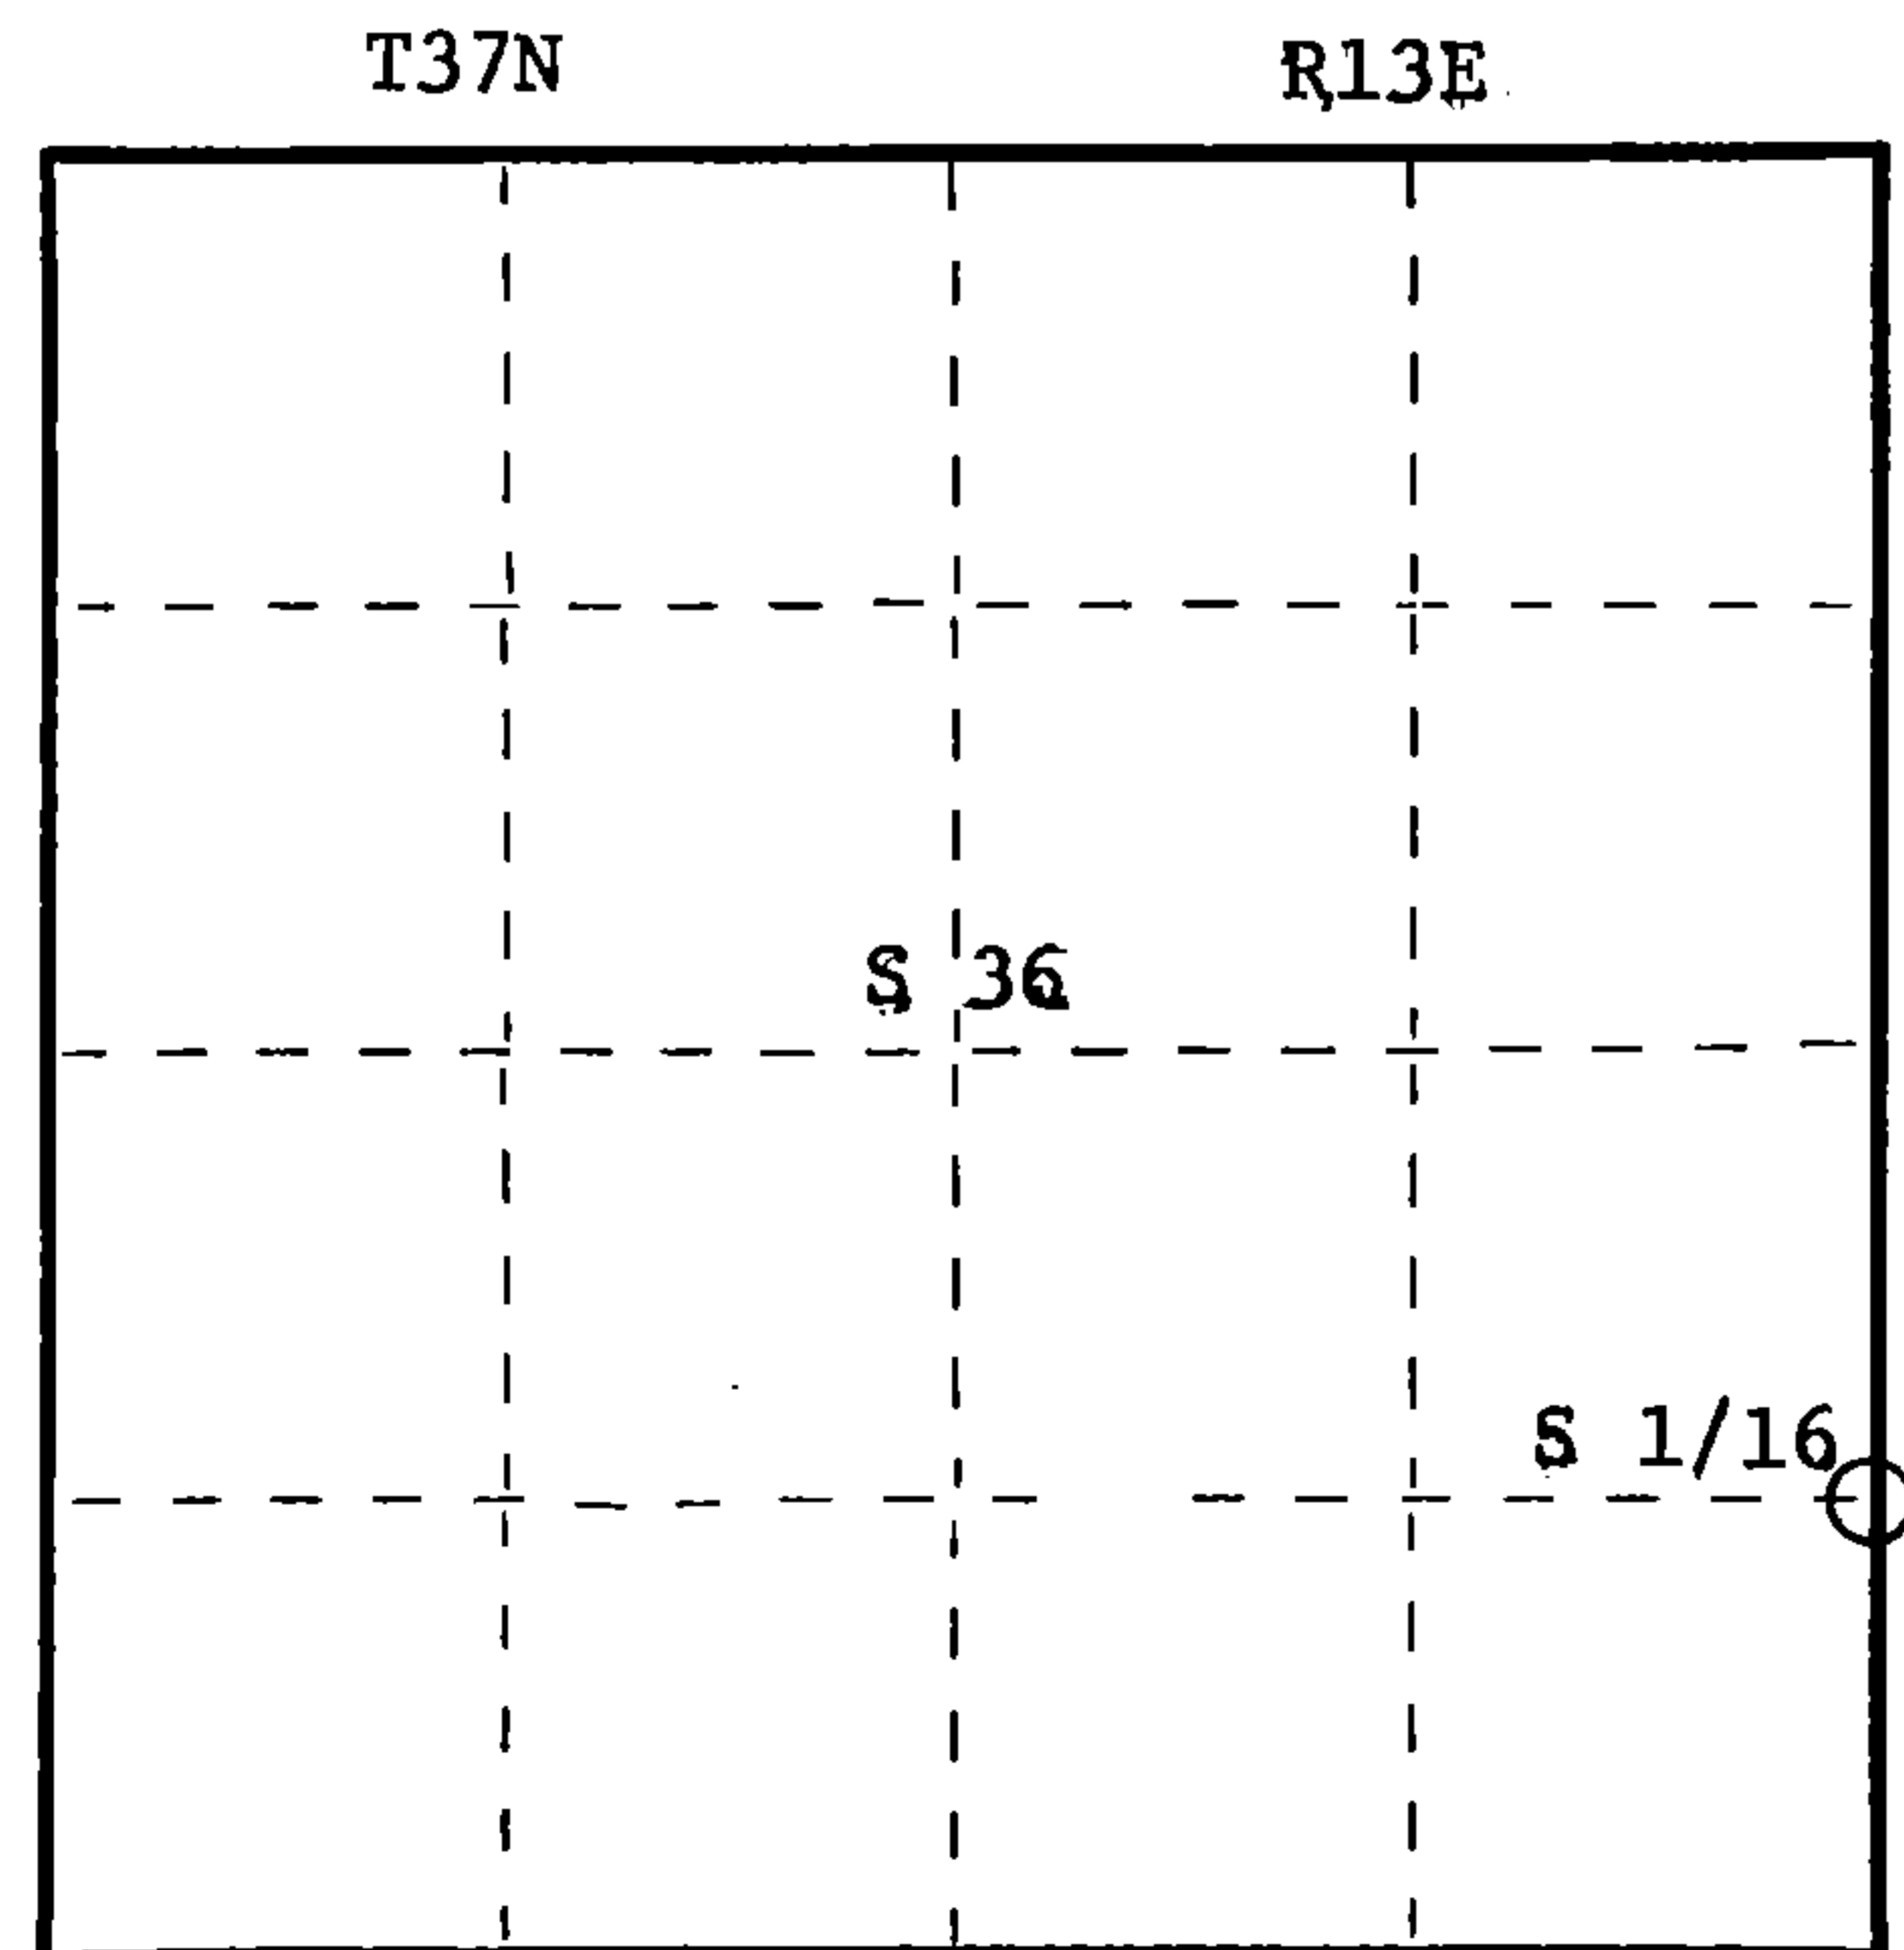

○ = Corner monument restored.

History of original corner establishment:
No evidence of any previous corner.

Description of corner evidence found:
Total distance from township corner 1, 6, 31, 36 T36 & 37N, R13 & 14E to 1/4 corner between sections 31 & 36 is 2660.206 ft. at bearing N1-42-40E.
Set S 1/16 1330.103 ft. intermediate

Description of monument and accessories I established to perpetuate the original location of this corner.
Set a 1 1/2" iron pipe with 2" diameter aluminum cap stamped: S1537
Monument projects 18" above ground T37N
Marked NBTs R13E R14E
Black spruce 6" N84W 15.23 ft. S 1/16 36 | 31
Black spruce 6" S33E 31.15 ft. CPI - 1981
Scribed 1/16 - B.T.

Dated at Rhinelander, Wis., this 4th day of November, 1981.

Signature Daniel K. Pleoger Title Registered Land Surveyor Registration No. 1537
(County Surveyor, Registered Land Surveyor, or other duly authorized official)

Office of Register of Deeds, County of Forest, I hereby certify that the within instrument was filed in this office for record on the 19th day of January, 1982 at 3:00 o'clock P. M.

Eugene Stutzman (Register of Deeds) Deputy

DOCUMENT NO. 121086

H3713361000