

CERTIFIED LAND CORNER RESTORATION

Index No. Y-23


State of Wisconsin }
County of Forest } ss.

I Daniel K. Plegger, do hereby certify that on the 25 day of September, 1981, I ~~found~~ Est. ~~XXXXXX~~ the SC 1/16 corner of Section 36 Township 37, North, Range 13 East, Fourth Principal Meridian, as described hereon; and that from this evidence I established a new monument and accessories as described hereon to perpetuate the original location of this corner.

History of original corner establishment:
No evidence of any previous survey.

Description of corner evidence found:
Total distance from 1/4 corner between sections 1 & 36 T36 & 37N R13E to C1/4 corner section 36 is 2618.764 ft. at bearing N1-55-07E.
Set SC 1/16 1309.382 ft. intermediate.

Resident witnesses:

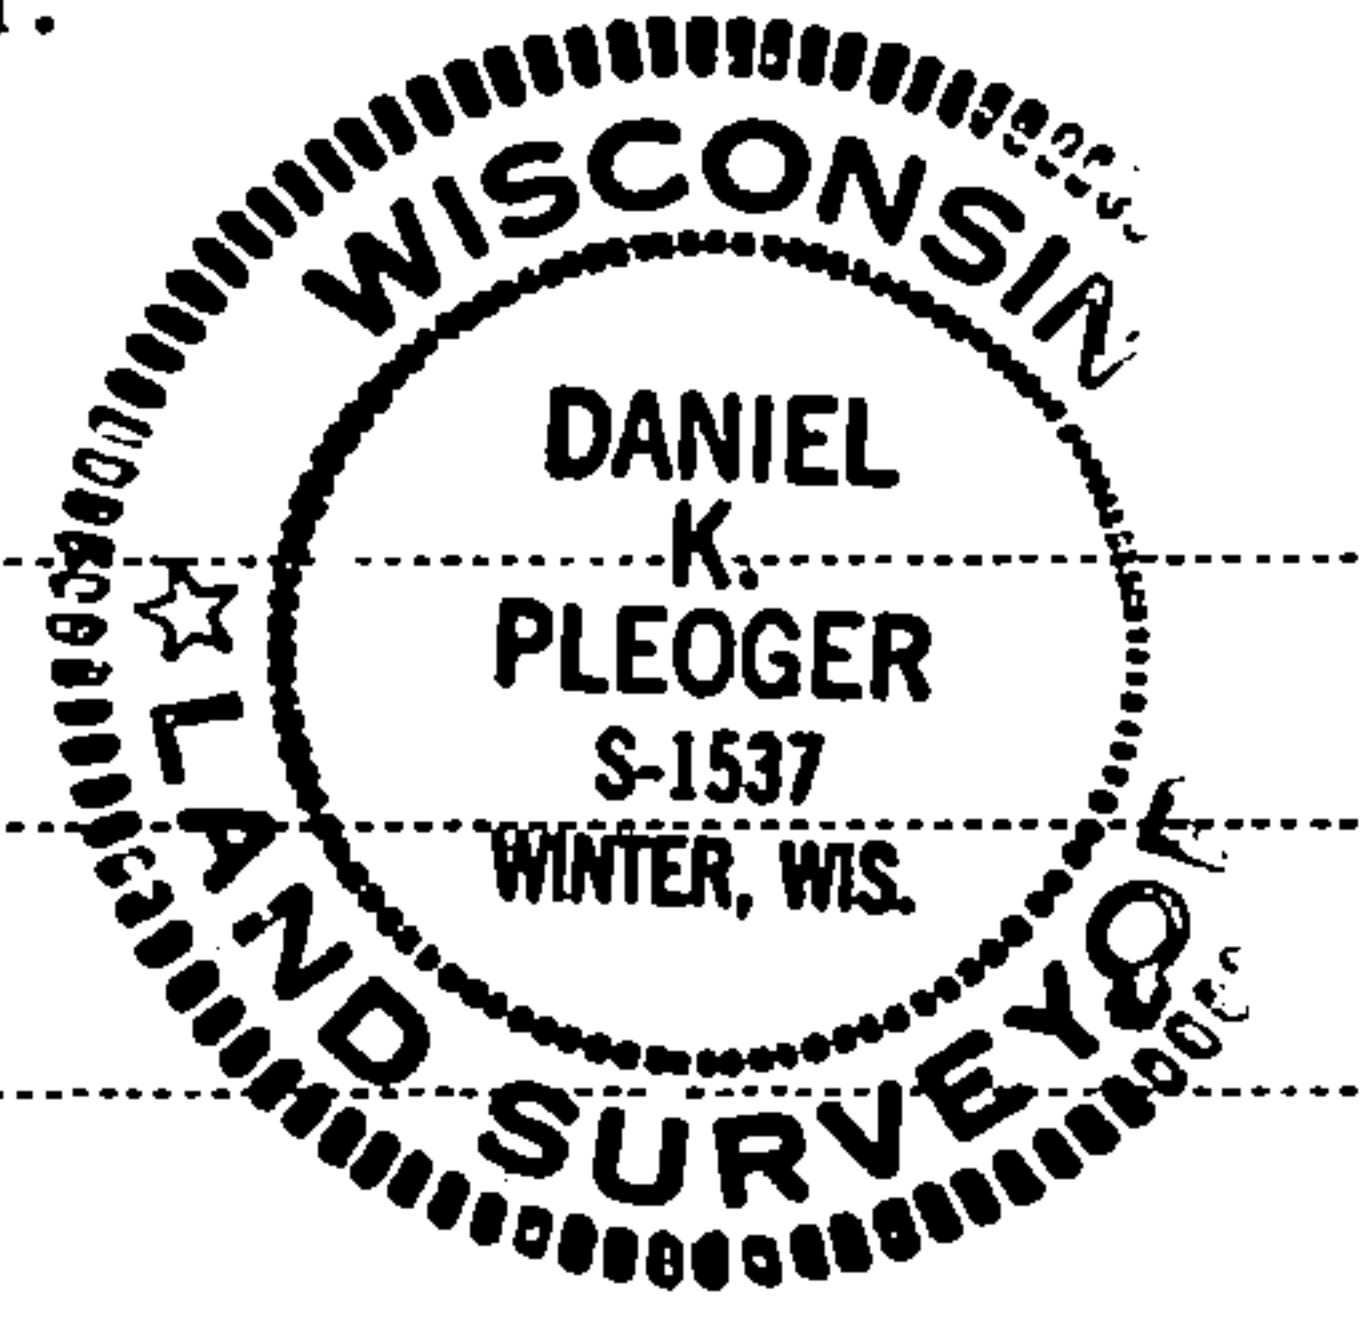


Description of monument and accessories I established to perpetuate the original location of this corner.

Set a 1 1/2" iron pipe with 2" diameter brass cap stamped:
Monument projects 24" above ground

S1537
T37N R13E
SC 1/16 S 36
CPI - 1981

Marked NBTs
White pine 10" S11W 10.05 ft.
White pine 12" S87W 28.45 ft.
Scribed 1/16 - BT

FORM 985 H. C. MILLER CO., MILWAUKEE

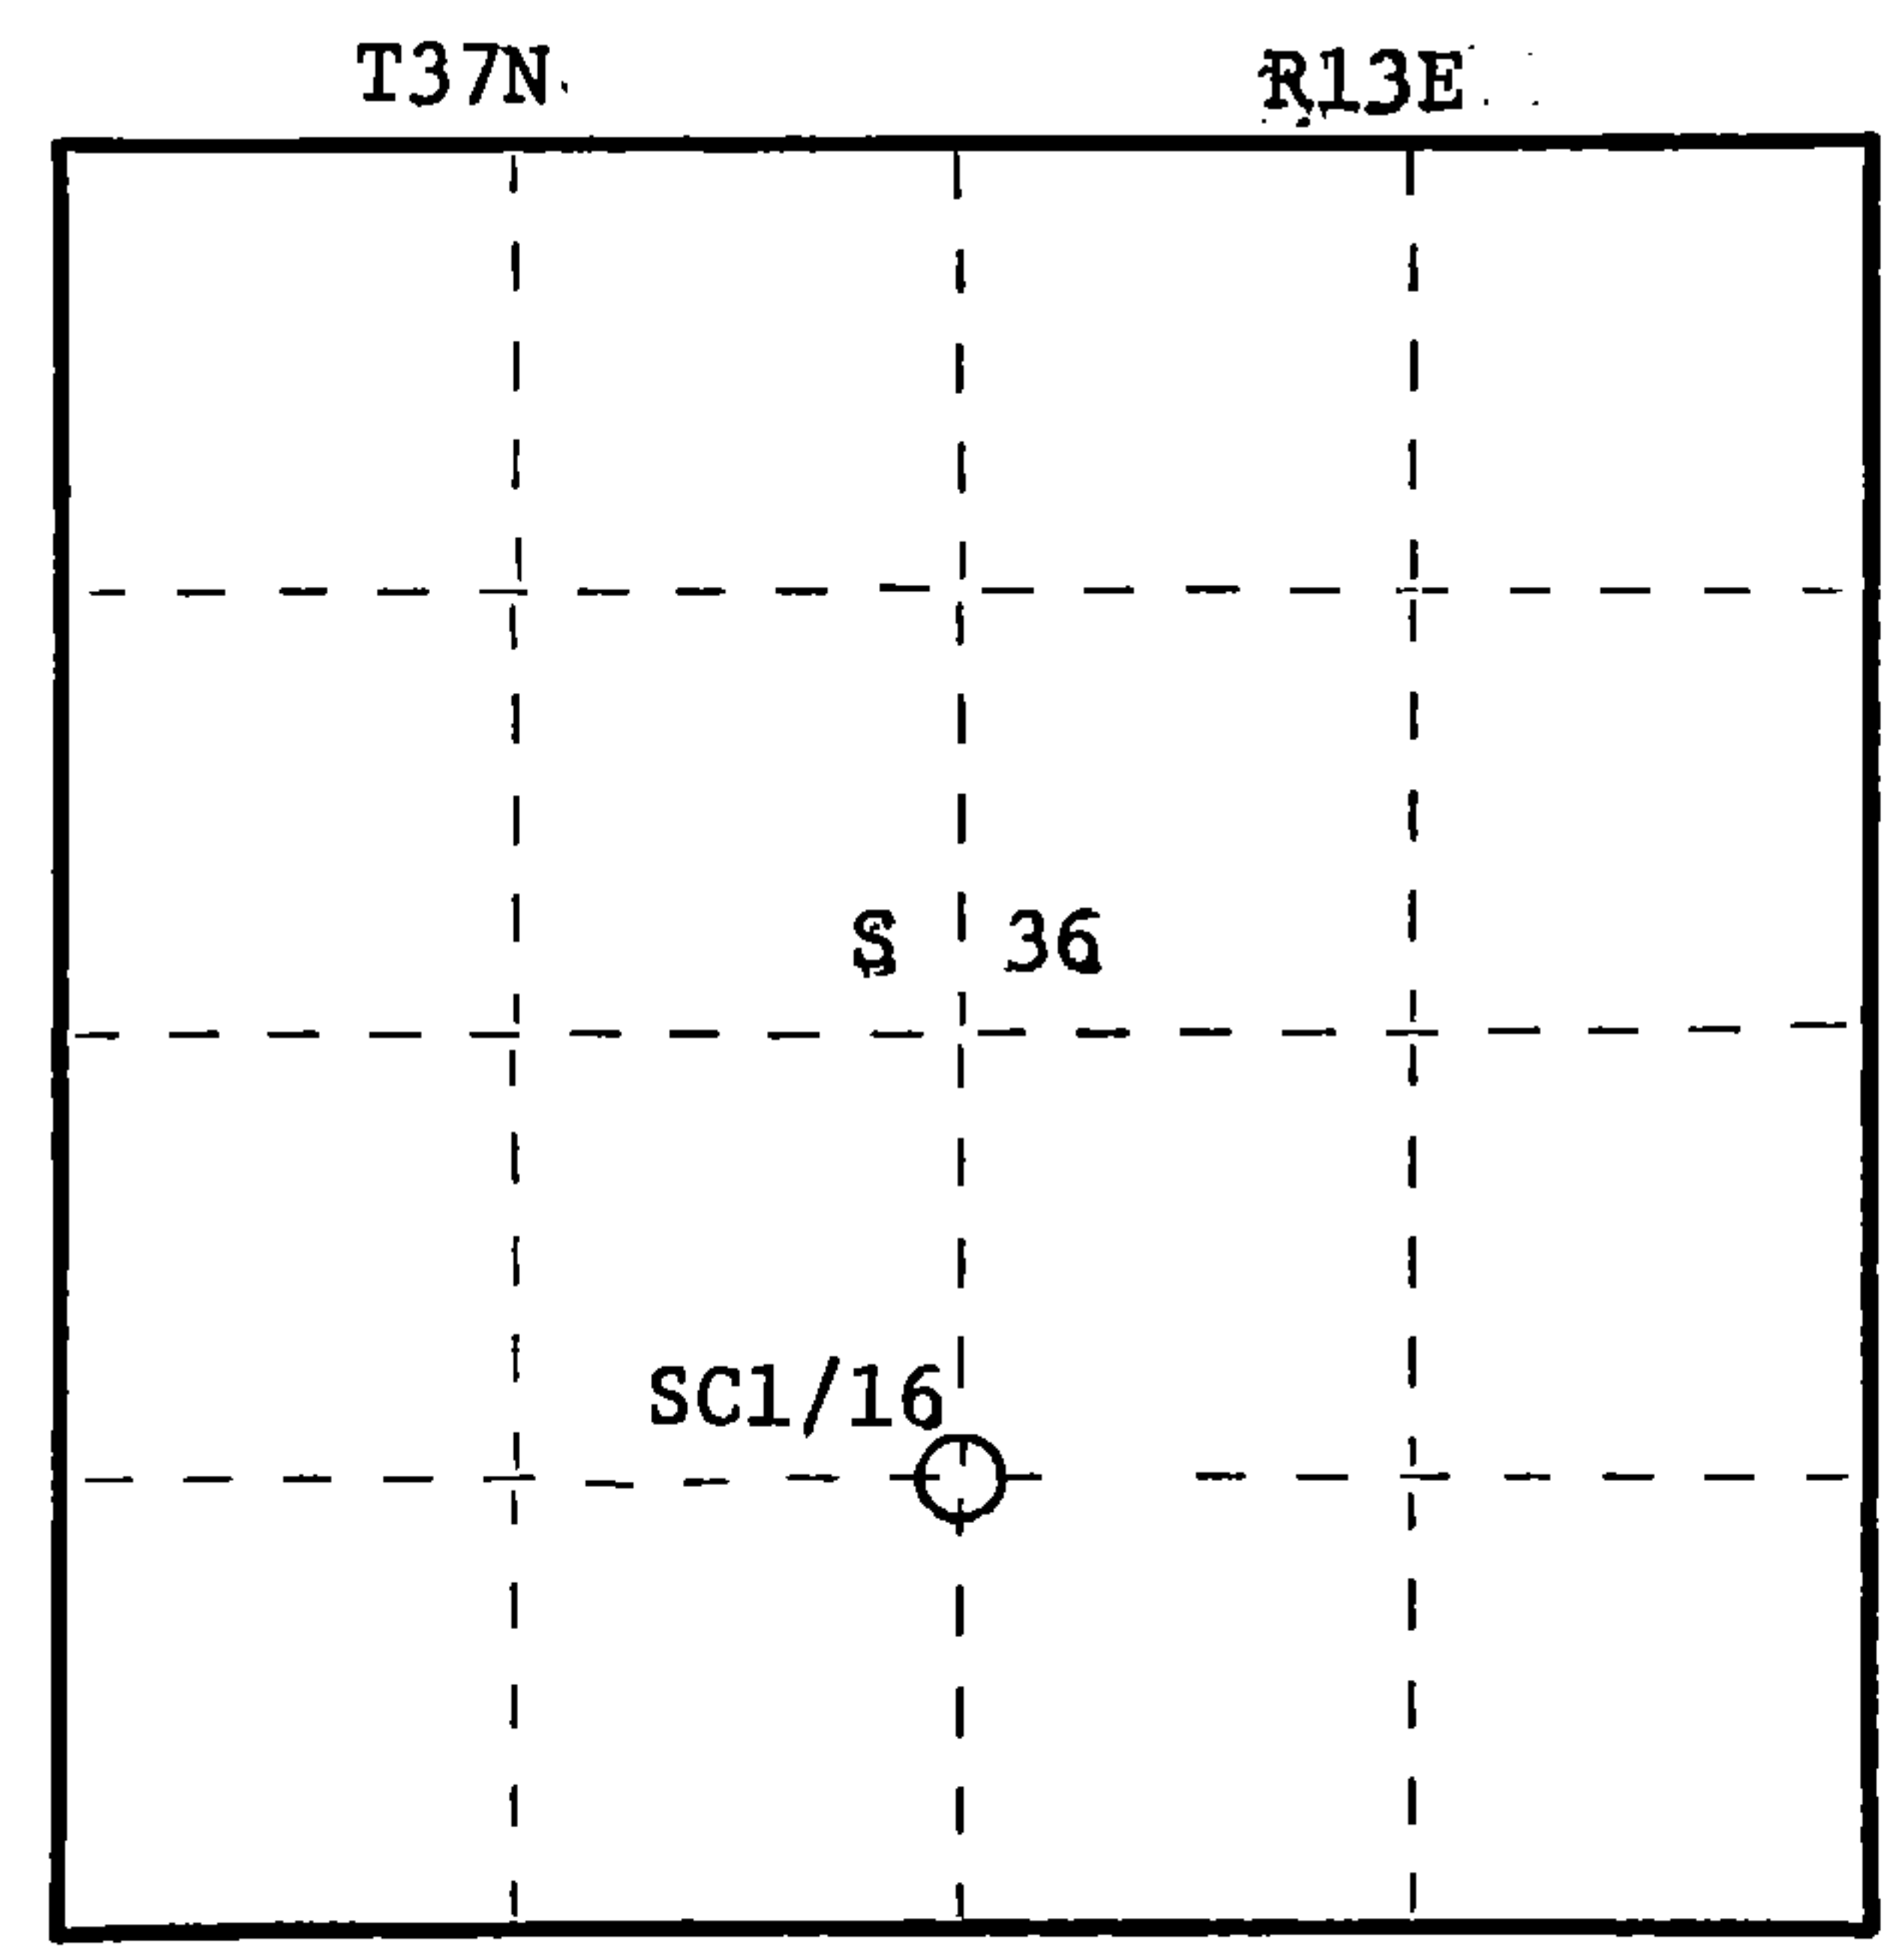

○ = Corner monument restored.

Dated at Rhineland, Wis., this 4th day of November, 1981

Signature Daniel K. Plegger Title Registered Land Surveyor Registration No. 1537
(County Surveyor, Registered Land Surveyor, or other duly authorized official)

Office of Register of Deeds, County of Forest, I hereby certify that the within instrument was filed in this office for record on the 19th day of January, 1982 at 3:00 o'clock P. M.

Eugene Staryny
(Register of Deeds)
By _____ Deputy

DOCUMENT NO.
121084

43713361020