

CERTIFIED LAND CORNER RESTORATION

Index No. **C 21**


State of Wisconsin } ss.
County of Forest

I Philip T. Hansen, do hereby
certify that on the 29th day
of September, 1975, I found
evidence of the Quarter
corner of Sec. 1 and 2
Township 37
14 East, North, Range
as described hereon; and that from this evidence
I established a new monument and accessories
as described hereon to perpetuate the original
location of this corner.


Resident witnesses:

Glen Barker

Jim Claflin

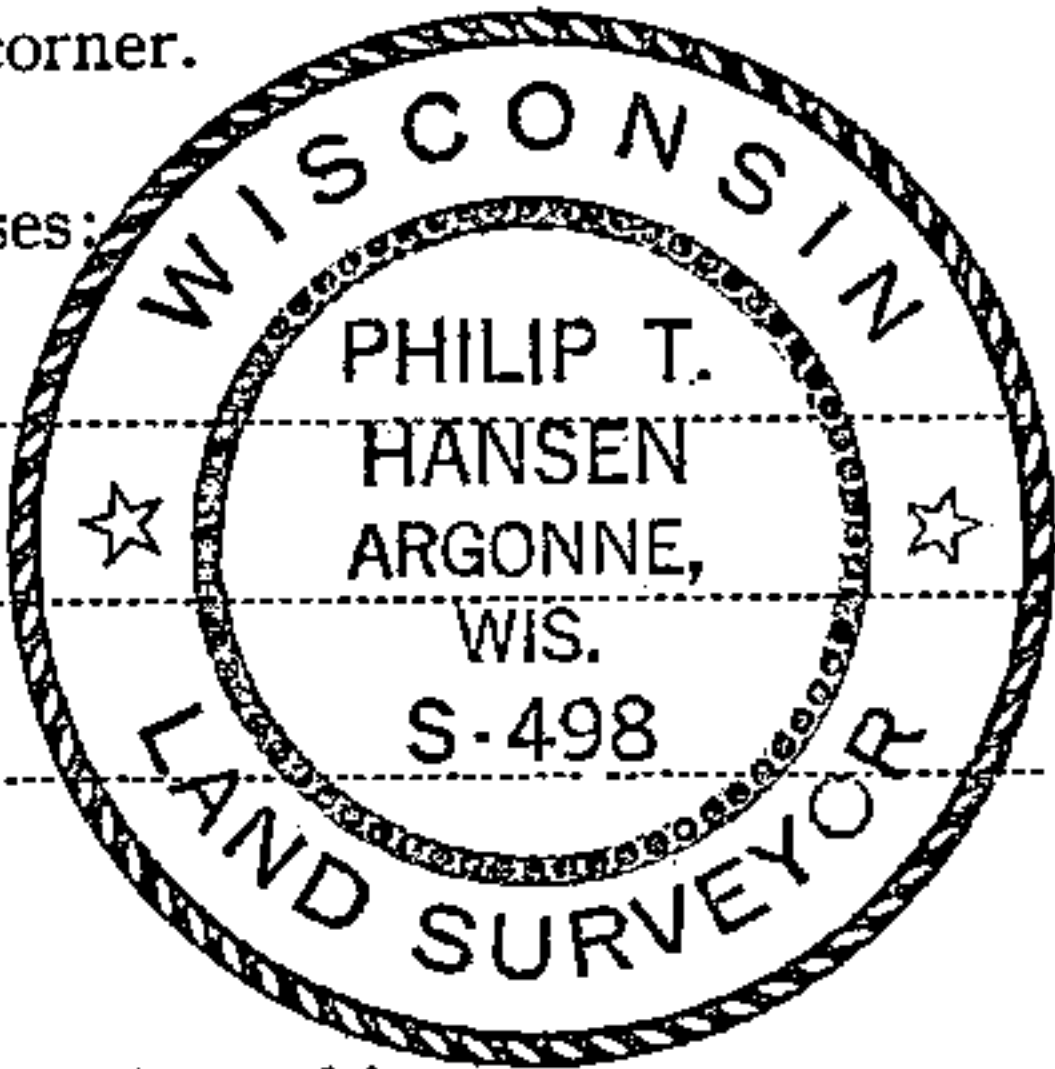

T37N R14E

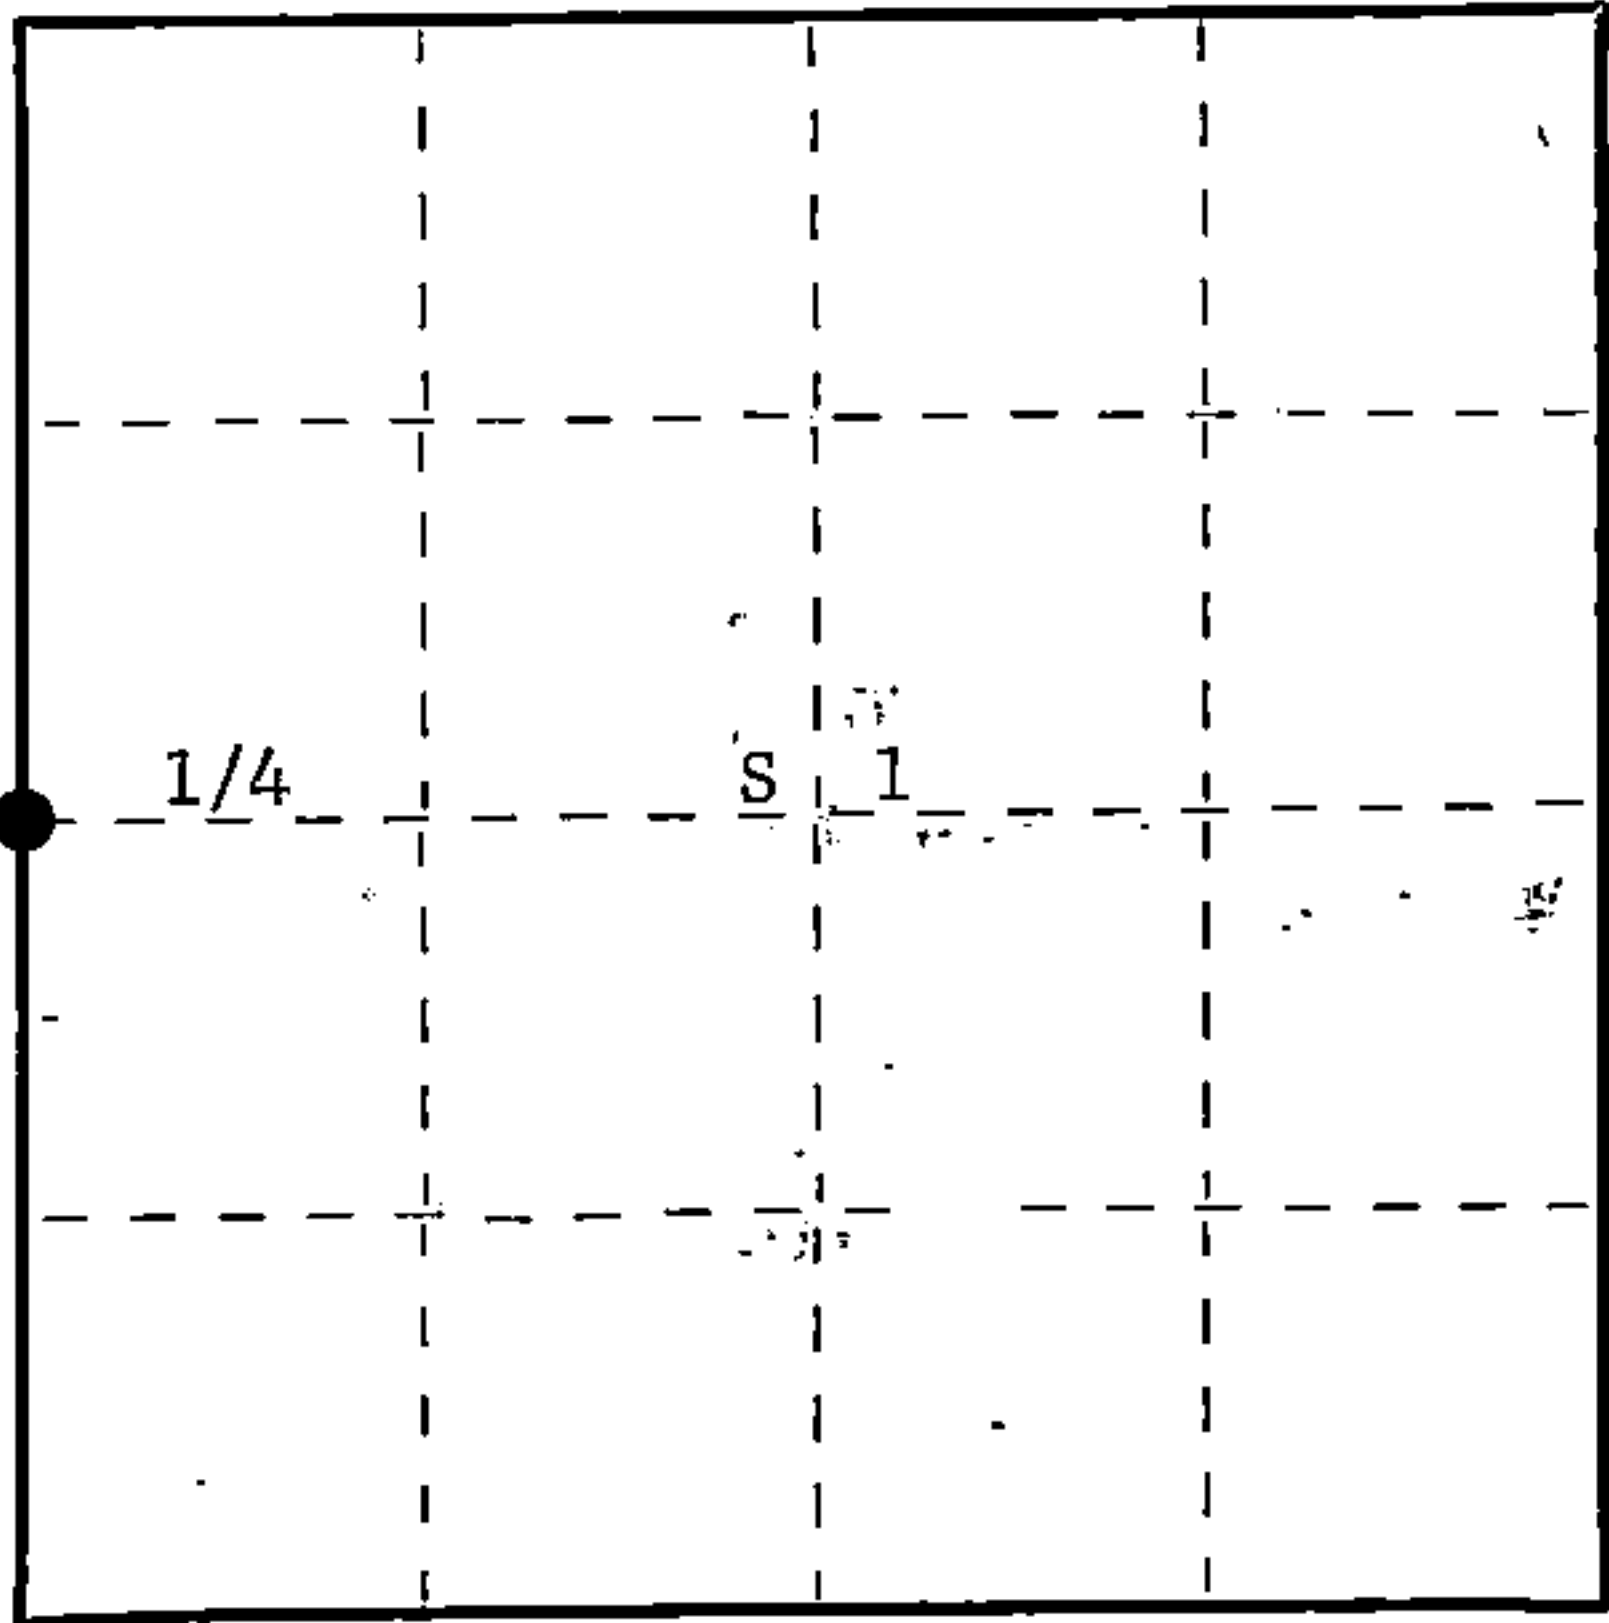

○ = Corner monument restored.

History of original corner establishment: Original corner established by James L. Nowlin, Gov. Deputy Surveyor, in 1865, from which Tamarack 10" bears N29°W 12 links, and Tamarack 10" bears S72°E 4 links.
Corner recovered by Ray Leigh, Consolidated Forester, who claims he found an old decayed post in place and set iron pipe in its place. P.T. Hansen, Registered Land Surveyor, perpetuated corner since 1948.

Description of corner evidence found:

Recovered Leigh's 1½" iron pipe in place. No BT's were recovered although extensive search was made for remains of old Tamarack BT's.

Description of monument and accessories I established to perpetuate the original location of this corner.

Replaced 1½" iron pipe with 2½" x 30" Berntsen A-1 Federal Monument, aluminum pipe with magnet installed in cap and base. Cap stamped -
Pipe projects 6" above ground. Drove old iron pipe beside
new post.

S498
T37N R14E
1/4 S2 S1
1975

NBT's - Tamarack 7" S88°W 40.5 links, scribed ½ BT.
Tamarack 9" N64°E 35.5 links, scribed ½ BT.

Post and NBT's painted blue.

Dated at Argonne, Wis., this 2nd day of October, 1975

Signature Philip T. Hansen Title Registered Land Surveyor Registration No. S-498
(County Surveyor, Registered Land Surveyor, or other duly authorized official)

Office of Register of Deeds, County of Forest, I hereby certify that the within
instrument was filed in this office for record on the 13th day of October, 1975
at 4:00 o'clock P. M.

Eugene Staley
(Register of Deeds)
By Deputy

DOCUMENT NUMBER 107965

FORM 985 R. C. MILLER CO., MILWAUKEE

43714022000