

CERTIFIED LAND CORNER RESTORATION  
U.S. PUBLIC LAND SURVEY

History of original corner establishment:

Original corner established by J.L. Nowlin, Deputy Surveyor in 1865  
from which Cedar 8" bears N15 W 40 links and Hemlock 9" bears S55 W\*12 links.

State of Wisconsin }  
County of Forest } ss.

I, Glen Barker, do hereby  
certify that on the 10th day  
of May, 19 88, I ~~found~~  
evidence of the Quarter Section  
corner of 2 & 3  
Township 37, North, Range  
14 East, Fourth Principal Meridian,  
as described hereon; and that from this evidence  
I established a new monument and accessories  
as described hereon to perpetuate the original  
location of this corner.

Resident witnesses:

Norm Spiess

Herb Wagoner

Description of corner evidence found:

Re-established Quarter Section corner by proportional measurement. Total  
distance from previous recovered section corners 2-3-10-11 and 2-3-34-35,  
T37 & 38N-R14E is 4993.82'. Quarter section corner sets 2574.14' of section  
corner 2-3-10-11 and 2419.68' of section corner 2-3-34-35 on line between the  
two.

Description of monument and accessories I established to perpetuate the original location of this corner.

Set a 2 1/4" aluminum Forest County monument with 3 1/4" alloy cap stamped:

Monument projects 6" above ground.

- Marked N.B.T.'s
- Sugar 7" N23°E 6.60'
- Sugar 7" N77°W 12.65'
- Sugar 12" S11°W 16.99'
- Sugar 10" N88°E 15.88'


T37N-R14E  
1/4 

S3	S2
...	...

  
1988  
S1682

DOCUMENT NUMBER  
**136225**

FORM 985 H. C. MILLER CO., MILWAUKEE

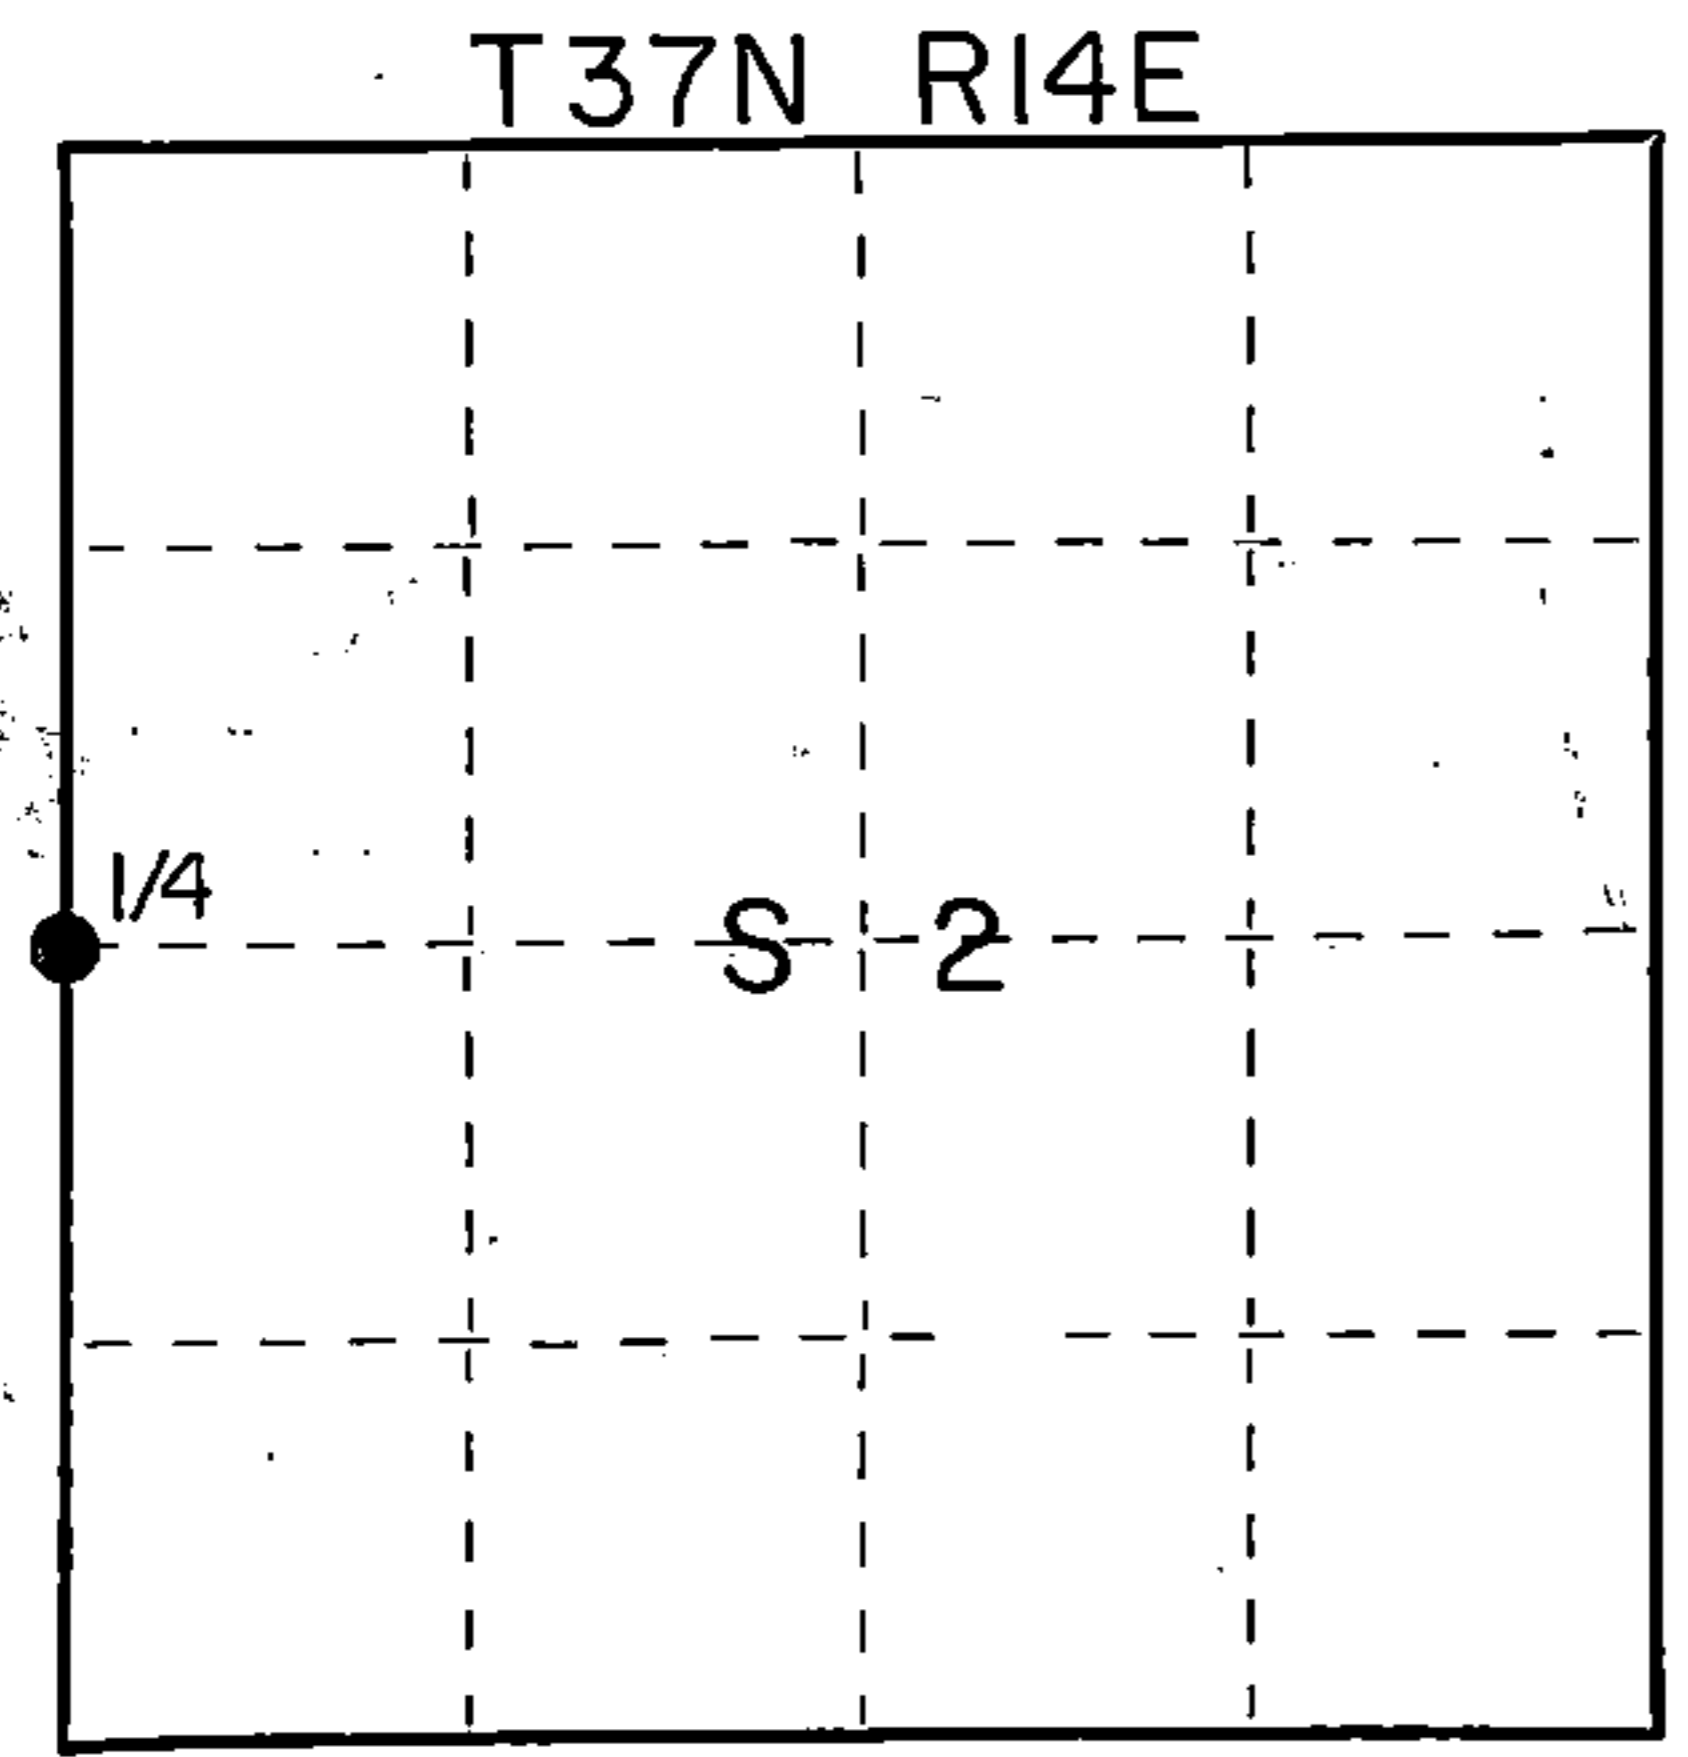

○ = Corner monument restored.

Dated at \_\_\_\_\_, Wis., this \_\_\_\_\_ day of \_\_\_\_\_, 19\_\_\_\_\_

Signature Glen Barker Title \_\_\_\_\_ Registration No. \_\_\_\_\_  
(County Surveyor, Registered Land Surveyor, or other duly authorized official)

Office of Register of Deeds, County of Forest, I hereby certify that the within  
instrument was filed in this office for record on the 19th day of October, 1988  
at 11:00 o'clock A. M.

Paul Aschenbrenner  
(Register of Deeds)

By \_\_\_\_\_ Deputy

43714032000

