

CERTIFIED LAND CORNER RESTORATION

Index No. **E 9**


State of Wisconsin }  
 County of Forest } ss.

I Philip T. Hansen, do hereby certify that on the 18th day of December, 1975, I found evidence of the Section corner of Sections 4, 5, 8, and 9 Township 37 North, Range 14 East, Fourth Principal Meridian, as described hereon; and that from this evidence I established a new monument and accessories as described hereon to perpetuate the original location of this corner.


Resident witnesses

Glen Barker

Jim Claflin

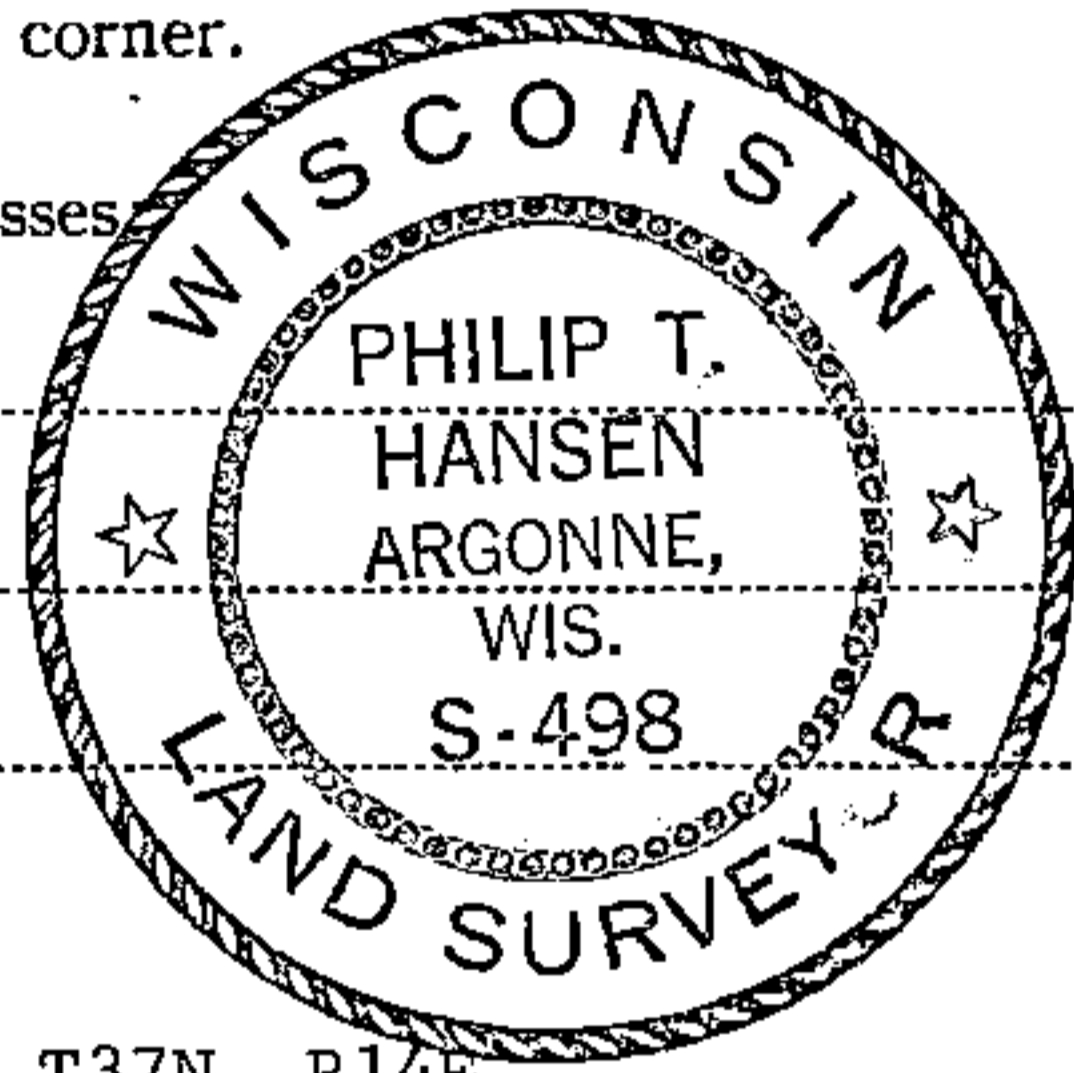

T37N, R14E

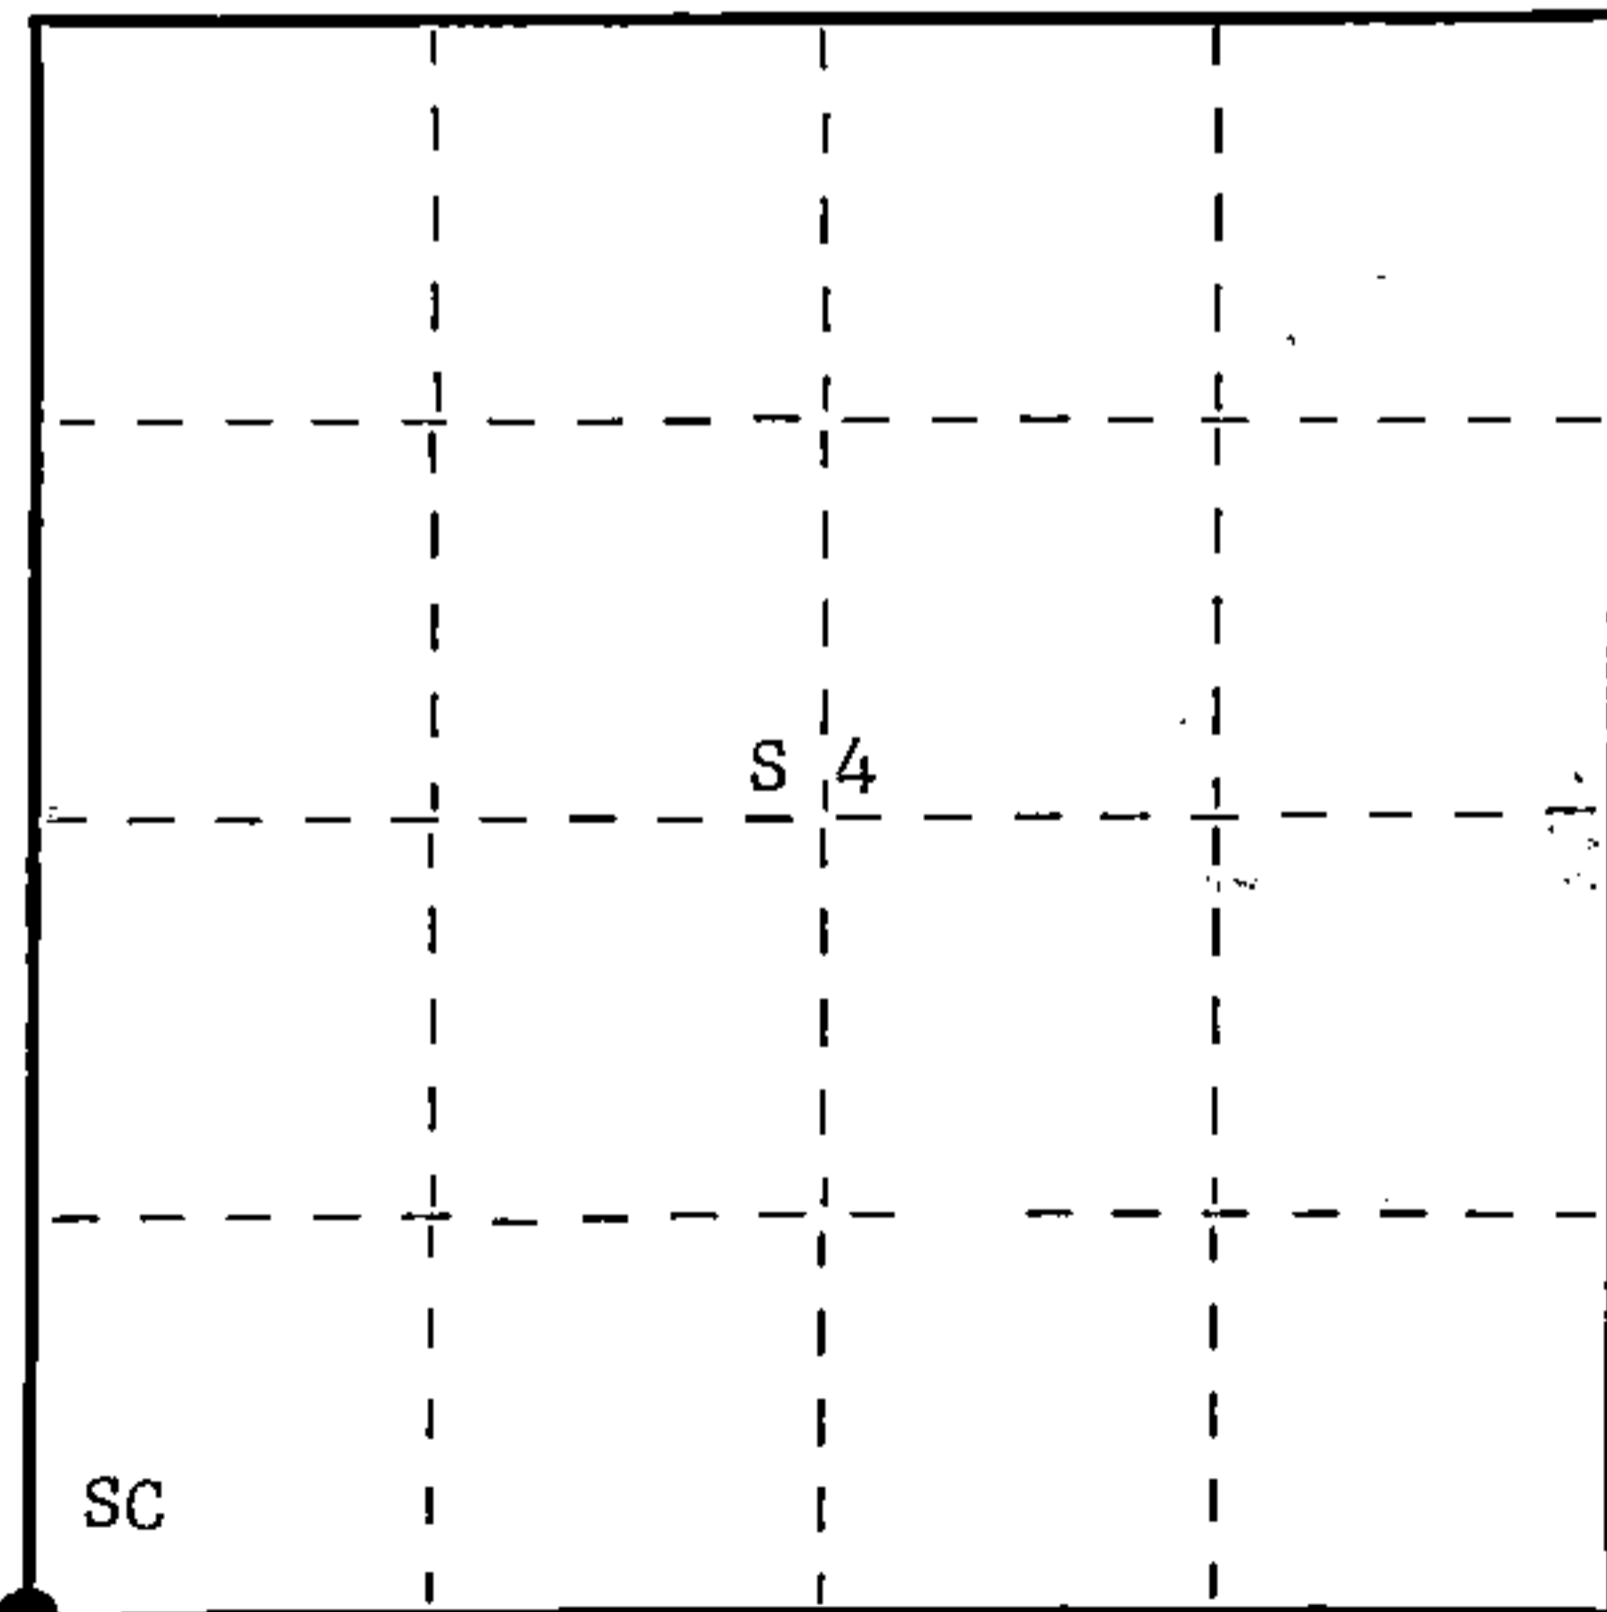

○ = Corner monument restored.

History of original corner establishment:

Original corner established by J.L. Nowlin, Deputy Surveyor, from which spruce 10" bears N66°E, 30 lks. and spruce 8" bears N45°W, 20 lks.

No records on file on any subsequent surveys.

Corner recovered and maintained by Ray Leigh, Consolidated Forester, during cruising and mapping in 1947.

Description of corner evidence found:

Recovered 4" squared cedar post in poor condition.

No evidence of OBT's was visible.

Description of monument and accessories I established to perpetuate the original location of this corner.

Replaced squared cedar post with 2-1/2" Berntsen, A-1 Federal Monument, aluminum with magnet installed in cap and base. Pipe projects 18 inches above ground. Cap stamped - Set squared post beside new pipe.

NBT's - Cedar 7"	S47°E	44.3 lks.	scribed SC BT.
Cedar 8"	N78°E	36.7 lks.	scribed SC BT.
Cedar 18"	S80°W	21.5 lks.	scribed SC BT.

S498  
 T37N, R14E  
 Sec.  $\frac{5}{8}$

Pipe, post, and NBT's painted blue.

Dated at Argonne, Wis., this 23rd day of December, 1975

Signature *Philip T. Hansen* Title Reg. Land Surveyor Registration No. S-498  
 (County Surveyor, Registered Land Surveyor, or other duly authorized official)

Office of Register of Deeds, County of Forest, I hereby certify that the within instrument was filed in this office for record on the 5th day of January, 1976 at 2:45 o'clock P. M.

EUGENE STATEZNY  
 (Register of Deeds)

DOCUMENT NUMBER 108494

By *Eileen Schmidt* Deputy

FORM 985 H. C. MILLER CO., MILWAUKEE

43714050000