

CERTIFIED LAND CORNER RESTORATION

Index No. G-9

US Public Land Survey
History of original corner establishment:

Original corner established by J.L. Nowlin, Deputy Surveyor, in 1865
from White Birch 10" bears S23°W 10 lks and Sugar 8" bears N30°E 20 lks.

State of Wisconsin }
County of Forest } ss.

I Glen Barker, do hereby
certify that on the 22nd day
of April, 19 88, I ~~found~~
est. ~~evidence of the~~ the quarter section
corner of 8 & 9
Township 37, North, Range
14 East, Fourth Principal Meridian,
as described hereon; and that from this evidence
I established a new monument and accessories
as described hereon to perpetuate the original
location of this corner.

Resident witnesses:

N. Spiess

H. Wagoner

Description of corner evidence found:

Quarter section corner re-established by proportional measurement. Total
distance from recovered section corners 4-5-8-9 and 8-9-16-17 is 5308.65'.
Set 1/4 corner 2654.32' intermediate. Original distance was 5280.0'. No
evidence of original corner or B.T.'s.

Description of monument and accessories I established to perpetuate the original location of this corner.

Set a 2 1/4" Forest County aluminum monument with 3 1/4" alloy cap stamped:
Monument projects 6" above ground.
6.0' south to center line woods road.

Marked NBT's


Sugar 8" N41°W 68.42'
Sugar 14" N15°E 41.13'
Sugar 7" N81°E 77.52'
1" I.P. S55°W 55.73'

T37N R14E

1/4

S8	S9
----	----

1987
S1682

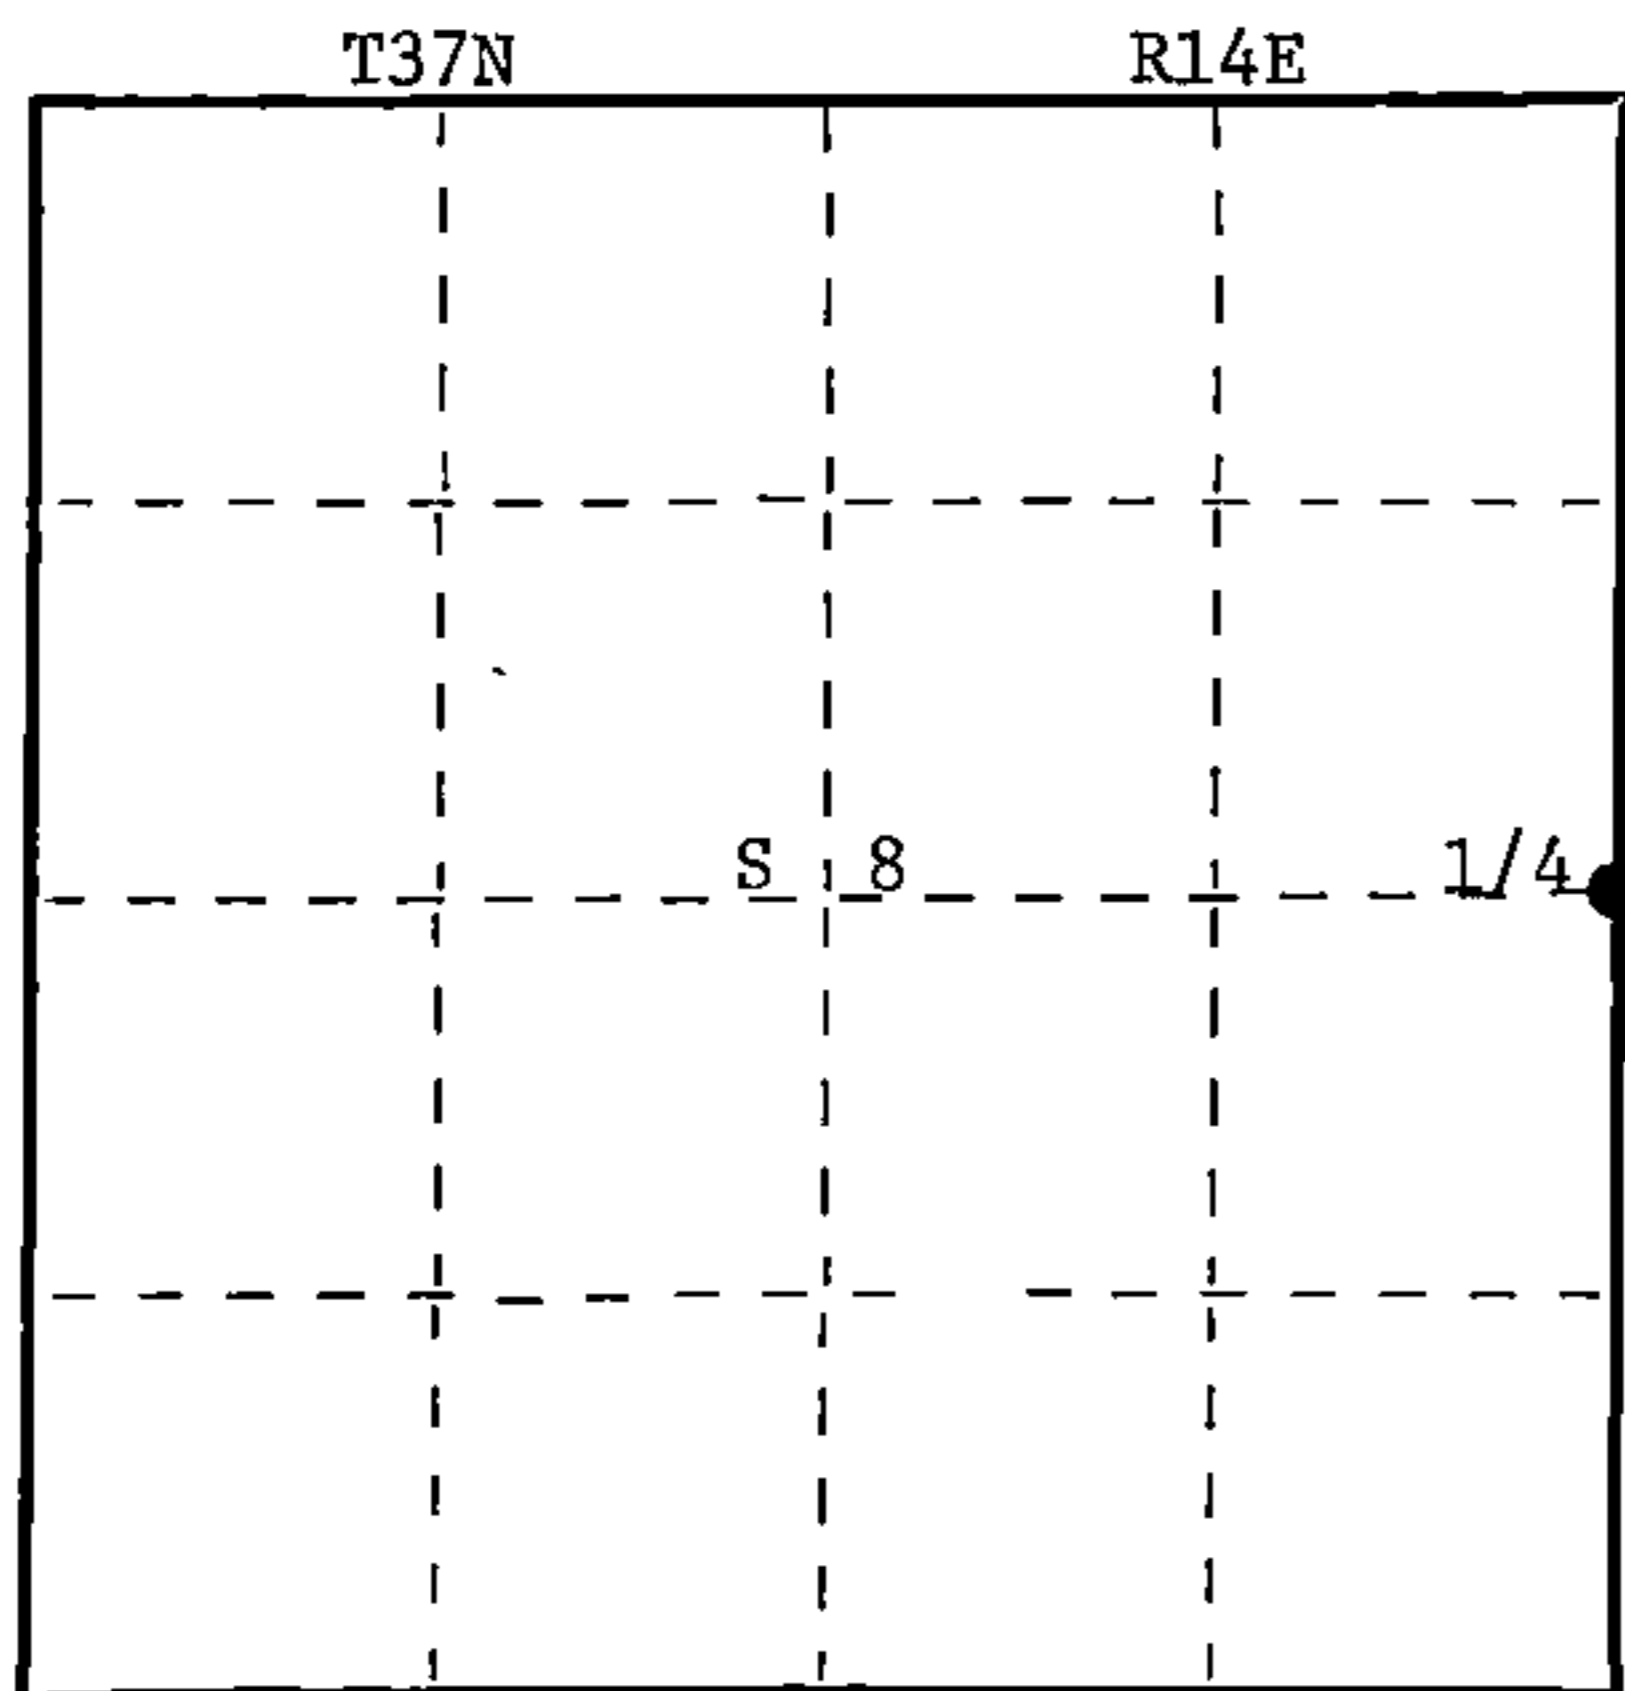

○ = Corner monument restored.

Dated at _____, Wis., this _____ day of _____, 19 _____

Signature Glen Barker Title Surveyor Registration No. 1682
(County Surveyor, Registered Land Surveyor, or other duly authorized official)

Office of Register of Deeds, County of Forest, I hereby certify that the within
instrument was filed in this office for record on the 18th day of May, 19 88
at 1:05 o'clock P. M.

Paul Aschenbrenner
(Register of Deeds)

By _____ Deputy

DOCUMENT NUMBER
135246

Stock No. 26272

FORM 985

McMillan Company

43714082000

