

CERTIFIED LAND CORNER RESTORATION

J-13 Index No. **J 13**


State of Wisconsin }  
County of Forest } ss.

I Philip T. Hansen, do hereby certify that on the 15th day of September, 1975, I found evidence of the Section corner of S9, S10, S15, S16 Township 37 North, Range 14 East, Fourth Principal Meridian, as described hereon; and that from this evidence I established a new monument and accessories as described hereon to perpetuate the original location of this corner.


Resident witnesses:

Glen Barker

Jim Claflin

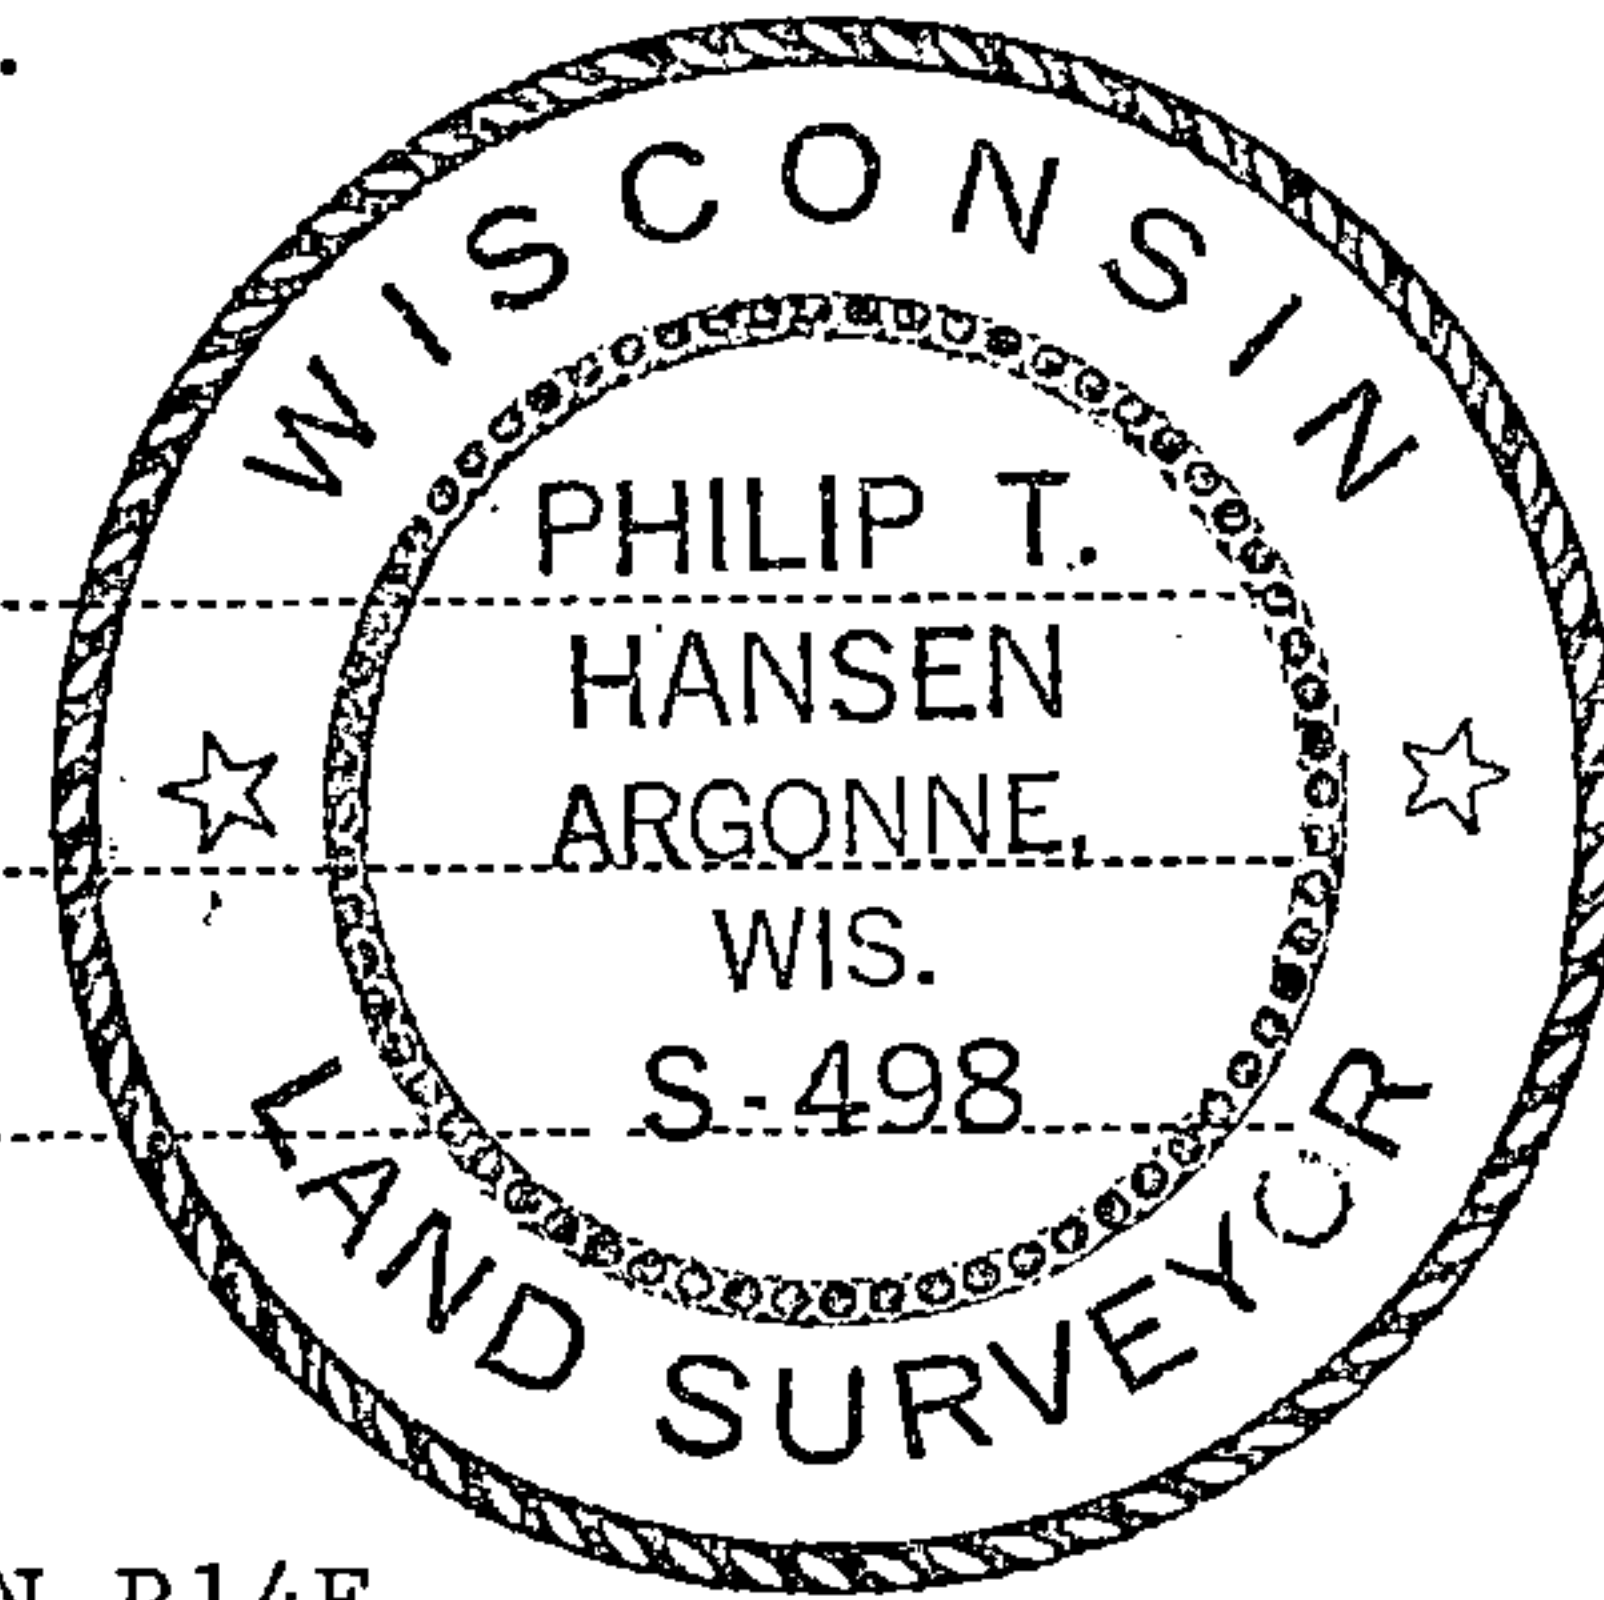

T37N R14E

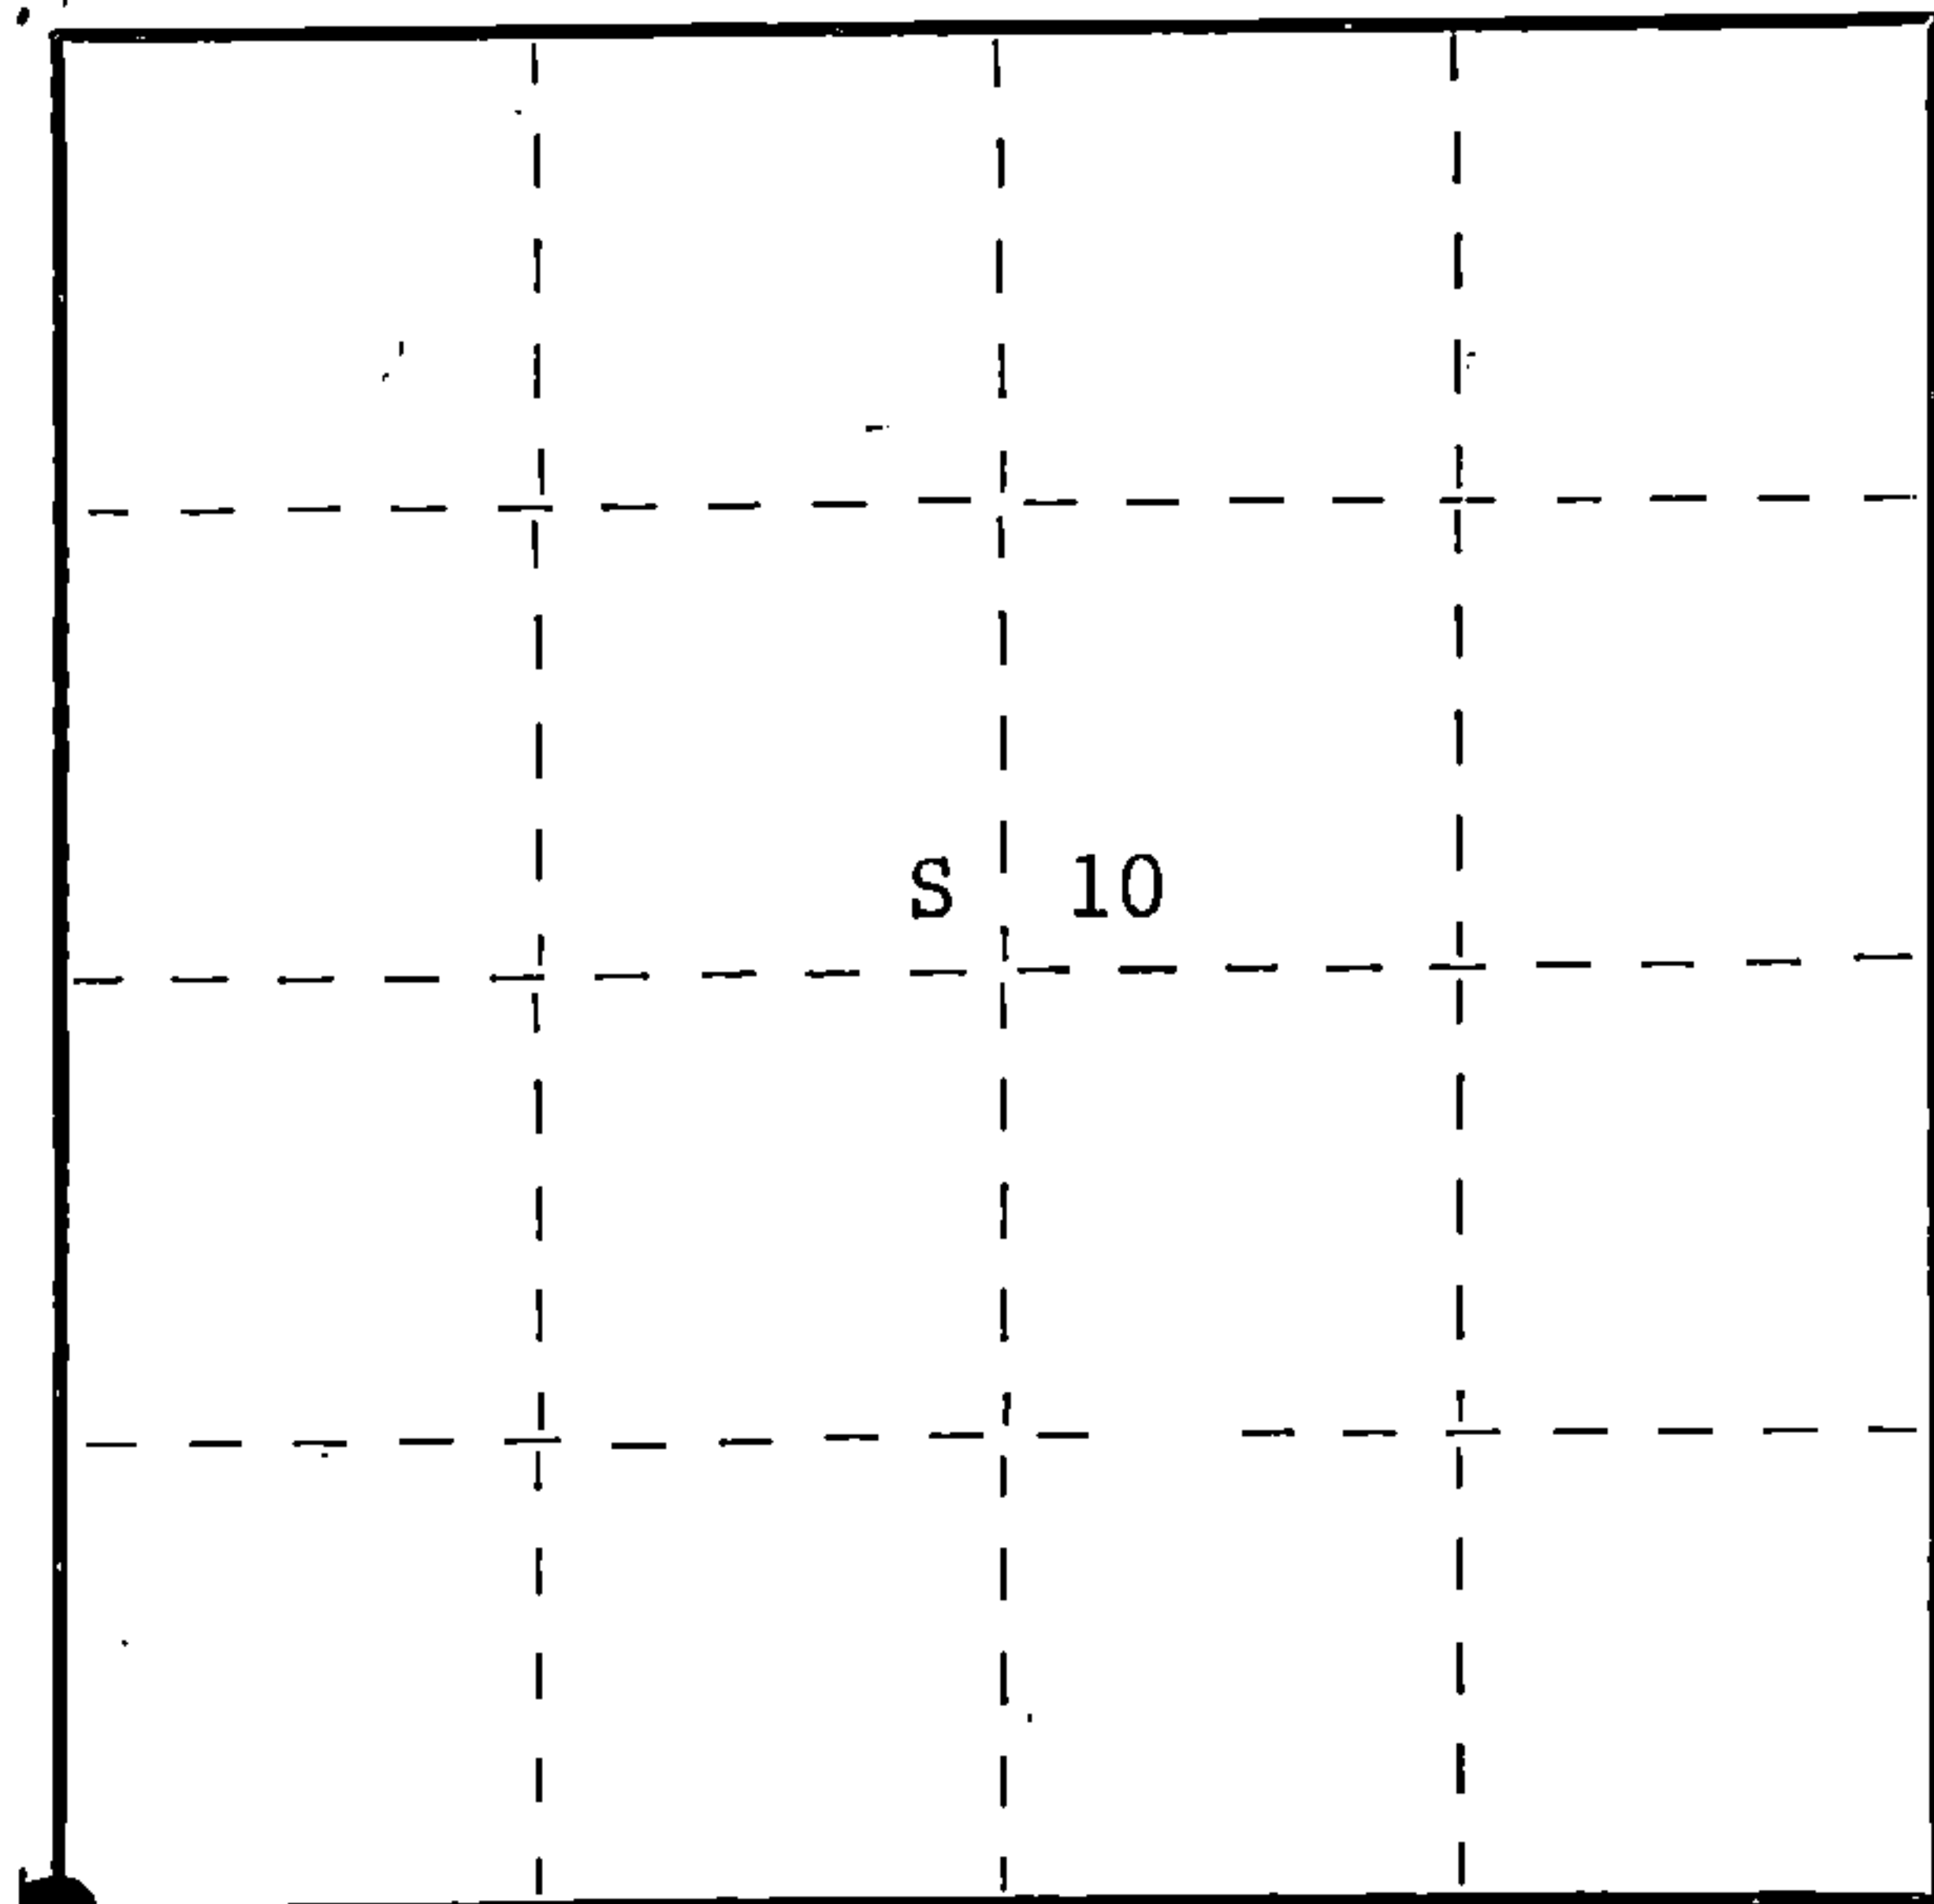

○ = Corner monument restored.

History of original corner establishment: Original corner established by James L. Nowlin, Government Deputy Surveyor, in 1865, from which cedar 12" bears N58°W 40 links and hemlock 8" bears N68°E 9 links. This corner recovered by E.B. Hurst, Consolidated forester, in 1930 while mapping for acquisition.

Corner perpetuated by Ray Leigh, Consolidated forester, and P.T. Hansen, Registered Land Surveyor, since 1930.

Description of corner evidence found:

Recovered 3" squared cedar post with a mound of rocks piled around it. Also an old cedar stake lying on the rock mound.

Recovered an old cedar lying on the ground with old scribing S9 BT. This bears N52°W a distance of 13 links to the face and scribing. No assurance that this is original location of fall.

Description of monument and accessories I established to perpetuate the original location of this corner.

Replaced 3" squared post with 2-1/2" x 30" Berntsen A-1 Federal Monument, aluminum pipe with magnet installed in cap and base. The post projects 6" above the ground. Cap stamped -

NBT's - Red maple 6" S72°W 55.6 links scribed SC BT.  
Red maple 6" N47°W 39.6 links scribed SC BT.  
Hemlock 12" N22°E 85.2 links scribed SC BT.

S498  
T37N R14E  
S9 | S10  
S16 | S15

Corner and accessories painted blue.

1975

Dated at Argonne, Wis., this 24th day of September, 1975.

Signature *Philip T. Hansen* Title Registered Land Surveyor Registration No. S-498  
(County Surveyor, Registered Land Surveyor, or other duly authorized official)

Office of Register of Deeds, County of Forest, I hereby certify that the within instrument was filed in this office for record on the 30th day of September, 1975 at 3:15 o'clock P. M.

DOCUMENT NUMBER 107869

*Eugene Staszny*  
(Register of Deeds)

By Deputy

FORM 985 R. C. MILLER CO., MILWAUKEE

0000604154