


CERTIFIED LAND CORNER RESTORATION

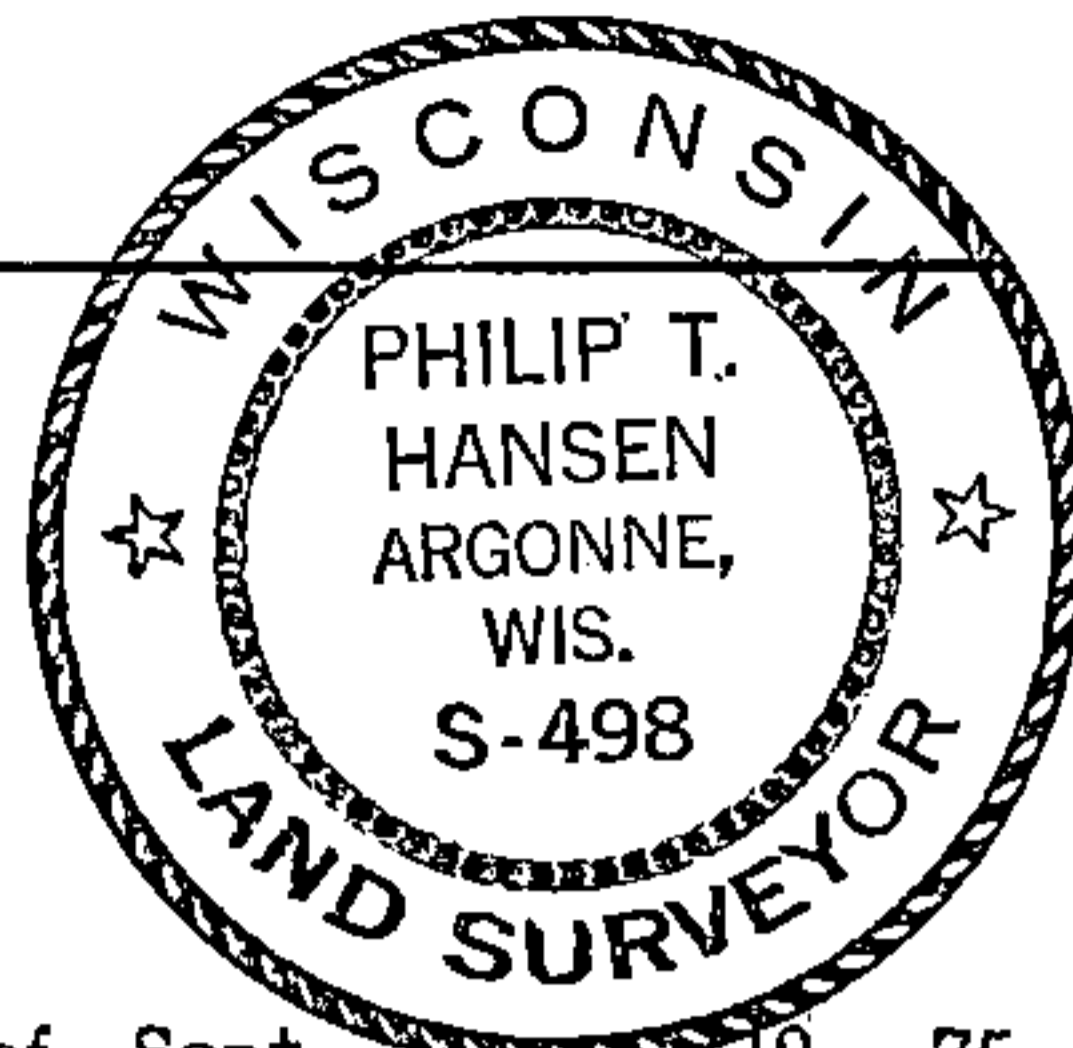

State of Wisconsin }
County of Forest } ss.

I, Philip T. Hansen, do hereby certify that on the 25 day of Sept. 1975 I found evidence of the Section Corner corner of Sec. 19, 20, 29, 30 Township 37 North Range 14 East, Fourth Principal Meridian, as described hereon; and that from this evidence I established a new monument and accessories as described hereon to perpetuate the original location of this corner:

Description of original monument and accessories and subsequent restorations: Original corner established by James L. Nowlin, Gov. Deputy Surveyor, in 1865 from which Ash 8" bears N 72° W 15 lks and Ash 7" bears N 57° E 30 lks. This corner was recovered by E.B. Hurst, Consolidated Forester in 1932. Corner has been perpetuated by Consolidated Forester, Ray Leigh and P.T. Hansen, Reg. Land Surveyor since 1932.

Description of corner evidence found: Recovered 3" squared cedar post, in poor condition. Corner had been painted blue. Area has been planted to spruce.


Description of monument and accessories I established to perpetuate the location of this corner: Replaced 3" squared cedar post with 2 1/2" x 30" Berntsen, A-1 Federal monument, aluminum pipe with magnet installed in cap and base. Post projects 6" above ground. Cap stamped.

NBYs - W. Spruce 7" S46°E 19.7 lks Scribed SC BT
W. Spruce 6" N52°W 28.3 lks Scribed SC BT
W. Spruce 6" S 9°W 41.4 lks Scribed SC BT

S 498
T 37 N R 14 E
S19 | S20
S30 | S29
1975

Pipe and NBTs painted blue

T 37 N R 14 E

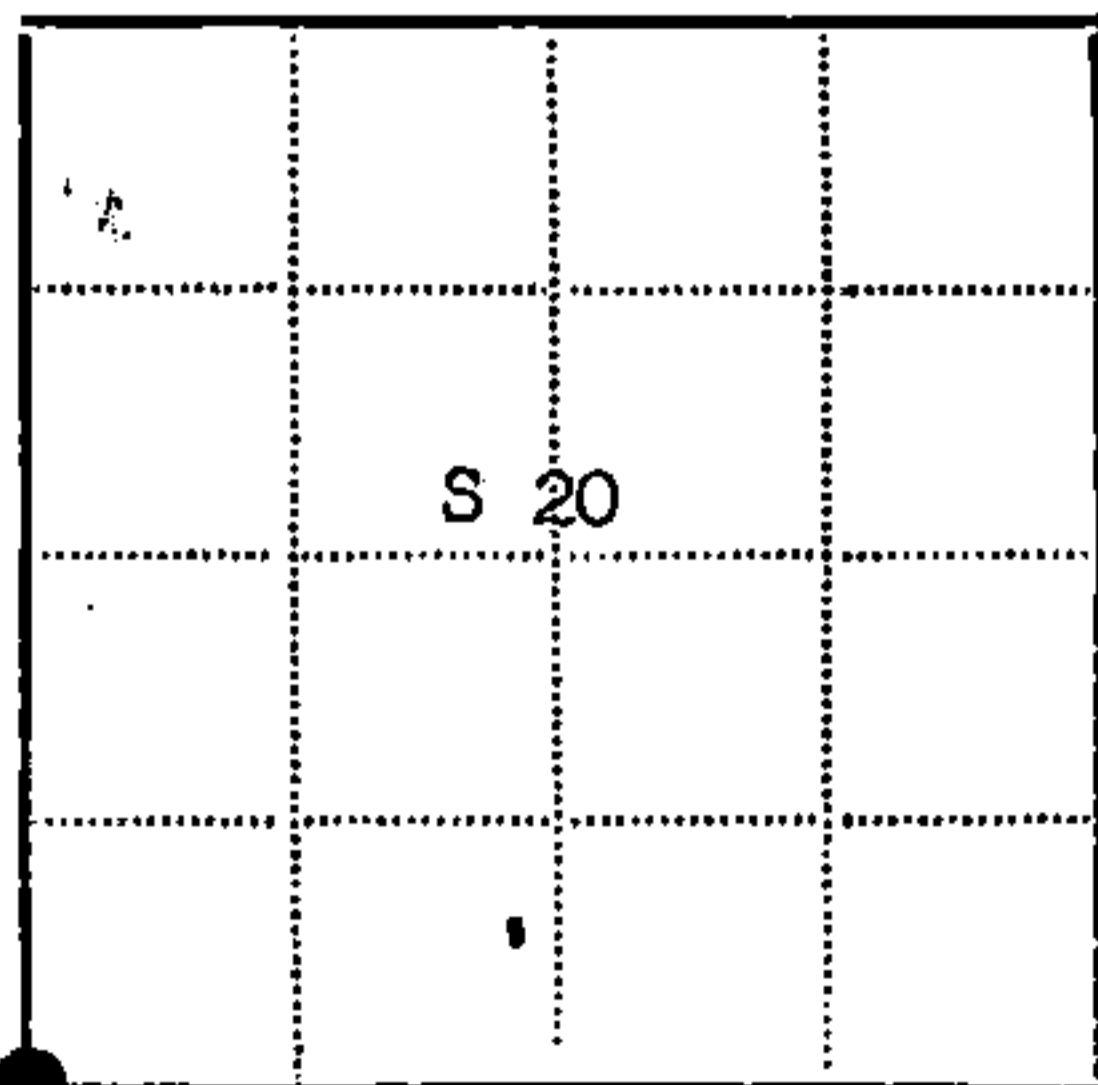

Resident witnesses Glen Barker and Jim Claflin

Dated at Argonne Wisconsin, this 29 day of Sept 1975.

Signature Philip T. Hansen Title Reg. Land Surveyor
(County Surveyor, Registered Land Surveyor, or other duly authorized official)

Surveyors Registration No. S498 DOCUMENT NUMBER 107921

Office of Register of Deeds County of Forest

I hereby certify that the within instrument was filed in this office for record on the 6th day of October 1975, and was filed in Book No. Page No. of County Records.

Signature Eugene Stutzman Title Register of Deeds

Township 37 N Range 14E Section 20 Index No. Page No.