

CERTIFIED LAND CORNER RESTORATION



State of Wisconsin

County of Forest

ss.

I, Philip T. Hansen, do hereby certify that on the 24th day of September, 1975, I found evidence of the section corner corner of S22, 23, 26, 27 Township 37 Range 14 East, Fourth Principal Meridian, as described hereon; and that from this evidence I established a new monument and accessories as described hereon to perpetuate the original location of this corner:

Description of original monument and accessories and subsequent restorations: Original corner established by James L. Nowlin, Gov. Deputy Surveyor in 1865, from which cedar 10" bears N41°E 25 lks, and spruce 8" bears N39°W 20 lks.

Corner recovered and restored by J.R. Ritter, County Surveyor in 1921, from which spruce 6" bears 11 lks, spruce 6" bears N28°E 28 lks and tamarack 14" bears S42°W 24½ lks.

Corner recovered by P.T. Hansen, Registered Land Surveyor in 1970. Recovered Ritter's post and BT's intact, post in poor condition. Set 1½" iron pipe beside old post.

Description of corner evidence found:

Recovered 4" cedar post, squared and scribed post decayed so bad was unable to distinguish scribing. Also recovered 1½" iron pipe setting beside it.

Recovered OBT spruce 6" due east, 11 lks. Now a decayed stump. BT scribe marks visible. spruce 6" N28°E 26 lks. Now a decayed stump. Scribe marks visible. tamarack 14" S42°W 24.5 lks. Now a decayed stump.

Description of monument and accessories I established to perpetuate the location of this corner:


Replaced old post with 2½" x 30" Berntsen A-1 Federal Monument, aluminum post with magnets installed in cap and base. Post projects 6" above ground.

Cap stamped

S-498
T37N R14E

NBTS - Cedar 6" S54°E 8.6 lks scribed SC BT.
Cedar 6" N26°W 31.2 lks scribed SC BT.
Cedar 7" S65°W 14.6 lks scribed SC BT.

S22 S23
S27 S26
1975

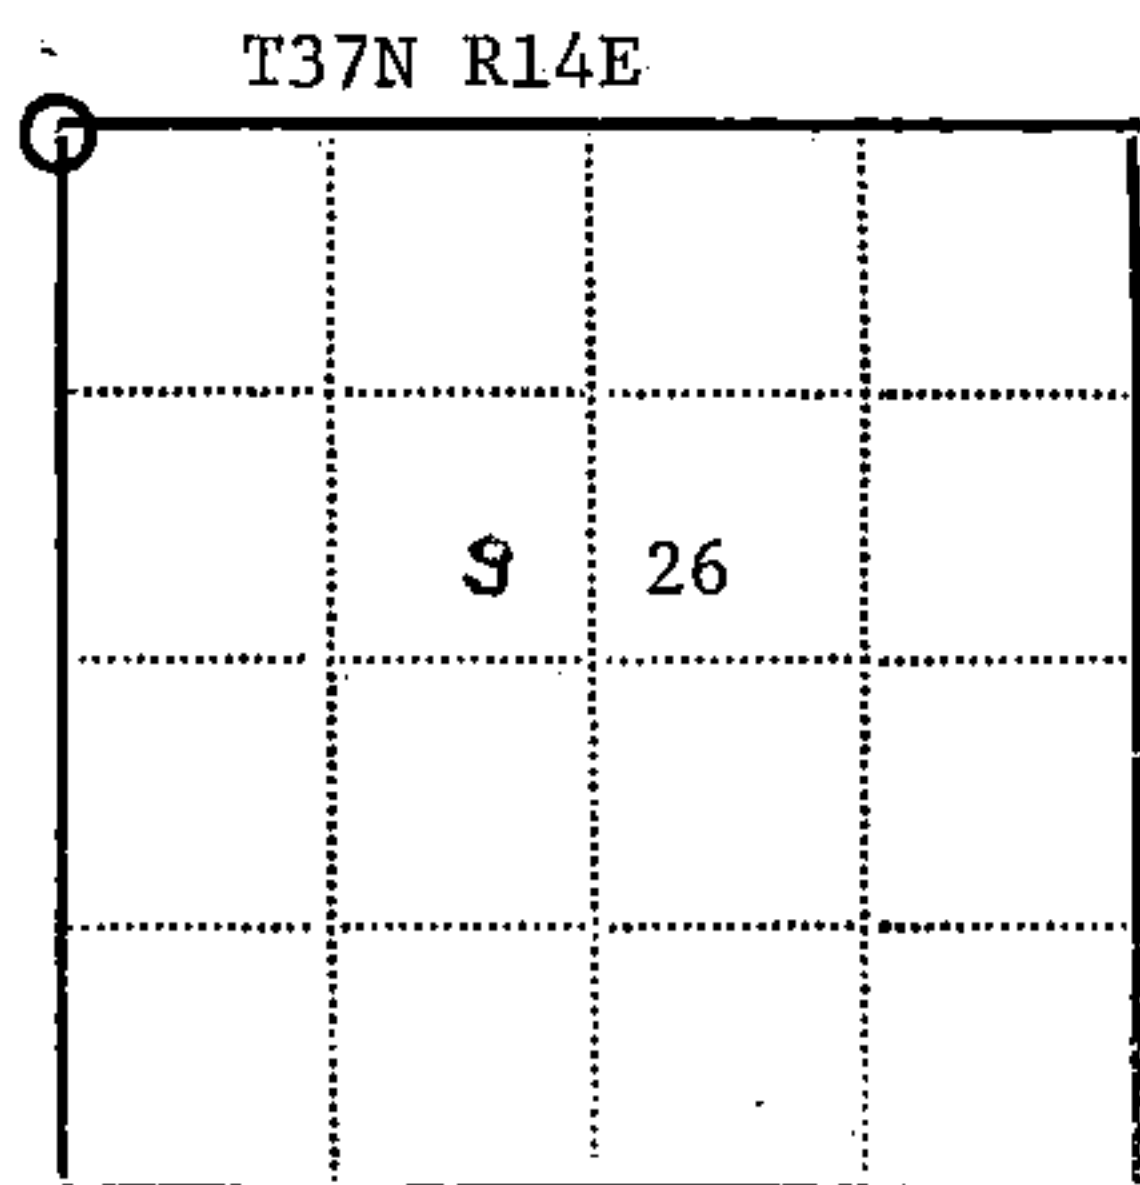

● - Corner monument restored
□ -

Resident witnesses Glen Barker and Jim Claflin

Dated at Argonne Wisconsin, this 29th day of September 1975.

Signature *Philip T. Hansen* Title Registered Land Surveyor
(County Surveyor, Registered Land Surveyor, or other duly authorized official)

Surveyors Registration No. S-498 DOCUMENT NUMBER 107922

Office of Register of Deeds County of Forest

I hereby certify that the within instrument was filed in this office for record on the 6th day of October 1975, and was filed in Book No. Page No. of County Records.

Signature *Eugene Staszny* Title Register of Deeds

Township 37 North Range 14 E Section 26 Index No. Page No.