

CERTIFIED LAND CORNER RESTORATION


Index No. P-25

P25


State of Wisconsin }
County of Forest } ss.

I Daniel K. Plegger, do hereby certify that on the 16th day of April, 1981, I found evidence of the Quarter corner of Sections 19 and 24 Township 37 North, Range 14 & 15 East, Fourth Principal Meridian, as described hereon; and that from this evidence I established a new monument and accessories as described hereon to perpetuate the original location of this corner.

Resident witnesses:

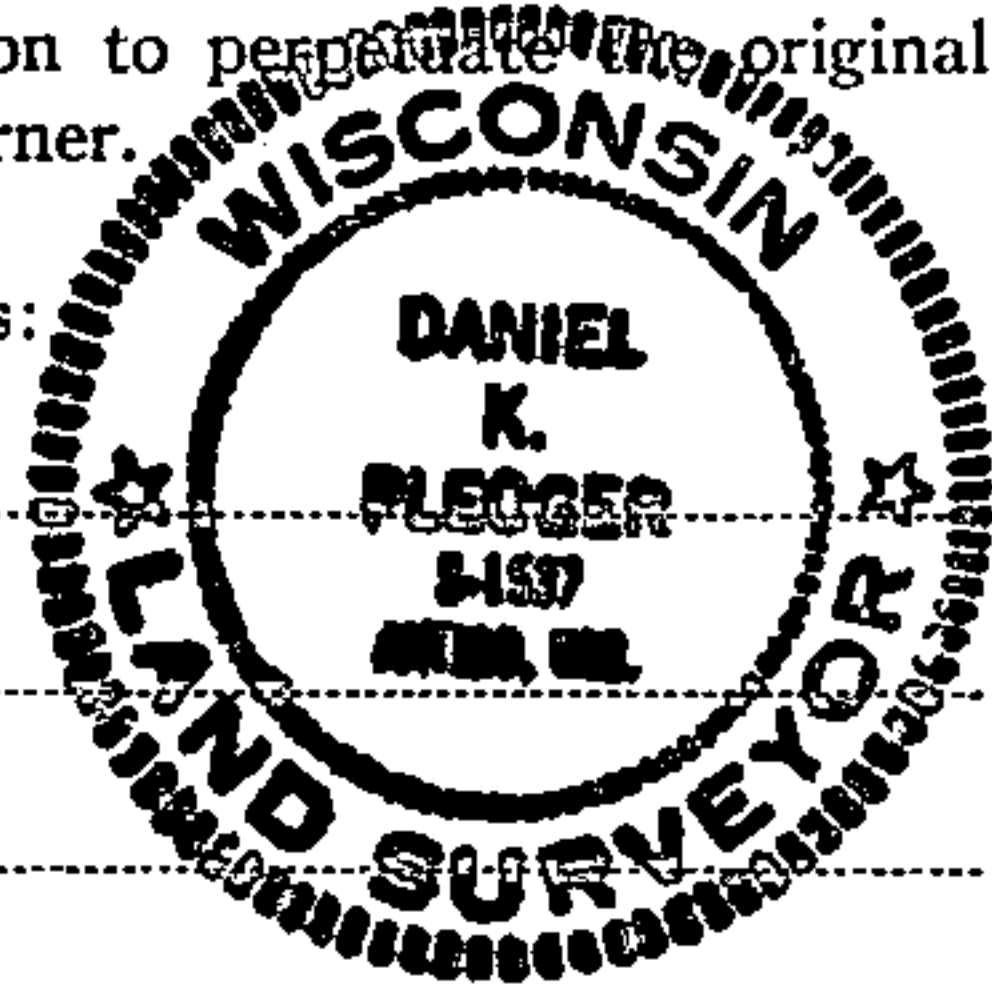

FORM 985 R. C. MILLER CO., MILWAUKEE

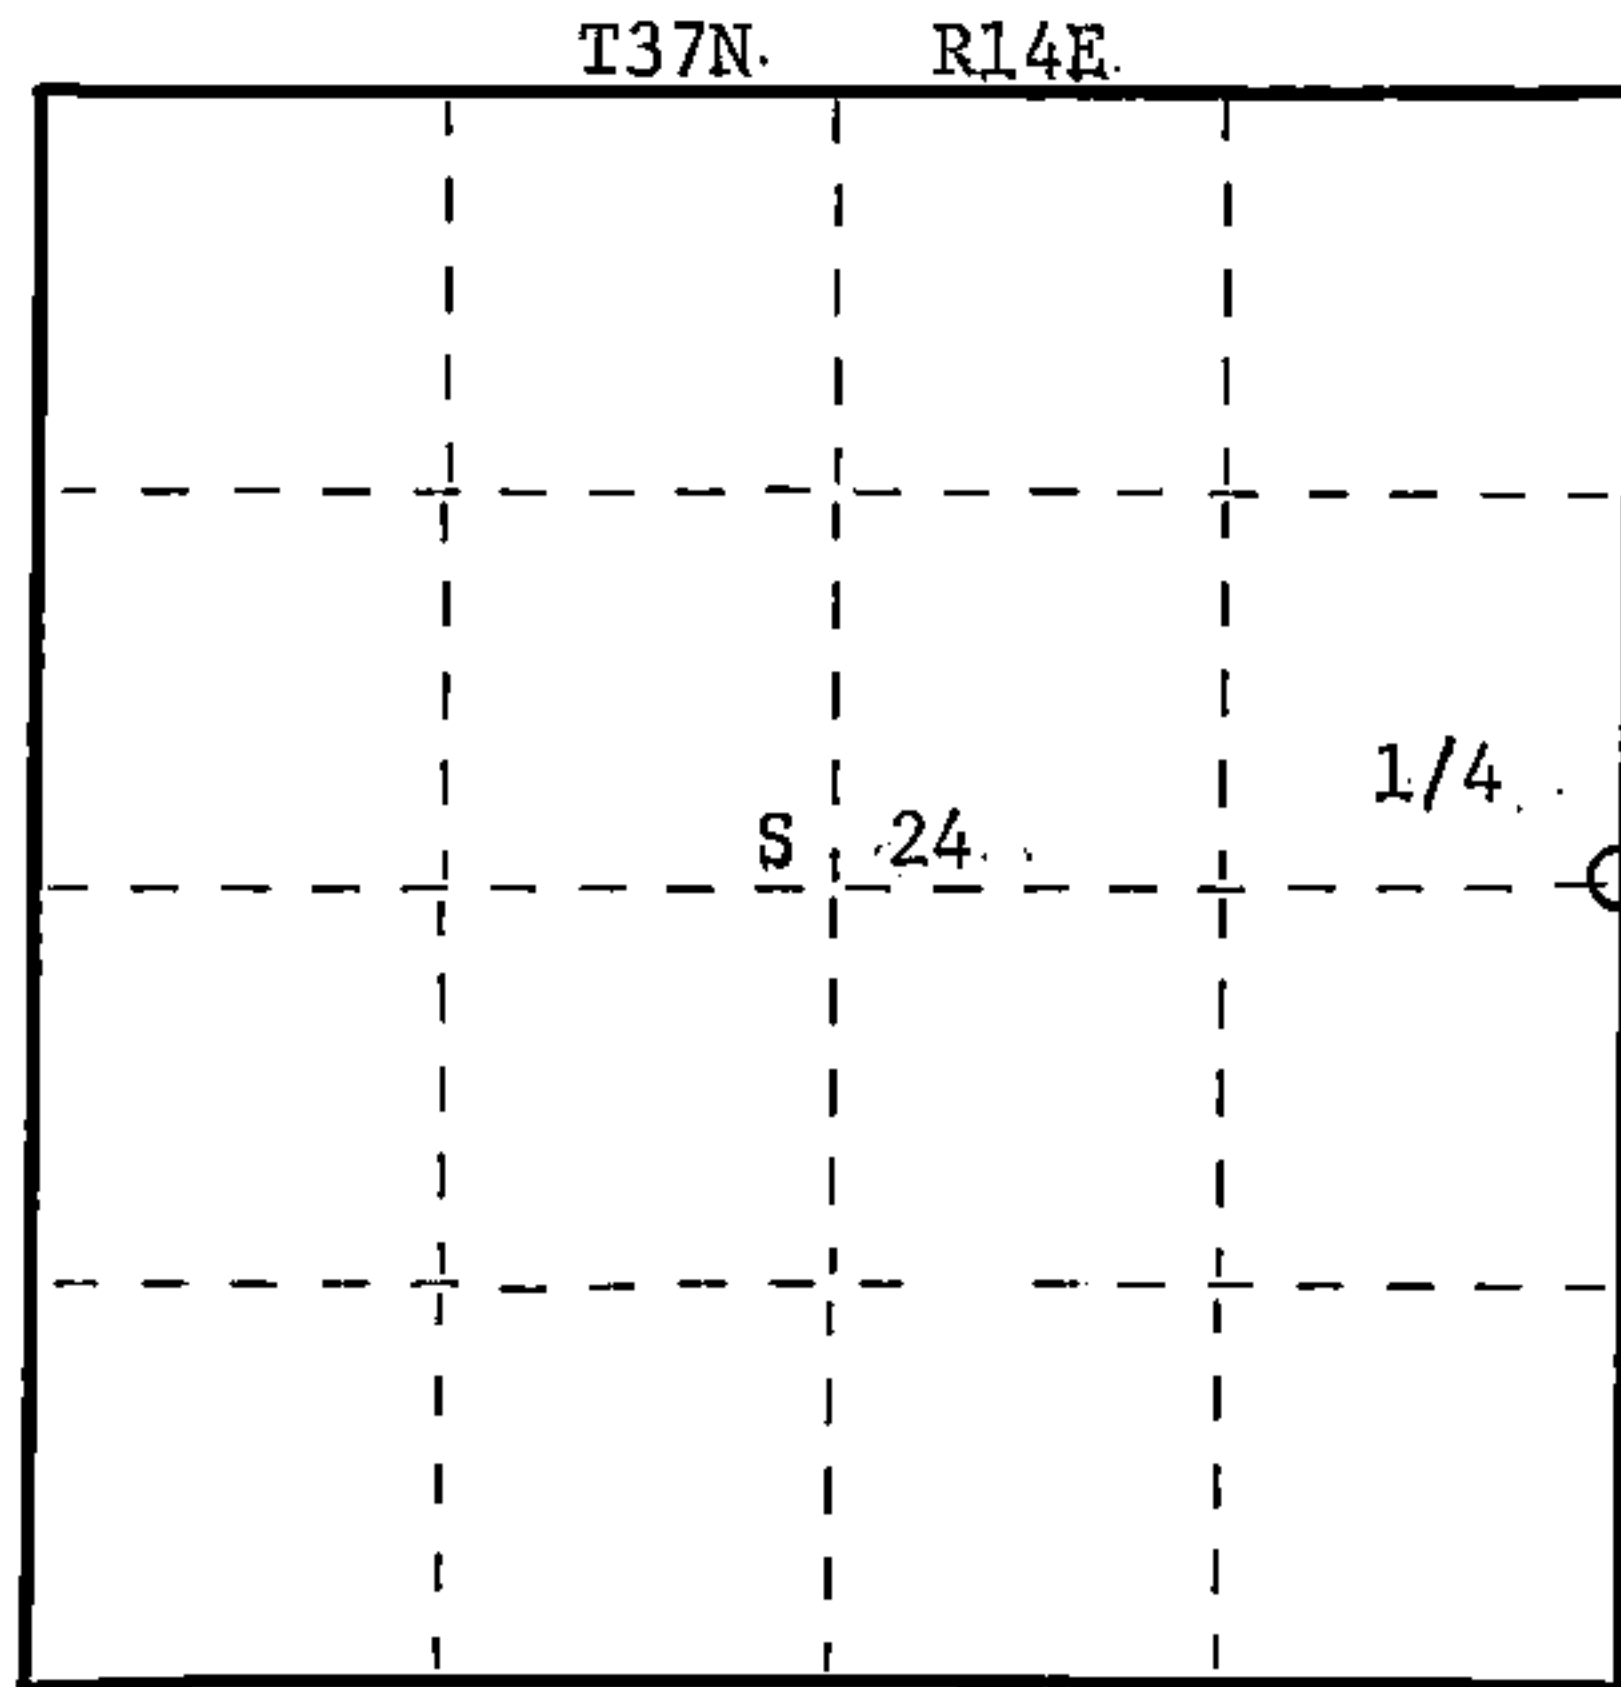

○ = Corner monument restored.

History of original corner establishment:

Original corner established by James L. Nowlin, government deputy surveyor, in 1865 from which Tamarack 6" bears S18°W 33 links and Tamarack 6" bears N23°E 34 links.

Description of corner evidence found:

Recovered an old 3" squared cedar stake laying down, no scribing legible - found pieces of point at end of stake. There is an old U.S.F.S. Location Tag tacked to a 10" cedar which bears S52°E 11.67 feet. Recovered old tamarack stump which bears N16°E 39 links.

Description of monument and accessories I established to perpetuate the original location of this corner.

Set a 2-1/2" aluminum federal A-1 monument with alloy cap - stamped: Monument projects 12" above ground.

Marked NBT's:

Cedar 8" S56°W 14.60 feet
Cedar 5" N83°W 49.79 feet
Cedar 6" S81°E 46.23 feet
scribed 1/4 B.T.

R14E - T37N - R15E
1/4 24 + 19
S1537 - 1981

Dated at Rhinelander, Wis., this 22nd day of June, 1981.

Signature Daniel K. Plegger Title Registered Land Surveyor Registration No. 1537
(County Surveyor, Registered Land Surveyor, or other duly authorized official)

Office of Register of Deeds, County of Forest, I hereby certify that the within instrument was filed in this office for record on the 1st day of July, 1981 at 8:30 o'clock A.M.

Eugene Stutzman
(Register of Deeds)
By _____ Deputy

DOCUMENT NO.
120034

437142H2000