

CERTIFIED LAND CORNER RESTORATION


State of Wisconsin }  
County of Forest } ss.

I Philip T. Hansen, do hereby  
certify that on the 18th day  
of December, 1975, I found  
evidence of the Quarter  
corner of Sections 25 and 30  
Township 37, North, Range  
14 and 15, Fourth Principal Meridian,  
as described hereon; and that from this evidence  
I established a new monument and accessories  
as described hereon to perpetuate the original  
location of this corner.


Resident witnesses:

Glen Barker

Jim Claflin

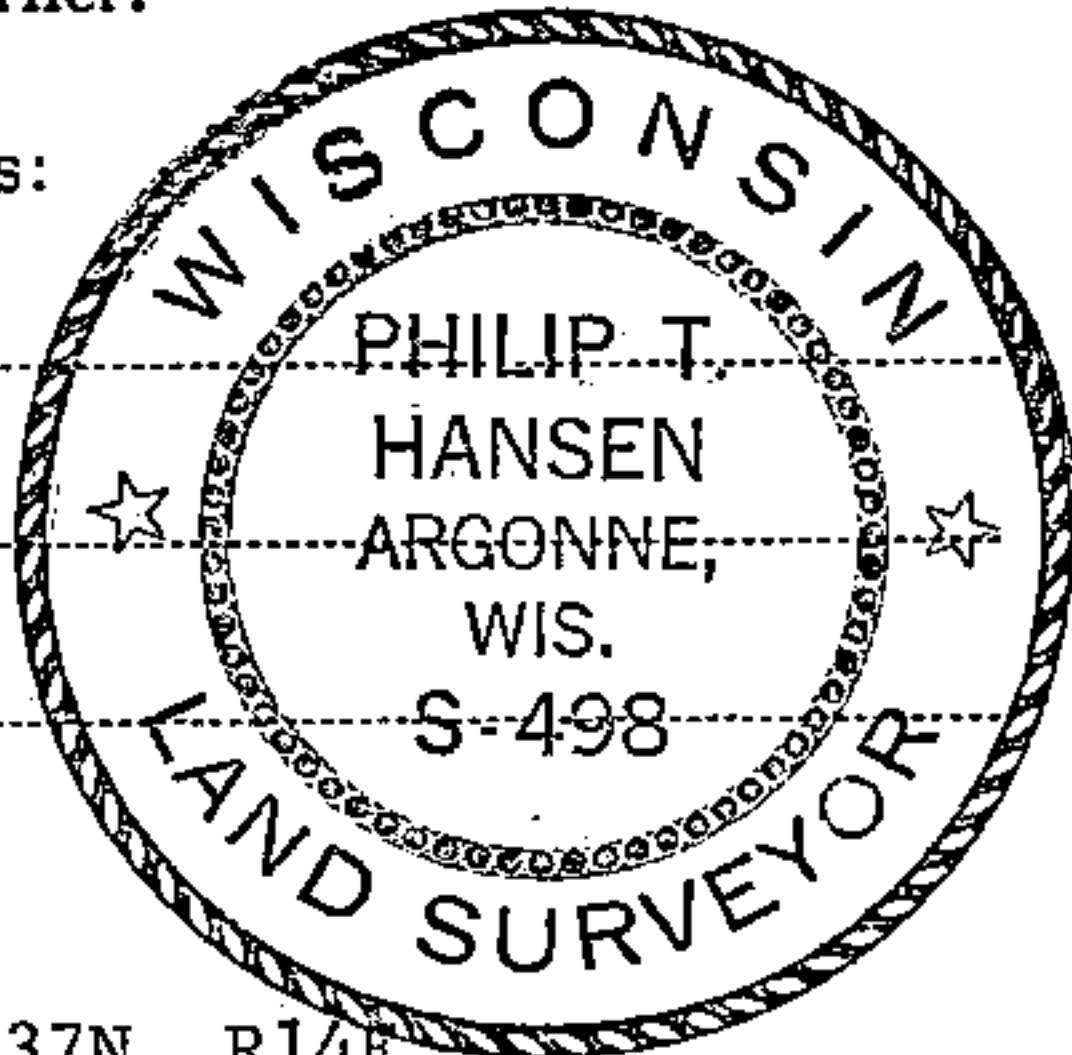

T37N, R14E

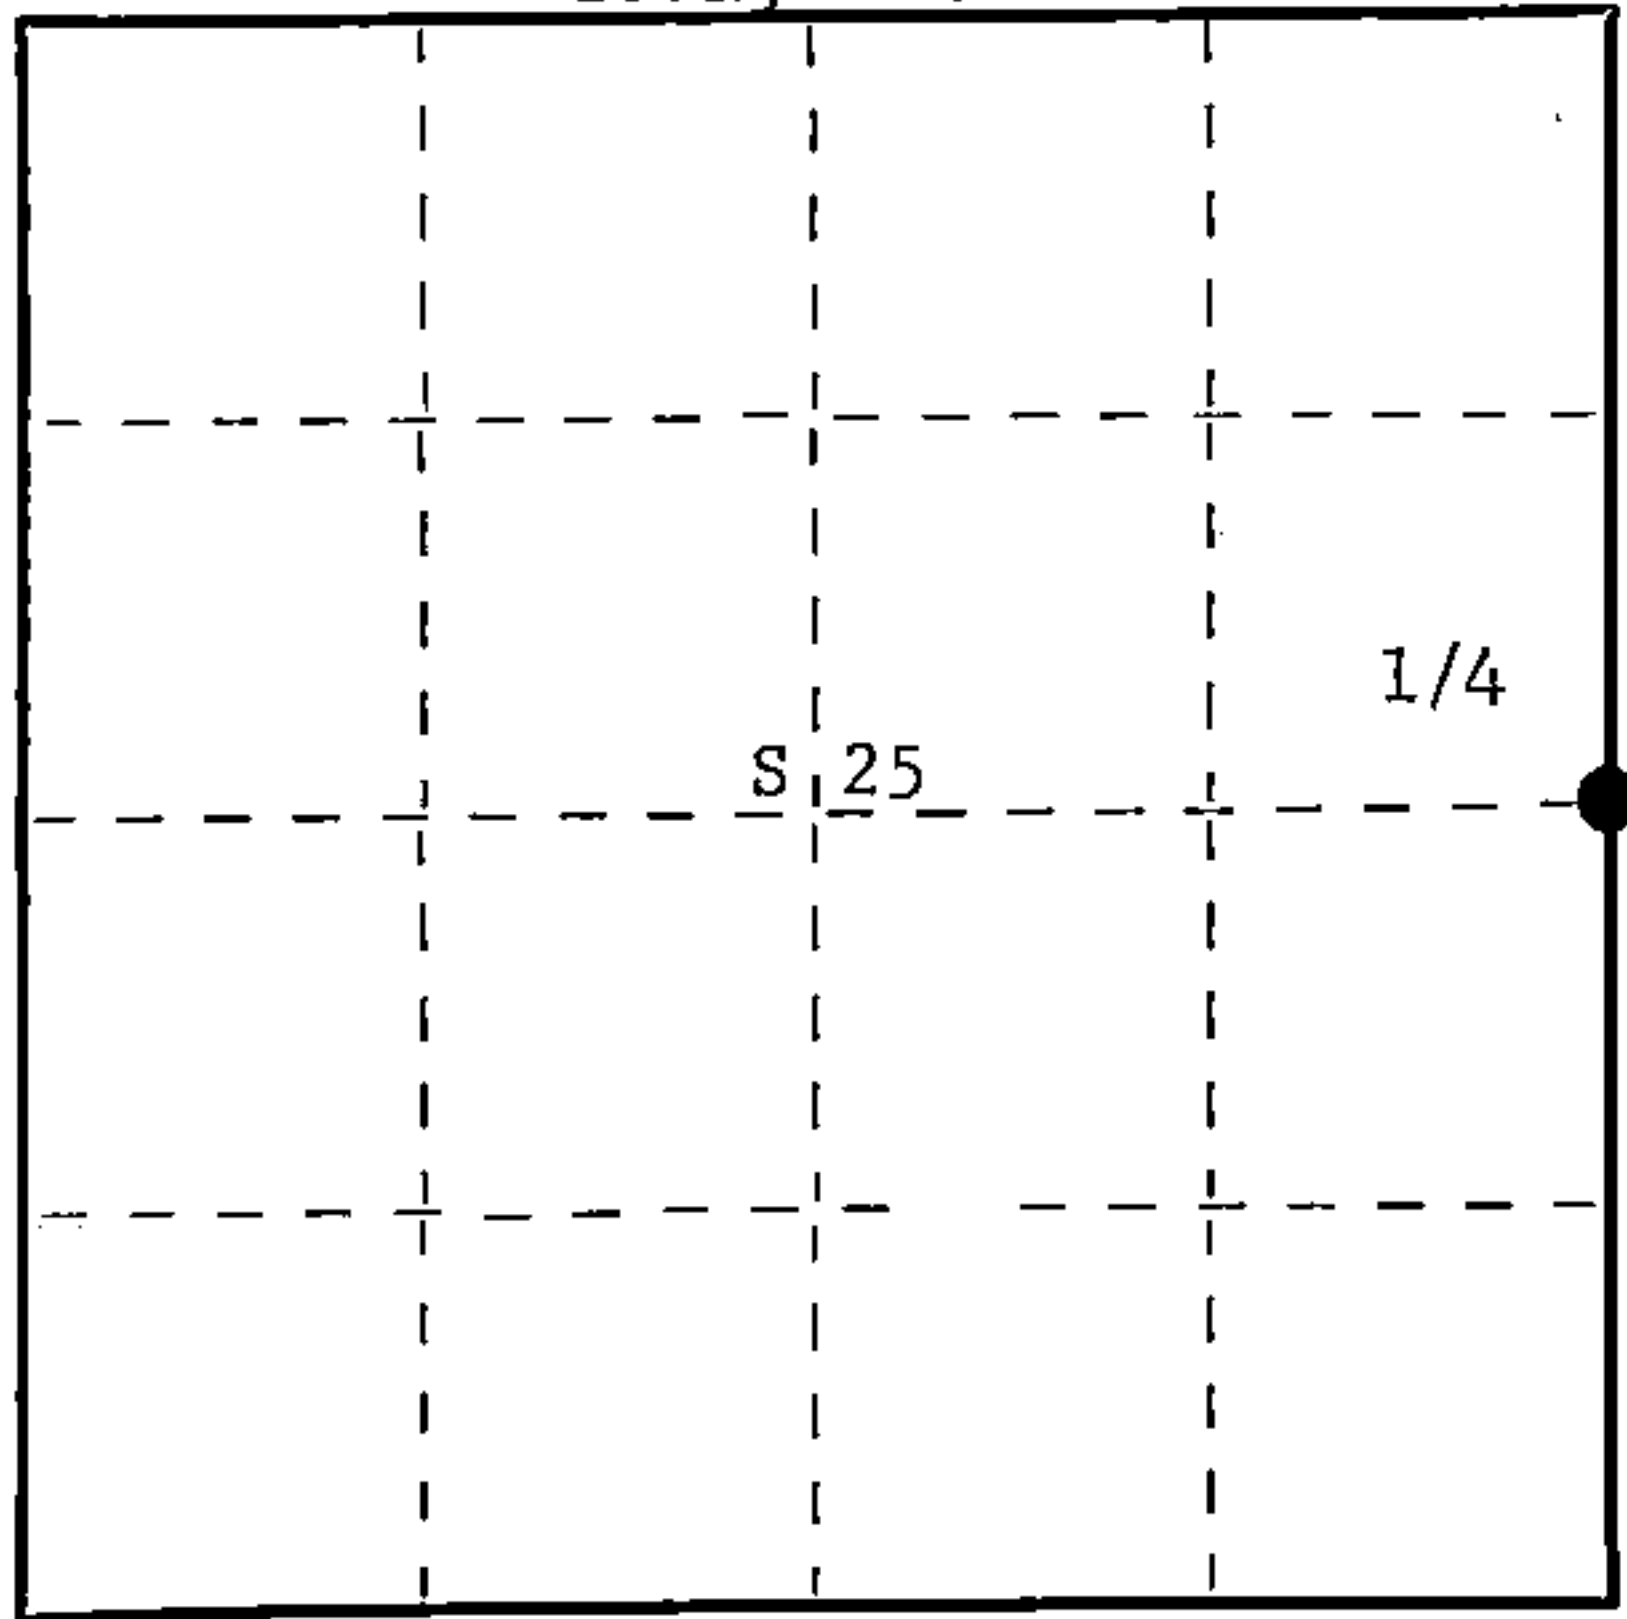

○ = Corner monument restored.

History of original corner establishment:  
Original corner established by A. Millard, Deputy Surveyor, in 1858 from which elm 6" bears  
N88°W, 40 lks., and aspen 12" bears N58°E, 59 lks.

No record of any subsequent survey.

Corner recovered by Ray Leigh, Consolidated Forester, in 1947 while cruising and mapping.  
Recovered old squared wood post. Replaced same with 3" squared wood post.

Description of corner evidence found:  
Recovered 3" squared spruce post in poor condition.  
No evidence of OBT's visible.

Description of monument and accessories I established to perpetuate the original location of this corner.  
Replaced spruce post with 2-1/2" Berntsen, A-1 Federal Monument, aluminum with magnet in-  
stalled in cap and base. Pipe projects 12" above ground. Cap stamped -

NBT - W. spruce 12" N35°E 152.9 lks. scribed 1/4 BT.  
Maple 7" N88°E 41.2 lks. scribed 1/4 BT.

Propped old post beside new pipe.  
Painted pipe, post, and NBT's blue.

S498  
T37N  
R S25 | S30 R  
14 | 15  
E 1/4 E

1975

Dated at Argonne, Wis., this 23rd day of December, 1975.

Signature Philip T. Hansen Title Reg. Land Surveyor Registration No. S-498  
(County Surveyor, Registered Land Surveyor, or other duly authorized official)

Office of Register of Deeds, County of Forest, I hereby certify that the within  
instrument was filed in this office for record on the 5th day of January, 1976  
at 2:45 o'clock P.M.

DOCUMENT NUMBER 108500

EUGENE STATEZNY  
(Register of Deeds)  
By Eileen Schmidt Deputy

FORM 985 R. C. MILLER CO., MILWAUKEE

43714252000