


CERTIFIED LAND CORNER RESTORATION

Index No. **F-23**


State of Wisconsin }
County of Forest } ss.

I Daniel K. Pleoger, do hereby certify that on the 27th day of April, 1981, I found ~~evidence of the~~ established Center Quarter corner of Section 25 Township 37 North, Range 14 East, Fourth Principal Meridian, as described hereon; and that from this evidence I established a new monument and accessories as described hereon to perpetuate the original location of this corner.

Resident witnesses:

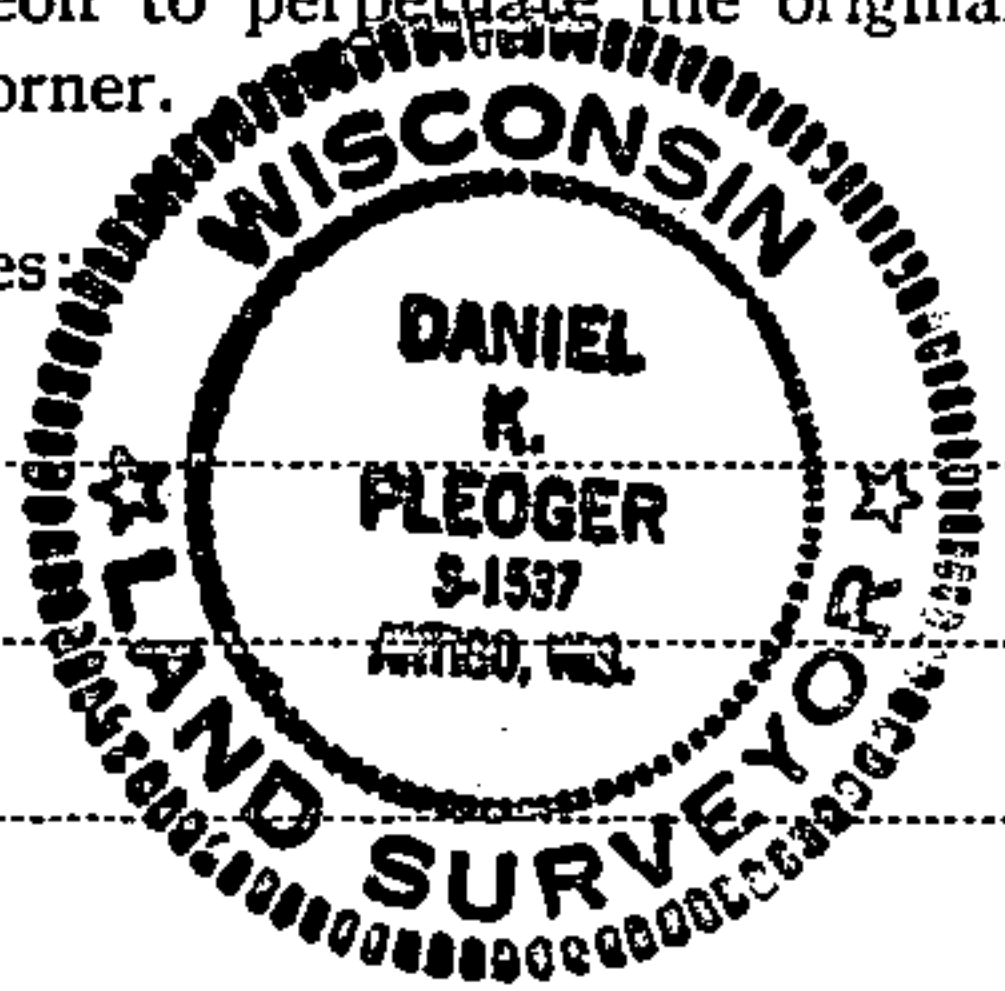

FORM 985 H. C. MILLER CO., MILWAUKEE

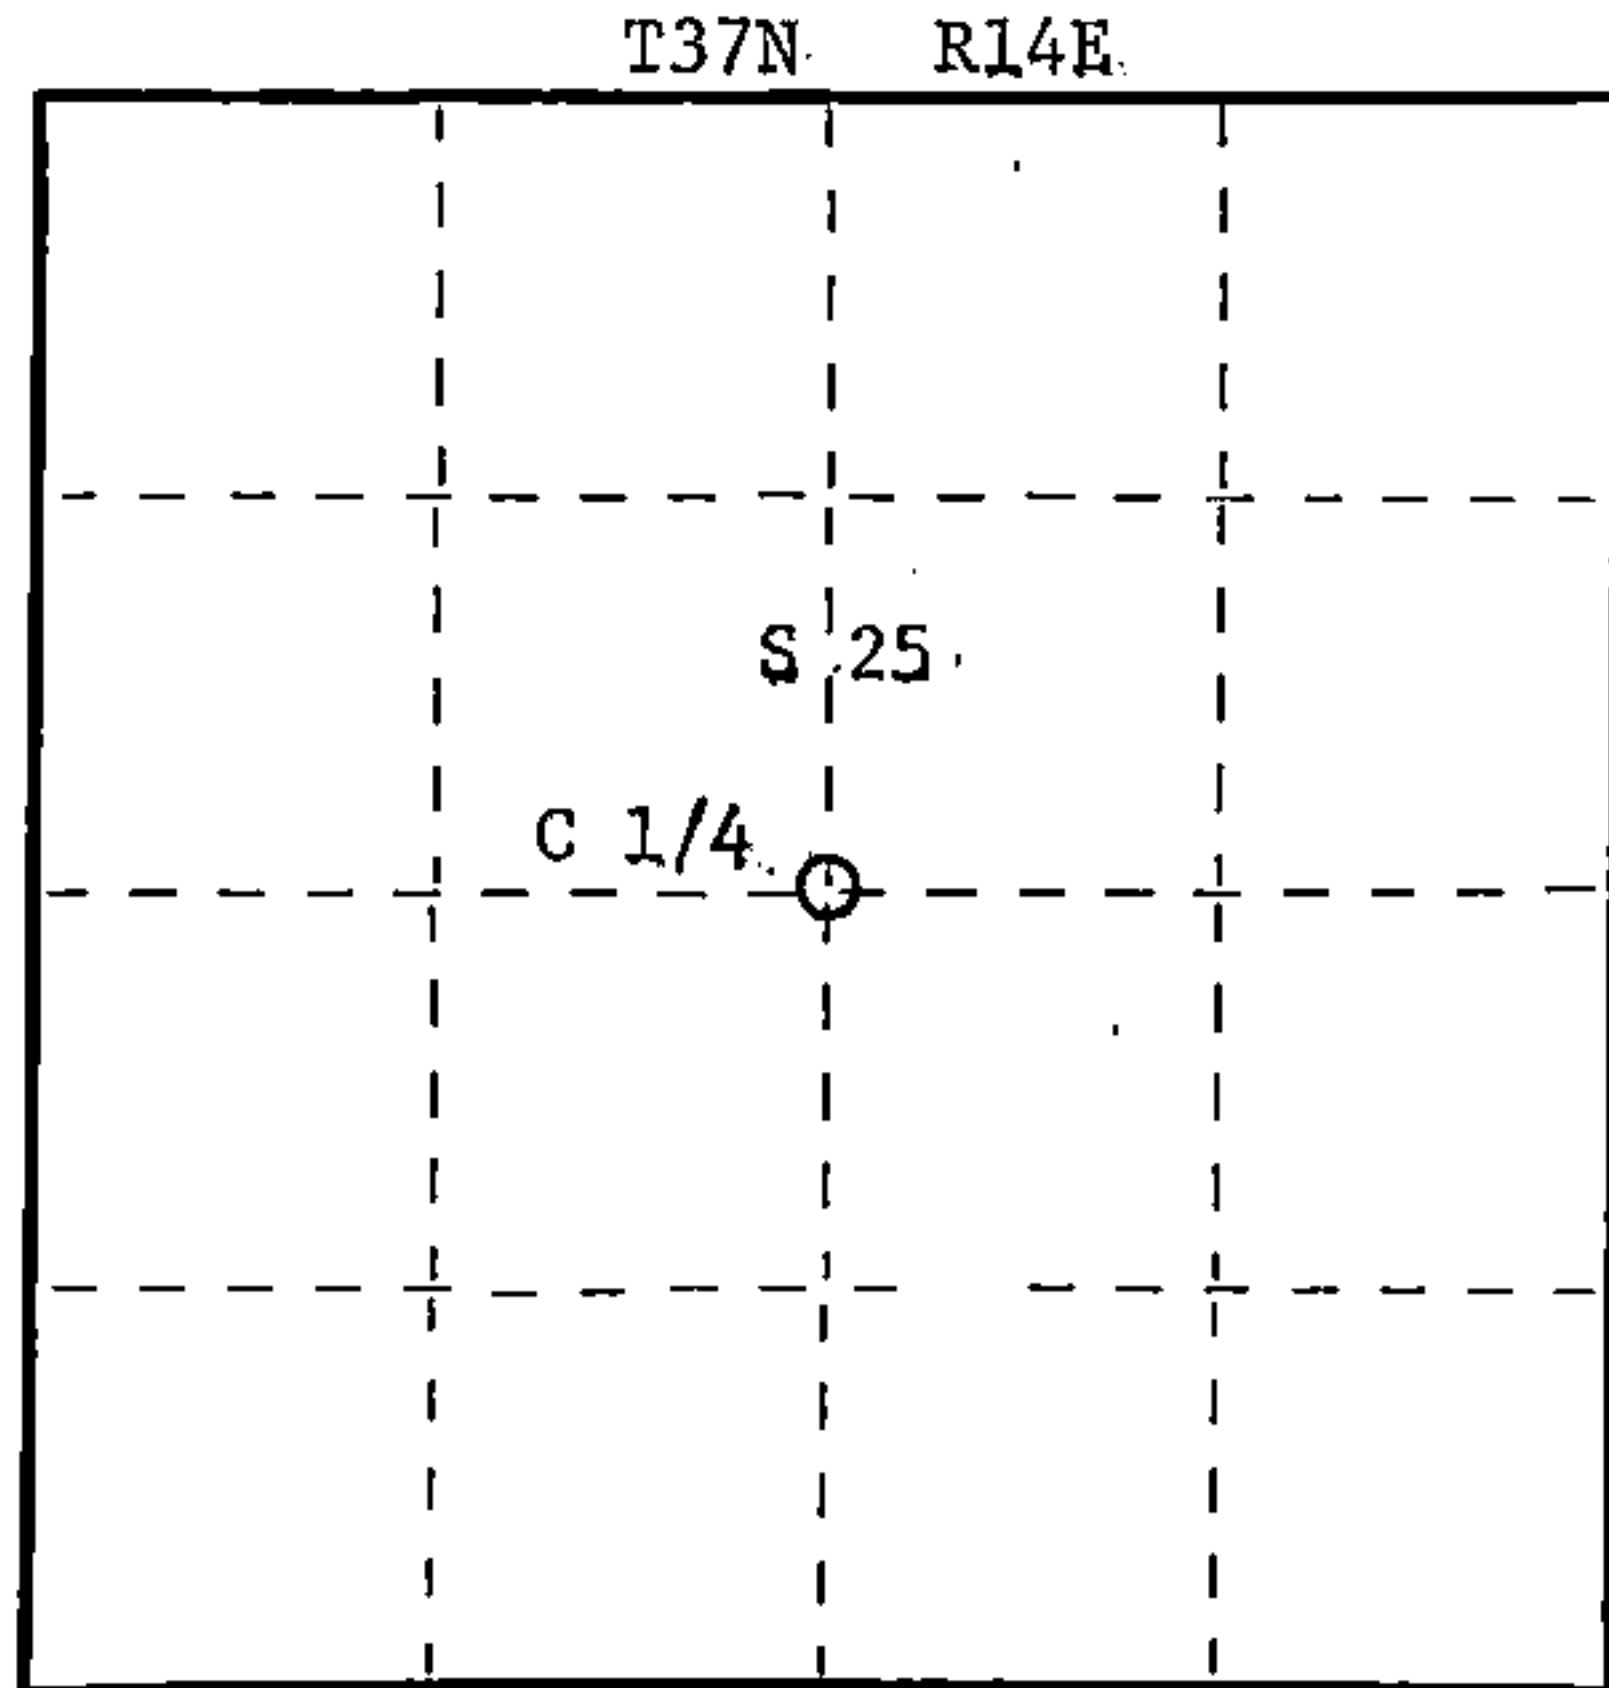

○ = Corner monument restored.

History of original corner establishment:

No evidence of any previous corner.

Description of corner evidence found:

Corner established by subdividing section corner. Sets S 0-19-00 E 2586.684 feet of N 1/4 corner, N 85-47-51 W 2711.634 feet of E 1/4 corner, N 0-19-00 W 2592.335 feet of S 1/4 corner and S 85-47-51 E 2701.842 feet of W 1/4 corner.

Description of monument and accessories I established to perpetuate the original location of this corner.

Set a 2-1/2" aluminum pipe with alloy cap - stamped:
Monument projects 12" above ground.

Marked NBT's:

Cherry 7" N31°E 34.20 feet
Cherry 7" N49°E 50.35 feet
W. Birch 5" S49°E 73.83 feet
scribed C 1/4 B.T.

T37N R14E
C 1/4 S 25
S1537-1981

Dated at Rhinelander, Wis., this 3rd day of August, 1981

Signature *Daniel K. Pleoger* Title Registered Land Surveyor Registration No. 1537
(County Surveyor, Registered Land Surveyor, or other duly authorized official)

Office of Register of Deeds, County of Forest, I hereby certify that the within instrument was filed in this office for record on the 19th day of January, 1982 at 3:00 o'clock P. M.

Eugene Staszny
(Register of Deeds)
By _____ Deputy

DOCUMENT NO. **121090**

H371425202D