

CERTIFIED LAND CORNER RESTORATION


Index No. S-25

**S25**


State of Wisconsin }  
County of Forest } ss.

I, Daniel K. Plegger, do hereby certify that on the 14th day of April, 1981, I ~~found~~ established N 1/16 corner of sections 25 & 30 Township 37, North, Range 14 & 15 East, Fourth Principal Meridian, as described hereon; and that from this evidence I established a new monument and accessories as described hereon to perpetuate the original location of this corner.

Resident witnesses:

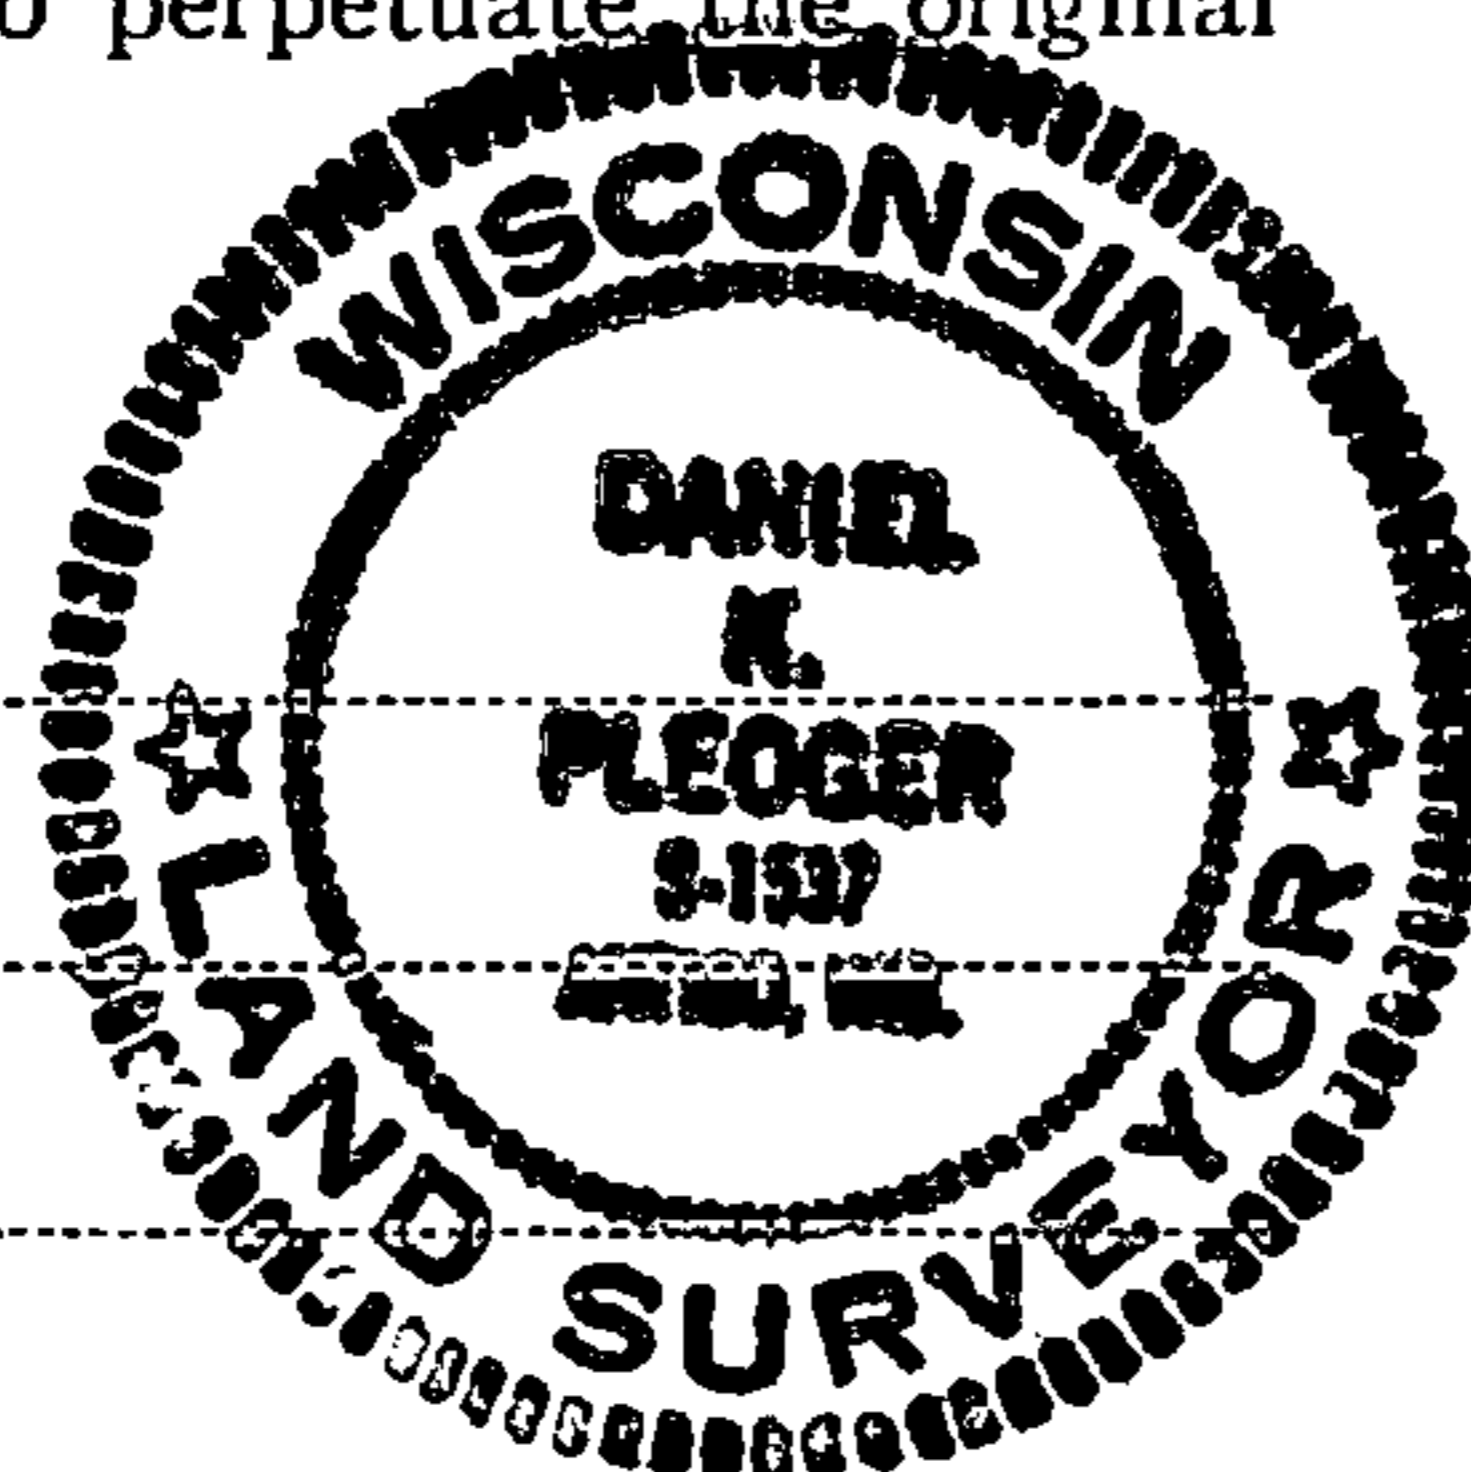

FORM 985 N. C. MILLER CO., MILWAUKEE

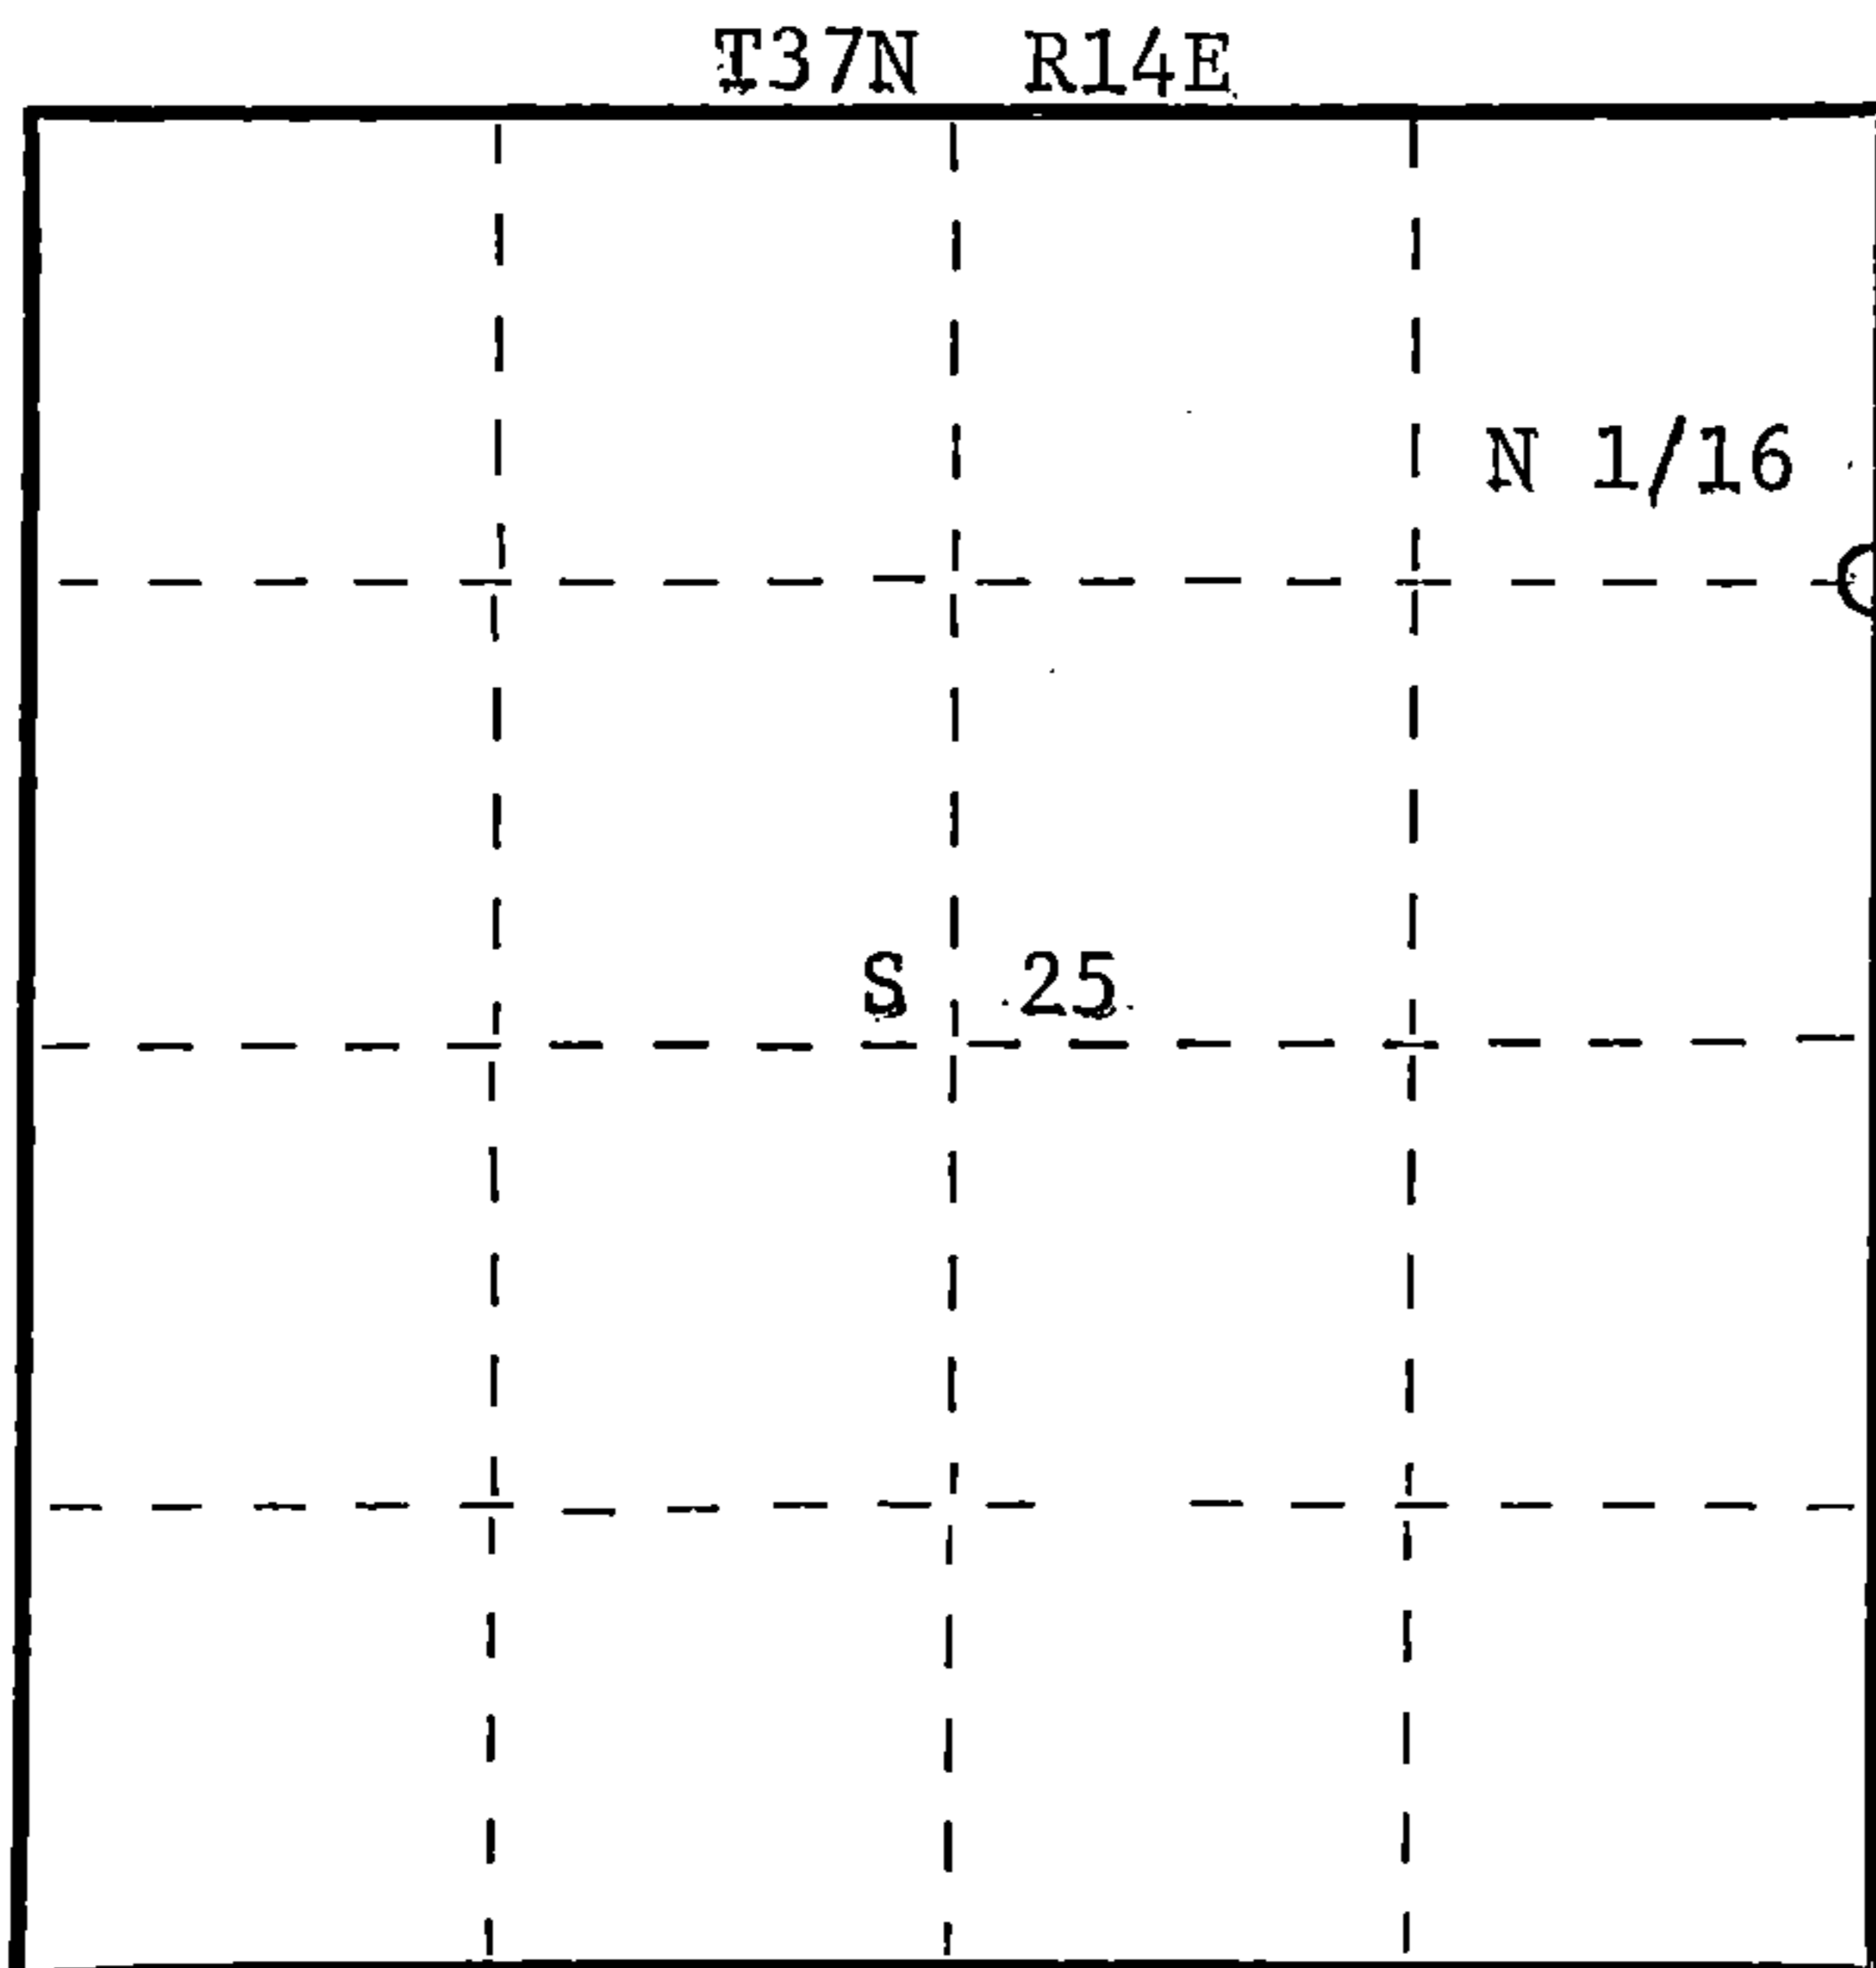

○ = Corner monument restored.

History of original corner establishment:

No evidence of any previous corner.

Description of corner evidence found:

Total distance from section corner 24-25-19-30 T37N-R14&15E to 1/4 corner between sections 25 & 30 is 2621.368 feet at bearing S0-18-25E.

Set N 1/16 1310.684 feet intermediate.

Description of monument and accessories I established to perpetuate the original location of this corner.

Set a 1-1/2" iron pipe with 2" diameter brass cap stamped:  
Projecting 24" above ground.

Marked NBT's:

Black Spruce 7" N6°W 23.71 feet  
Black Spruce 8" S70°E 36.72 feet  
scribed 1/16 BT

R14E R15E  
N 1/16 25+30  
T37N  
S1537-1981

Dated at Rhineland, Wis., this 24th day of June, 1981.

Signature Daniel K. Plegger Title Registered Land Surveyor Registration No. 1537  
(County Surveyor, Registered Land Surveyor, or other duly authorized official)

Office of Register of Deeds, County of Forest, I hereby certify that the within instrument was filed in this office for record on the 1st day of July, 1981 at 8:30 o'clock A. M.

Eugene Stutzman  
(Register of Deeds)

By \_\_\_\_\_ Deputy

DOCUMENT NO.  
**120038**

43714253000