

CERTIFIED LAND CORNER RESTORATION

Index No. **V 5**


State of Wisconsin }
County of Forest } ss.

I, Philip T. Hansen, do hereby certify that on the 11th day of December, 1975, I found evidence of the Section corner of Sec. 29, 30, 31, and 32 Township 37, North, Range 14 East, Fourth Principal Meridian, as described hereon; and that from this evidence I established a new monument and accessories as described hereon to perpetuate the original location of this corner.


Resident witnesses:

Glen Barker

Jim Claflin

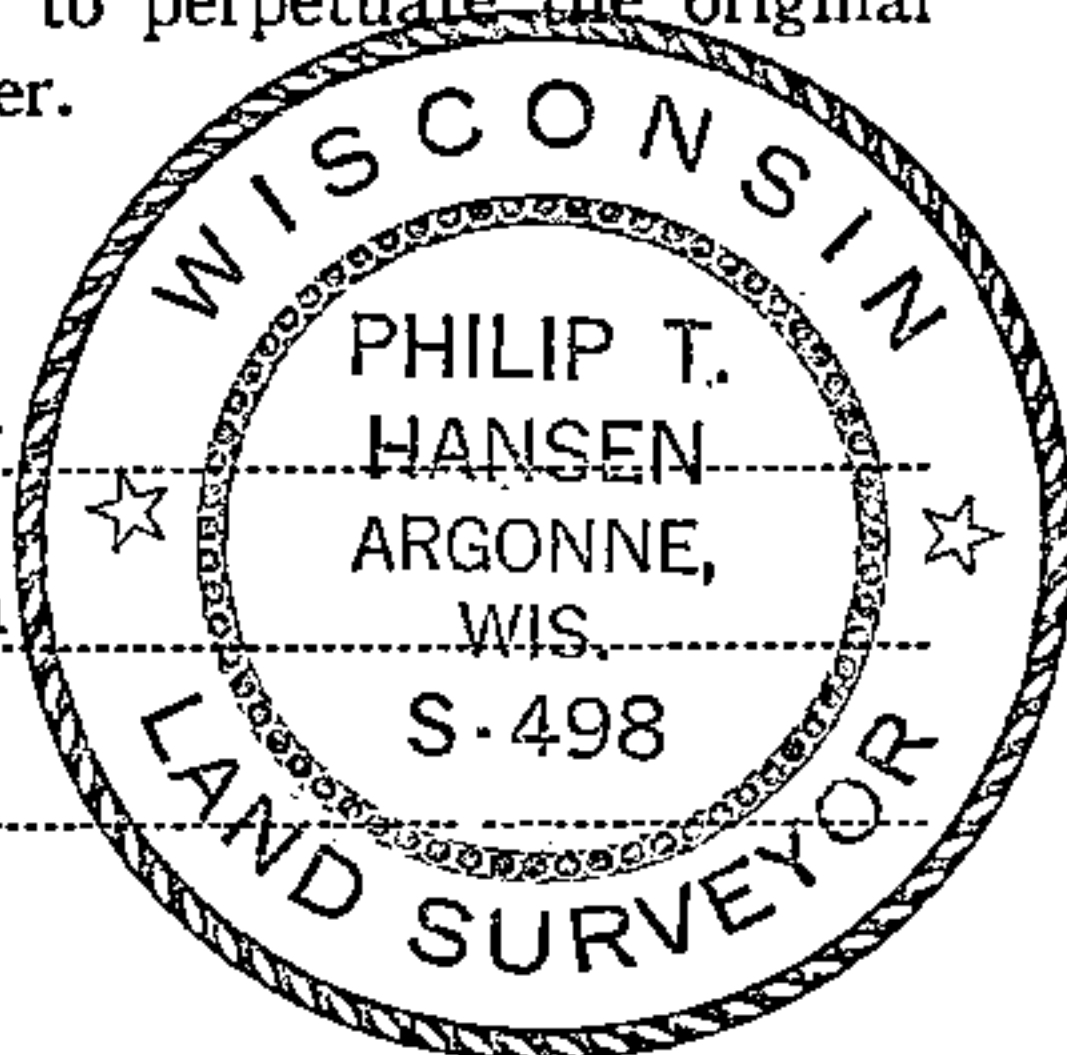

FORM 985 K. C. MILLER CO., MILWAUKEE

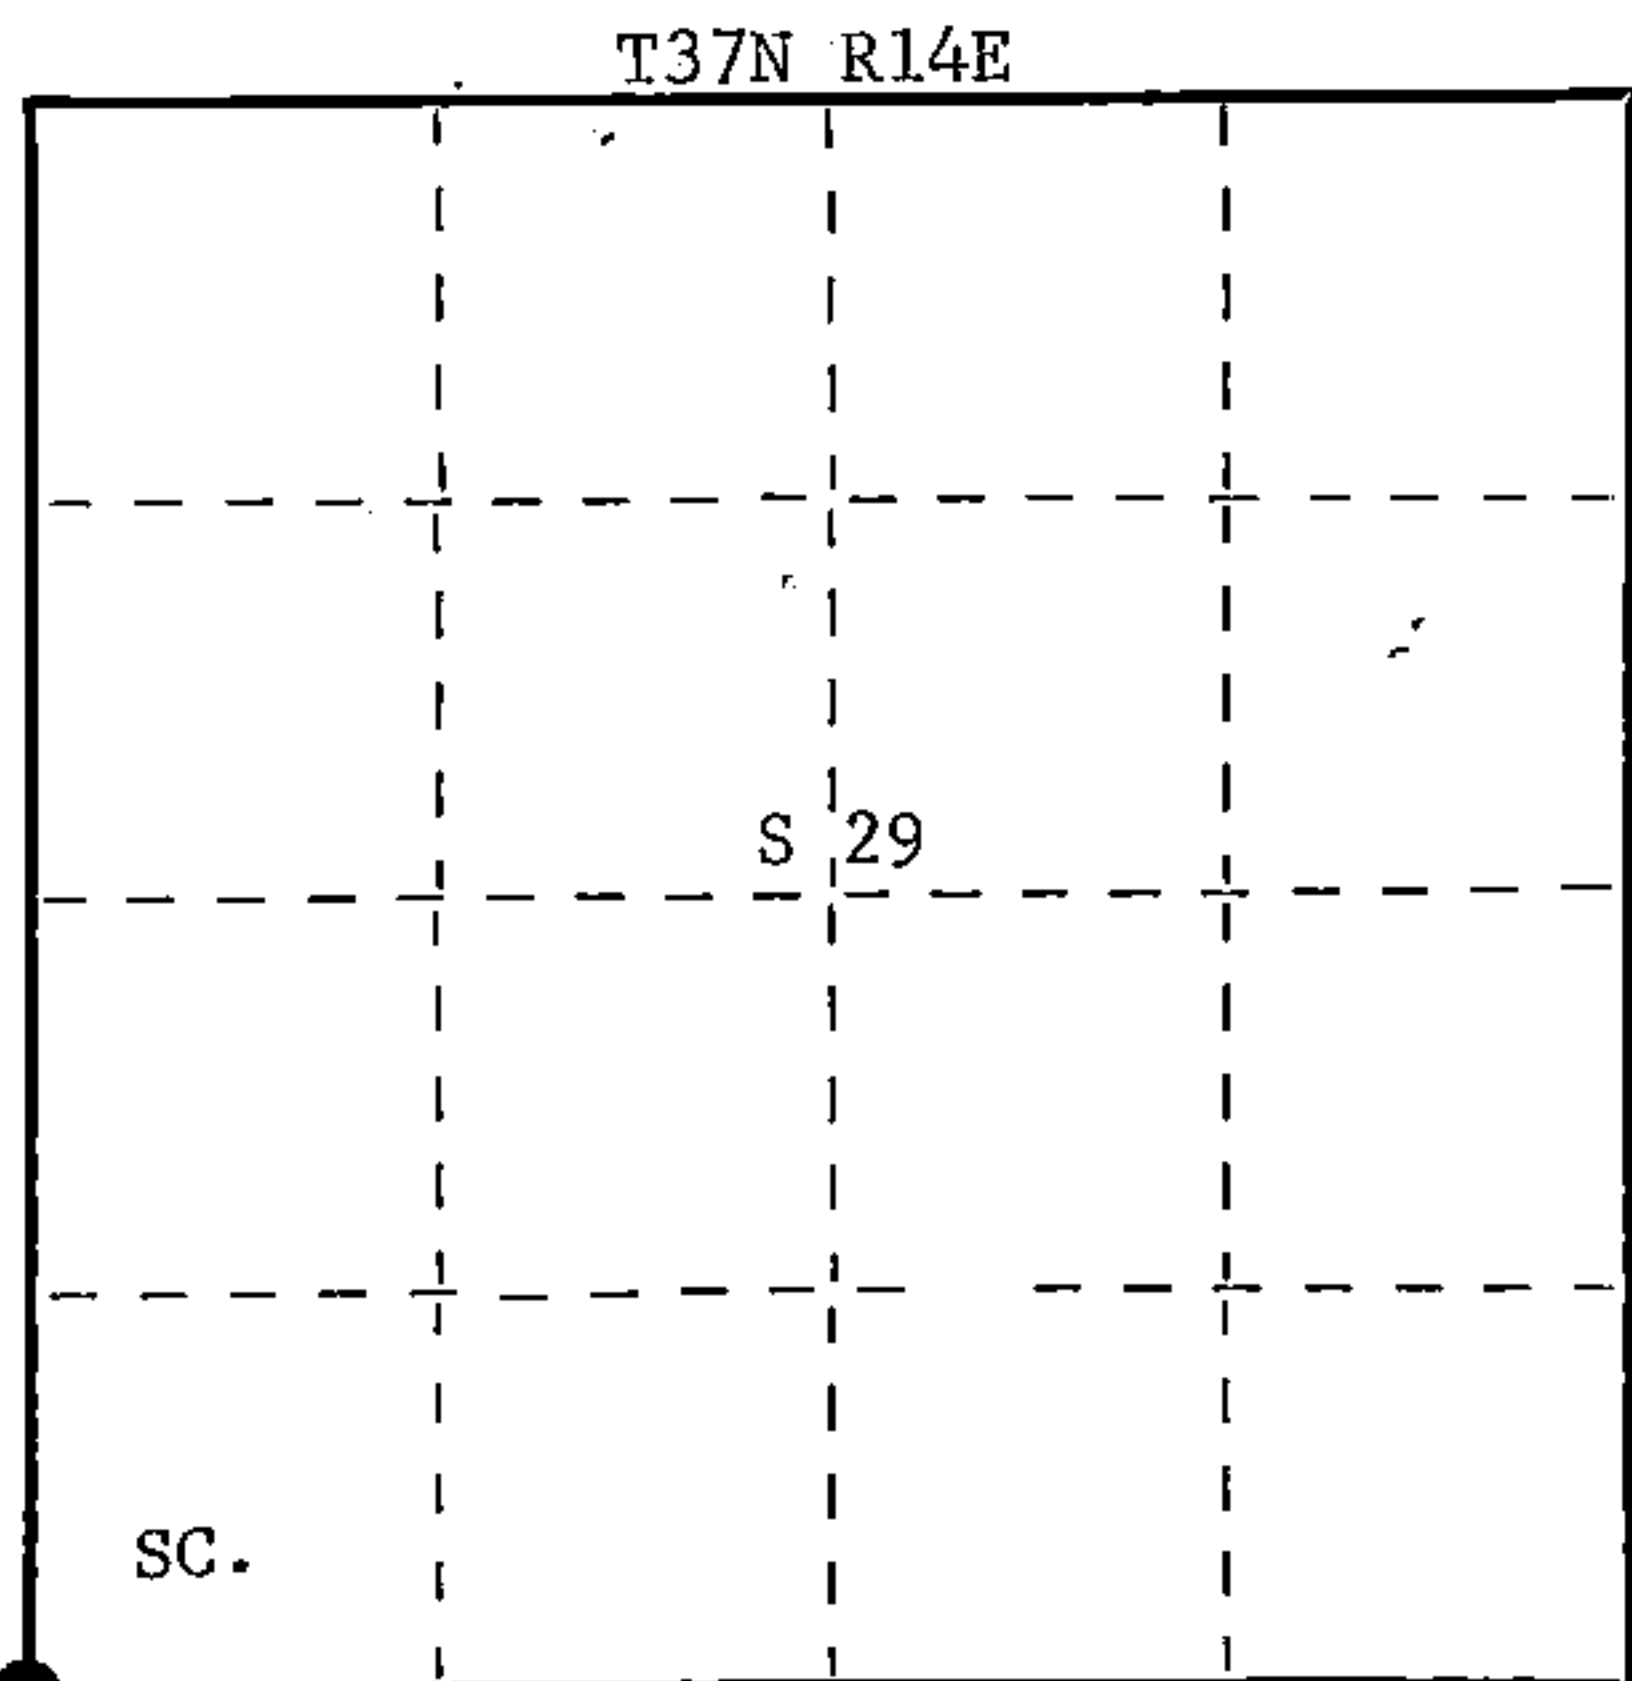

○ = Corner monument restored.

History of original corner establishment: Original corner established by J.L. Nowlin, Deputy Surveyor, in 1858, from which sugar 20" bears N5°W 8" lks. and sugar 8" bears S25°E 30 lks.

This corner recovered by E.B. Hurst and P. Hansen in 1932. A squared wooden post was offset 33 feet north of corner on a bank on the north side of highway G. This was later referenced with a white post with location tag by Ray Leigh, Consolidated Forester. During the reconstruction of highway G, the highway engineers set a 1-1/2" iron pipe with white post and location tag at a point 100 feet north of the true corner. This is in line with and north of the P.I. of curve in highway.

Description of corner evidence found: Recovered a 1-1/2" iron pipe projecting 8", and white post with location tag stating true corner is 100 feet south. This white post, witness pipe, and true corner are in line with P.I. hub of curve in highway G.

For more information on this see Division of Highways Right of Way plat, CTH"G", Forest County, project No. 9333-5-31.

Description of monument and accessories I established to perpetuate the original location of this corner. Measured 100 feet south from witness corner and set a 1-1/2" x 18' iron pipe flush with the ground for the true corner. This point is on the north shoulder of county trunk highway G. Set a 2-1/2" Berntsen A-1 Federal Monument for witness corner, 55 lks. north from true corner on line with the white post, iron pipe, and P.I. of curve. Cap stamped - Projecting 12" above ground.

S498
T37N R14E
Sec. S30 | S29
S31 | S32 W.C.
S 55 lks.
1975

NBT's - Sugar 5" N14°W 106 lks. scribed SC BT.
Sugar 7" N33°E 140.5 lks. scribed SC BT.

Measurements and bearings from true corner. Witness corner and NBT's painted blue.

Dated at Argonne, Wis., this 15th day of December, 1975.

Signature *Philip T. Hansen* Title Reg. Land Surveyor Registration No. S-498
(County Surveyor, Registered Land Surveyor, or other duly authorized official)

Office of Register of Deeds, County of Forest, I hereby certify that the within instrument was filed in this office for record on the 23rd day of December, 1975 at 2:30 o'clock P. M.

Eugene Stutzman
(Register of Deeds)
By Deputy

DOCUMENT NUMBER - 108436

00000214124