

**CERTIFIED LAND CORNER RESTORATION
U.S. Public Land Survey Monument Record**

Index No. x-5

State of Wisconsin }
County of Forest } ss.

I Glen Barker, do hereby certify that on the 21st day of December, 1988, I ~~found~~ ~~evidence of the~~ established the 1/4 corner of Section 31 & 31 Township 37, North, Range 14 East, Fourth Principal Meridian, as described hereon; and that from this evidence I established a new monument and accessories as described hereon to perpetuate the original location of this corner.

Resident witnesses:

N. Spiess

D. Broadbridge

History of original corner establishment:

Original corner established in 1865 by James L. Nowlin, government deputy surveyor, from which Ironwood 7" bears N42W 50 links and Sugar 7" S12W 30 links.

Description of corner evidence found:

Set 1/4 corner on proportionate method.
Total distance from SW Section corner to NW Section corner of Section 32 is 5508.06'. Set 1/4 corner 2754.03' intermediate.


Description of monument and accessories I established to perpetuate the original location of this corner.

Set a 2 1/4" Forest County aluminum monument with 3 1/4" alloy cap stamped: Monument projects 5" above ground.

Marked NBT:

Sugar 8" S76W 24.82'
Sugar 8" S45E 23.58'
Sugar 10" N50E 25.81'
Sugar 10" N3E 42.12'

T37N R14E
1/4 S31 | S32
|
S1682
1988
Forest County

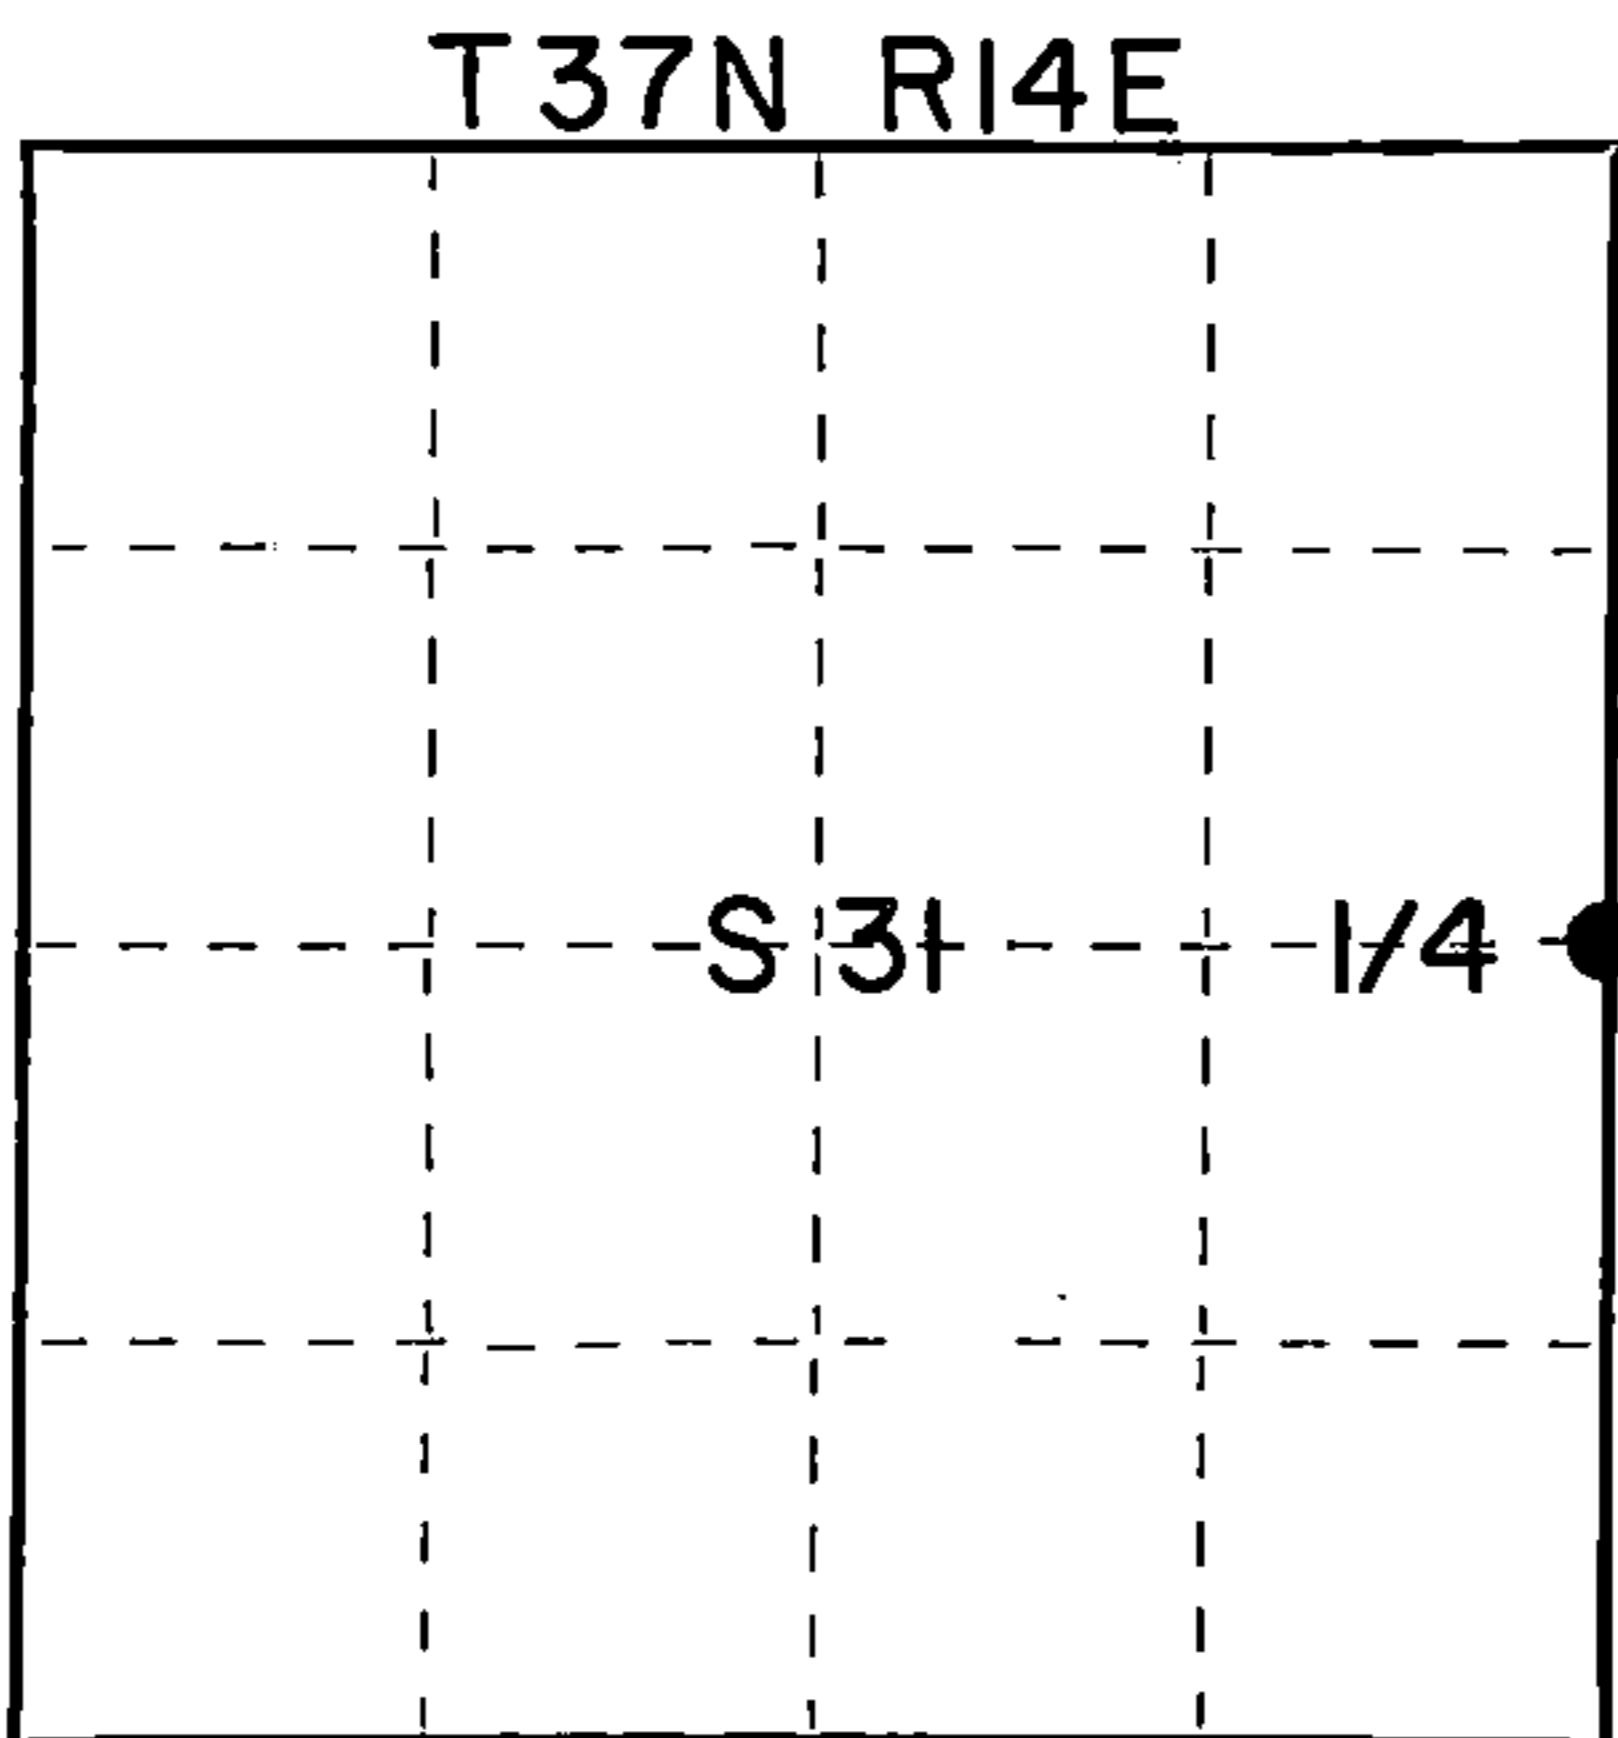

○ = Corner monument restored.

Dated at Rhineland, Wis., this 14th day of March, 1989.

Signature Glen Barker Title Registered Land Surveyor Registration No. 1682
(County Surveyor, Registered Land Surveyor, or other duly authorized official)

Office of Register of Deeds, County of Forest, I hereby certify that the within instrument was filed in this office for record on the 31st day of March, 1989 at 10:25 o'clock A. M.

Paul Achenbrenner
(Register of Deeds)

By _____ Deputy

DOCUMENT NUMBER
137133

FORM 985 H. C. MILLER CO., MILWAUKEE

437114312000

