

CERTIFIED LAND CORNER RESTORATION

Index No. X 9


State of Wisconsin }  
County of Forest } ss.

I Philip T. Hansen, do hereby certify that on the 24th day of September, 1975, I found evidence of the Quarter corner of Sections 32 and 33 Township 37, North, Range 14 East, Fourth Principal Meridian, as described hereon; and that from this evidence I established a new monument and accessories as described hereon to perpetuate the original location of this corner.


Resident witnesses:

Glen Barker

Jim Claflin

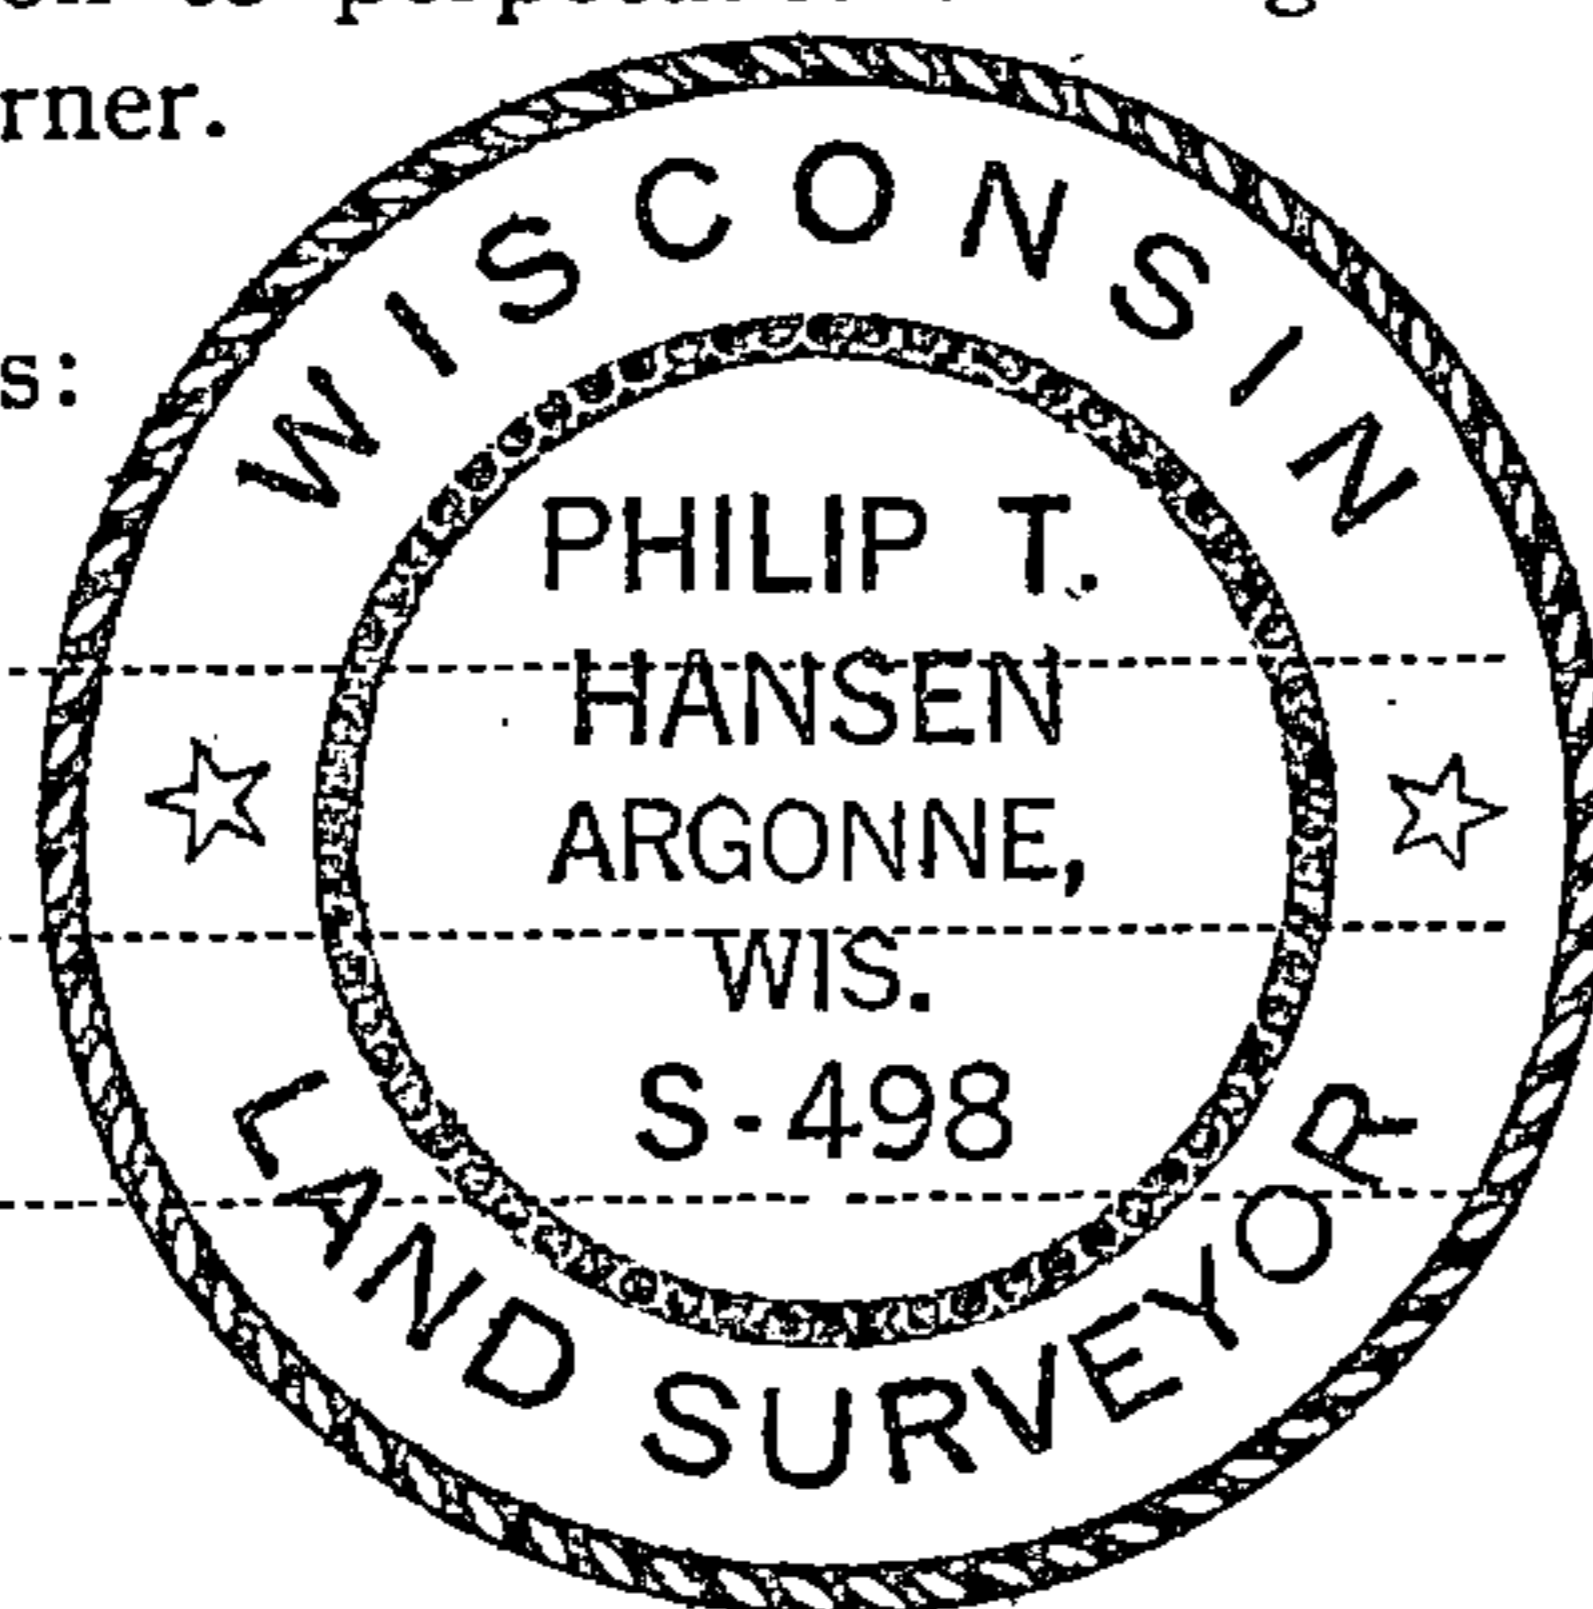

T37N, R14E

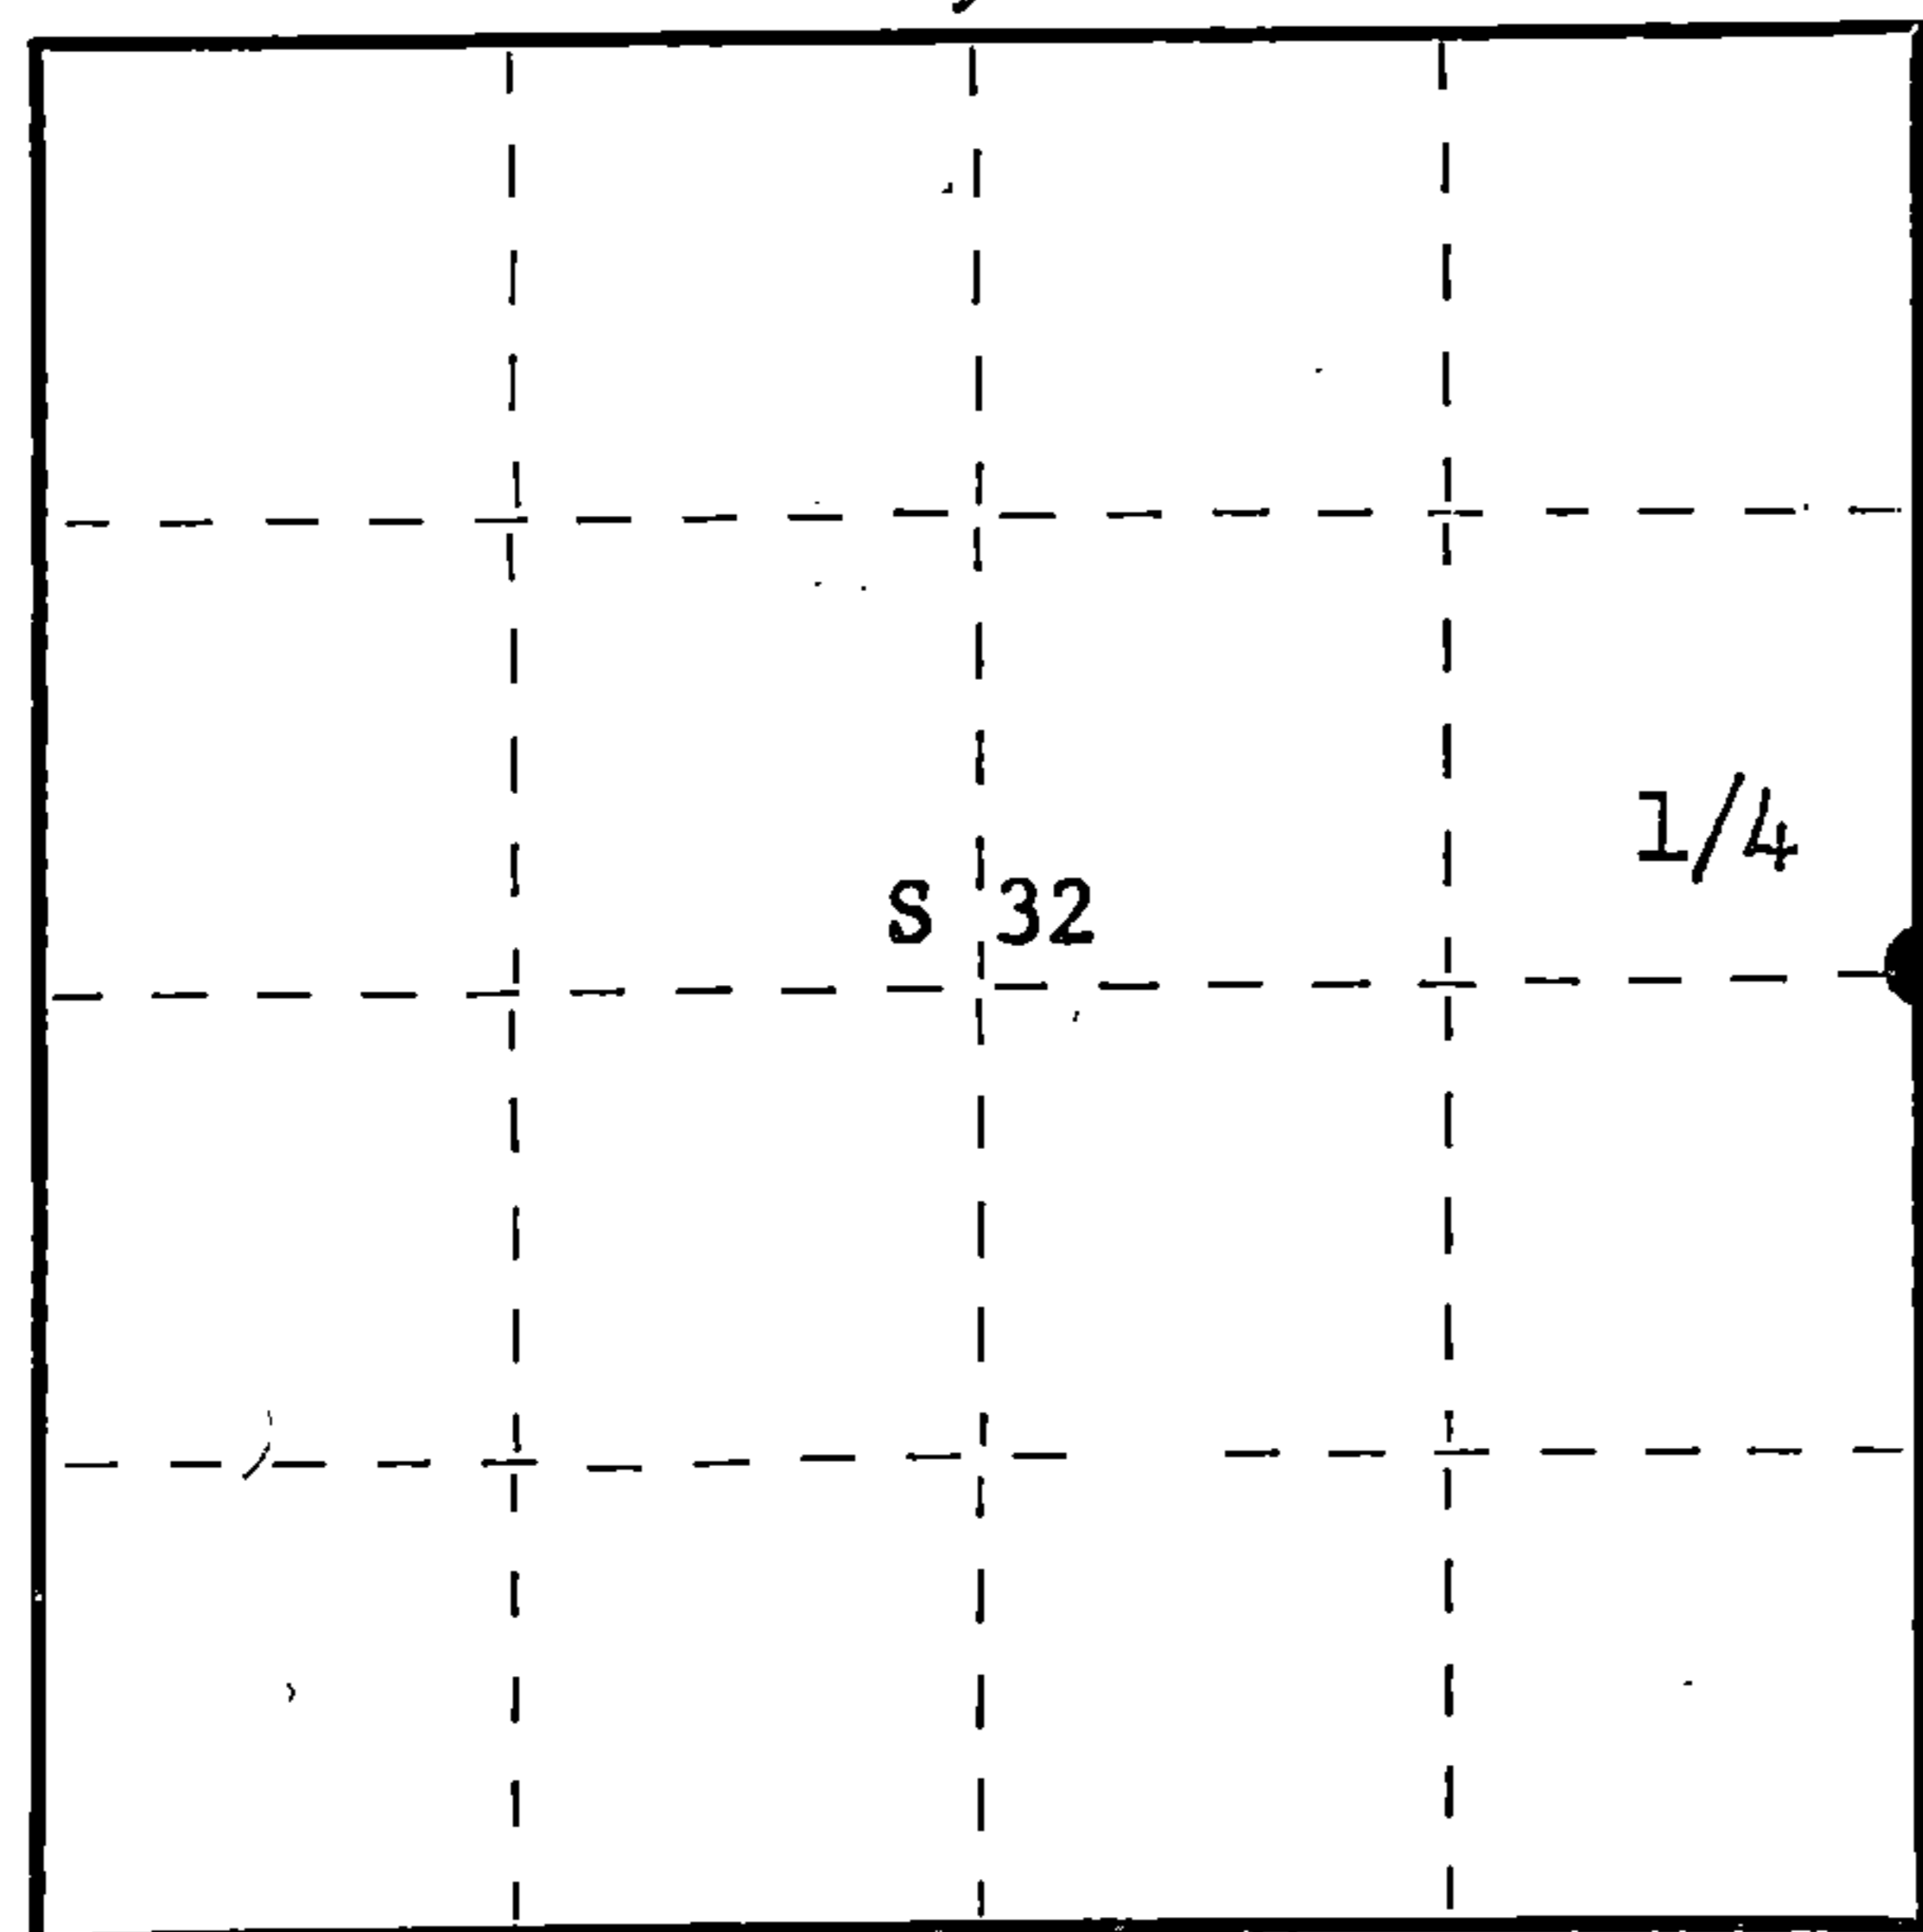

○ = Corner monument restored.

History of original corner establishment:

Original corner established by James L. Nowlin, Gov't Deputy Surveyor, in 1865 from which birch 8", N15°W, 20 lks., and cedar 6", S23E, 30 lks. Corner recovered and restored by J.R. Ritter, County Surveyor, in 1921. Set new post and established NBT from which birch 5" bears S30°W, 13 lks., and cedar 6" bears S80°E, 35 lks.

Road constructed on line about 1928. Corner recovered and reset post which was at end of cutout R.O.W. Post recovered by Ray Leigh, Consolidated Forester, about 1950. Found Ritter's post lying down, badly decayed. Placed 1-1/2" iron pipe in place of post.

Description of corner evidence found:

Recovered 1-1/2" iron pipe set at south end of old cleared R.O.W. No evidence of Ritter's old post visible.

Recovered OBT's Birch 5", S30°W, 13 lks., now a decayed stump. Scribing is visible.  
Cedar 6", S80°E, 35 lks., now blown down.

Description of monument and accessories I established to perpetuate the original location of this corner.

Replaced 1-1/2" iron pipe with 2-1/2" Berntsen A-1 Federal Monument, aluminum post with magnet installed in cap and base. Post projects 6" above ground. Cap stamped -

NBT's Cedar 10", S17°E, 54.2 lks., scribed 1/4 BT.  
Cedar 10", N42°E, 60 lks., scribed 1/4 BT.

Post and NBT's painted blue.

S498  
T37N, R14E

S32 | S33

1975

Dated at Argonne, Wis., this 29th day of September, 1975.

Signature Philip T. Hansen Title Reg. Land Surveyor Registration No. S-498  
(County Surveyor, Registered Land Surveyor, or other duly authorized official)

Office of Register of Deeds, County of Forest, I hereby certify that the within instrument was filed in this office for record on the 10th day of October, 1975 at 10:30 o'clock A. M.

Eugene Stalony  
(Register of Deeds)

By..... Deputy

DOCUMENT NUMBER -- **107955**

FORM 985 H. C. MILLER CO., MILWAUKEE

43714322000