

CERTIFIED LAND CORNER RESTORATION

State of Wisconsin }
County of Forest } ss.

I Philip T. Hansen, do hereby certify that on the 25 day of September 19 75, I found evidence of the Section corner corner of S 33-34 3-4 Township 37 and 36 North Range 14 East, Fourth Principal Meridian, as described hereon; and that from this evidence I established a new monument and accessories as described hereon to perpetuate the original location of this corner:

Description of original monument and accessories and subsequent restorations: Original corner established by Alfred Millard, Gov. Deputy Surveyor in 1858, from which Tamarack 7" bears N45°W 65 lks Tamarack 8" bears N35° E 55 lks, Tamarack 6" bears S20° E 18 lks and Tamarack 7" bears S60° W 121 lks.

Corner recovered and restored by J.R. Ritter, County Surveyor in 1921. Set new post and established NBTs - Spruce 4" S85°W 10 lks and Spruce 3" East 11 lks

Corner recovered by Ray Leigh, Consolidated Papers Inc. Forester. Set new post beside Ritter's post. No record of.

Description of corner evidence found: Recovered 2 3" squared Spruce post, both in poor condition. No trace of BTs recovered


Description of monument and accessories I established to perpetuate the location of this corner:

Replaced older of two Spruce posts with 2 1/2" x 30" Berntsen A-1 Federal Monument aluminum pipe with magnet install in cap and base. Cap stamped.

Pipe and NBTs painted blue

S498
T 37 N R 14 E
33 | 34
Sec 4 | 3
T 36 N R 14 E
1975

T 37 N R 14 E

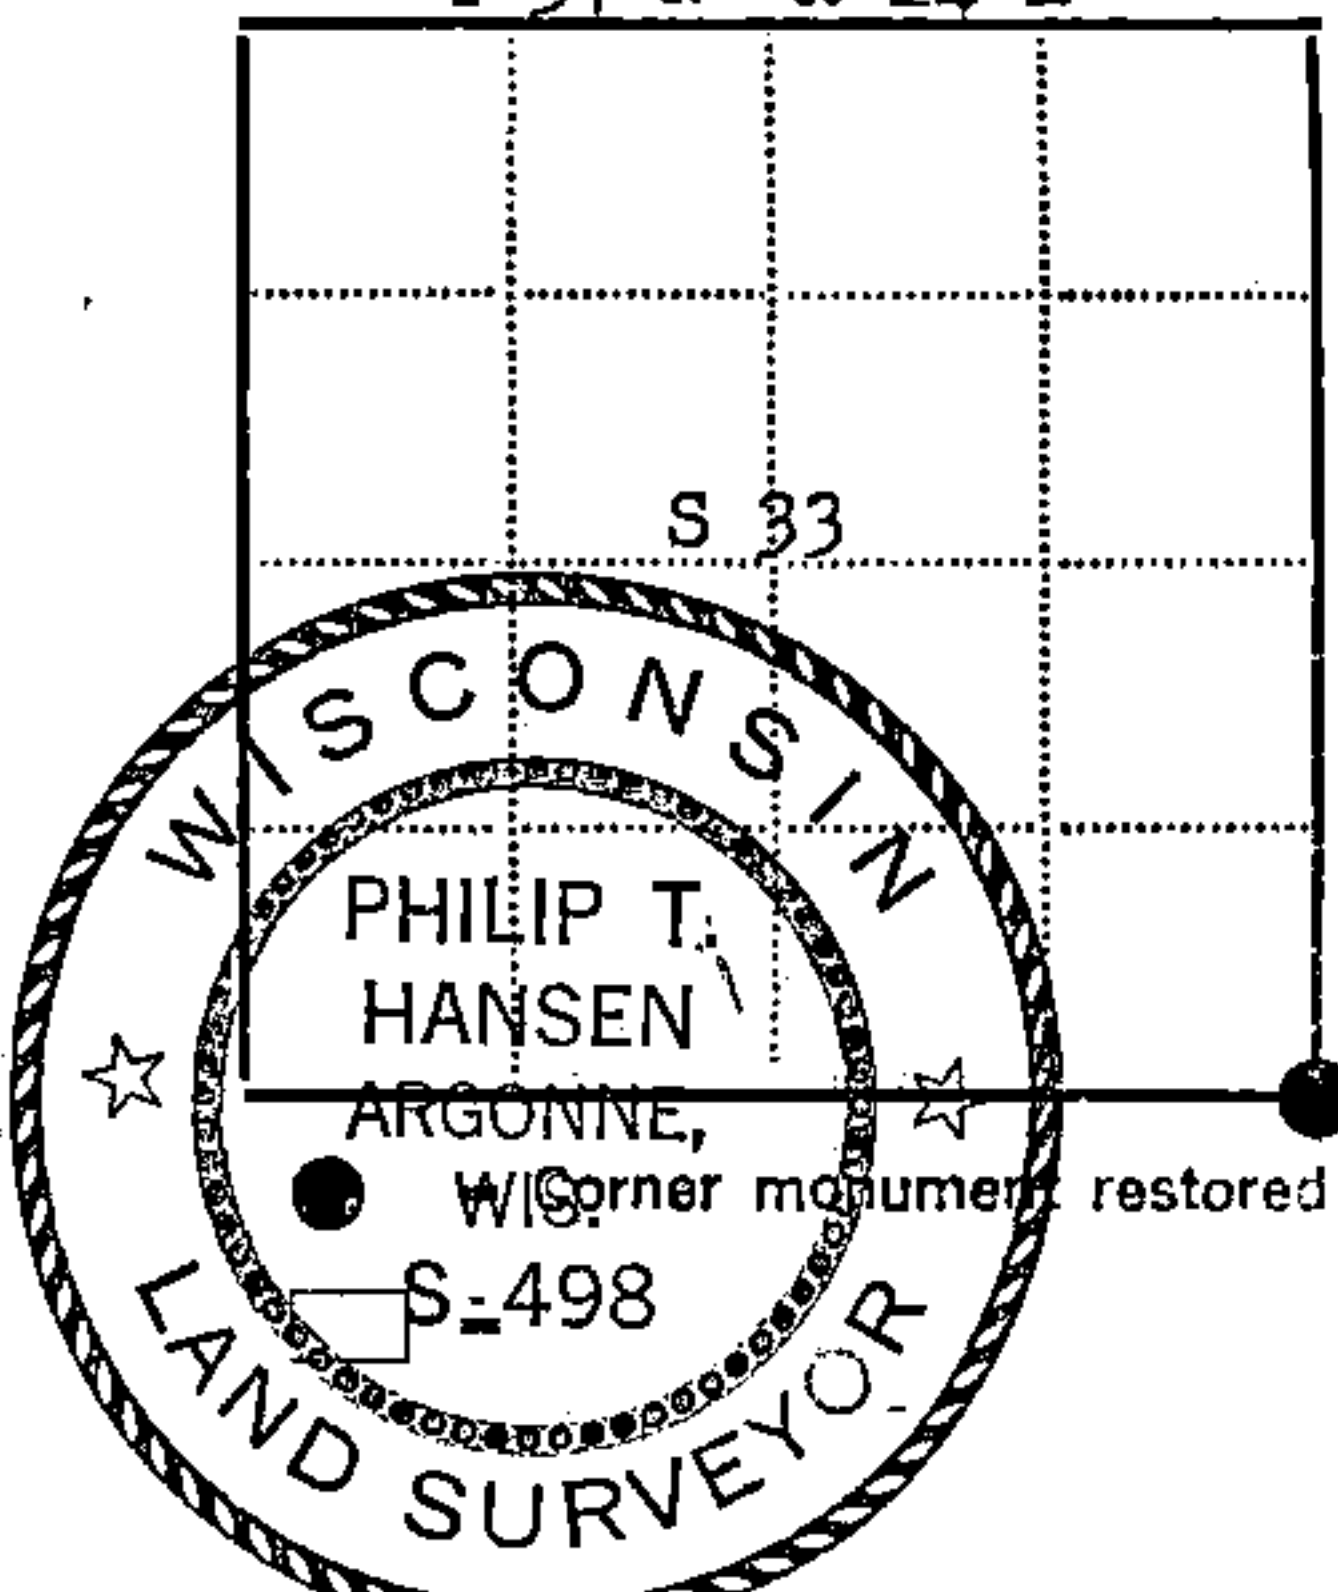

Resident witnesses Glen Barker and Jim Claflin

Dated at Argonne Wisconsin, this 29 day of September 19 75.

Signature Philip T. Hansen Title Reg. Land Surveyor
(County Surveyor, Registered Land Surveyor, or other duly authorized official)

Surveyors Registration No. S-498 DOCUMENT NUMBER -- 107924

Office of Register of Deeds County of Forest

I hereby certify that the within instrument was filed in this office for record on the 6th day of October 19 75, and was filed in Book No. Page No. of County Records.

Signature Eugene Staszewski Title Register of Deeds

Township 37 North, Range 14 East, Section 33, Under No., Page No.