

CERTIFIED LAND CORNER RESTORATION

X-13 Index No. **X13**



State of Wisconsin }
County of Forest } ss.

I Philip T. Hansen, do hereby
certify that on the 19th day
of September, 1975, I found
evidence of the Quarter
corner of Sections 33-34
Township 37 North, Range
14 East, Fourth Principal Meridian,
as described hereon; and that from this evidence
I established a new monument and accessories
as described hereon to perpetuate the original
location of this corner.

Resident witnesses:

Glen Barker

Jim Claflin

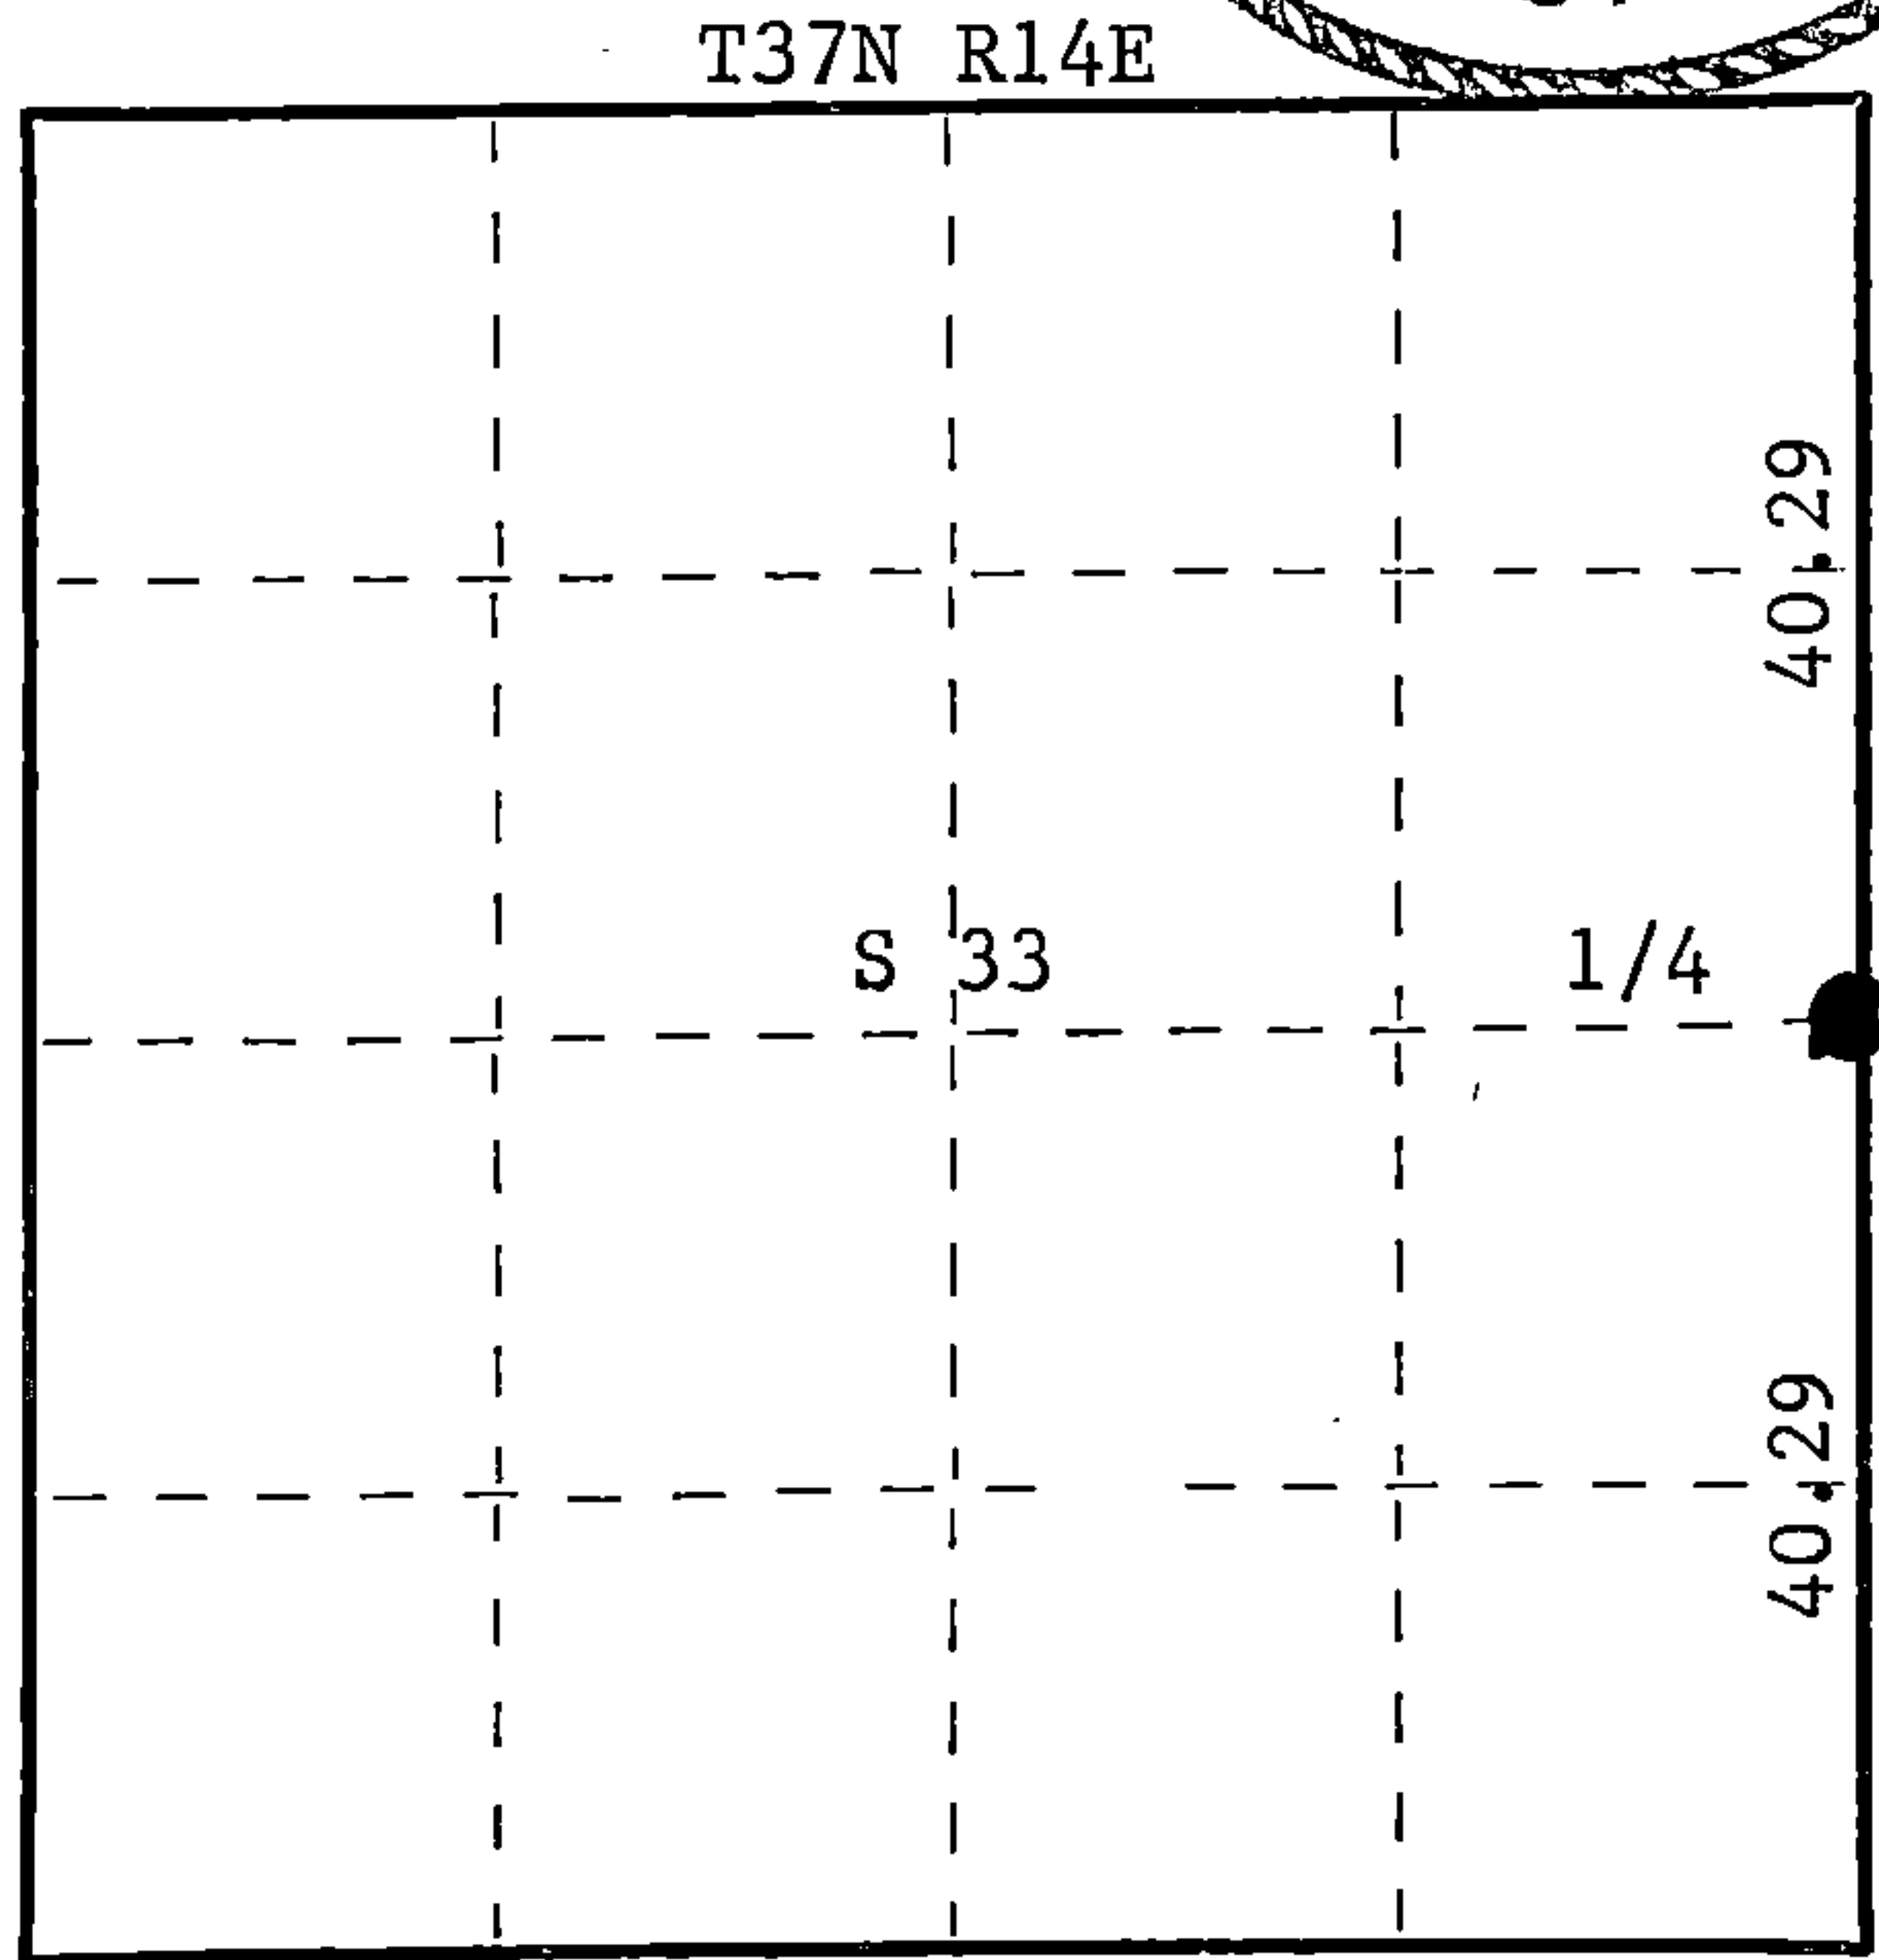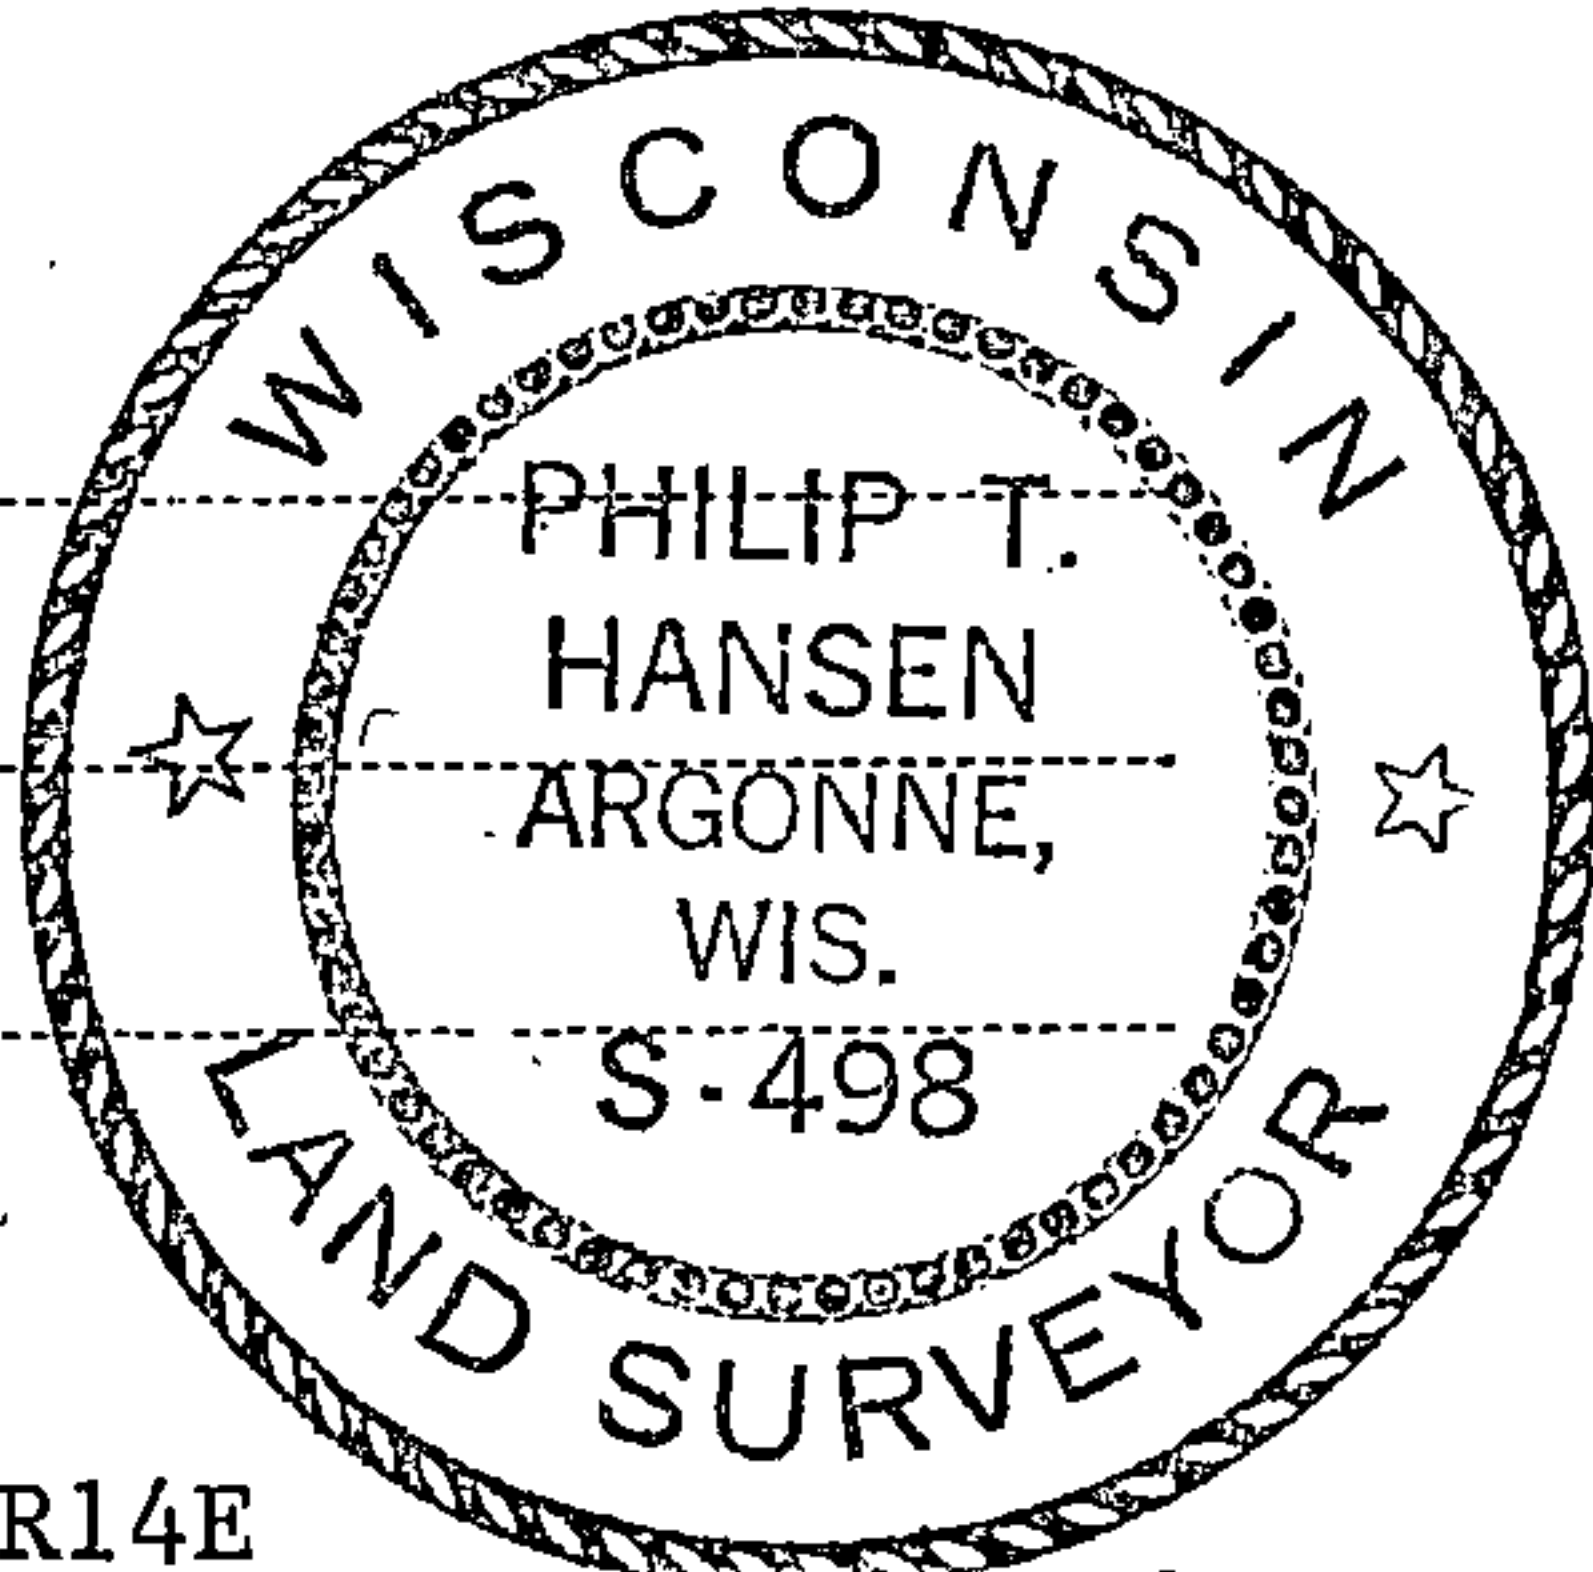

○ = Corner monument restored.

History of original corner establishment: Original corner established by James L. Nowlin, Government Deputy Surveyor, in 1865, from which hemlock 10" bears N12°W 75 links and white birch 8" bears S32°E 150 links.

Corner recovered and restored by J.R. Ritter, County Surveyor, in 1921. Set new post and marked NBT's - hemlock 5" S35°E 24½ links and tamarack N4°E 4½ links.

Description of corner evidence found:

Recovered 4" cedar post, squared and scribed 1/4 S S33, 1/4 S S34 in fair condition. Also a 1-3/4" iron pipe set beside the post.

Recovered OBT hemlock 5" S35°E 24.5 links, scribed 1/4 S BT; now a cut-off stump.

Description of monument and accessories I established to perpetuate the original location of this corner.

Replaced 4" cedar post with 2½" x 30" Berntsen A-1 Federal Monument, aluminum pipe with magnet installed in cap and base. Post projects above ground 6". Cap stamped -

NBT's - Tamarack 7" S6°W 54.5 links scribed 1/4 BT.
Pine 7" N56°E 88.2 links scribed 1/4 BT.

S498
T37N R14E

1/4 S33 S34
1975

Dated at Argonne, Wis., this 24th day of September, 1975.

Signature *Philip T. Hansen* Title Registered Land Surveyor Registration No. S-498
(County Surveyor, Registered Land Surveyor, or other duly authorized official)

Office of Register of Deeds, County of Forest, I hereby certify that the within instrument was filed in this office for record on the 30th day of September, 1975 at 3:15 o'clock P. M.

Eugene Staszny
(Register of Deeds)

By Deputy

DOCUMENT NUMBER 107878

FORM 985 H. C. MILLER CO., MILWAUKEE

43714332000