

CERTIFIED LAND CORNER RESTORATION

W-12 Index No. **W12**


State of Wisconsin }
County of Forest } ss.

I, Philip T. Hansen, do hereby certify that on the 3rd day of October, 1975, I found evidence of the NE-1/16 corner of Section 33 Township 37 North, Range 14 East, Fourth Principal Meridian, as described hereon; and that from this evidence I established a new monument and accessories as described hereon to perpetuate the original location of this corner.


Resident witnesses:

Glen Barker

Jim Claflin

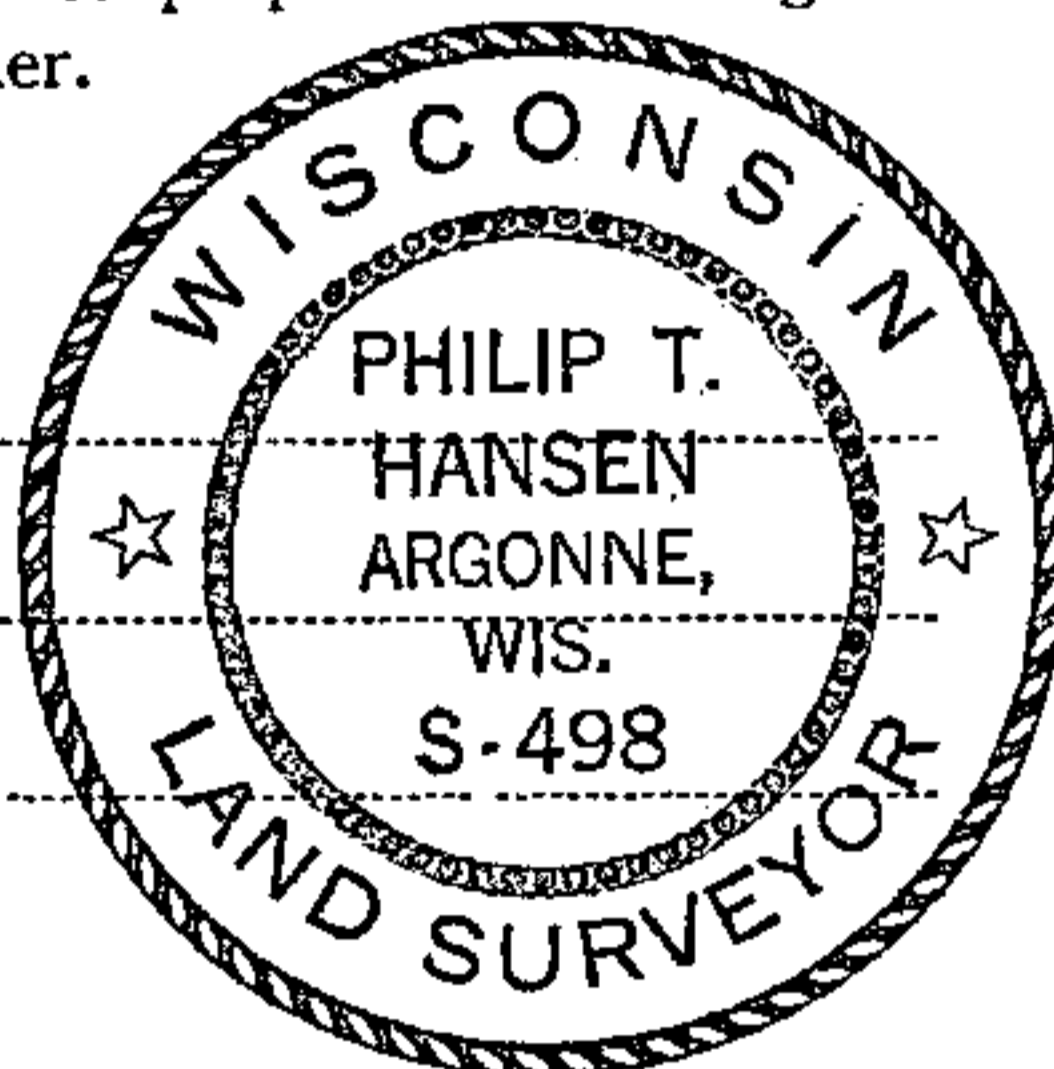

T37N R14E

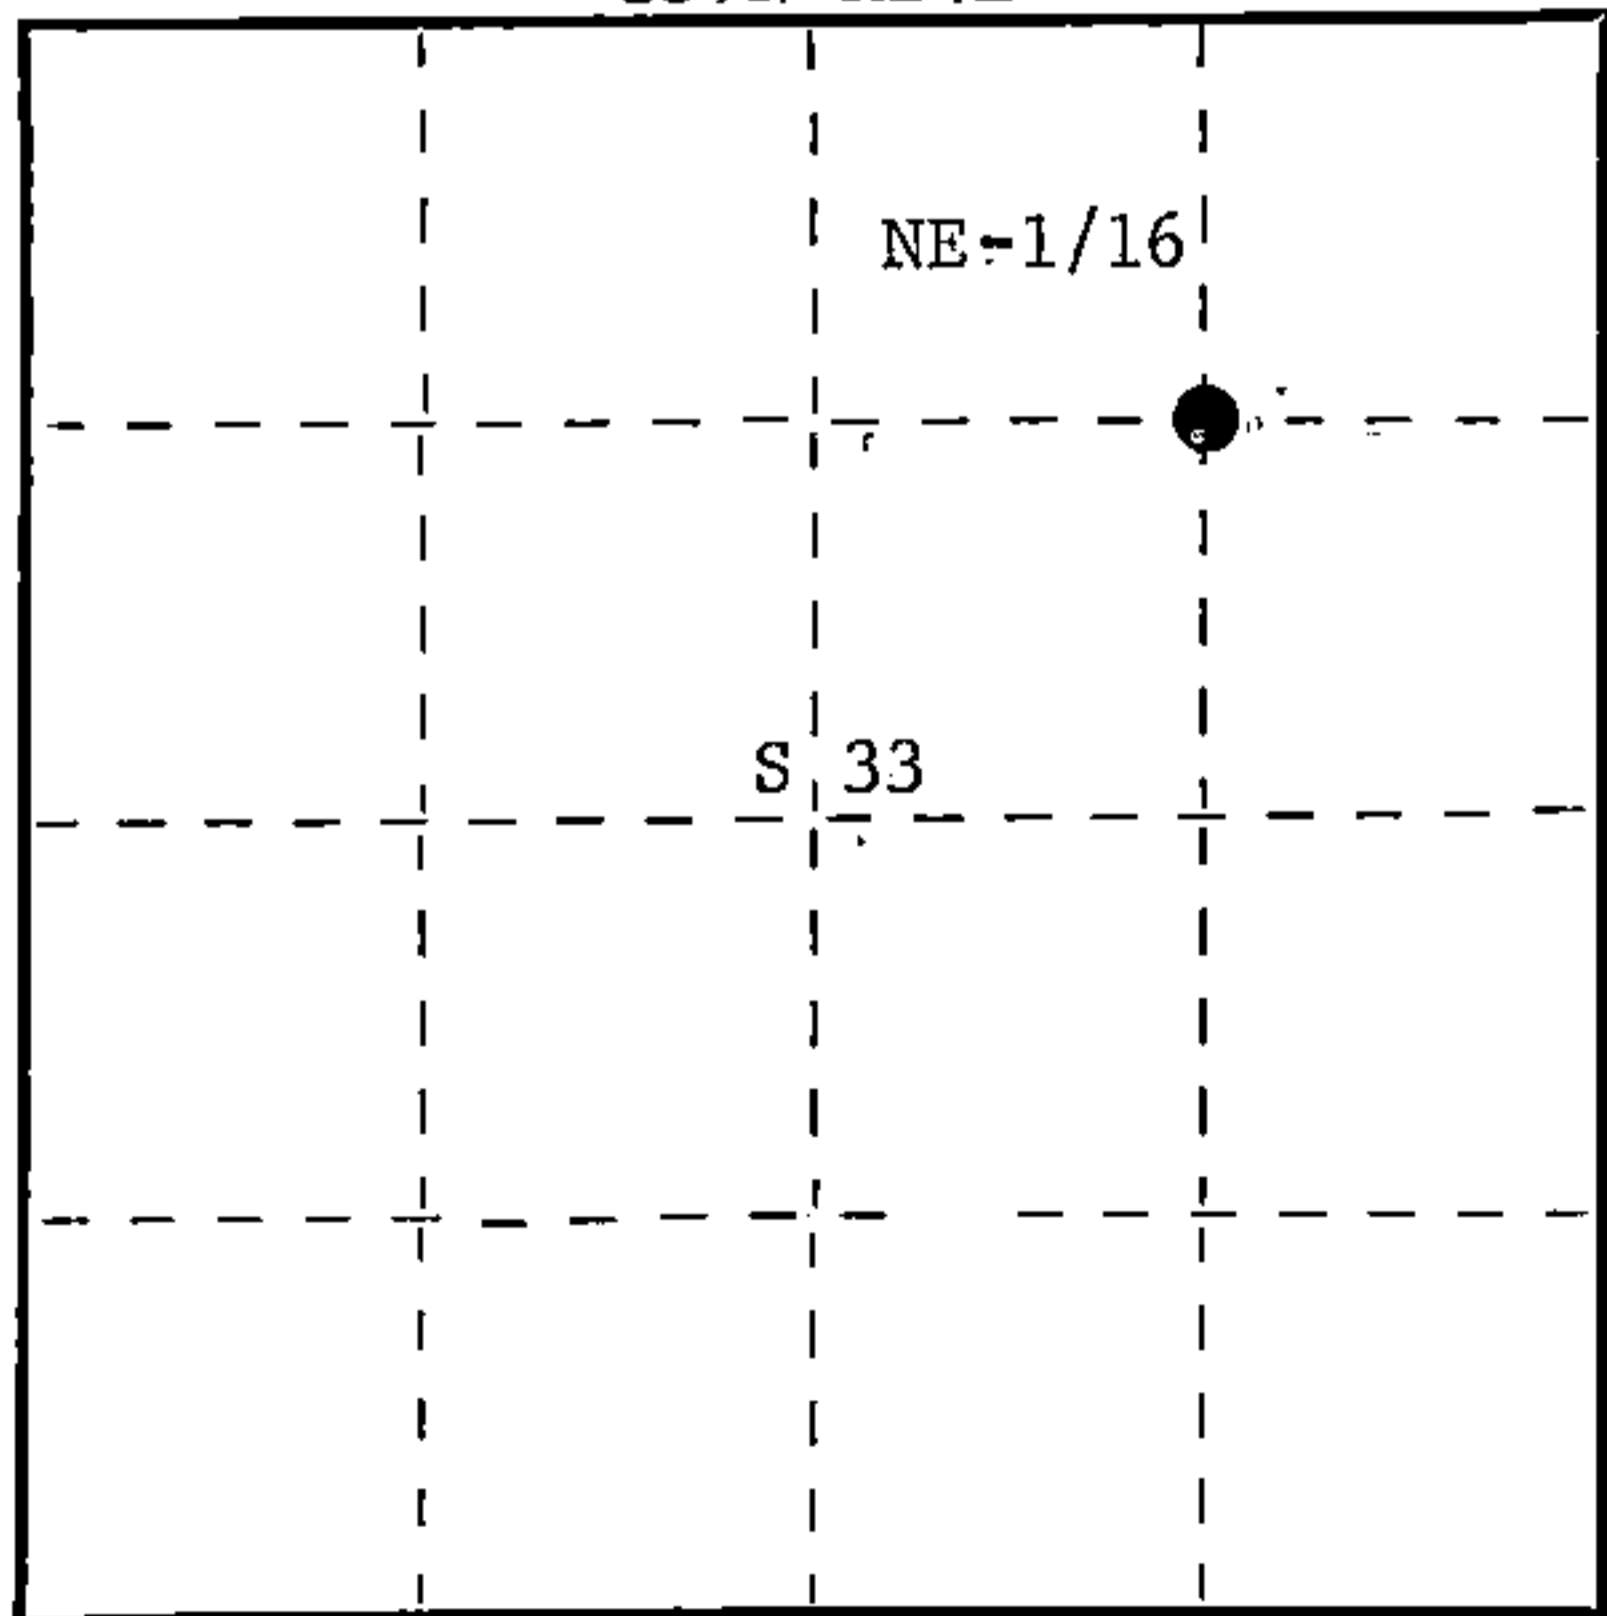

○ = Corner monument restored.

History of original corner establishment: Corner established by I.R. Ritter, County Surveyor, in 1921. Set squared and scribed wood post and marked BT's - Spruce 4" S70°E 13 links, and Spruce 5" N8°W 15 links. Corner has been perpetuated by P.T. Hansen, Registered Land Surveyor, since 1955.

Description of corner evidence found: Recovered 3" squared cedar post in fair condition. No BT's were recovered, these having been destroyed by road construction on County Trunk "G."

Description of monument and accessories I established to perpetuate the original location of this corner. Replaced wooden stake with 1 1/2" O.D. x 5' iron pipe with 2" brass cap stamped -

NBT's - Tamarack 7" N42°E 67.7 links, scribed 1/16 BT.
B. Spruce 6" N3°E 58.6 links, scribed 1/16 BT.

Iron pipe and BT's painted blue.

S498
T37N R14E
NE-1/16
S 33
CPI-1975

Dated at Argonne, Wis., this 9th day of October, 1975.

Signature *Philip T. Hansen* Title Registered Land Surveyor Registration No. S-498
(County Surveyor, Registered Land Surveyor, or other duly authorized official)

Office of Register of Deeds, County of Forest, I hereby certify that the within instrument was filed in this office for record on the 16th day of October, 1975 at 2:30 o'clock P.M.

Eugene Stutzman
(Register of Deeds)
By _____ Deputy

DOCUMENT NUMBER **108000**

FORM 985 H. C. MILLER CO., MILWAUKEE

43714333010