

CERTIFIED LAND CORNER RESTORATION

2-17 Index No. 217


State of Wisconsin } ss.
County of Forest

I, Philip T. Hansen, do hereby certify that on the 2nd day of October, 1975, I found evidence of the Section corner of Secs. 34, 35, 3, and 2 Township 37 and 36, North, Range 14 East, Fourth Principal Meridian, as described hereon; and that from this evidence I established a new monument and accessories as described hereon to perpetuate the original location of this corner.


Resident witnesses:

Glen Barker

Jim Claflin

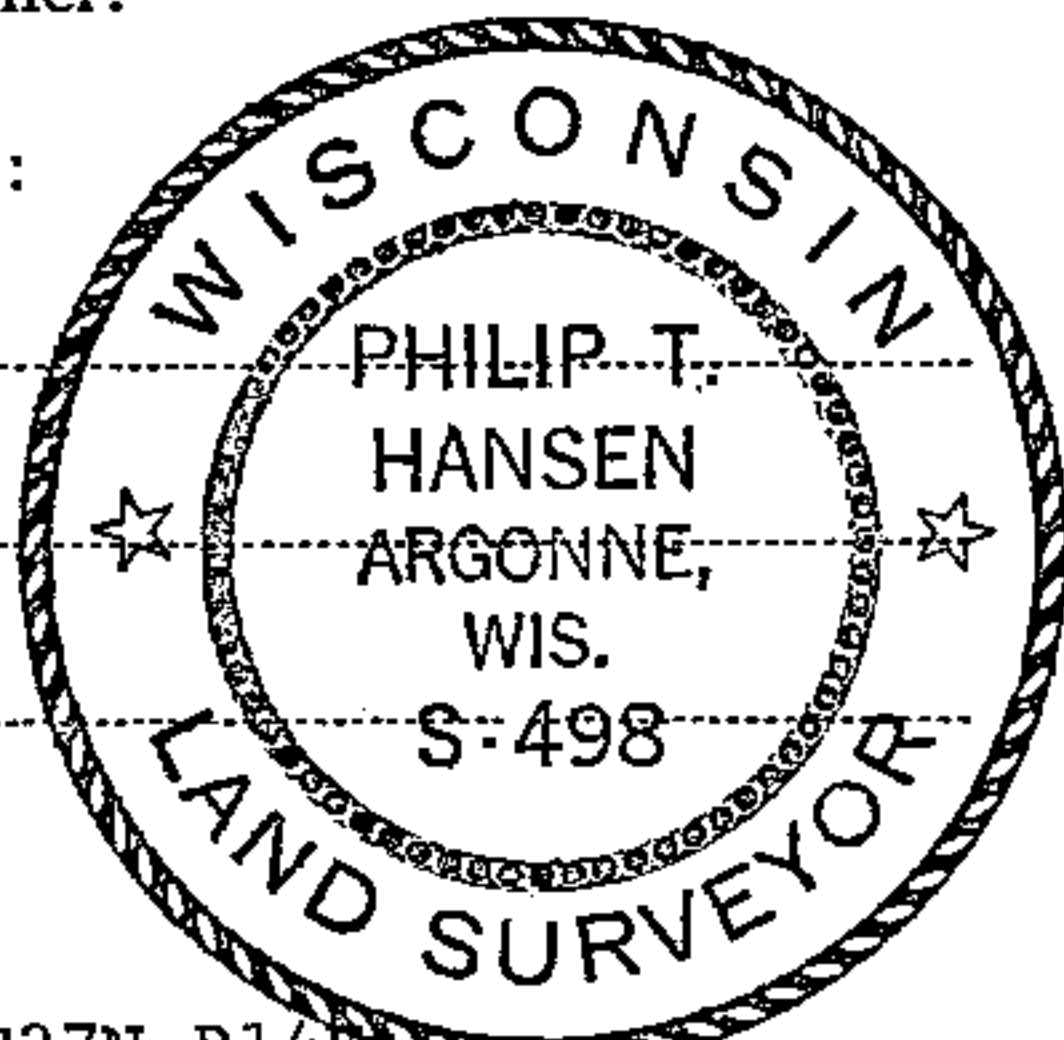

T37N R14E

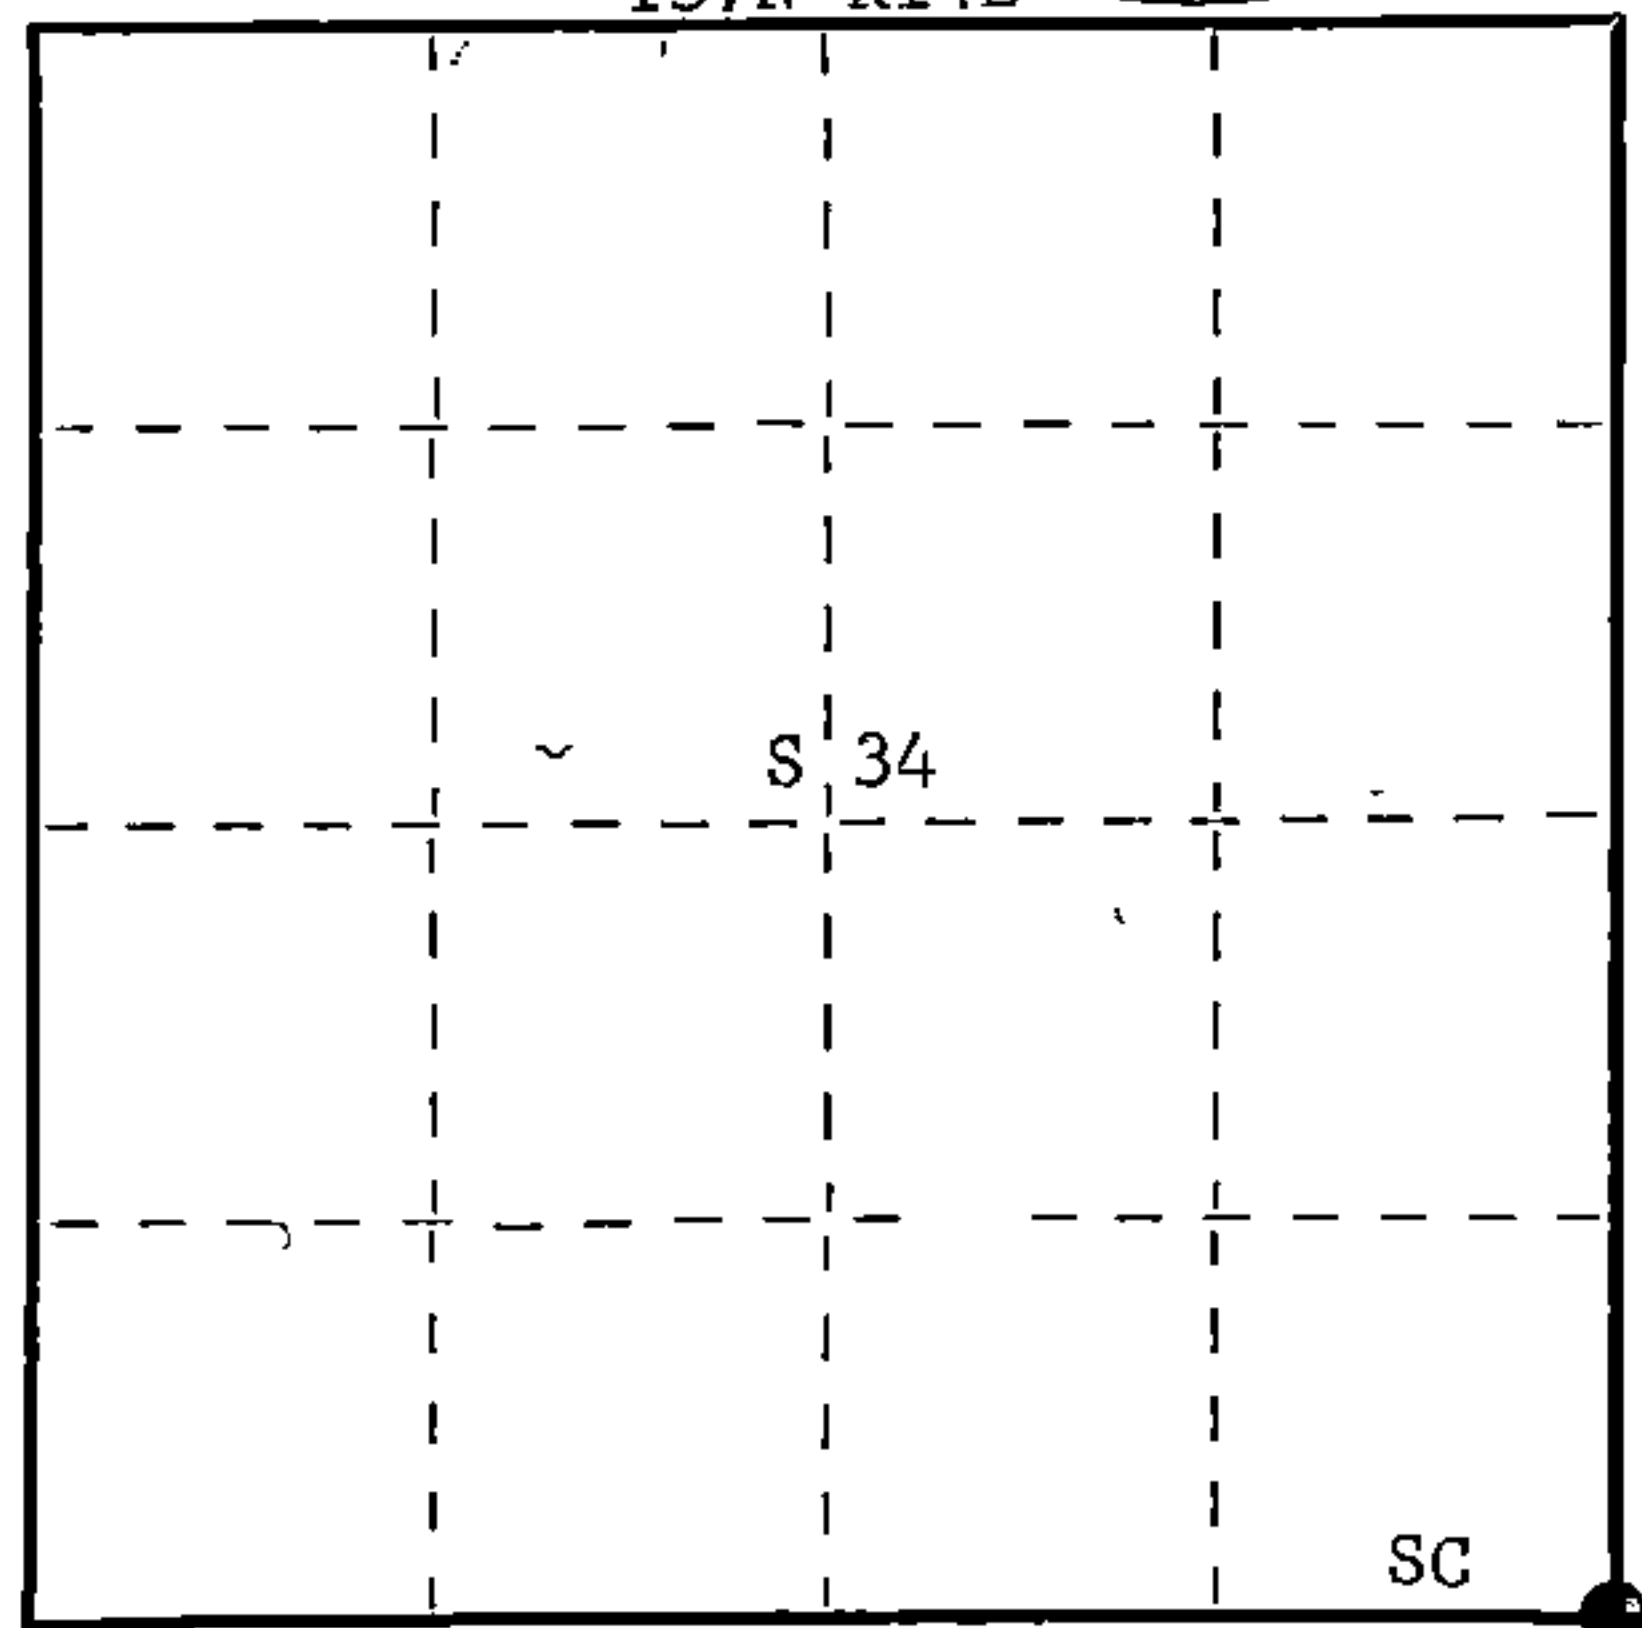

○ = Corner monument restored.

History of original corner establishment: Original corner established by Alfred Millard, Gov. Deputy Surveyor, in 1858, from which Sugar 14" bears N40°W 50 links, Sugar 18" bears N10°E 22 links, Lind 12" bears S55°E 37 links, and Sugar 14" bears S60°W 16 links.

Corner recovered and restored by I.R. Ritter, County Surveyor, in 1921. Set new post and marked NBT's - Hemlock 8" N25°E 8½ links, and Hemlock 8" S60°E 15 links.

Ray Leigh, Consolidated Forester, recovered corner in 1948 and replaced 1½" iron pipe in place of rotted wood stake.

Description of corner evidence found: Recovered 1½" iron pipe in good condition. Recovered OBT - Maple 14" (20") S60°W (S56°W) 16 links (15 links), now a decayed stump.

Description of monument and accessories I established to perpetuate the original location of this corner. Replaced 1½" iron pipe with 2½" x 30" Berntsen A-1 Federal Monument, aluminum with magnet installed in cap and base. Projects 6" above ground. Cap stamped -

NBT's - Sugar 6" N70°W 41.5 links, scribed SC BT.
Sugar 9" S77°W 31.3 links, scribed SC BT.
Elm 12" S37°E 118.7 links, scribed SC BT.

S498
T37N R14E
Sec. 34 | 35
3 | 2
T36N R14E
1975

Post and BT's painted blue.

Dated at Argonne, Wis., this 9th day of October, 1975.

Signature Philip T. Hansen, Title Registered Land Surveyor, Registration No. S-498
(County Surveyor, Registered Land Surveyor, or other duly authorized official)

Office of Register of Deeds, County of Forest, I hereby certify that the within instrument was filed in this office for record on the 16th day of October, 1975 at 2:30 o'clock P.M.

Eugene Staszny (Register of Deeds)
By Deputy

DOCUMENT NUMBER 107998

FORM 985 R. C. MILLER CO., MILWAUKEE

4371434000