

CERTIFIED LAND CORNER RESTORATION


Index No. Z-16

Z16


State of Wisconsin }
County of Forest } ss.

I Daniel K. Plegger, do hereby certify that on the 11th day of March, 1981, I ~~found~~ established E 1/16 corner of Sections 3 & 34 Township 36 & 37, North, Range 14 East, Fourth Principal Meridian, as described hereon; and that from this evidence I established a new monument and accessories as described hereon to perpetuate the original location of this corner.

Resident witnesses:

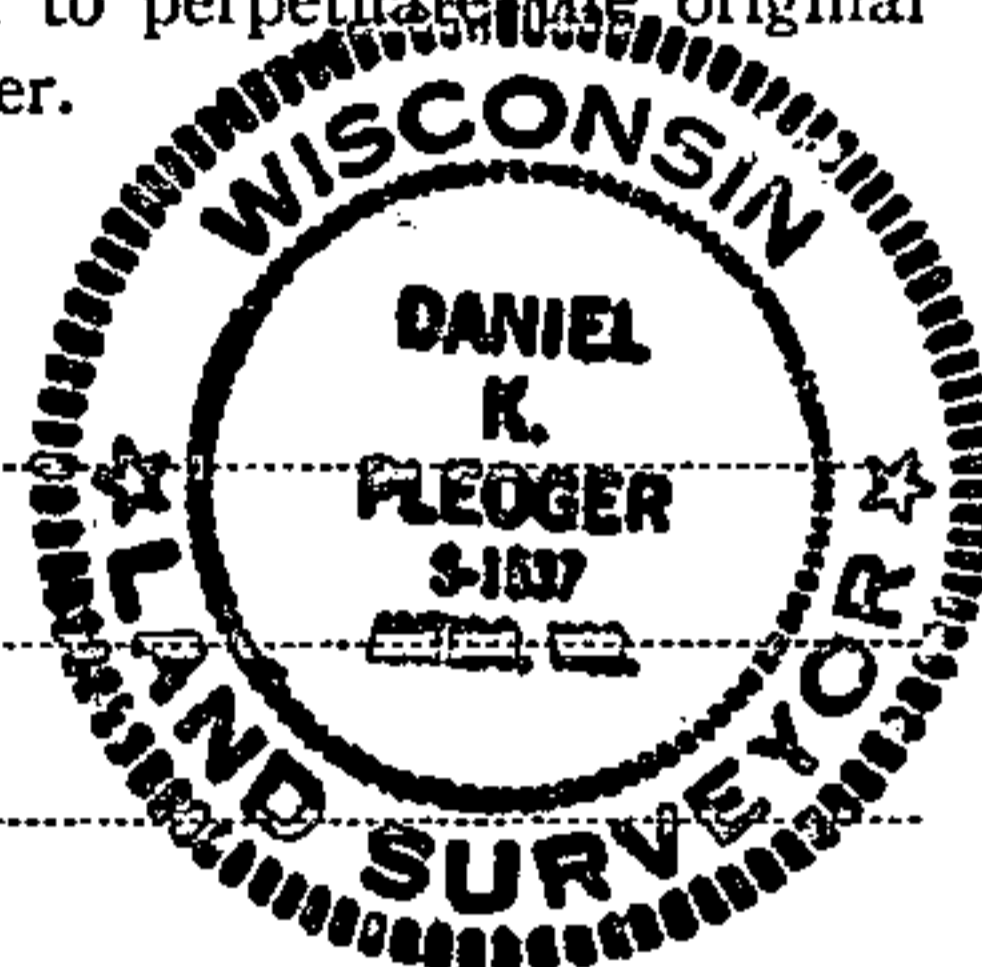

FORM 985 H. C. MILLER CO., MILWAUKEE

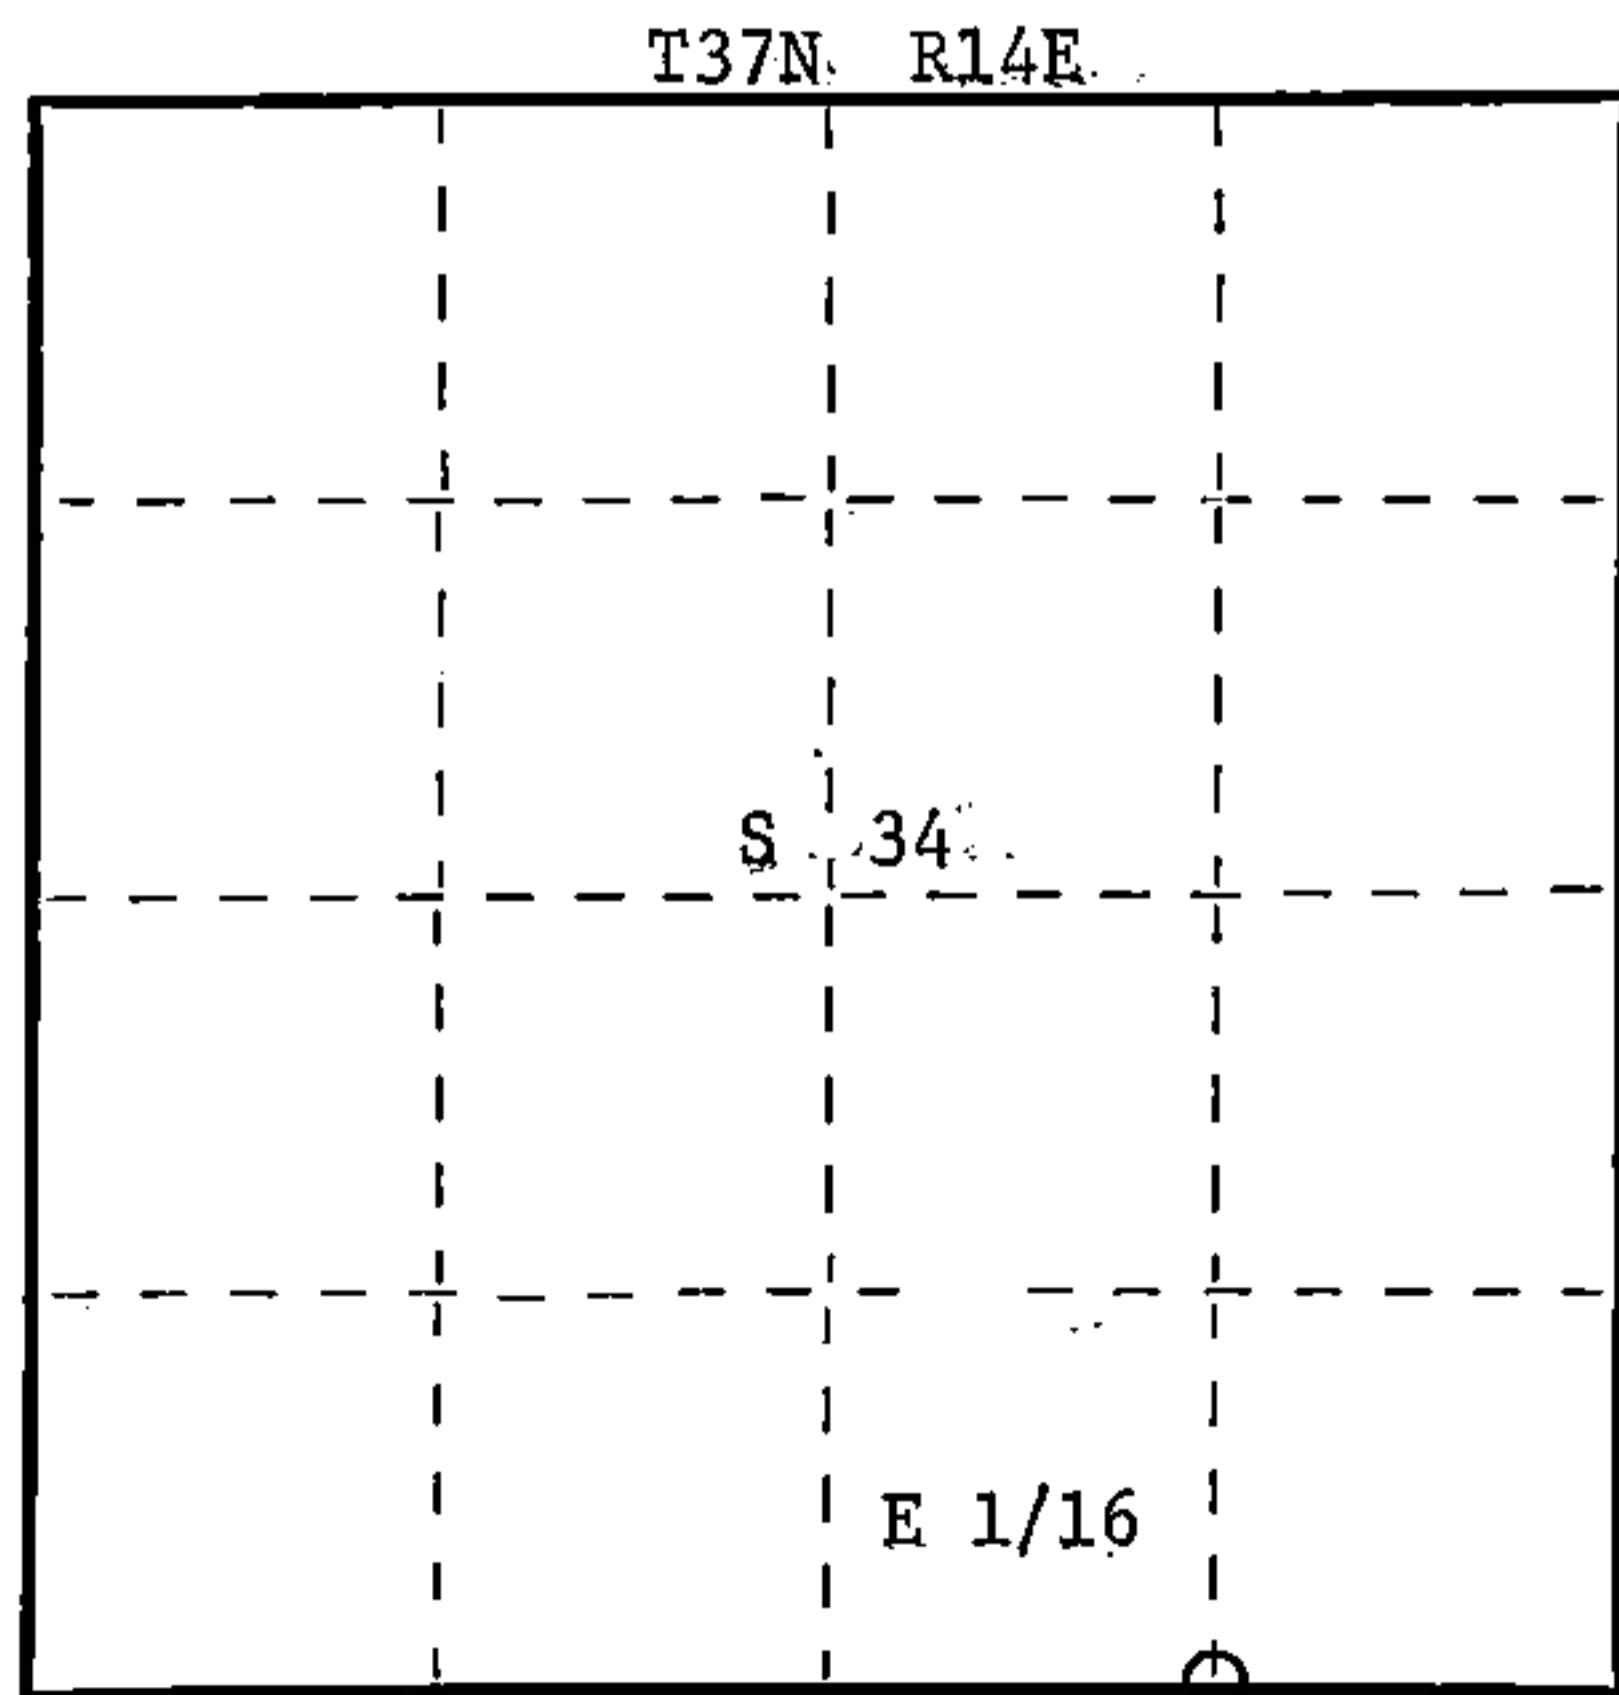

○ = Corner monument restored.

History of original corner establishment:

No evidence of any previous corner.

Description of corner evidence found:

Ran traverse from section corner 2-3- & 34-35 T36&37N-R14E for a distance of 2644.496 feet at bearing N88-15-19W.
Set E 1/16 1322.248 feet intermediate.

Description of monument and accessories I established to perpetuate the original location of this corner.

Set a 1-1/2" iron pipe with 2" diameter brass cap - stamped:
Projecting 18" above ground.

Marked NBT's:-

Yellow Birch 8" S81°W 15.74 feet
Yellow Birch 9" S2°W 34.90 feet
scribed 1/16 B.T.

S1537
T37N R14E
E 1/16 S 34
S 3
T36N R14E

Dated at Rhineland, Wis., this 24th day of June, 19 81.

Signature Daniel K. Plegger Title Registered Land Surveyor Registration No. 1537
(County Surveyor, Registered Land Surveyor, or other duly authorized official)

Office of Register of Deeds, County of Forest, I hereby certify that the within instrument was filed in this office for record on the 1st day of July, 19 81 at 8:30 o'clock A. M.

Eugene Statermy
(Register of Deeds)
By _____ Deputy

DOCUMENT NO.
120053

4371434 0010