

CERTIFIED LAND CORNER RESTORATION


Index No. Z-14

Z14


State of Wisconsin }
County of Forest } ss.

I Daniel K. Plegger, do hereby certify that on the 9th day of March, 1981, I ~~found~~ ^{established} ~~evidence of the~~ ^{W 1/16} corner of Sections 3 and 34 Township 37&36, North, Range 14 East, Fourth Principal Meridian, as described hereon; and that from this evidence I established a new monument and accessories as described hereon to perpetuate the original location of this corner.

Resident witnesses:

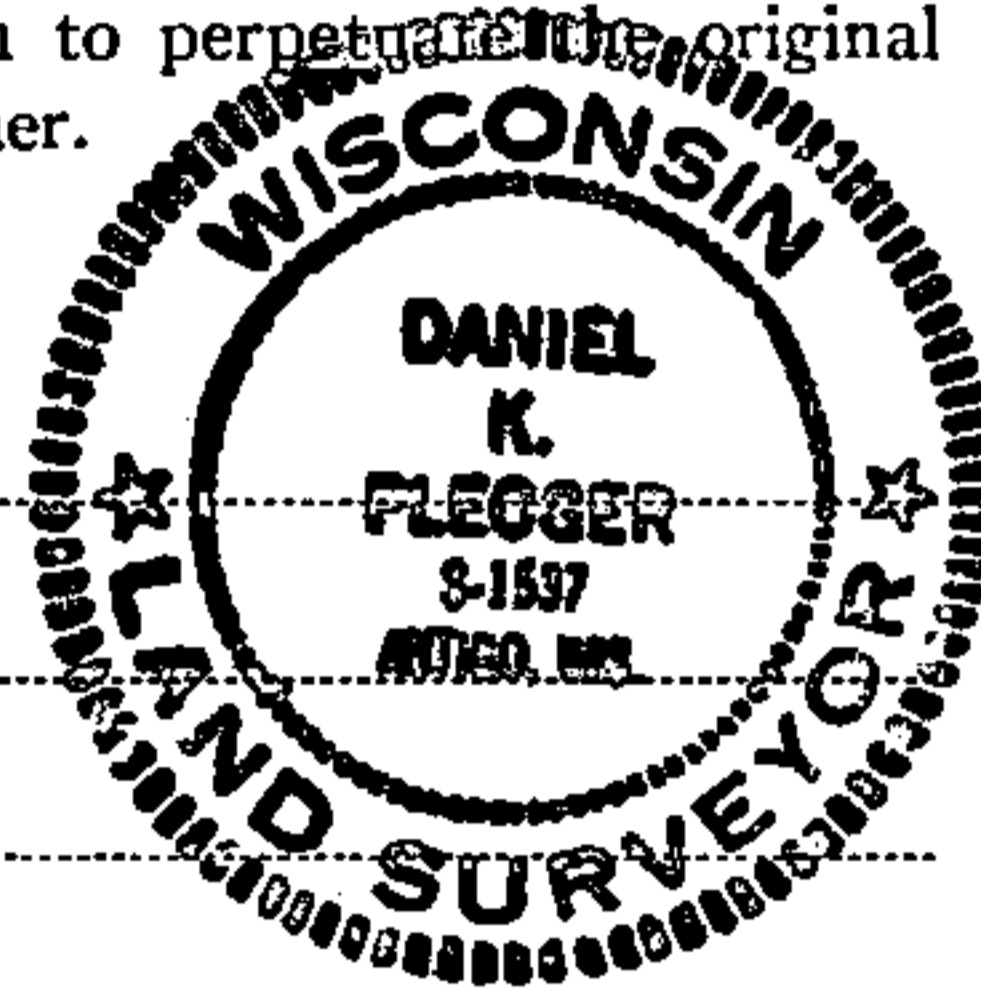

FORM 985 M. C. MILLER CO., MILWAUKEE

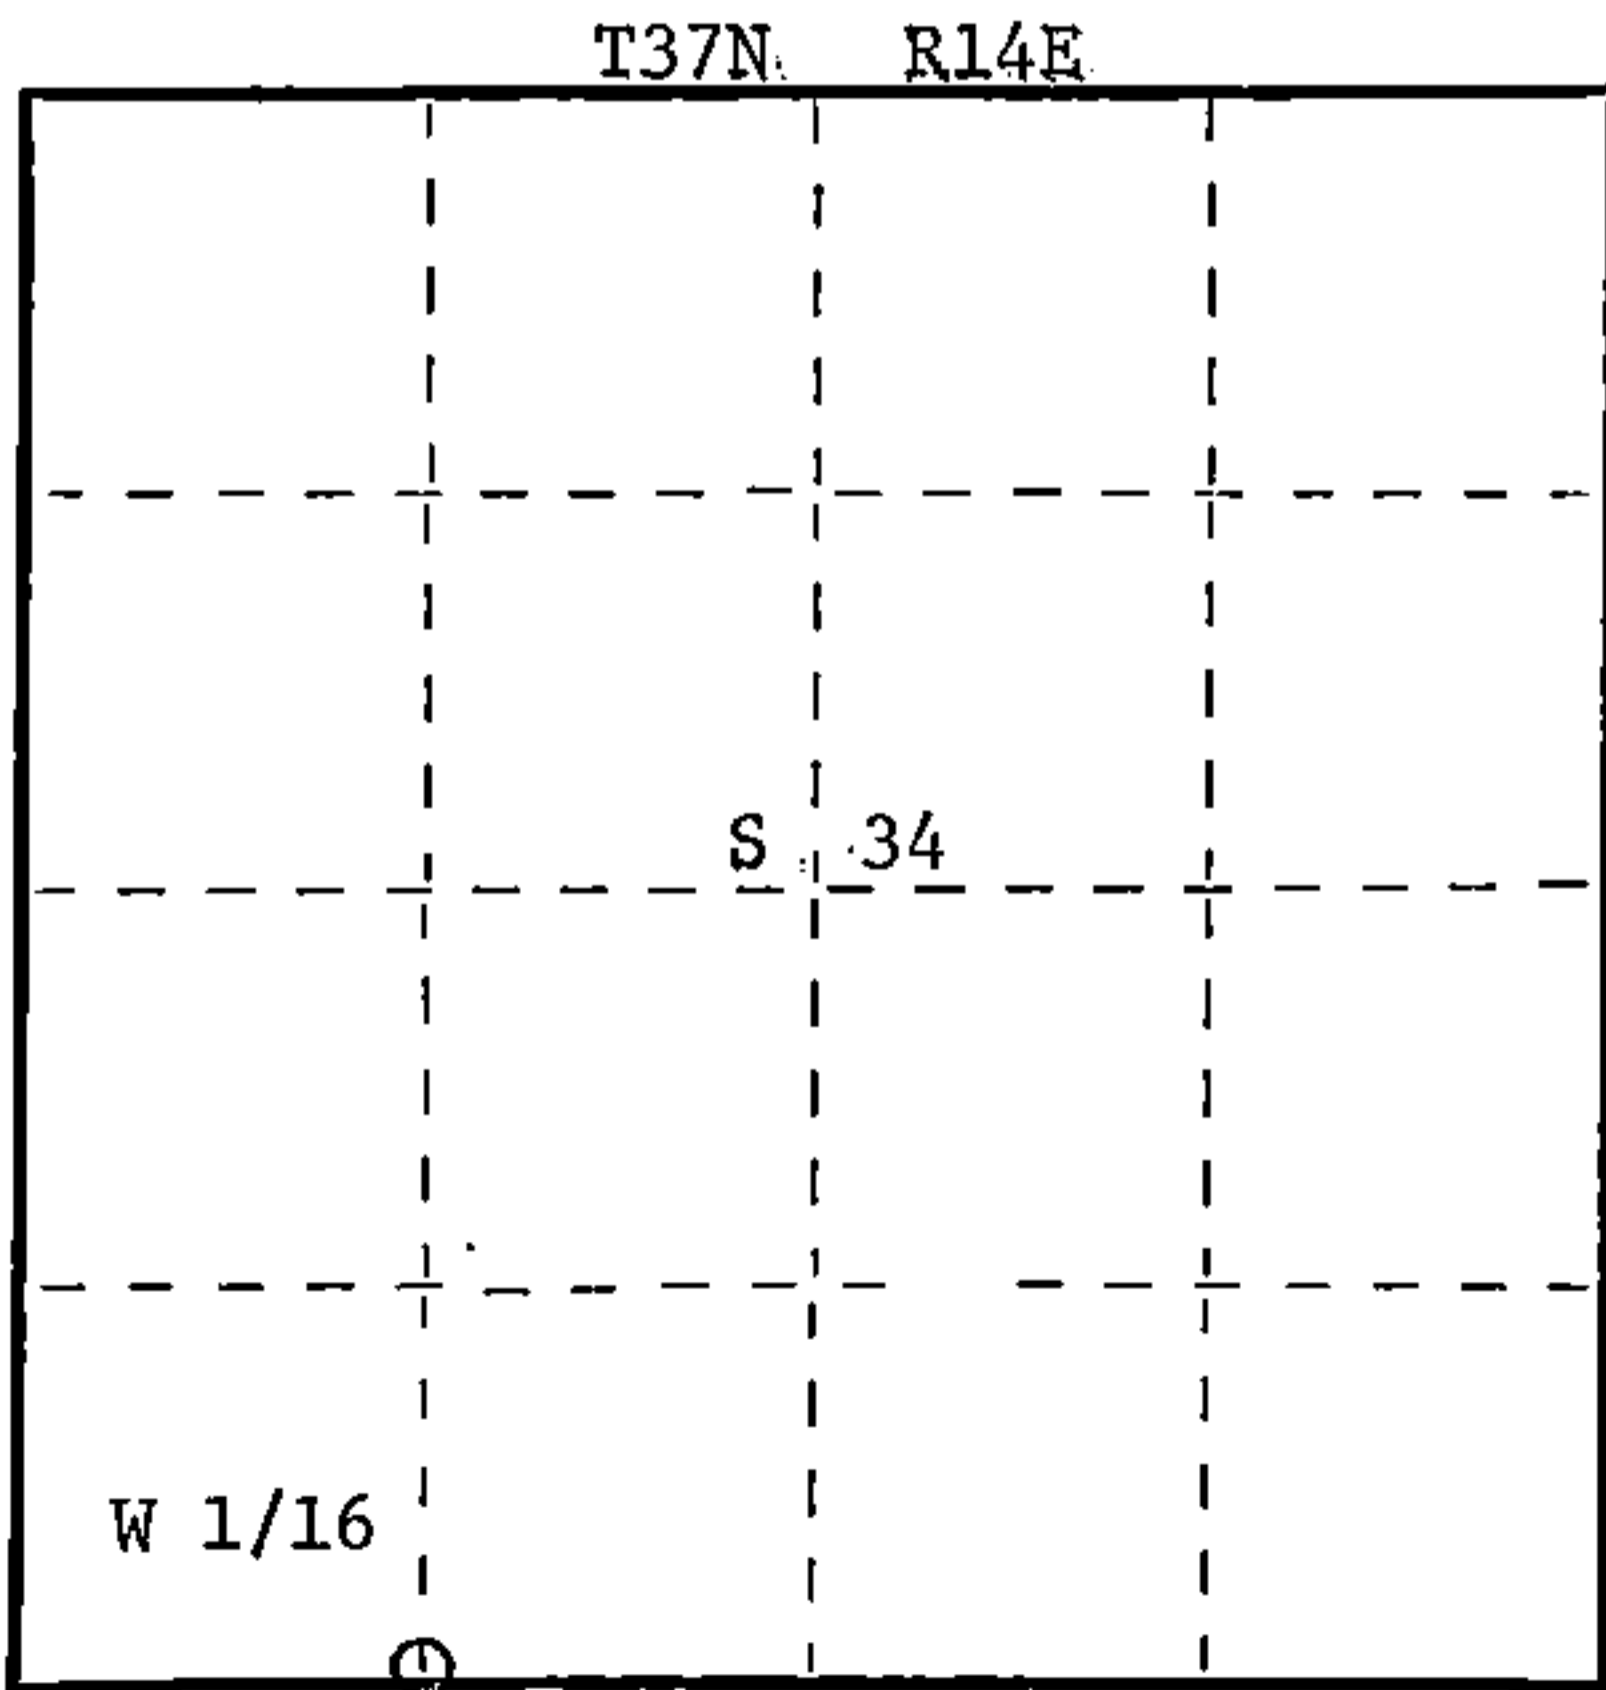

○ = Corner monument restored.

History of original corner establishment:

No evidence of any previous corner.

Description of corner evidence found:

Ran traverse from section corner 3-4-33-34 T36&37N-R14E to 1/4 corner between sections 3 and 34 T36&37N-R14E for a distance of 2743.167 feet at bearing S87-46-12E.
Set W 1/16 1371.583 feet intermediate.

Description of monument and accessories I established to perpetuate the original location of this corner.

Set a 1-1/2" iron pipe with brass cap - stamped:
Projecting 18" above ground.

Marked NBT's:

Black Spruce 8" N3°E 29.68 feet
Black Spruce 6" S63°W 17.68 feet
scribed 1/16 B.T.

S1537
T37N R14E
W 1/16 S+34
S 3
T36N R14E
CPI 1981

Dated at Rhineland, Wis., this 24th day of June, 1981

Signature Daniel K. Plegger Title Registered Land Surveyor Registration No. 1537
(County Surveyor, Registered Land Surveyor, or other duly authorized official)

Office of Register of Deeds, County of Forest, I hereby certify that the within instrument was filed in this office for record on the 1st day of July, 1981 at 8:30 o'clock A. M.

Eugene Stutzman
(Register of Deeds)
Deputy

DOCUMENT NO. **120051**

43714340030