

CERTIFIED LAND CORNER RESTORATION


Index No. X-15

X 15


State of Wisconsin }
County of Forest } ss.

I Daniel K. Pleoger, do hereby certify that on the 3rd day of March, 1981, I found established evidence of the C 1/4 corner of section 34 Township 37 North, Range 14 East, Fourth Principal Meridian, as described hereon; and that from this evidence I established a new monument and accessories as described hereon to perpetuate the original location of this corner.

Resident witnesses:

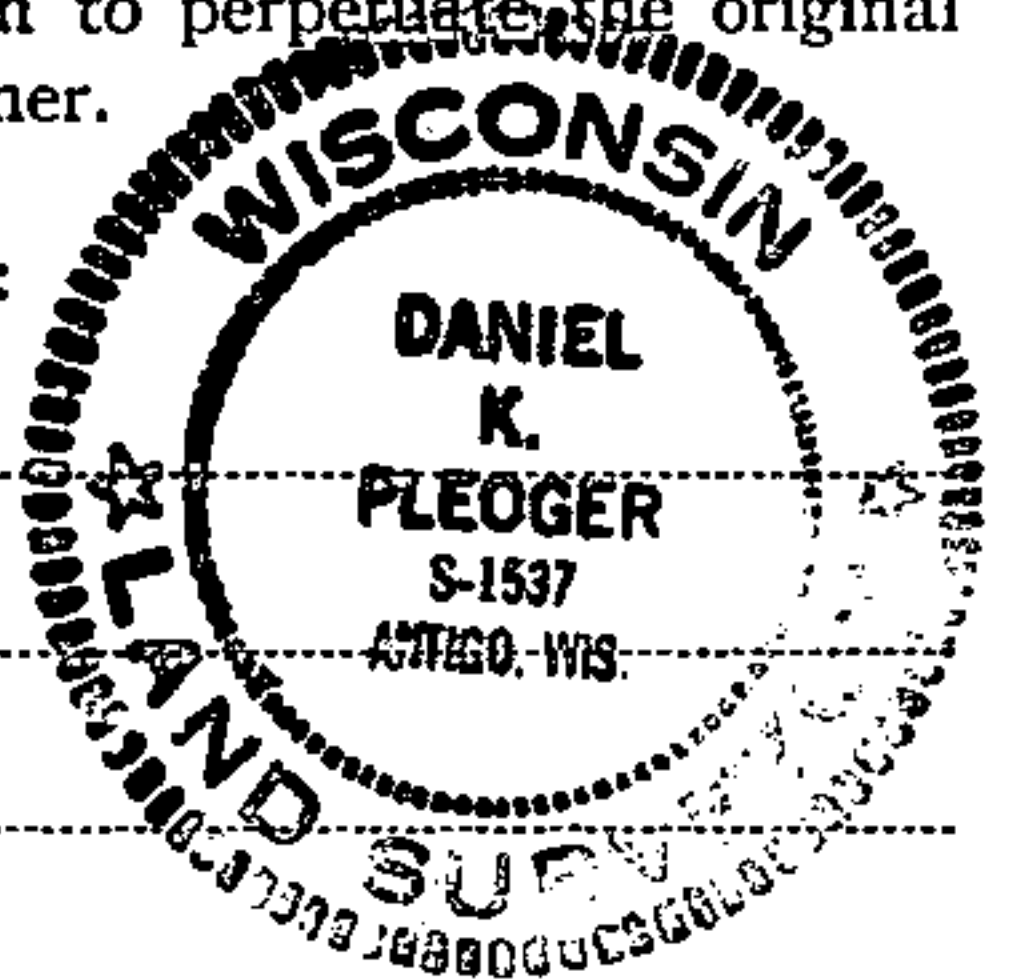

FORM 985 H. C. MILLER CO., MILWAUKEE

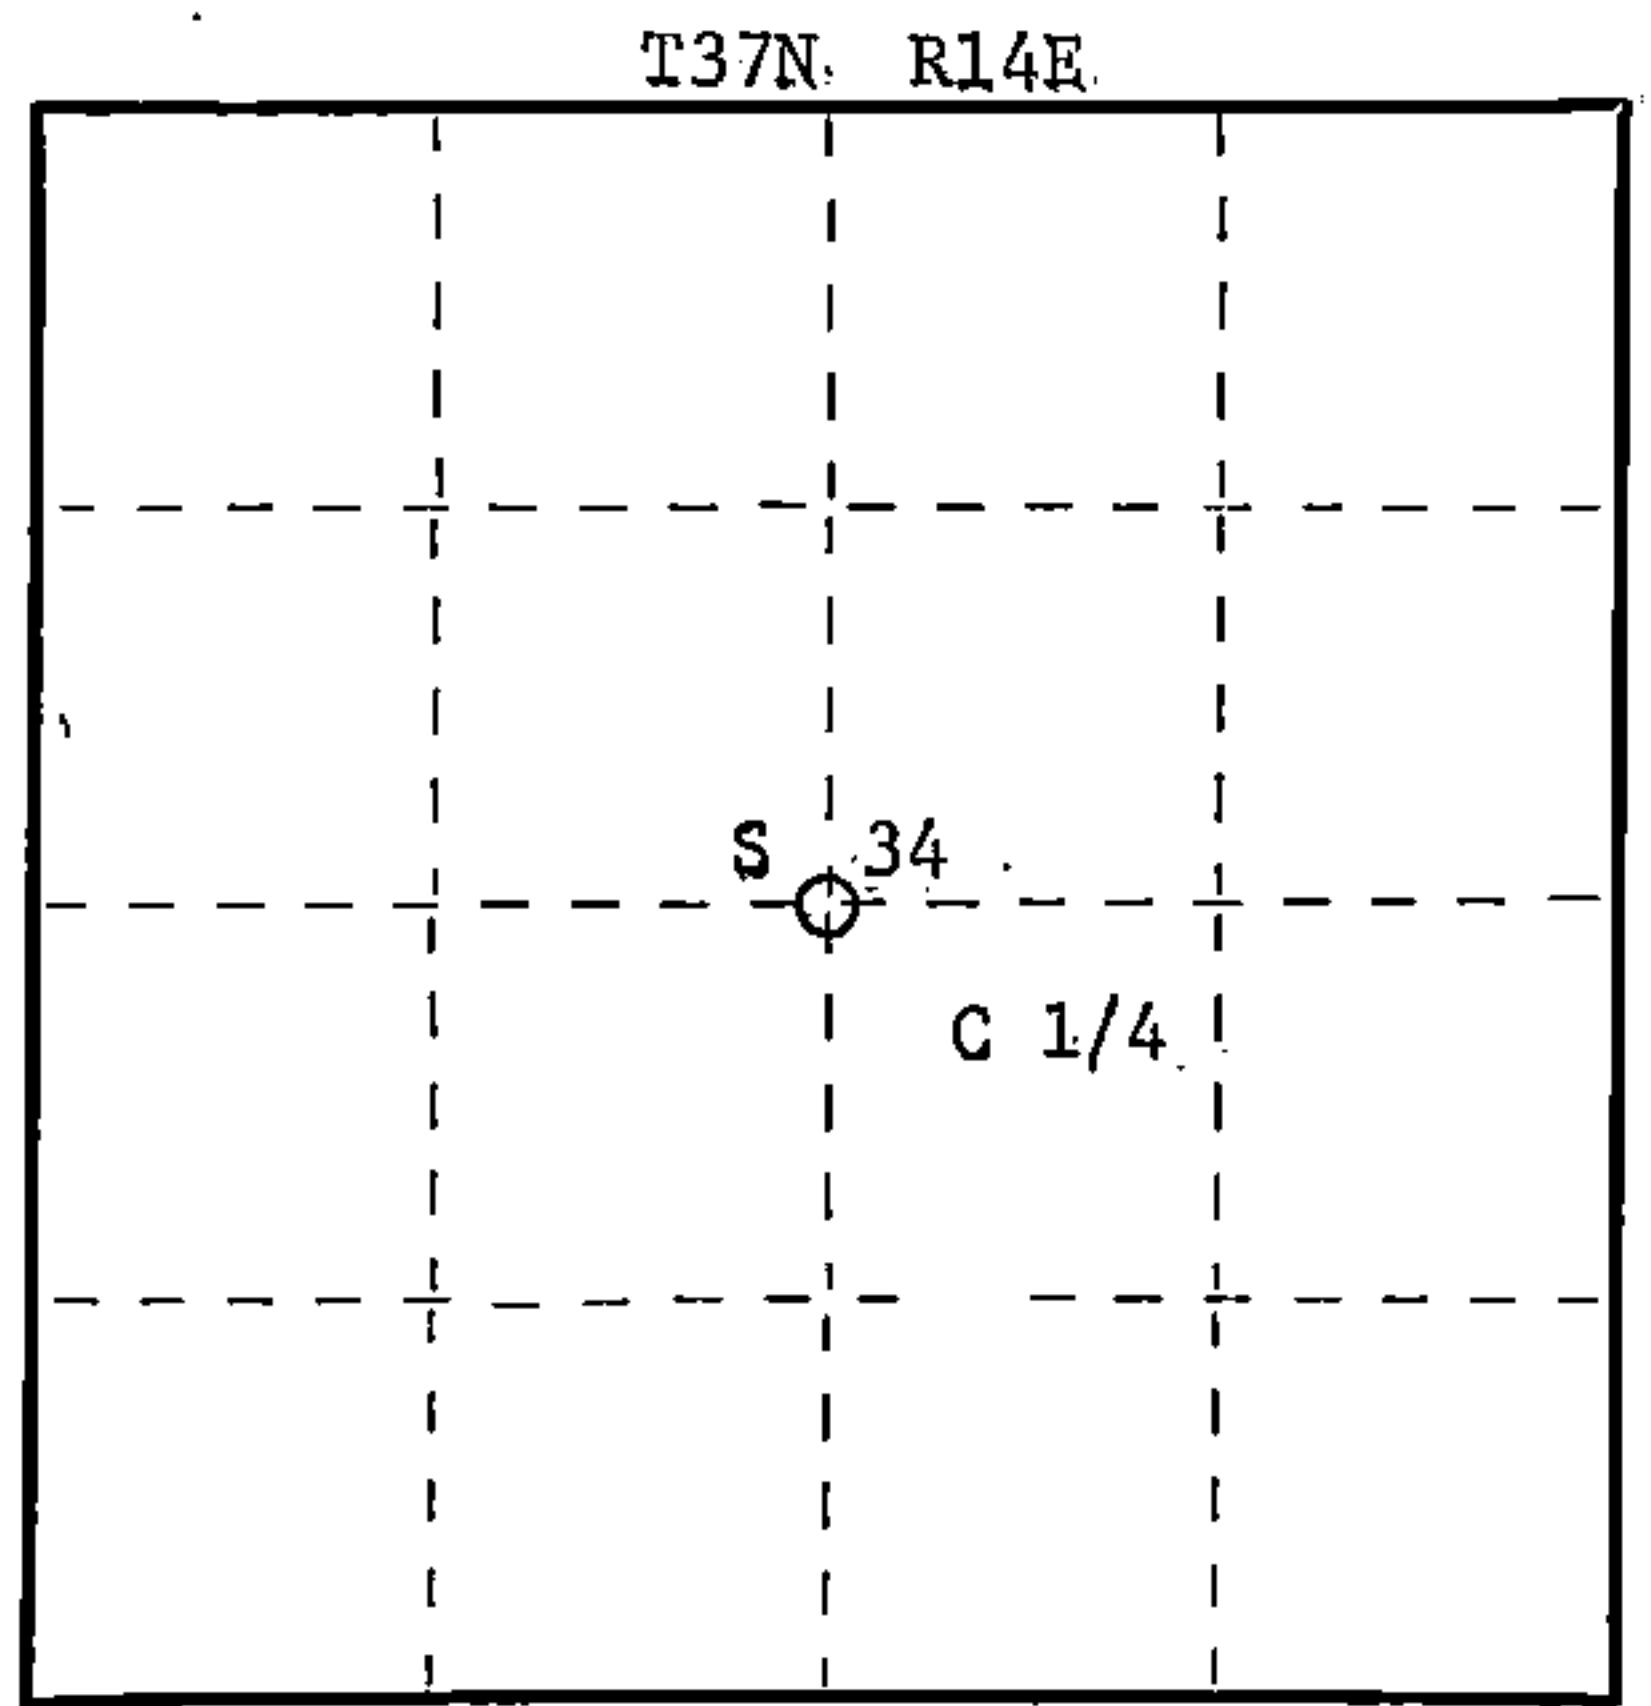

○ = Corner monument restored.

History of original corner establishment:

No evidence of any previous corner.

Description of corner evidence found:

- Corner established by traverse and computation.
- Corner sets S2-14-21W 2705.90 feet of N 1/4 corner.
- N89-06-46W 2615.664 feet of E 1/4 corner.
- N2-14-21E 2718.802 feet of S 1/4 corner.
- S89-06-46E 2627.05 feet of W 1/4 corner.

Description of monument and accessories I established to perpetuate the original location of this corner.

Set a 2-1/2" Federal A-1 Monument with alloy cap - stamped:
Projecting 18" above ground.

Marked NBT's:

- Tamarack 6" N63°E 12.75 feet
 - Tamarack 8" S21°E 6.80 feet
 - Tamarack 6" S57°W 5.13 feet
- scribed C 1/4 - B.T.

T37N R14E
C 1/4 S 34
S1537-1981

Dated at Rhinelander, Wis., this 23rd day of June, 1981.

Signature Daniel K. Pleoger Title Registered Land Surveyor Registration No. 1537
(County Surveyor, Registered Land Surveyor, or other duly authorized official)

Office of Register of Deeds, County of Forest, I hereby certify that the within instrument was filed in this office for record on the 1st day of July, 1981 at 8:30 o'clock A. M.

Eugene Stutzman
(Register of Deeds)

By _____ Deputy

DOCUMENT NO.
120044

43714342020