

CERTIFIED LAND CORNER RESTORATION



Index No. W-17

W17

State of Wisconsin }
County of Forest } ss.

I, Daniel K. Pleoger, do hereby
certify that on the 12th day
of March, 1981, I ~~found~~
~~re-established~~ re-established
~~corner of the~~ N 1/16
corner of sections 34 & 35
Township 37, North, Range
14 East, Fourth Principal Meridian,
as described hereon; and that from this evidence
I established a new monument and accessories
as described hereon to perpetuate the original
location of this corner.

Resident witnesses:

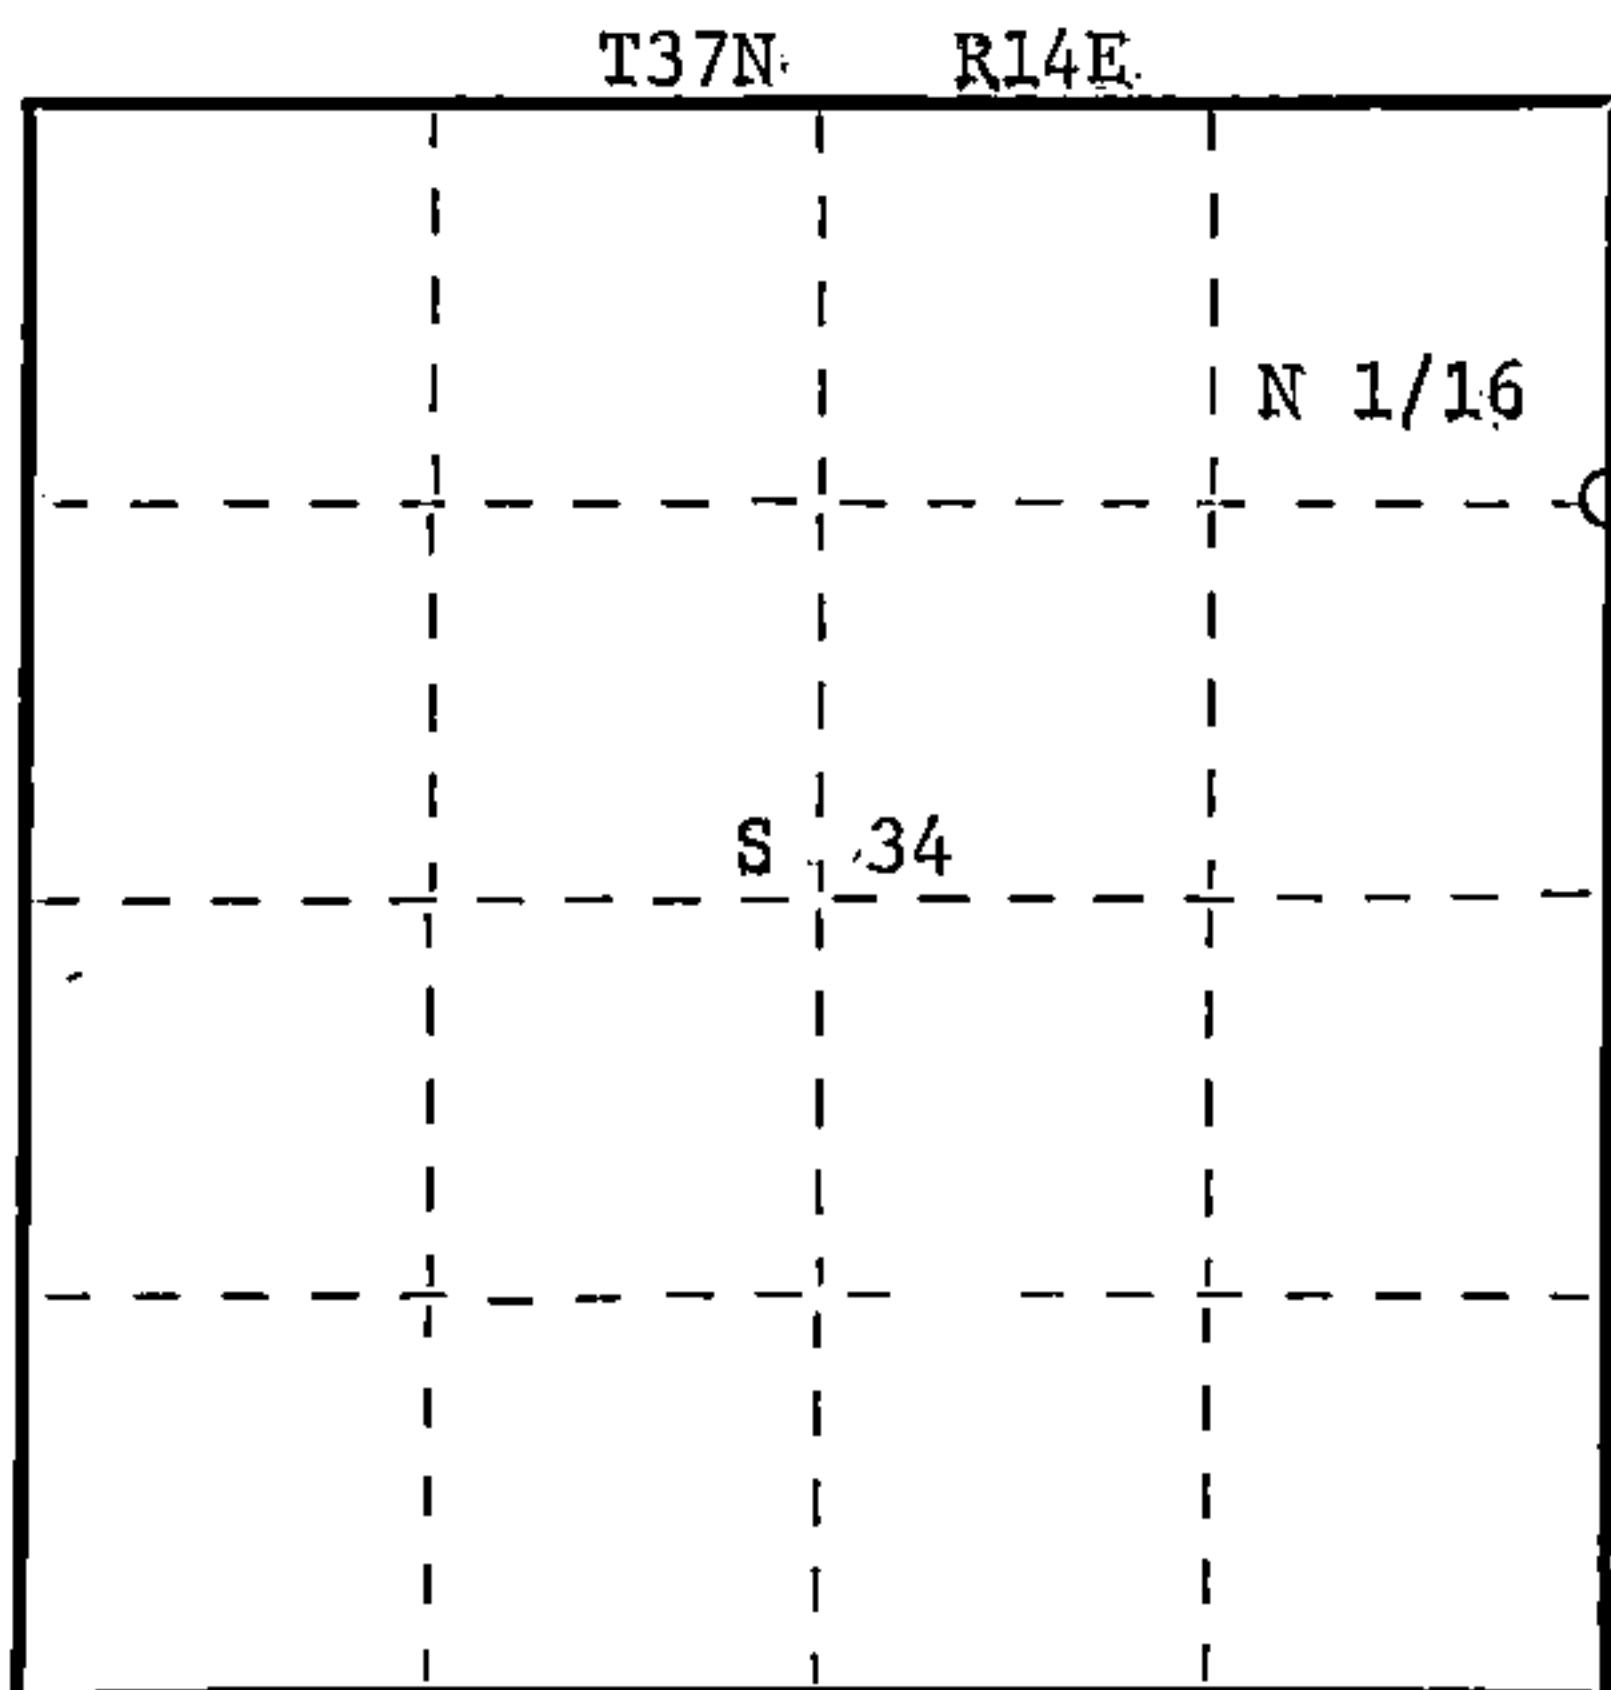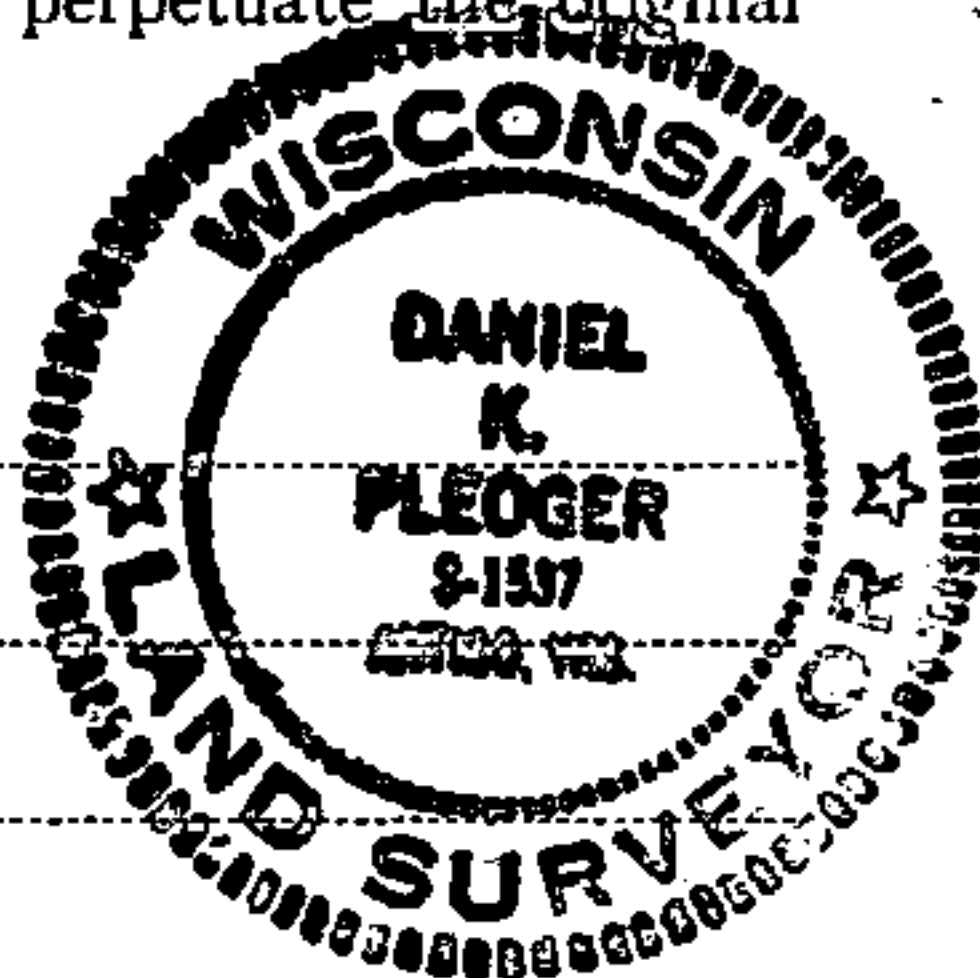

○ = Corner monument restored.

History of original corner establishment:

No evidence of any previous corner.

Description of corner evidence found:

Ran traverse from section corner 26-27-34-35 to 1/4 corner between sections
34 and 35 for a distance of 2751.303 feet at bearing S1-42-31W.
Set N 1/16 1375.651 feet intermediate.

Description of monument and accessories I established to perpetuate the original location of this corner.

Set a 1-1/2" iron pipe with 2" diameter brass cap - stamped:
Projecting 24" above ground.
Marked NBT's:

Cedar 6" S53°E 14.85 feet
Maple 6" S6°W 66.05 feet
scribed 1/16 - BT

S1537
T37N R14E
N 1/16 34-35
CPI 1981

Dated at Rhineland, Wis., this 24th day of June, 1981

Signature Daniel K. Pleoger Title Registered Land Surveyor Registration No. 1537
(County Surveyor, Registered Land Surveyor, or other duly authorized official)

Office of Register of Deeds, County of Forest, I hereby certify that the within
instrument was filed in this office for record on the 1st day of July, 1981
at 8:30 o'clock A. M.

Eugene Stearns
(Register of Deeds)
By _____ Deputy

DOCUMENT NO.
120042