

CERTIFIED LAND CORNER RESTORATION

State of Wisconsin }
County of Forest } ss.

I Milo E. Stefan, do hereby certify that on the 21 day of October, 19 80, I found evidence of the North Quarter corner of Section 1 Township 36 and 37 North, Range 14 East, Fourth Principal Meridian, as described hereon; and that from this evidence I established a new monument and accessories as described hereon to perpetuate the original location of this corner:

Description of original monument and accessories and subsequent restorations:

Surveyed by Alfred Curtis in 1858.
Set Wood Post
Sugar 10", S30°E, 14 lks.
Sugar 12", N24°W, 33 lks.

Description of corner evidence found:

1½" ironpipe and fallen wood post
Stump Hole, S30°E, 9.5'
Stump Hole, N20°W, 22.0'


Description of monument and accessories I established to perpetuate the location of this corner:

At corner position set 2 inch by 30 inch aluminum pipe with cap stamped:
T37N, T36N, R14E, ¼, S36, S1, 1980, R.L.S. 1558

From which the following bear:

Hemlock 14", N44°E, 25.28'
Sugar Maple 6", S33°E, 43.92'
Sugar Maple 8", N85°W, 24.78'

DOCUMENT NO.
119864

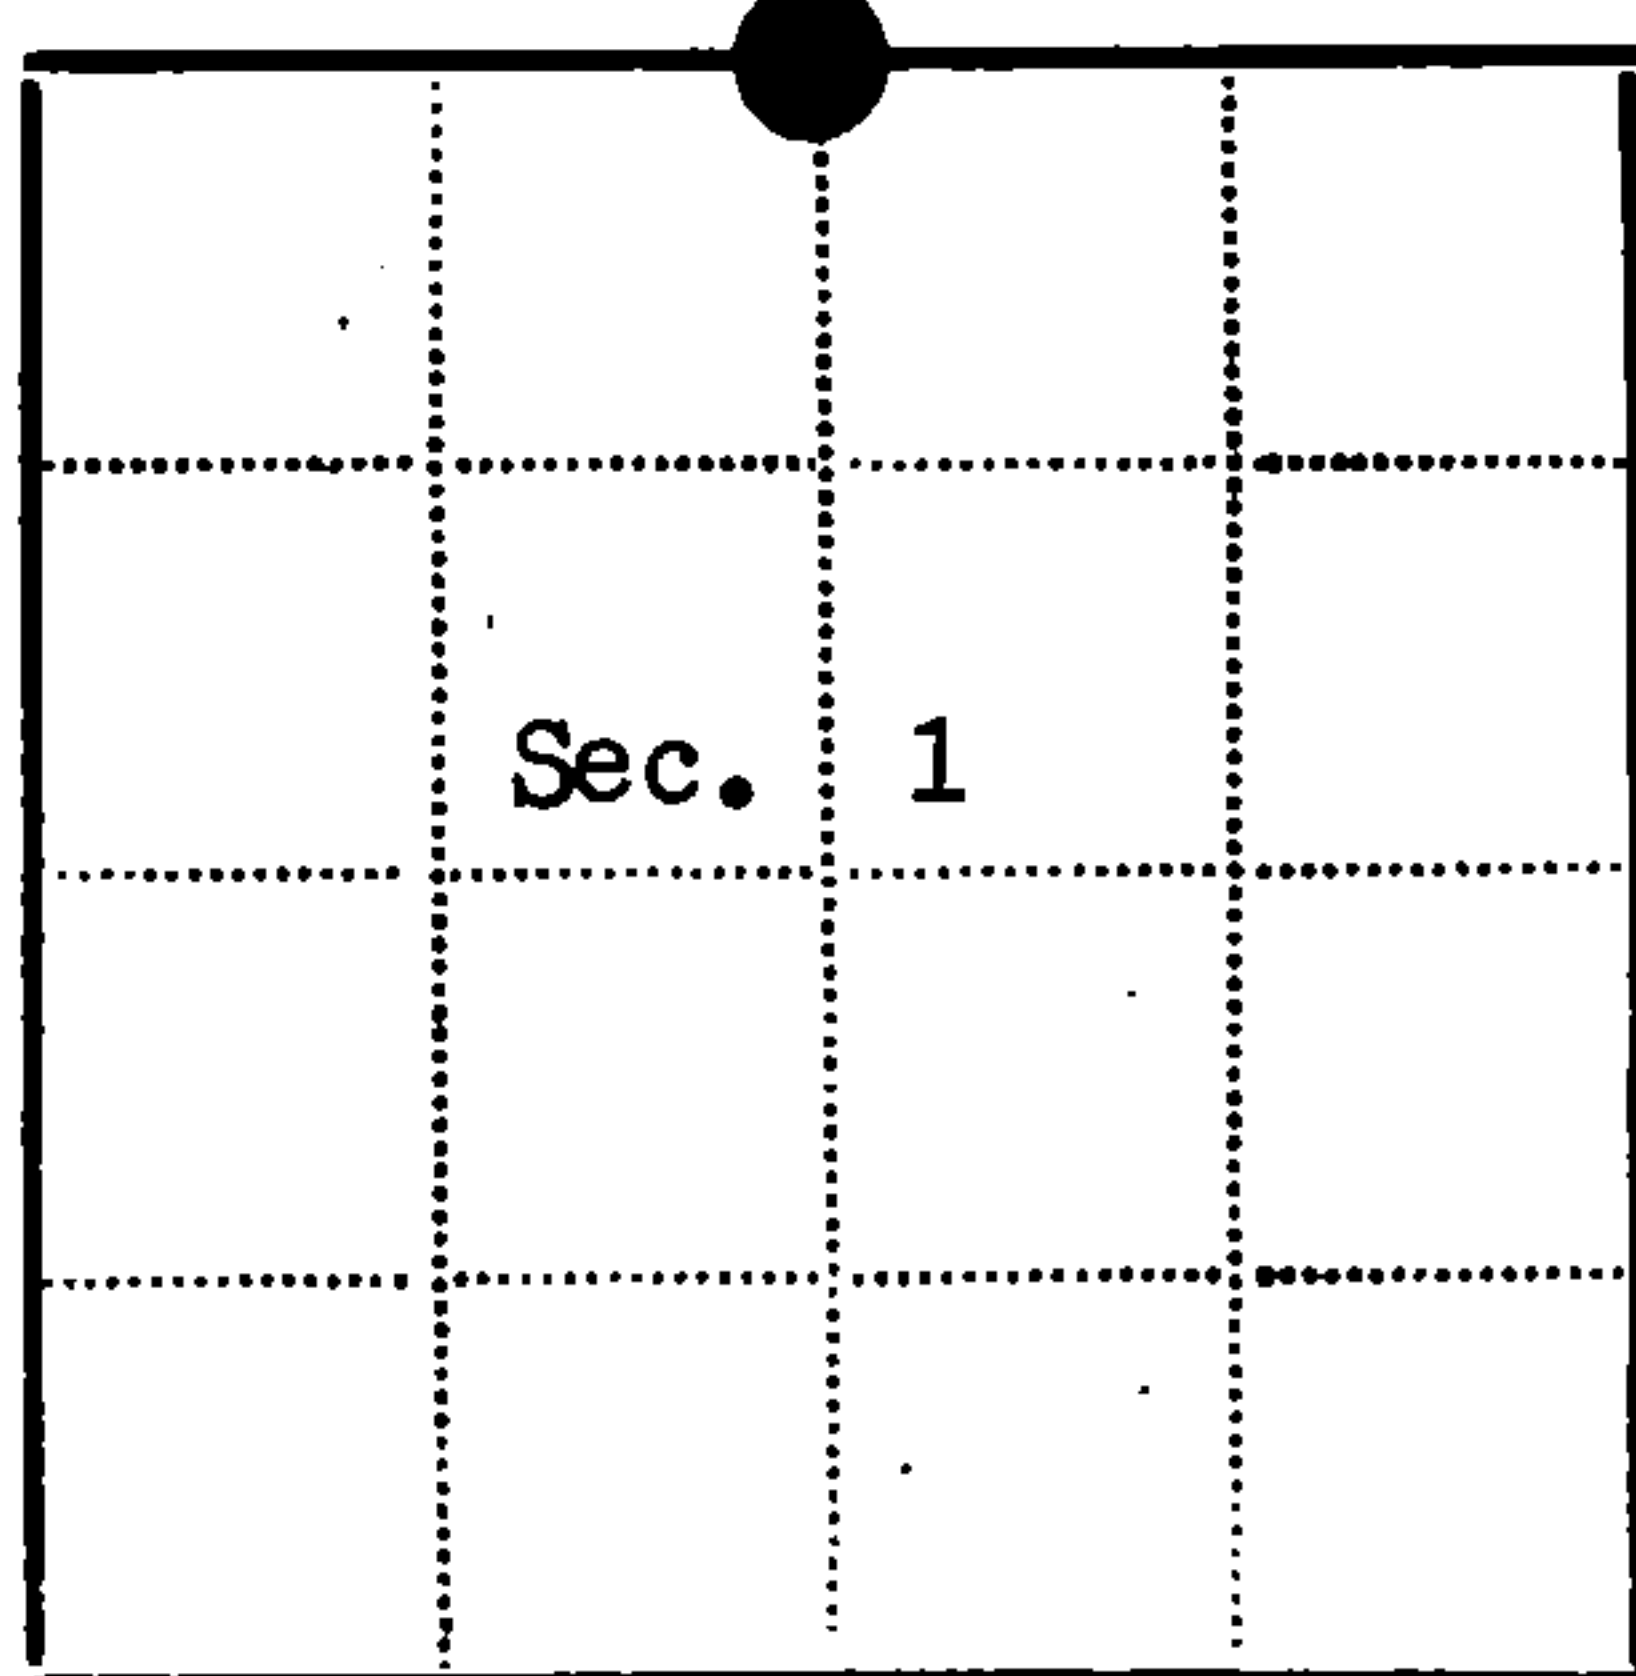

● - Corner monument restored
□ -

Resident witnesses.....

Dated at Laona Wisconsin, this 3 day of November 19 80..

Signature *Milo E. Stefan* Title Land Surveyor
(County Surveyor, Registered Land Surveyor, or other duly authorized official)

Surveyors Registration No. 1558

Office of Register of Deeds County of Forest

I hereby certify that the within instrument was filed in this office for record on the 2nd day of June 19 81, and was filed in Book No. Page No. of County Records.

Signature *Eugene Stutzman* Title Register of Deeds

Township 36N, Range 14E, Section 1, Index No. A-23, Page No.