

CERTIFIED LAND CORNER RESTORATION

Index No. **X-24**

State of Wisconsin }  
County of Forest } ss.

History of original corner establishment:  
No evidence of any previous corner.

I Daniel K. Pleoger, do hereby certify that on the 13 day of September, 19 81, I found evidence of the EC 1/16 corner of Section 36 Township 37, North, Range 14 East, Fourth Principal Meridian, as described hereon; and that from this evidence I established a new monument and accessories as described hereon to perpetuate the original location of this corner.


Description of corner evidence found:  
Total distance from 1/4 corner between sections 36 & 31 T37N R14 & 15E to C 1/4 corner section 36 is 2676.106 ft. at bearing N87-39-36W  
Set EC 1/16 1338.053 ft. intermediate.

Resident witnesses:




Description of monument and accessories I established to perpetuate the original location of this corner.

Set a 1 1/2" iron pipe with 2" diameter brass cap stamped:  
Monument projects 18" above ground.  
Marked NBTs  
Maple 6" S44E 22.32 ft.  
Maple 4" S31W 28.11 ft.  
Scribed 1/16 - B.T.

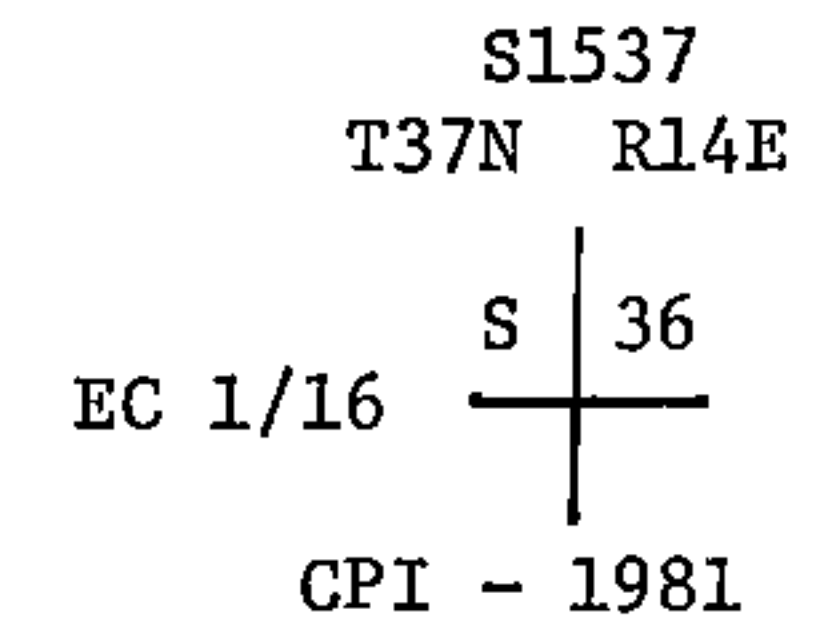

FORM 985 R. C. MILLER CO., MILWAUKEE

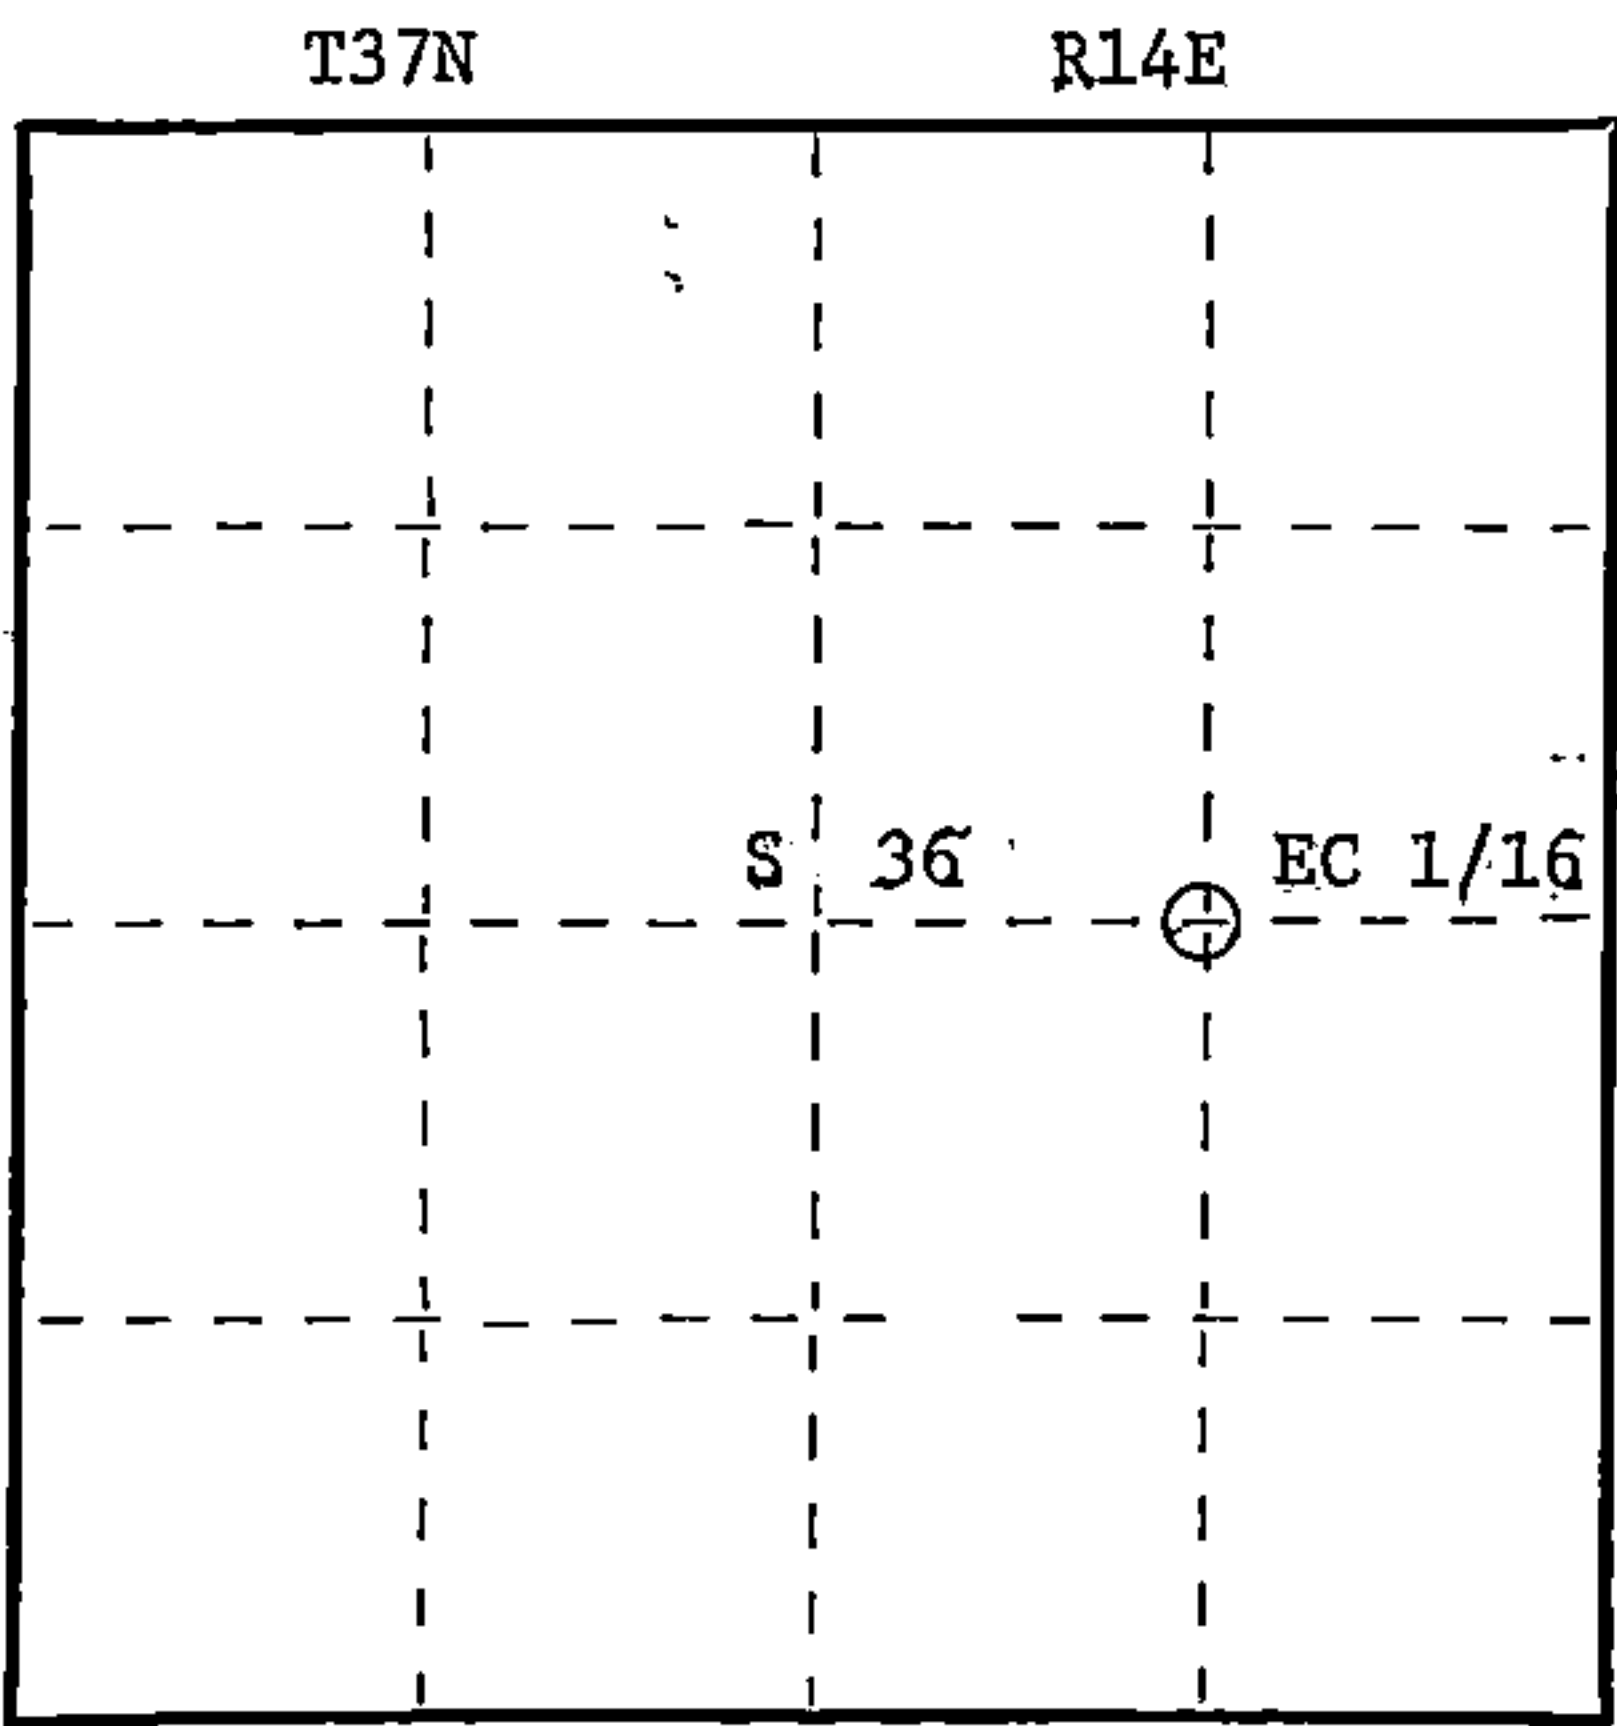

○ = Corner monument restored.

Dated at Rhinelander, Wis., this 4th day of November, 19 81

Signature Daniel K. Pleoger Title Registered Land Surveyor Registration No. 1537  
(County Surveyor, Registered Land Surveyor, or other duly authorized official)

Office of Register of Deeds, County of Forest, I hereby certify that the within instrument was filed in this office for record on the 19th day of January, 19 82 at 3:00 o'clock P. M.

By [Signature] Deputy  
(Register of Deeds)

DOCUMENT NO. 121098

43714302010