


CERTIFIED LAND CORNER RESTORATION

Index No. **W 25**

State of Wisconsin }  
County of Forest } ss.

I Daniel K. Plegger, do hereby certify that on the 3 day of September, 19 81, I found evidence of the N 1/16 corner of Sections 36 & 31 Township 37 North, Range 14 & 15 East, Fourth Principal Meridian, as described hereon; and that from this evidence I established a new monument and accessories as described hereon to perpetuate the original location of this corner.

Resident witnesses

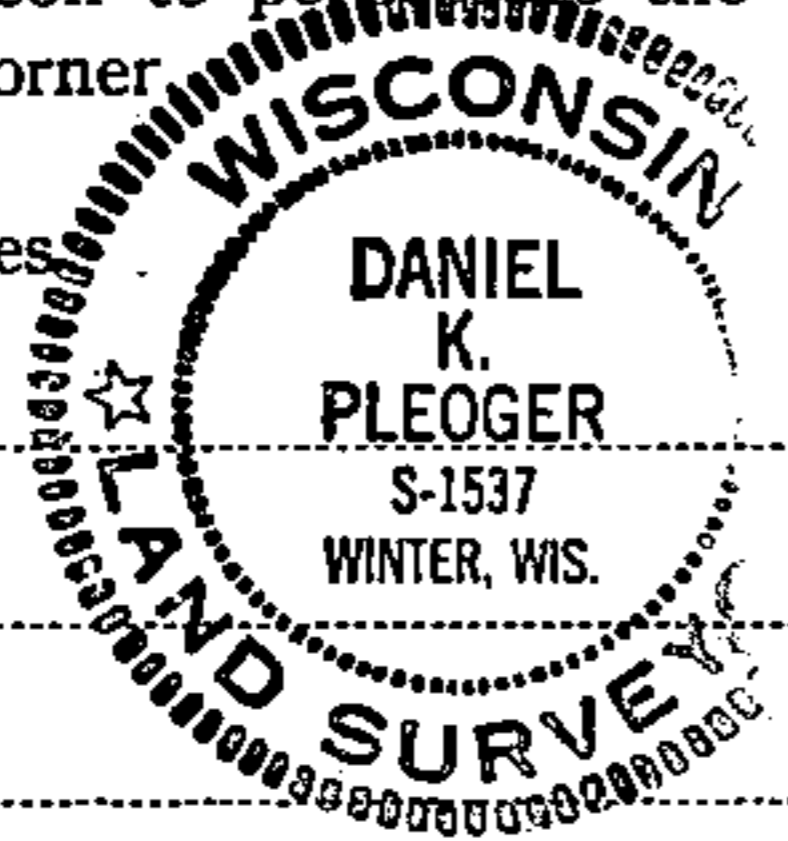

History of original corner establishment:  
No evidence of any previous corner.


Description of corner evidence found:  
Total distance from section corner 25, 36, 30, 31 T37N R14 & 15E to 1/4 corner between sections 36 & 31 T37N R14 & 15E is 2611.76 ft. of bearing S0-09-59E.  
Set N1/16 1305.88 ft. intermediate.

Description of monument and accessories I established to perpetuate the original location of this corner.

Set a 1 1/2" iron pipe with 2" diameter brass cap stamped:  
Monument projects 18" above ground.  
Marked NBTs  
Cedar 6" S47E 24.0 ft.  
Maple 7" N38E 36.05 ft.  
Scribed 1/16 - B.T.

S1537  
T37N  
R14E R15E  
N1/16 36 | 31  
CPI - 1981

FORM 985 H. E. MILLER CO., MILWAUKEE

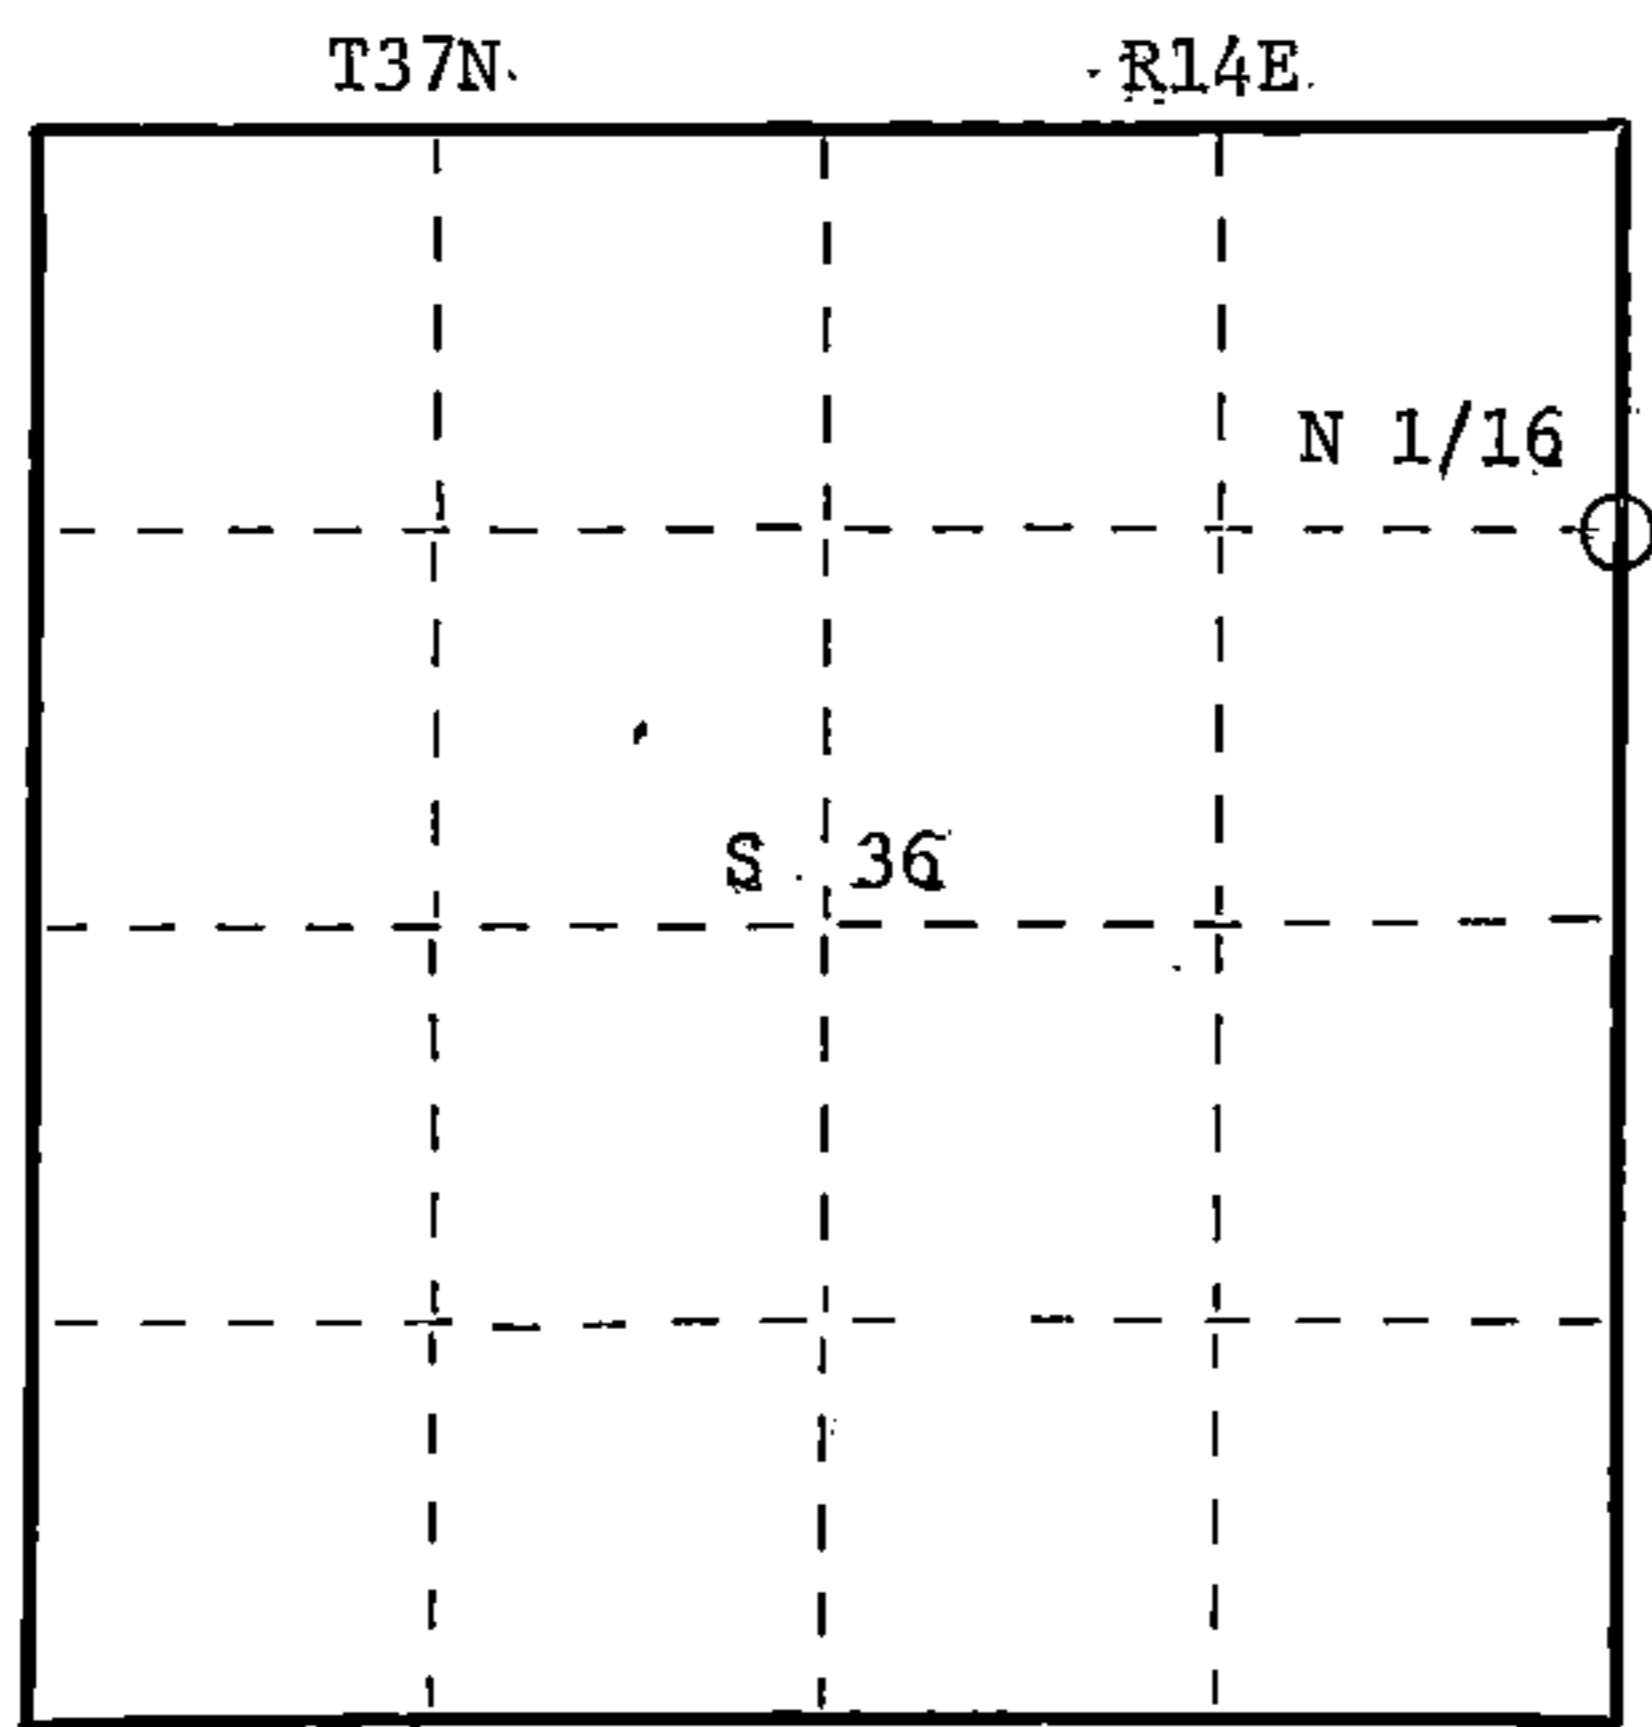

○ = Corner monument restored.

Dated at Rhinelander, Wis., this 4th day of November, 19 81

Signature Daniel K. Plegger Title Registered Land Surveyor Registration No. 1537  
(County Surveyor, Registered Land Surveyor, or other duly authorized official)

Office of Register of Deeds, County of Forest, I hereby certify that the within instrument was filed in this office for record on the 19th day of January, 19 82 at 3:00 o'clock P. M.

Eugene Staszny  
(Register of Deeds)

DOCUMENT NO. 121095

By Deputy

43714303000