


# U. S. PUBLIC LAND SURVEY MONUMENT RECORD

**INSTRUCTIONS:** This record shall show the location of the corner and shall include all of the following nine elements (a through i).

(a) Identify the corner by reference to the U.S. public land survey system.

○ = Corner monument restored.

Section corner to Sections 2, 3, 10, and 11,  
T.37N., R.15E.

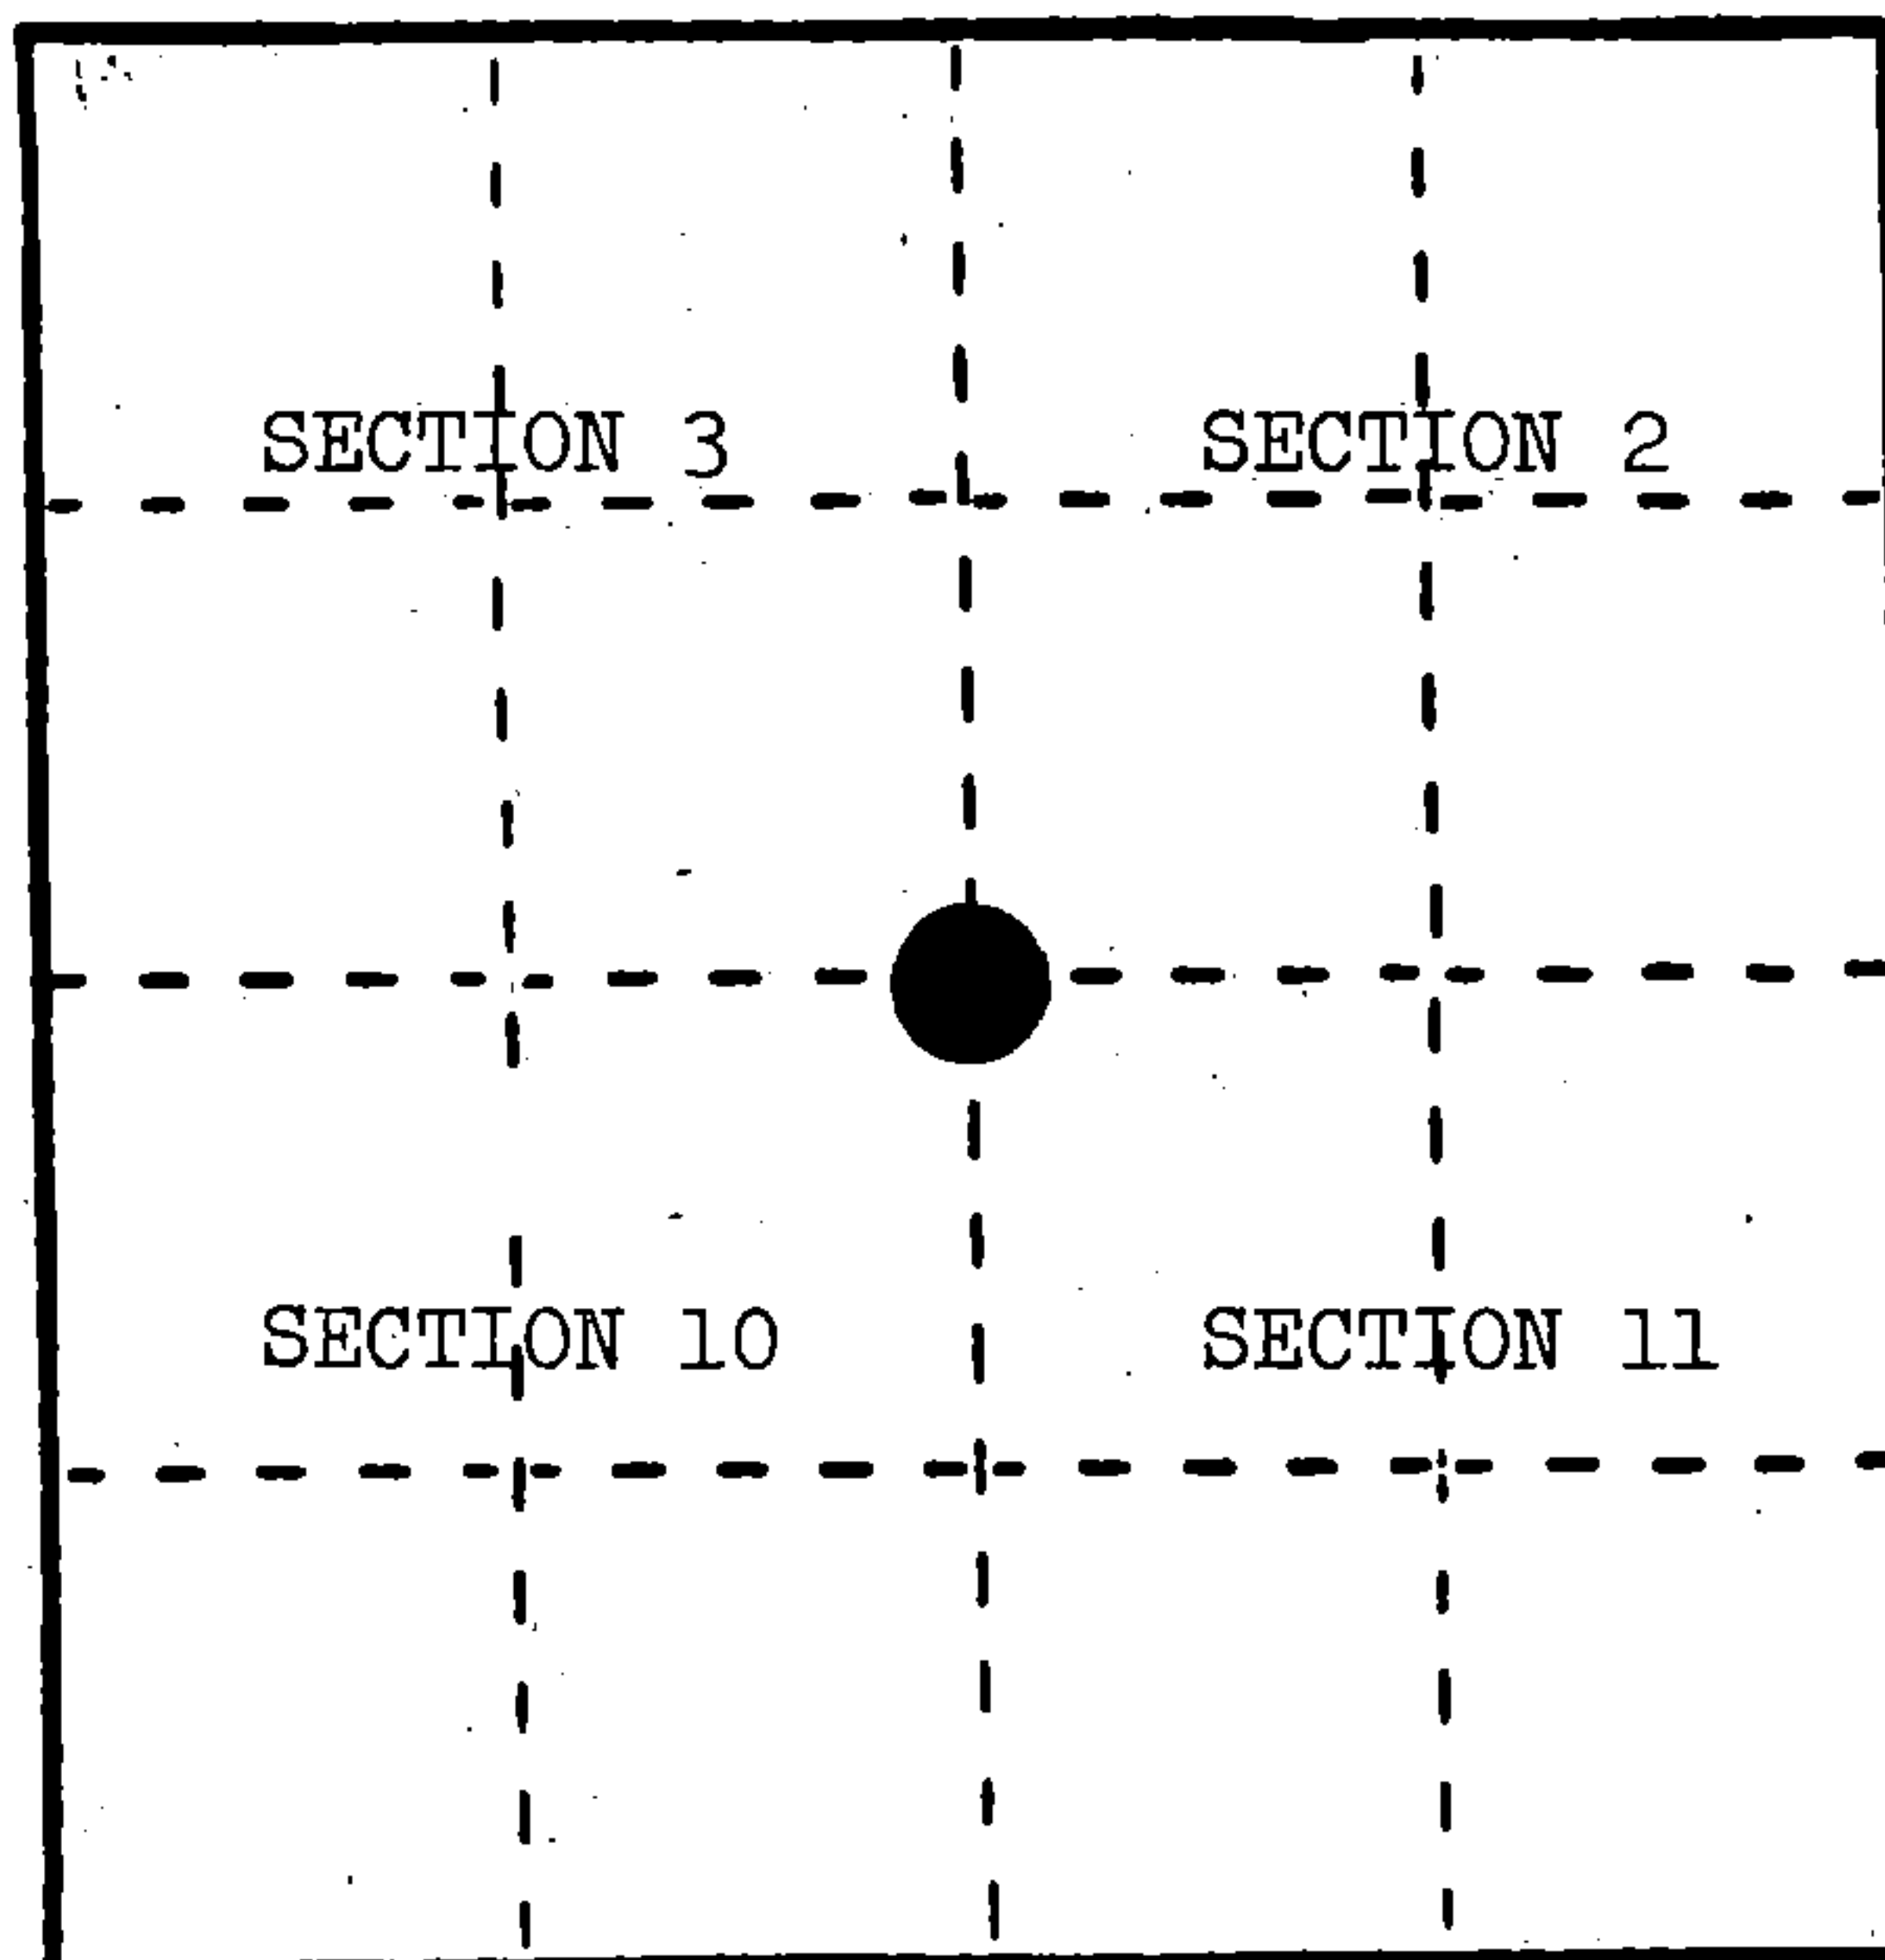

(b) Describe any record evidence, monument evidence, occupational evidence, testimonial evidence or any other material evidence you considered, and whether the monument was found or placed.

In August, 1865, J. L. Nowlin set post with the following BTs: Sugar, 12", N.77°E., 7 links; Sugar, 7" S.35°W., 30 links.


August, 1938, Falleck (CCCs) found corner, no indication of what he found.

November 30, 1984, Alan Harrison found 1" iron pipe and 1938 plantation post dated 9-38, 1 month after Falleck was there. Iron pipe is driven in discolored soil; most likely old post point. No sign of original BTs--corner is in plantation.

(c) In the plan view drawing below, provide reference ties to at least 4 witness monuments, or, if the location is within a municipality, to at least 2 witness monuments. (Witness monuments shall be made of concrete, natural stone, iron or other equally durable material.) Describe witness monuments.

(d) Show a plan view drawing depicting the relevant monuments and reference ties which is sufficient in detail to enable accurate relocation of the corner monument if the corner monument is disturbed. Indicate north.

1. 2" x 30" aluminum monument stamped to identify the corner.
2. Red Pine, 12", N.64°E., 21.26'
3. Red Pine, 12", S.43°E., 20.17'
4. Red Pine, 11", S.53°W., 34.08'
5. Red Pine, 12", N.65°W., 24.80'
6. Steel Sign Post, East, 1.05'

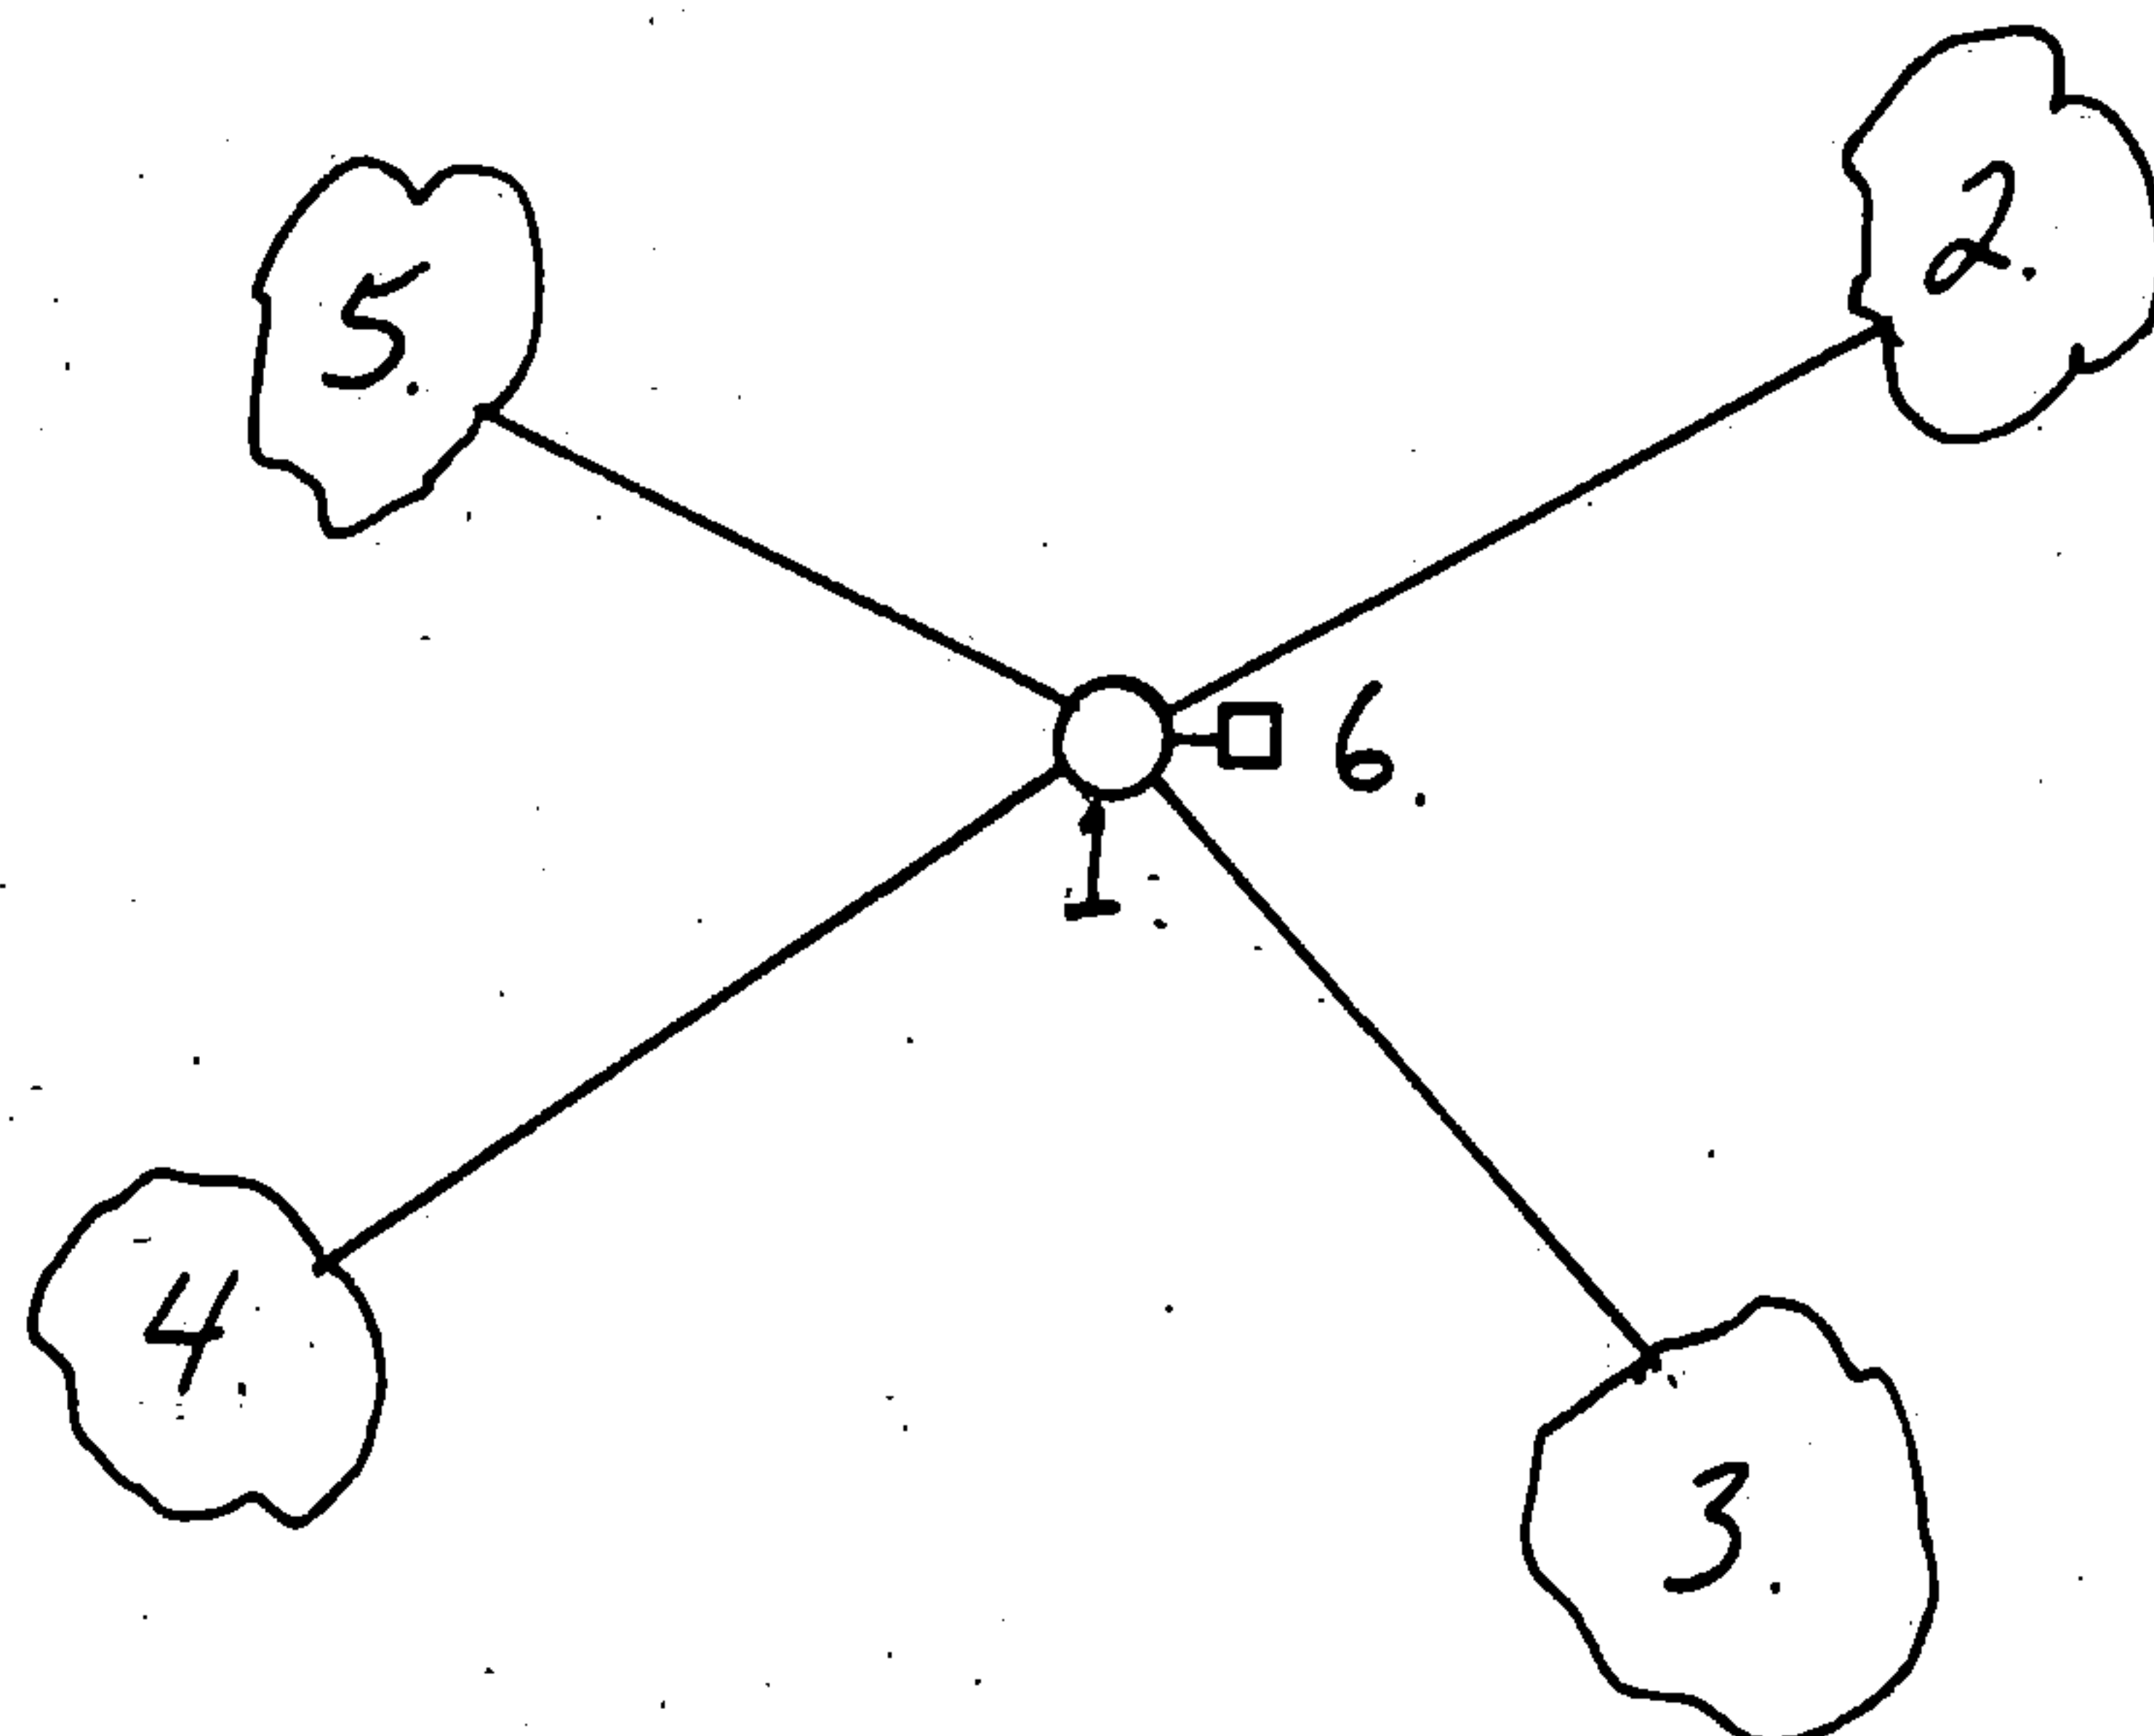

REGISTER'S OFFICE }  
Forest County, Wis. }

Received for record this... 23rd day  
of January... A.D., 1985 at  
9:00 o'clock... A.M. and  
recorded in Vol. CORNER RESTORATIONS  
on page 517  
Paul Aschenbreuner  
REGISTER

(e) Describe any material discrepancy between the location of the corner as restored or reestablished and the location of that corner as previously restored or reestablished by distance and direction. Show the discrepancy on the plan view drawing under (d), above. Show the distances between the corner as previously restored or reestablished and (1) the corner as restored or reestablished, and (2) to at least 2 of the witness monuments shown on the drawing in (d), above.


None.

(f) Was the corner restored through acceptance of (1) an obliterated evidence location, or, (2) a found perpetuated location?

(2) a found perpetuated location.

(g&h) Was the corner reestablished through lost corner proportionate methods? If so, show the method, including the directions and distances to other public land survey corners used as evidence or used for proportioning in determining the corner location?

No.

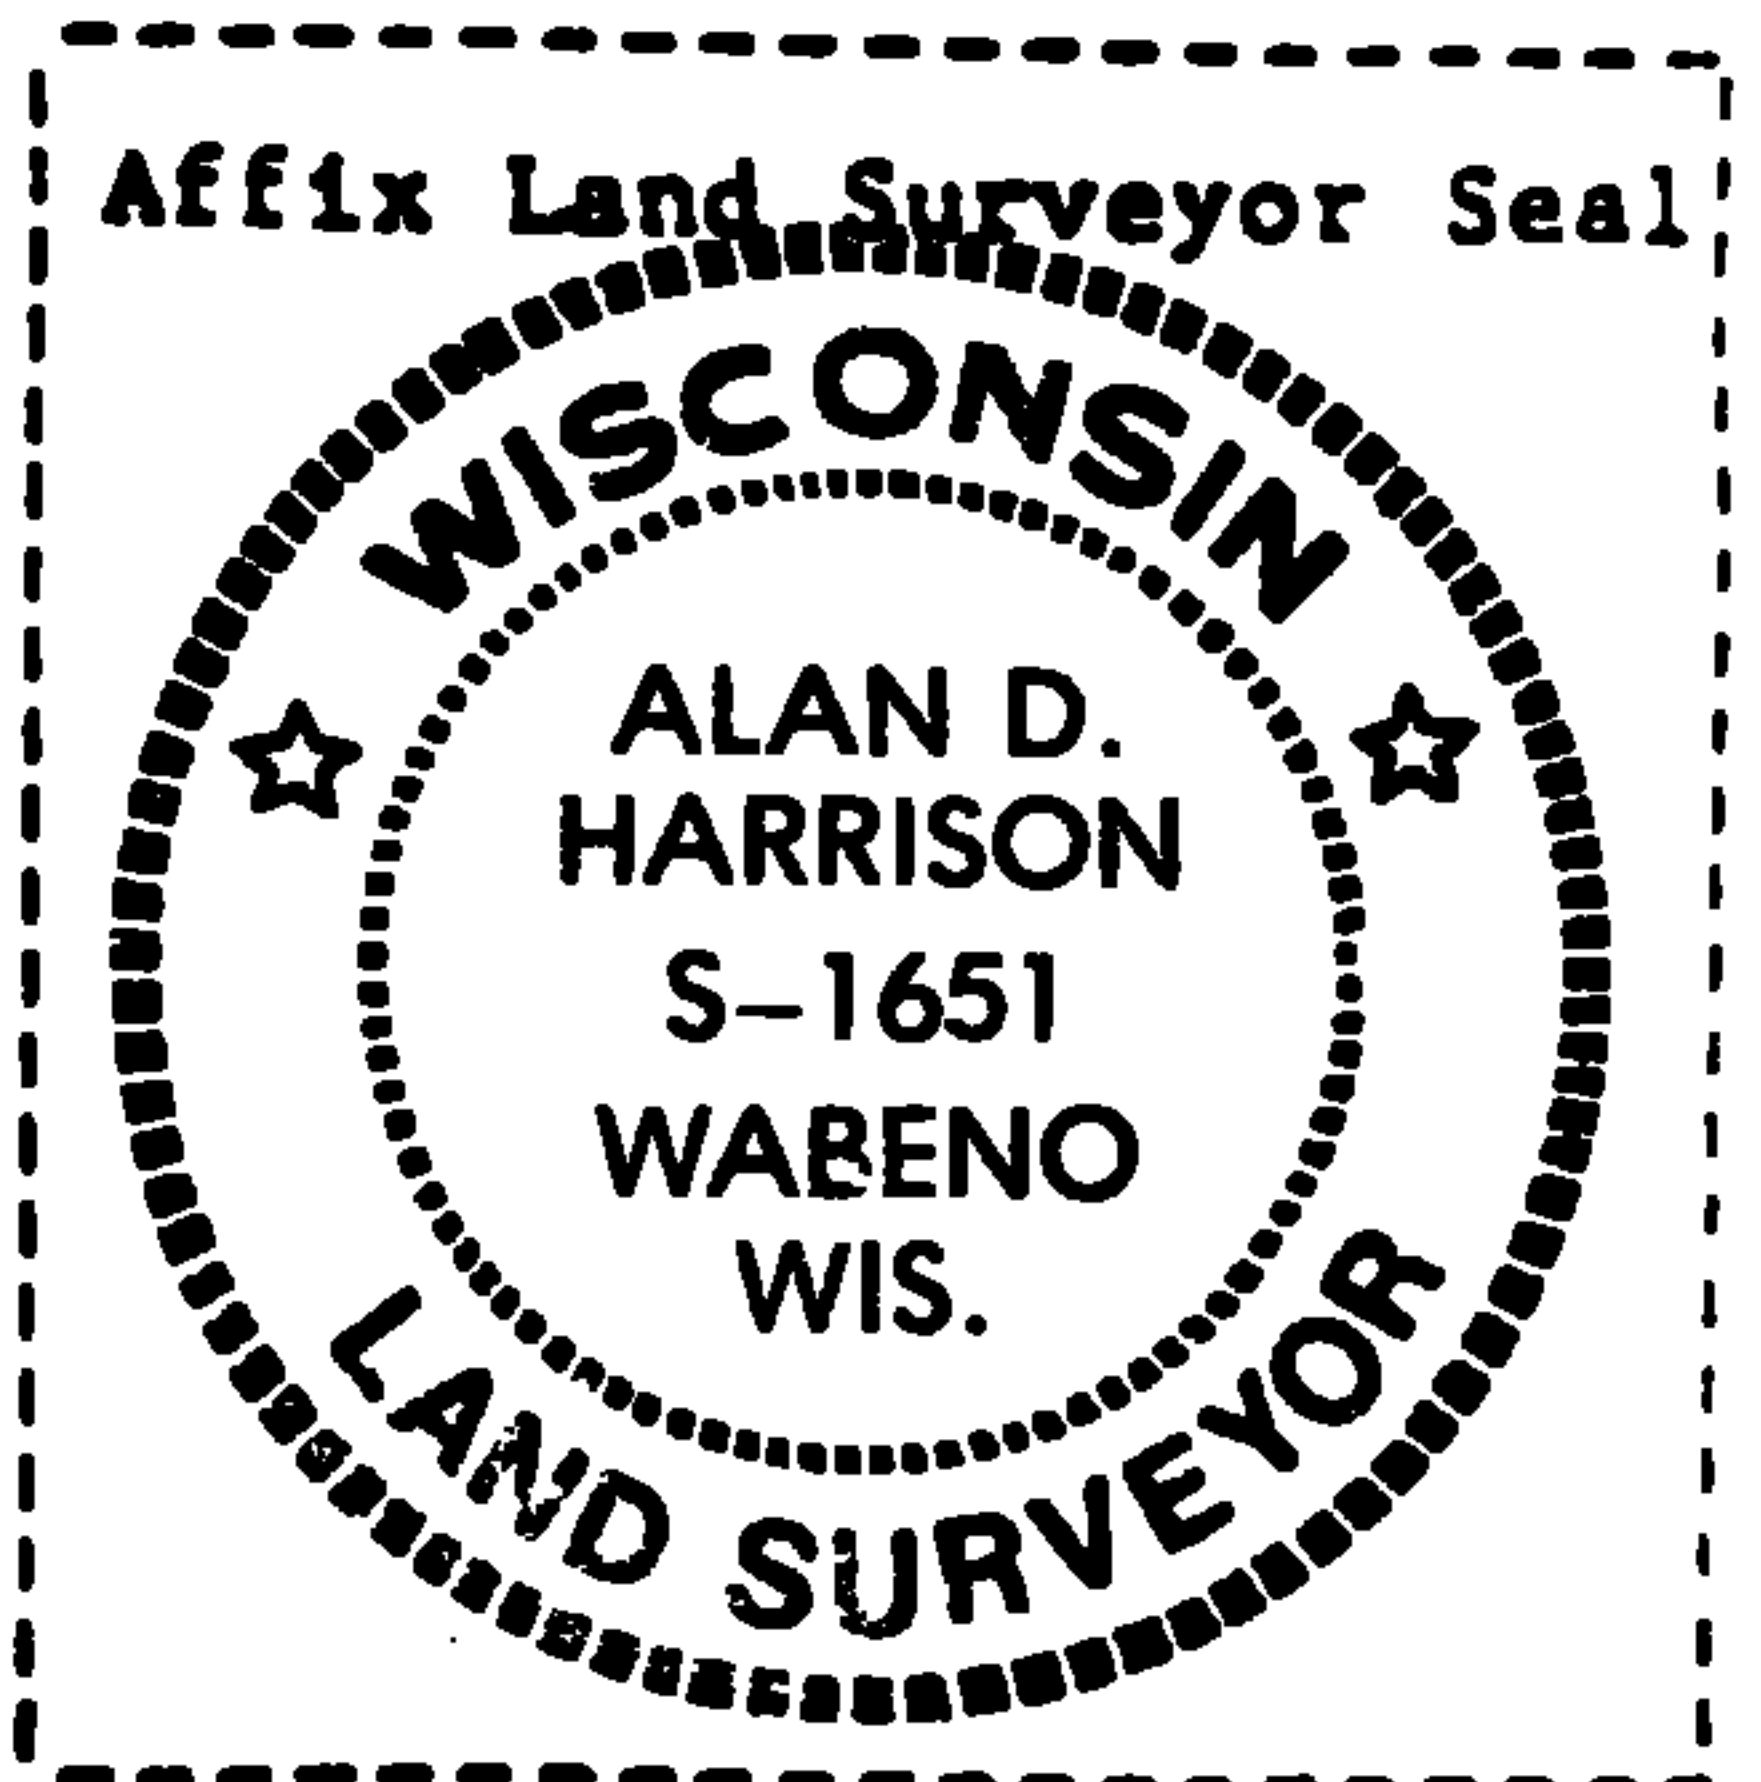

(i) I, Alan D. Harrison  
(type or print name) certify that the corner location shown  
on this record was determined by me or under my direction and  
control and that this U.S. Public Land Survey Monument Record is  
correct and complete to the best of my knowledge and belief.

Alan D. Harrison 12/14/84  
Signature Date