

CERTIFIED LAND CORNER RESTORATION


Index No. **J-111**

State of Wisconsin }
Forest } ss.
County of _____


I Daniel K. Pleoger, do hereby
certify that on the 22 day
of October, 19 81, I ~~found~~

Established the Quarter
corner of Sections 9, 16
Township 37, North, Range
15 East, Fourth Principal Meridian,
as described hereon; and that from this evidence
I established a new monument and accessories
as described hereon to perpetuate the original
location of this corner.

Resident witnesses:

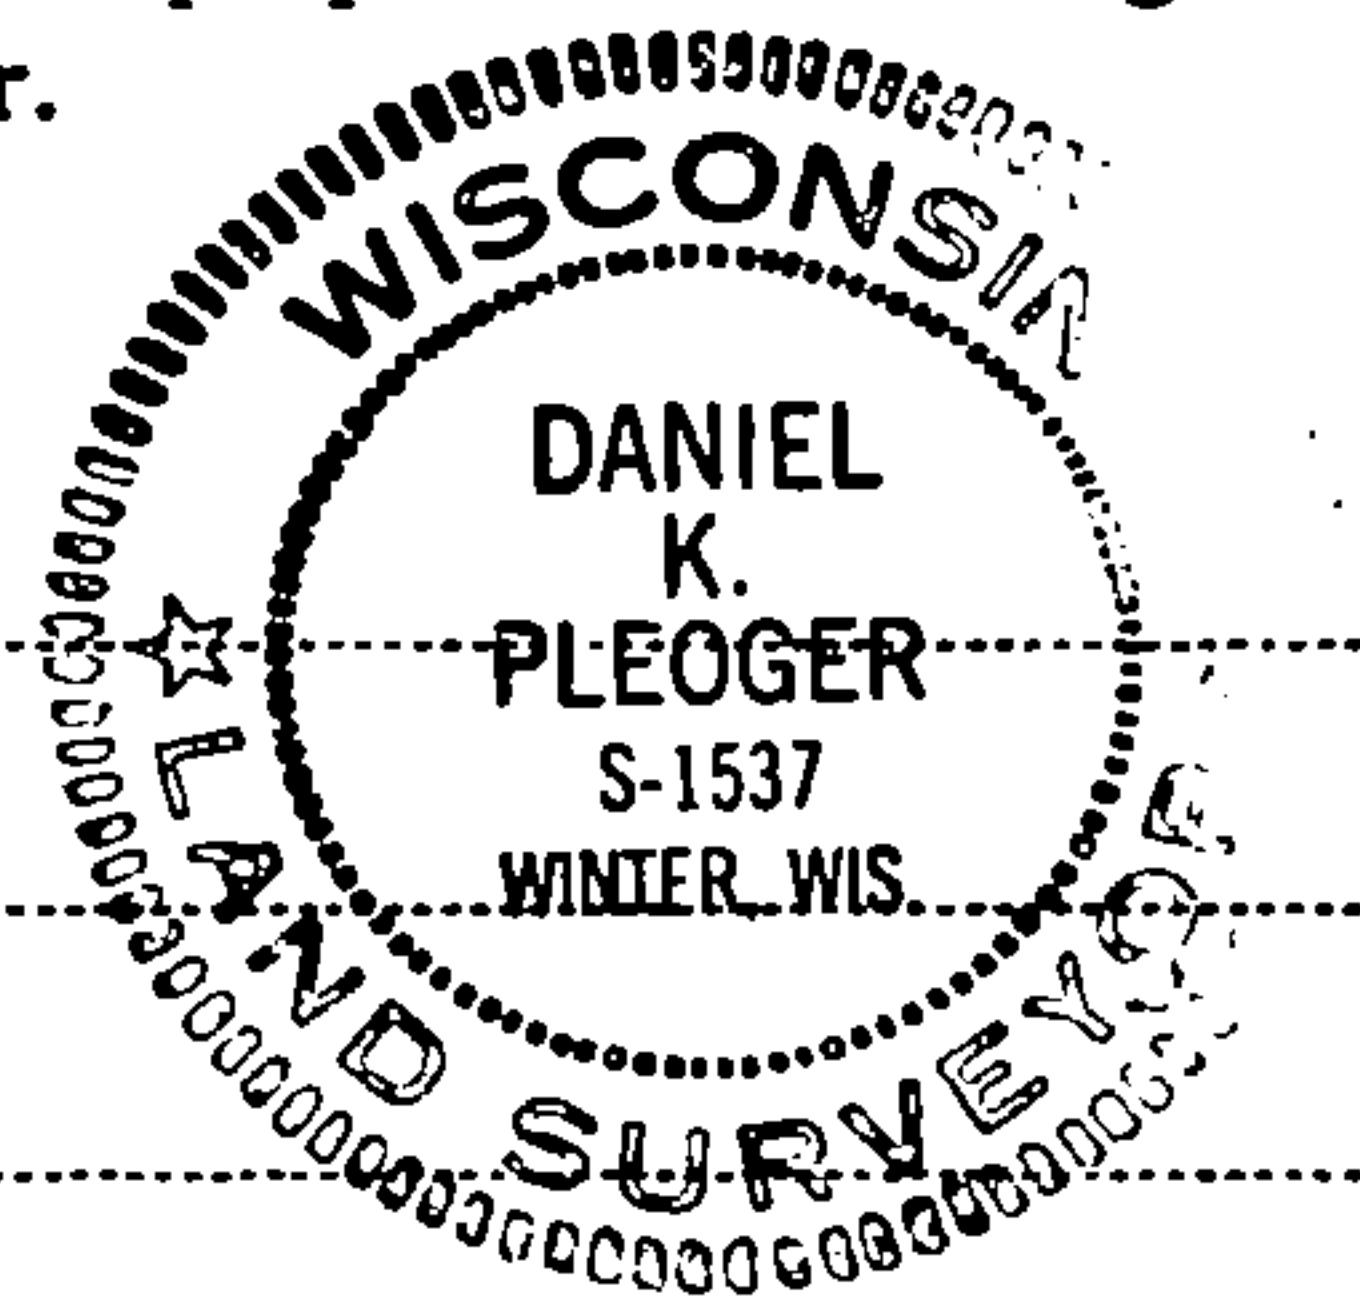

FORM 985 H. C. MILLER CO., MILWAUKEE

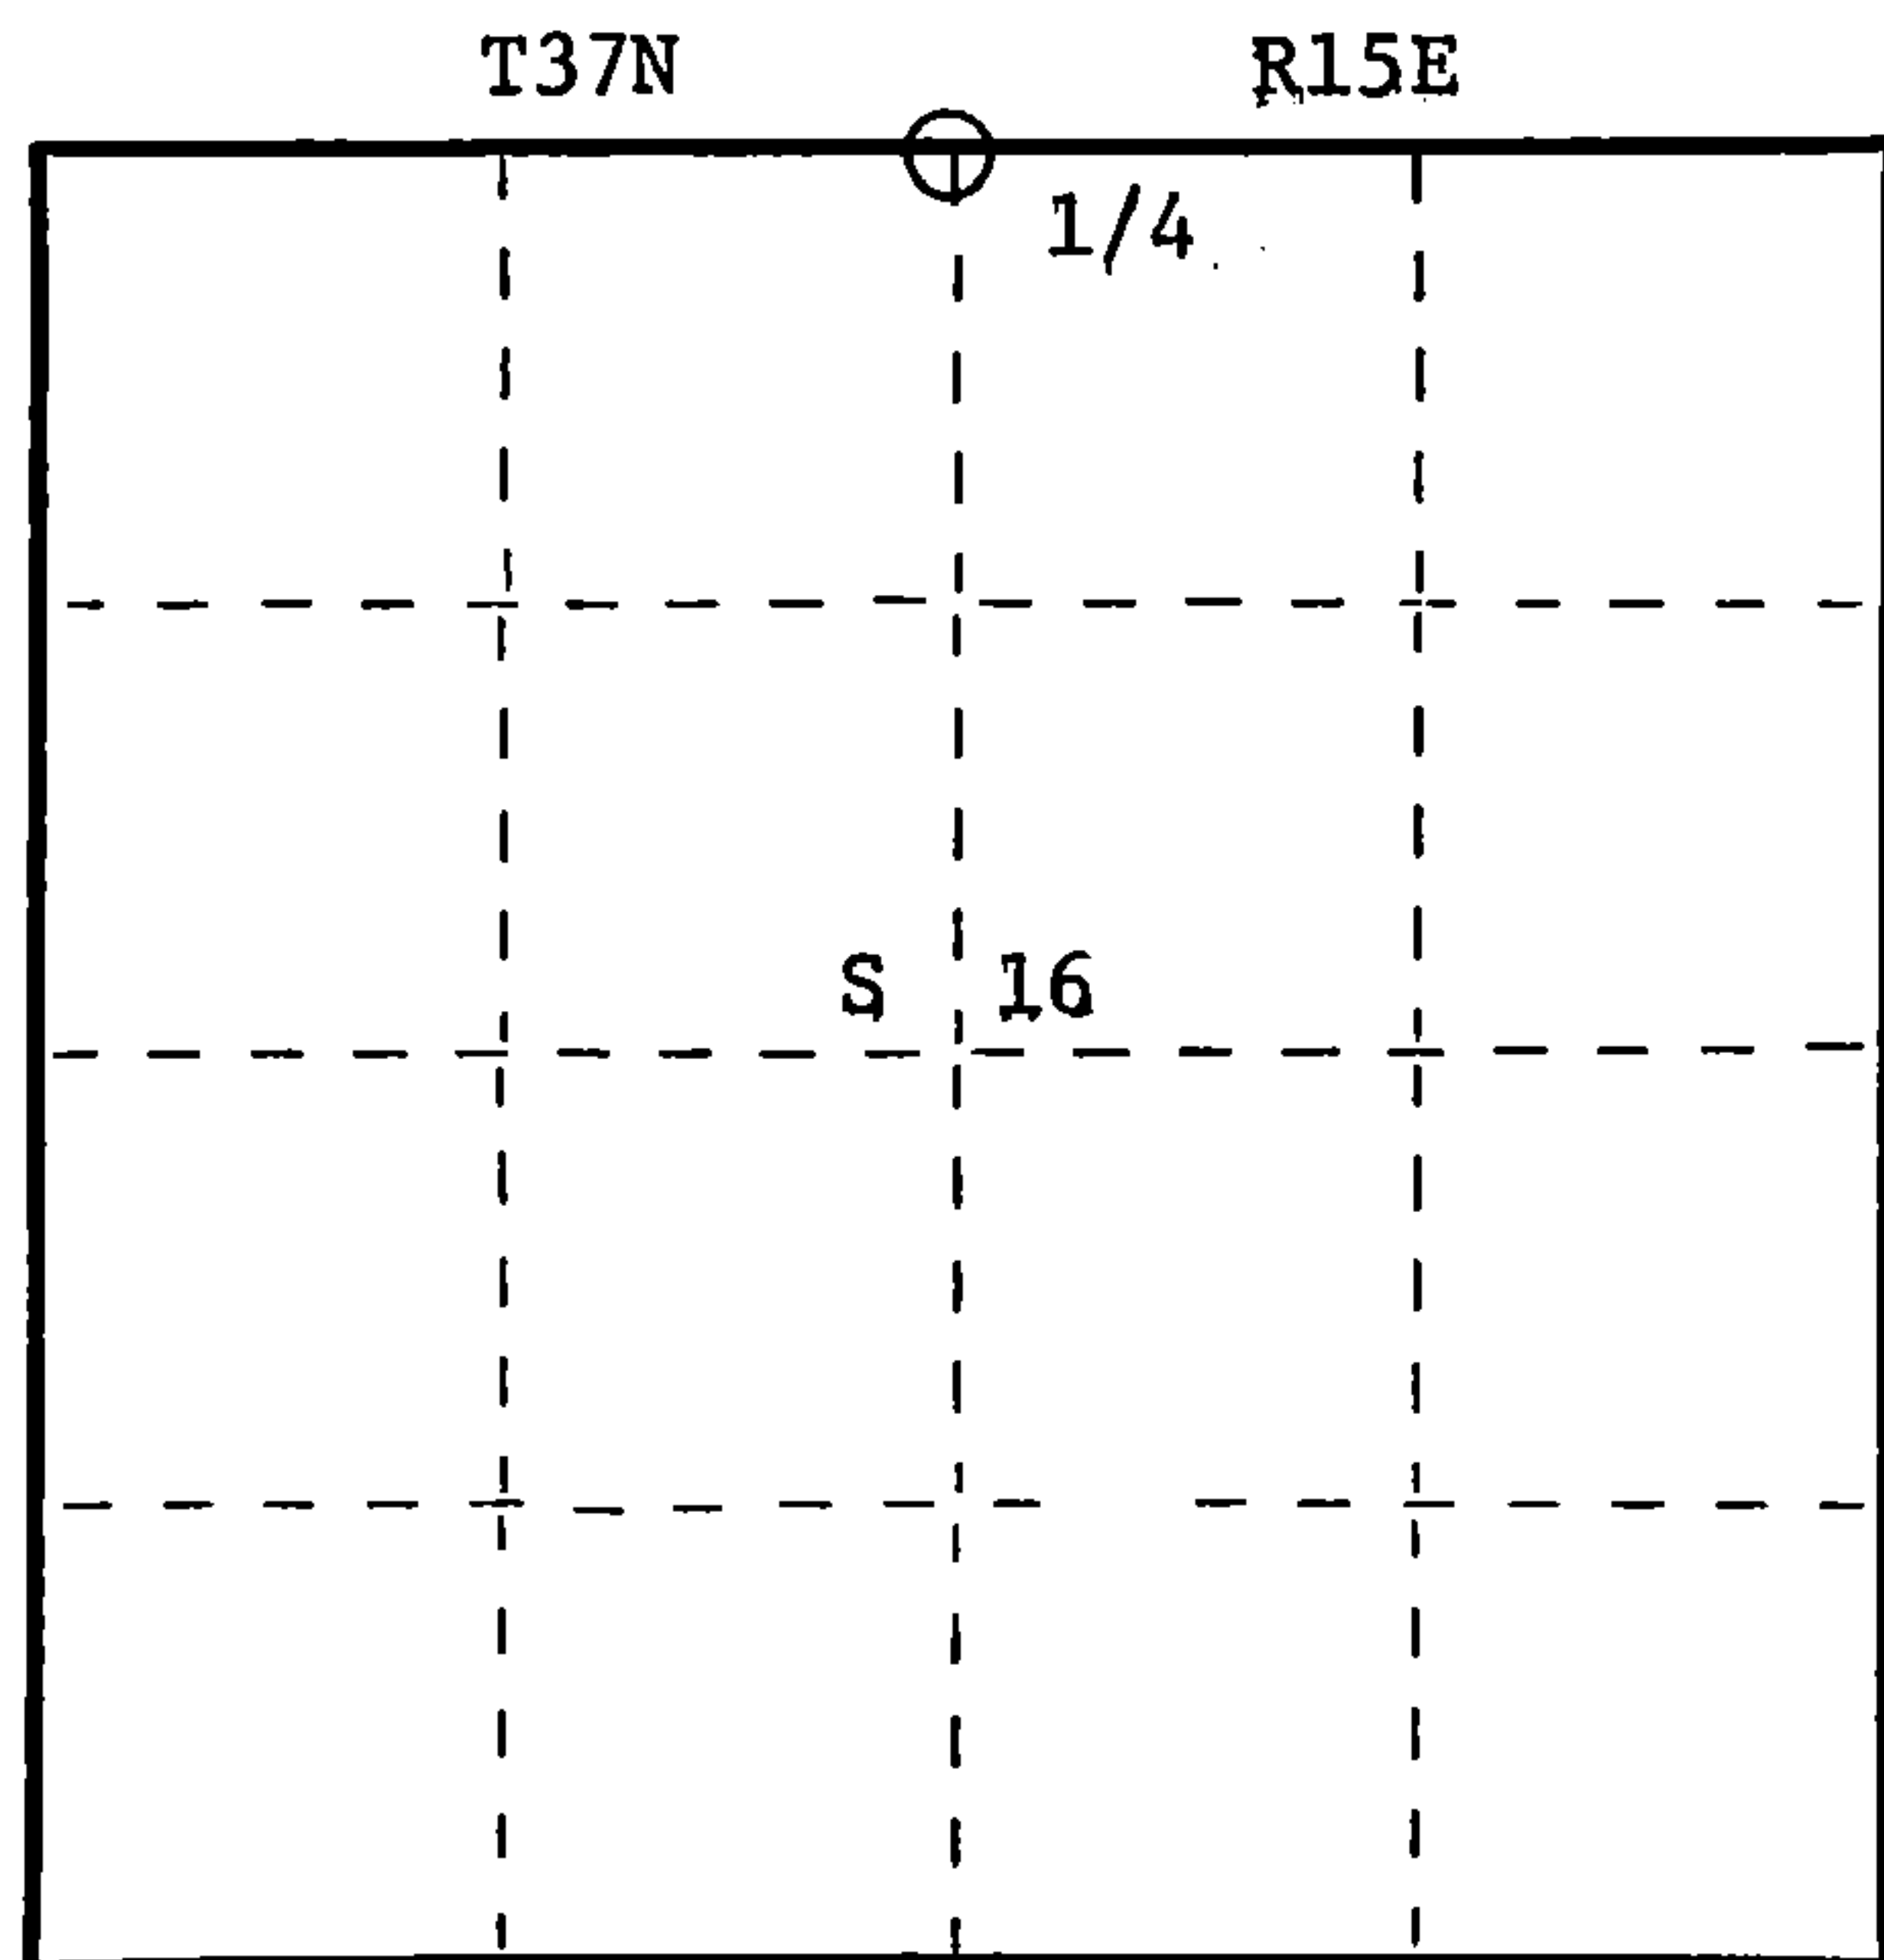

○ = Corner monument restored.

History of original corner establishment:

Original corner established by James L. Nowlin, Gov. Deputy Surveyor in 1865 from
which sugar 12" bear N41W 8 lks and sugar 12" bears S21W 35 lks.

Description of corner evidence found:

Total distance from section corner 9, 10, 15, 16 to section corner 8, 9, 16, 17 is
5153.894 ft. at bearing S87-34-03E.
Set 1/4 corner 2576.947 ft. intermediate.

Description of monument and accessories I established to perpetuate the original location of this corner.
Set a 2½" aluminum A-1 federal monument with alloy cap stamped:

Monument projects 8" above ground
Marked NBTs:

Sugar 6" S18E 26.74 ft.
Sugar 5" S56W 21.27 ft.
Sugar 6" N53W 30.75 ft.
Scribed 1/4 - BT

T37N R15E

1/4

S	9
S	16

S1537 - 1981

Dated at Rhinelanders, Wis., this 12th day of November, 1981

Signature Daniel K. Pleoger Title Registered Land Surveyor Registration No. 1537
(County Surveyor, Registered Land Surveyor, or other duly authorized official)

Office of Register of Deeds, County of Forest, I hereby certify that the within
instrument was filed in this office for record on the 9th day of April, 19 82
at 11:00 o'clock A. M.

DOCUMENT NO. **121394**
(Register of Deeds)

By _____ Deputy

43715090020