

CERTIFIED LAND CORNER RESTORATION

State of Wisconsin

County of Forest

SS.

I Jean F. Resvick, do hereby certify that on the 1st day of August, 1972, I found evidence of the Southwest Section corner of Section 12 Township 37 North, Range 15 East, Fourth Principal Meridian, as described hereon; and that from this evidence I established a new monument and accessories as described hereon to perpetuate the original location of this corner:

Description of original monument and accessories and subsequent restorations:

Surveyed in 1856 by J.L. Nowlin. North between sections 13 and 14, 80.0 chains set post for corner to sections 11, 12, 13 and 14. Tamarack, 7", N53W, 8 lks. Tamarack, 14". S42E, 30 lks.



Description of corner evidence found:

6"x6" Scribed cedar post from the post a Tamarack stump bears N53W, 8 lks. a Tamarack snag, 16", bears S42E, 30 lks. scribing visible. Cedar, 16" bears S47E 31 lks. scribed and Cedar 14", bears S83W, 16 links scribed. These trees were scribed by an unknown surveyor.

Description of monument and accessories I established to perpetuate the original location of this corner:

I replaced the post found with a 2 inch. inside diam. galvanized wrought iron pipe, filled with concrete with a brass cap marked: From which the following accessories bear:

- Spruce, 7", N26E, 12.22 feet
Cedar, 6" S11E, 9.97 feet
Cedar, 5" S36W, 10.09 feet
Cedar, 8" N44W, 21.76 feet
Cedar 14" S53E, 20.12 feet, bearing tree found
Cedar, 11" S84W, 10.38 feet, bearing tree found
Steel sign post, 1.0 feet, NE of the monument

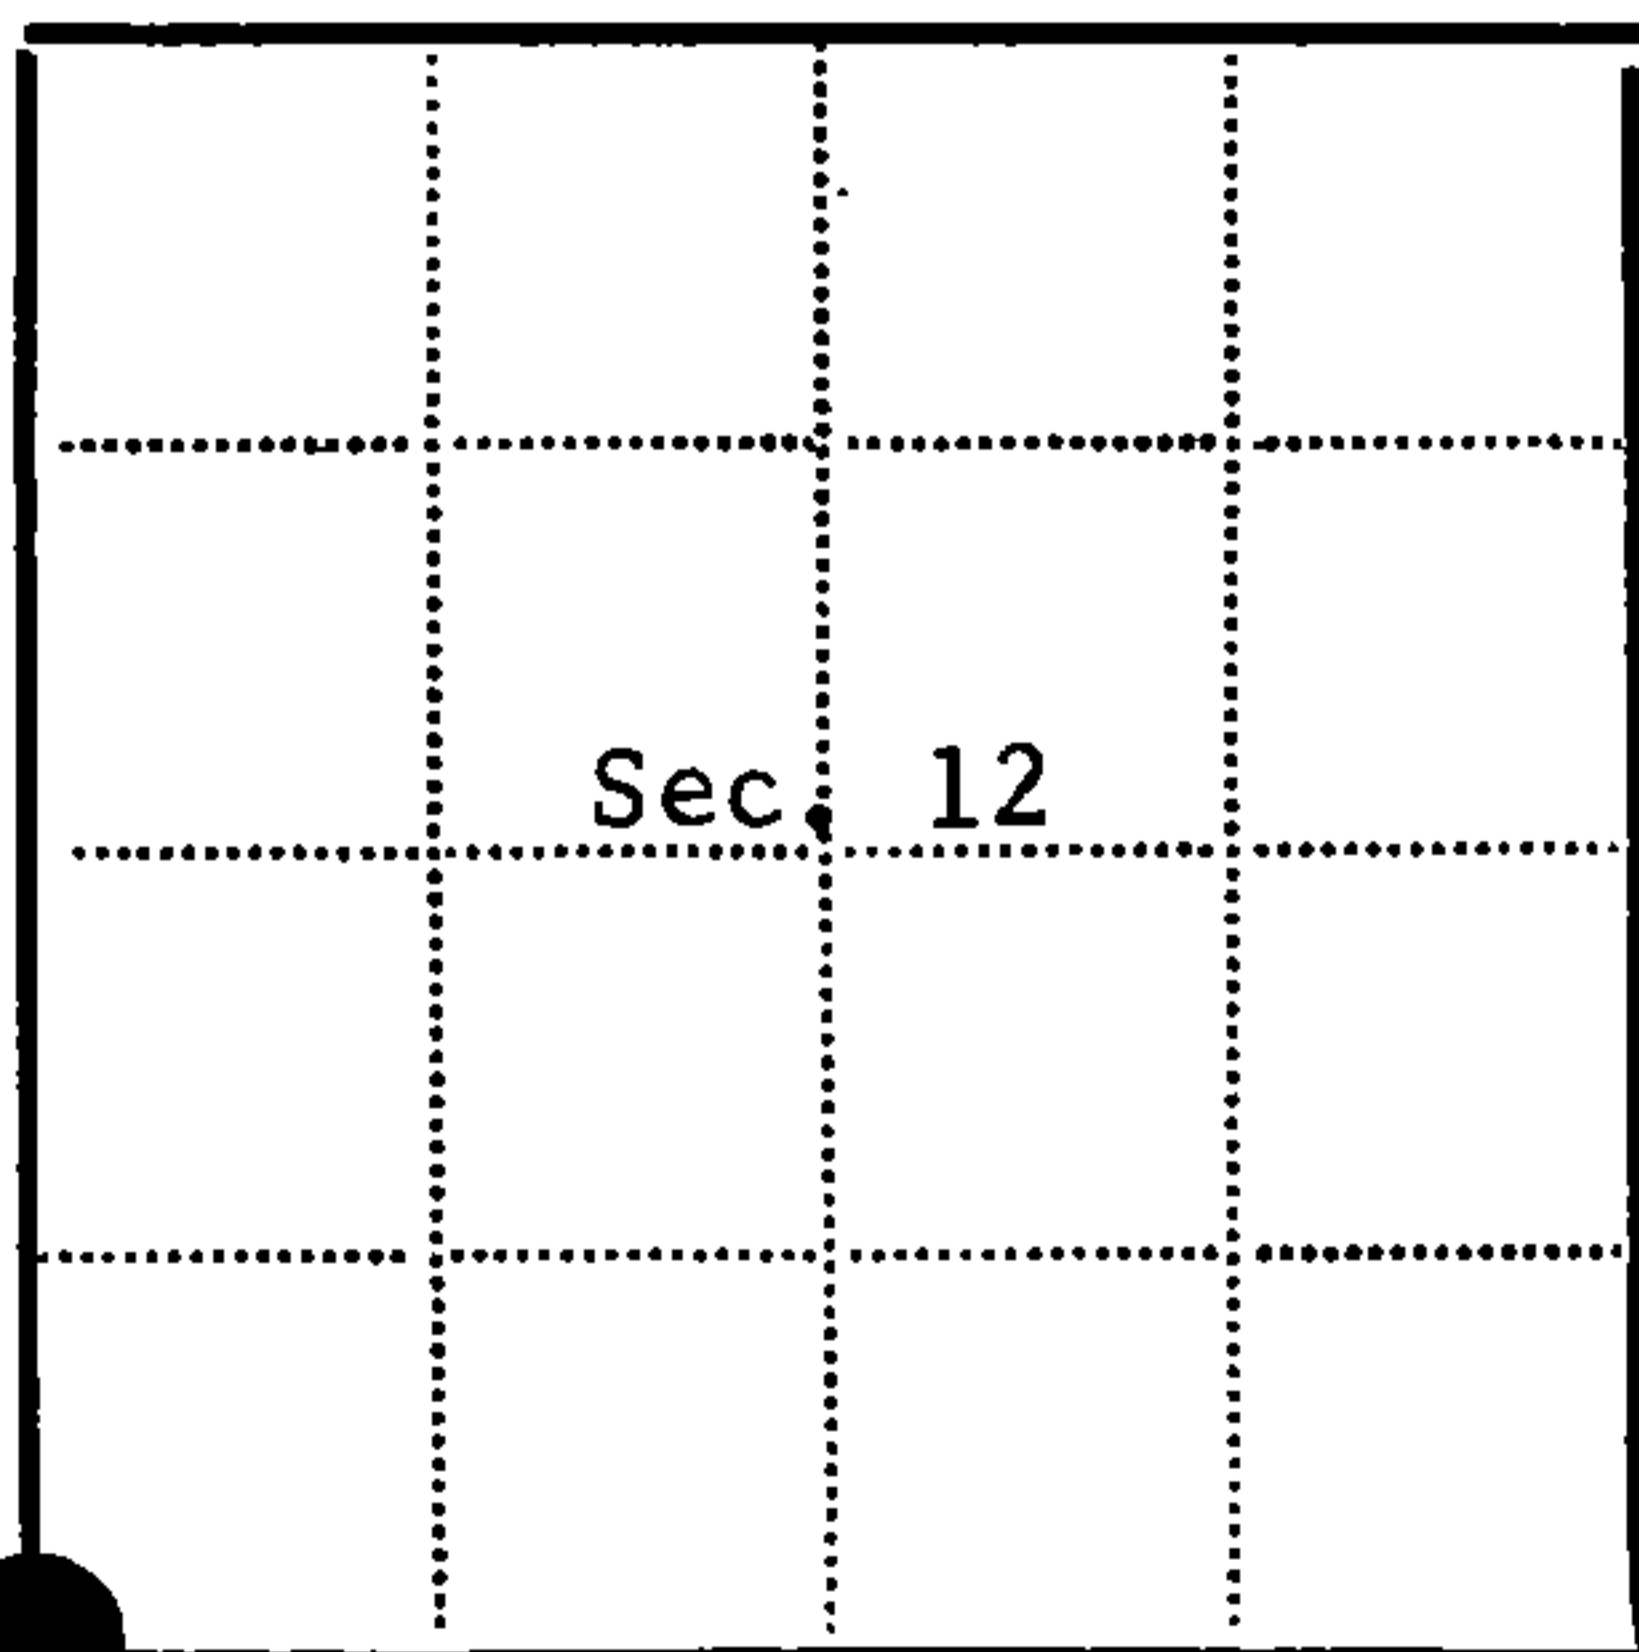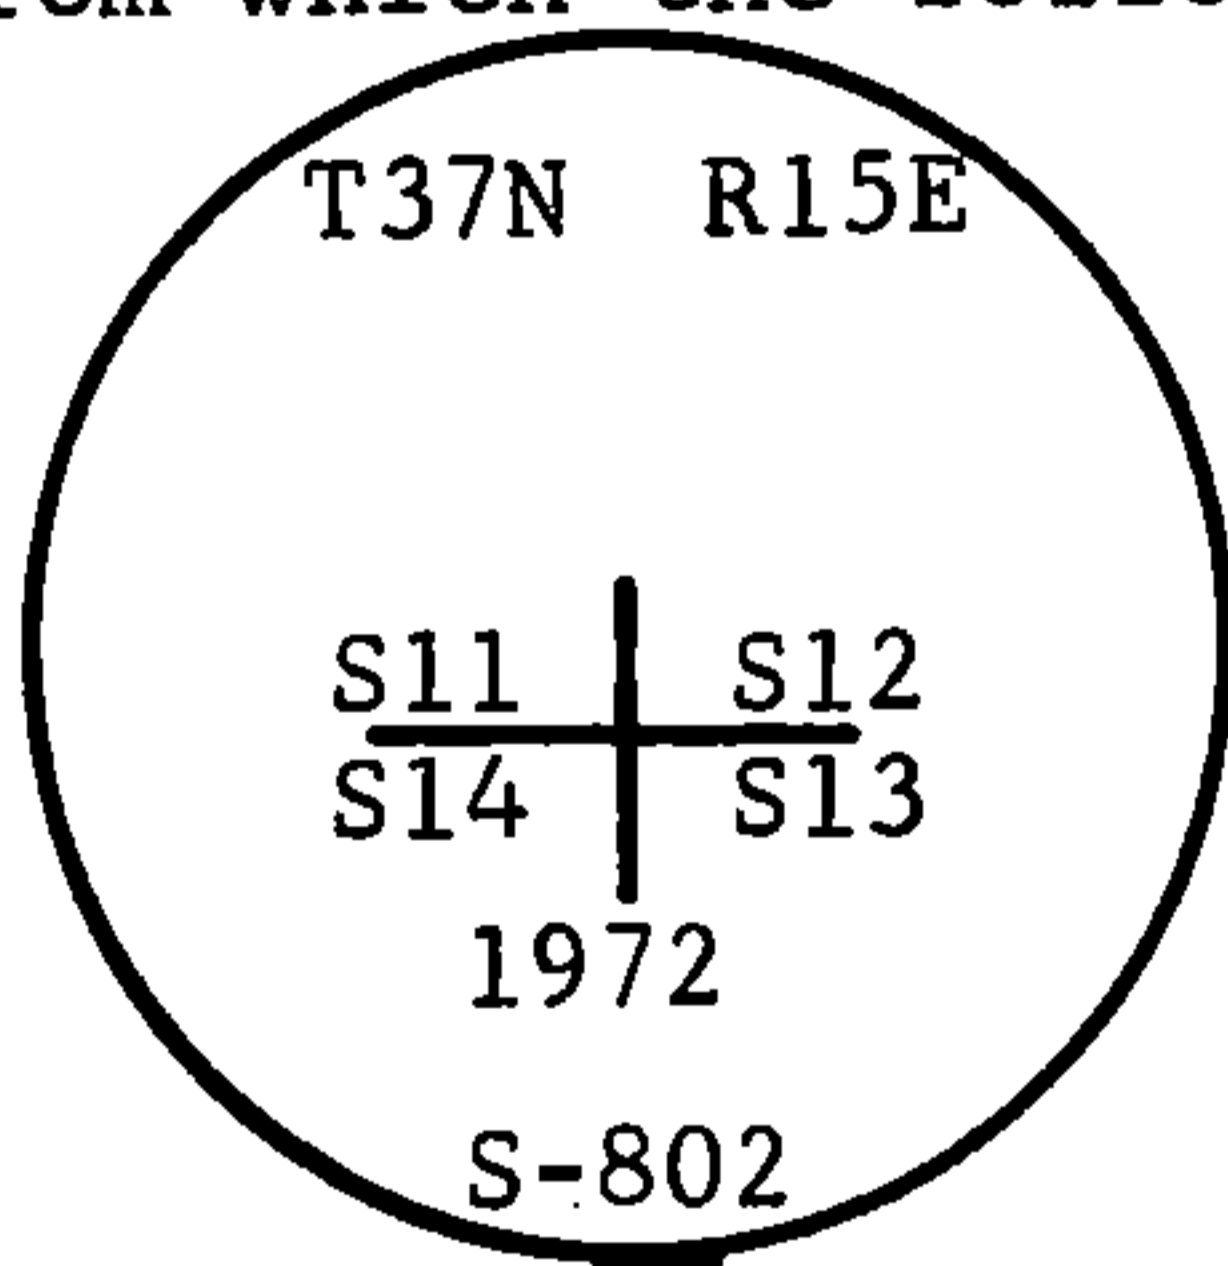

Legend: Circle with dot = Corner monument restored, Square =

Resident witnesses

Dated at Rhinelander Wisconsin, this 21st day of November 1972.

Signature Jean F. Resvick Title Cadastre Surveyor (County Surveyor, Registered Land Surveyor, or other duly authorized official)

Surveyors Registration No. S-802 DOCUMENT Number 102913

Office of Register of Deeds County of Forest

I hereby certify that the within instrument was filed in this office for record on the 15th day of February 1973, and was filed in Book No. Page No. of County Records.

Signature Eugene Stutzman Title Register of Deeds

Township 37 North, Range 15 East, Section 12, Index No. J-21, Page No.

