

CERTIFIED LAND CORNER RESTORATION

State of Wisconsin }
County of Forest } ss.

I Jean Resvick, do hereby certify that on the 6th day of June, 1968, I found evidence of the Northeast Section corner of Section 13 Township 37 North, Range 15 East, Fourth Principal Meridian, as described hereon; and that from this evidence I established a new monument and accessories as described hereon to perpetuate the original location of this corner:

Description of original monument and accessories and subsequent restorations:


Surveyed by Artemas Curtis 1857.
North between sections 13 and 18, 80.00 chains.
Set wood post for corner to sections 7, 12, 13, and 18.
Yellow Birch, 30 ins., S. 60° W., 37 lks.
Yellow Birch, 22 ins., N. 61° W., 37 lks.
Sugar, 18 ins., N. 21° E., 43 lks.
Sugar, 12 ins., S. 48° E., 69 lks.

Description of corner evidence found:


6 x 6 scribed post.
Stump hole, bears S. 60° W., 24.4 ft. from post found.
Sugar stump hole, bears N. 21° E., 28.4 ft. from post found.
Sugar stump, 20 ins., S. 48° E., 45.5 ft. from post found. 20 inch stump has a blaze with overgrowth. Stump was 12 ins. when blazed.
Yellow Birch that bears N. 61° W., 24.42 ft. falls in logging road.

Description of monument and accessories I established to perpetuate the original location of this corner:

Replace 6 x 6 wood post with a 6 inch diameter concrete monument 4 feet long, 42 inches in the ground with brass cap marked:

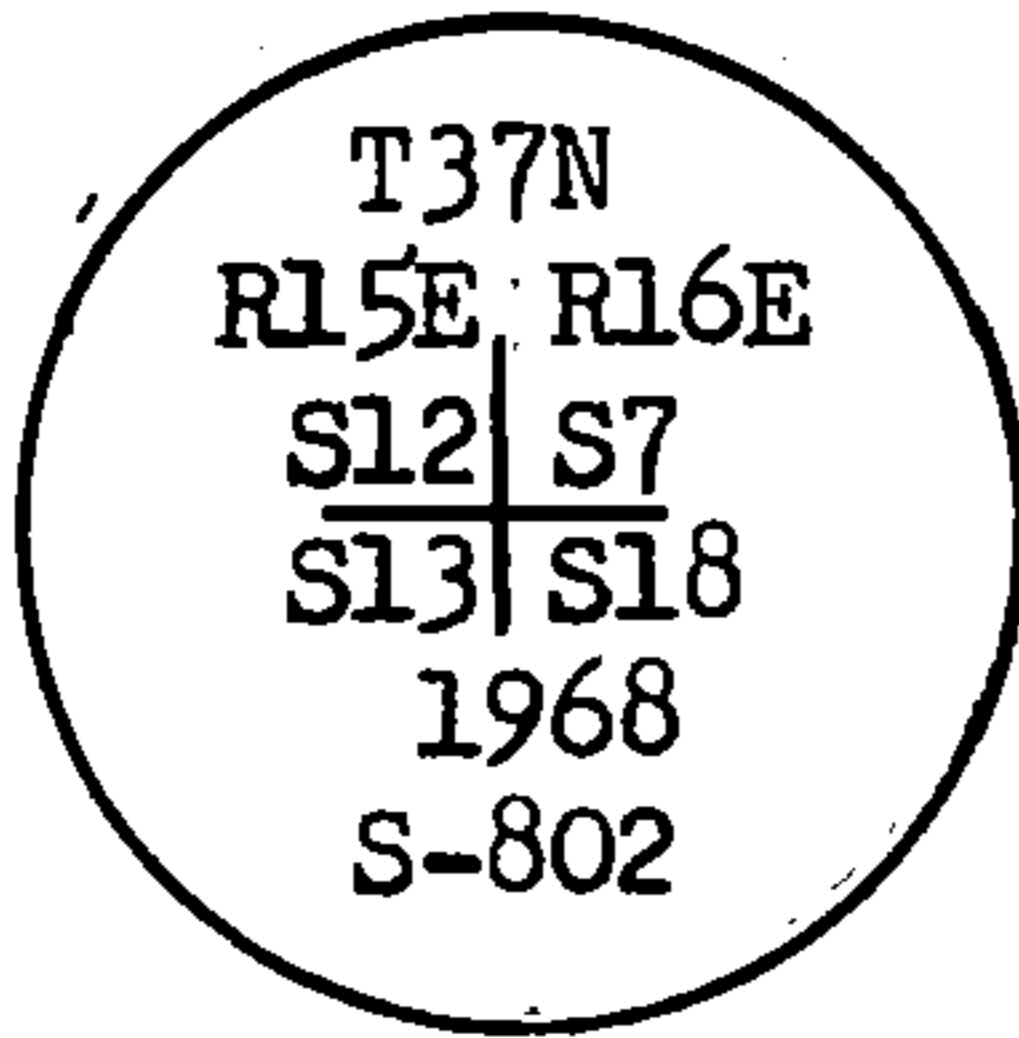

From which the following blazed and scribed new bearing trees bear:
Elm, 7 ins., N. 74° E., 11.31 feet or 17.14 lks.
Sugar, 11 ins., S. 37° E., 15.37 feet or 23.29 lks.
Elm, 8 ins., S. 74° W., 16.88 feet or 25.58 lks.
Elm, 8 ins., N. 54° W., 35.83 feet or 54.29 lks.
Center line of logging road bears N. 54° W., 27 feet or 40.91 lks.
4 x 4 cedar post 7 feet long, 3 feet inground bears N. 45° W., 1.50 feet.

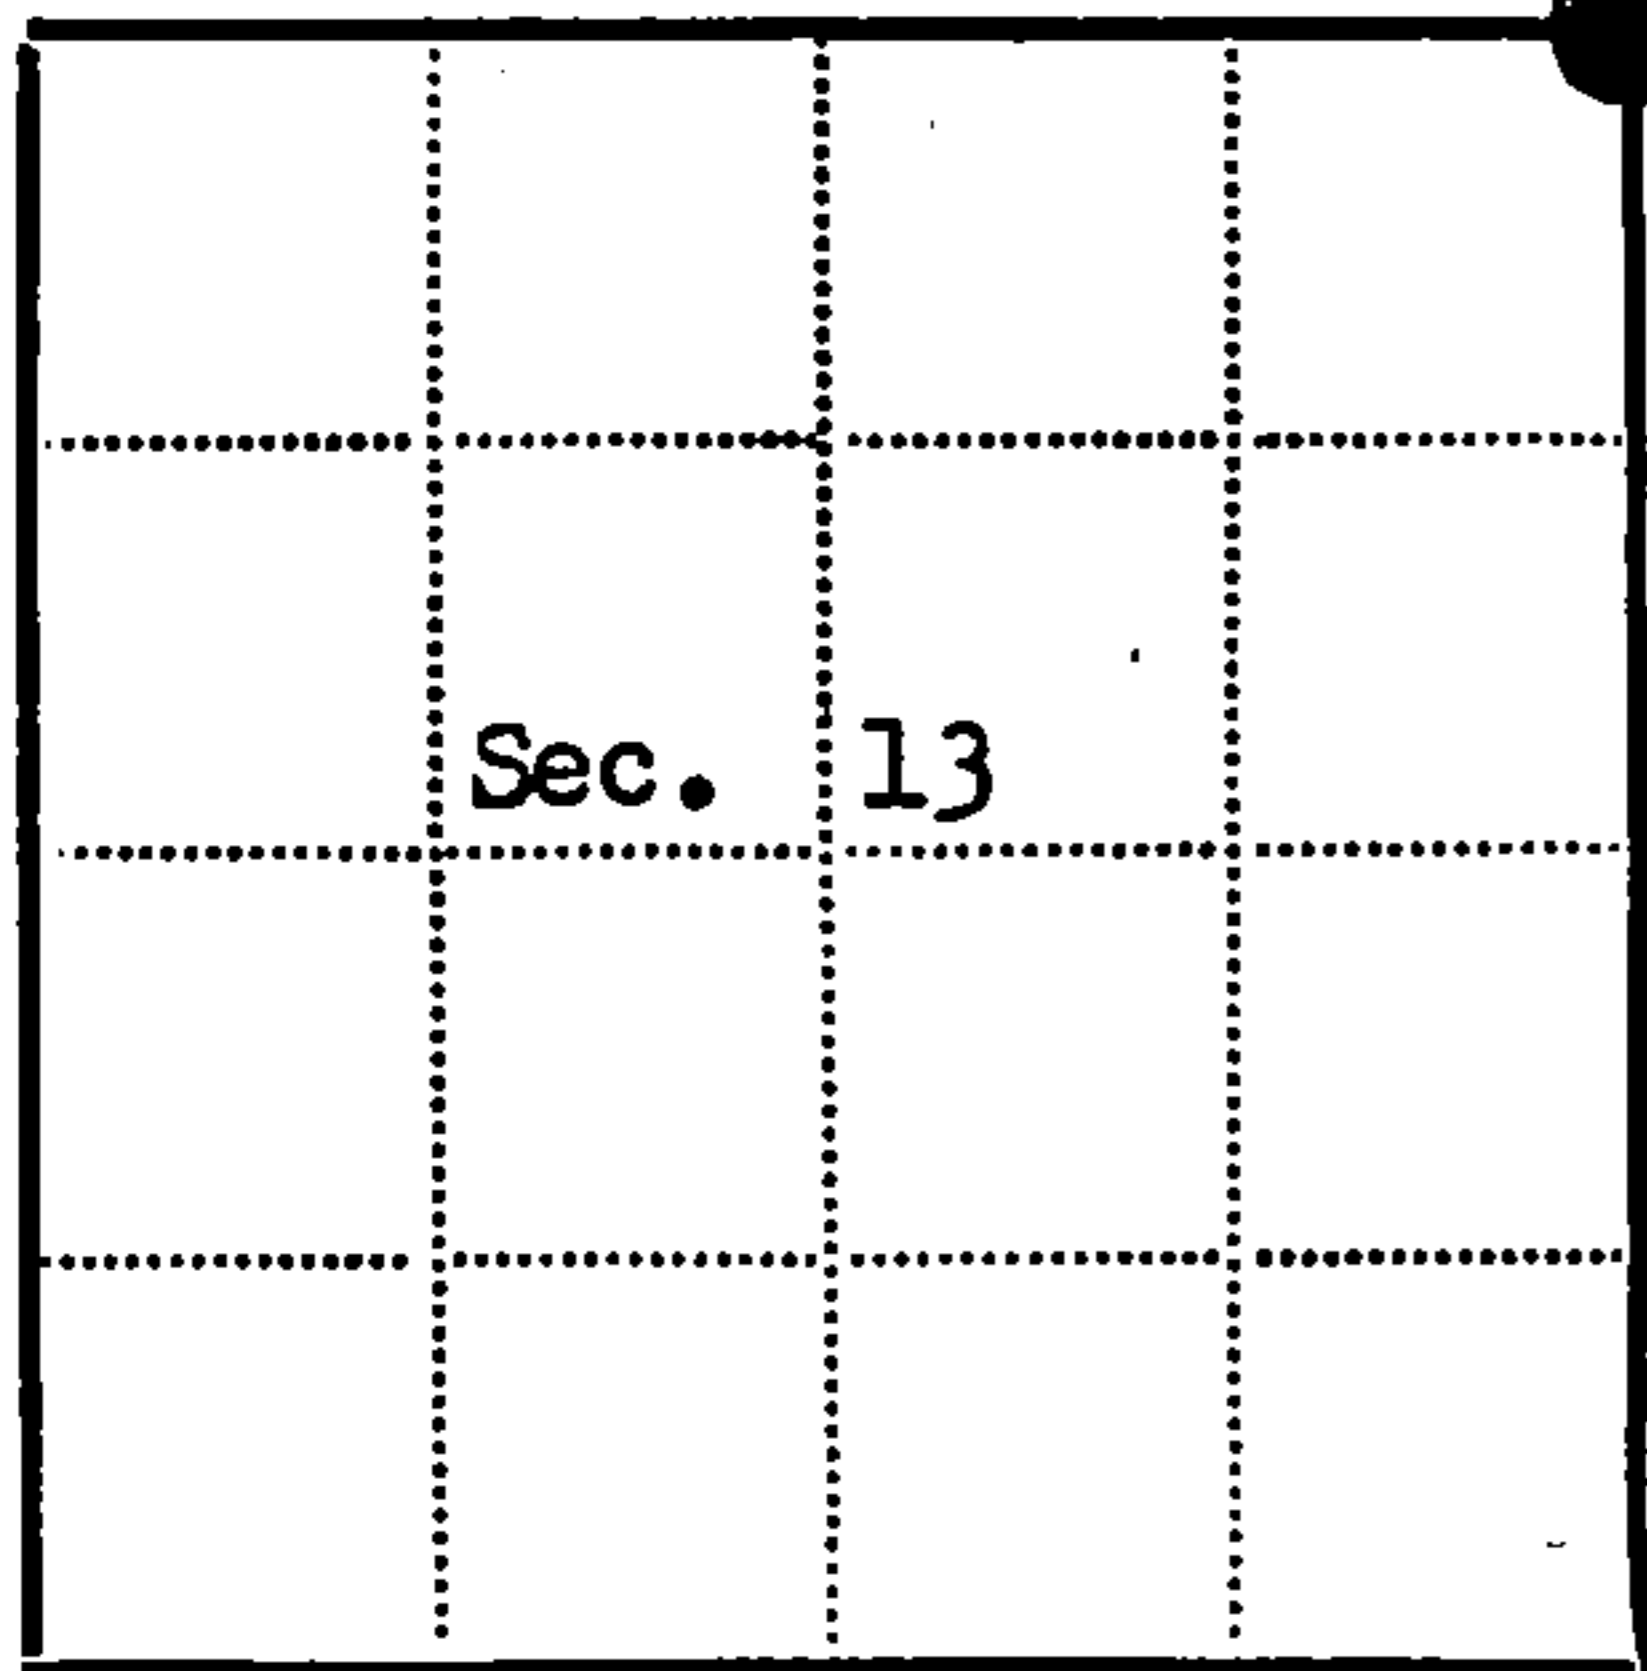

● - Corner monument restored
□ -

Resident witnesses.....

Dated at Rhinelander Wisconsin, this 22nd day of July, 1968.

Signature Jean F. Resvick Title, Land Surveyor
(County Surveyor, Registered Land Surveyor, or other duly authorized official)


Surveyors Registration No. S-802
DOCUMENT NO. 95057

Office of Register of Deeds County of Forest.

I hereby certify that the within instrument was filed in this office for record on the 8th day of August, 1968, and was filed in Book No. I Page No. J-25 of County Records at 9:45 A.M.

Signature Eugene Stutzman Title Register of Deeds

Township 37 North, Range 15 East, Section 13, Index No. J-25, Page No.

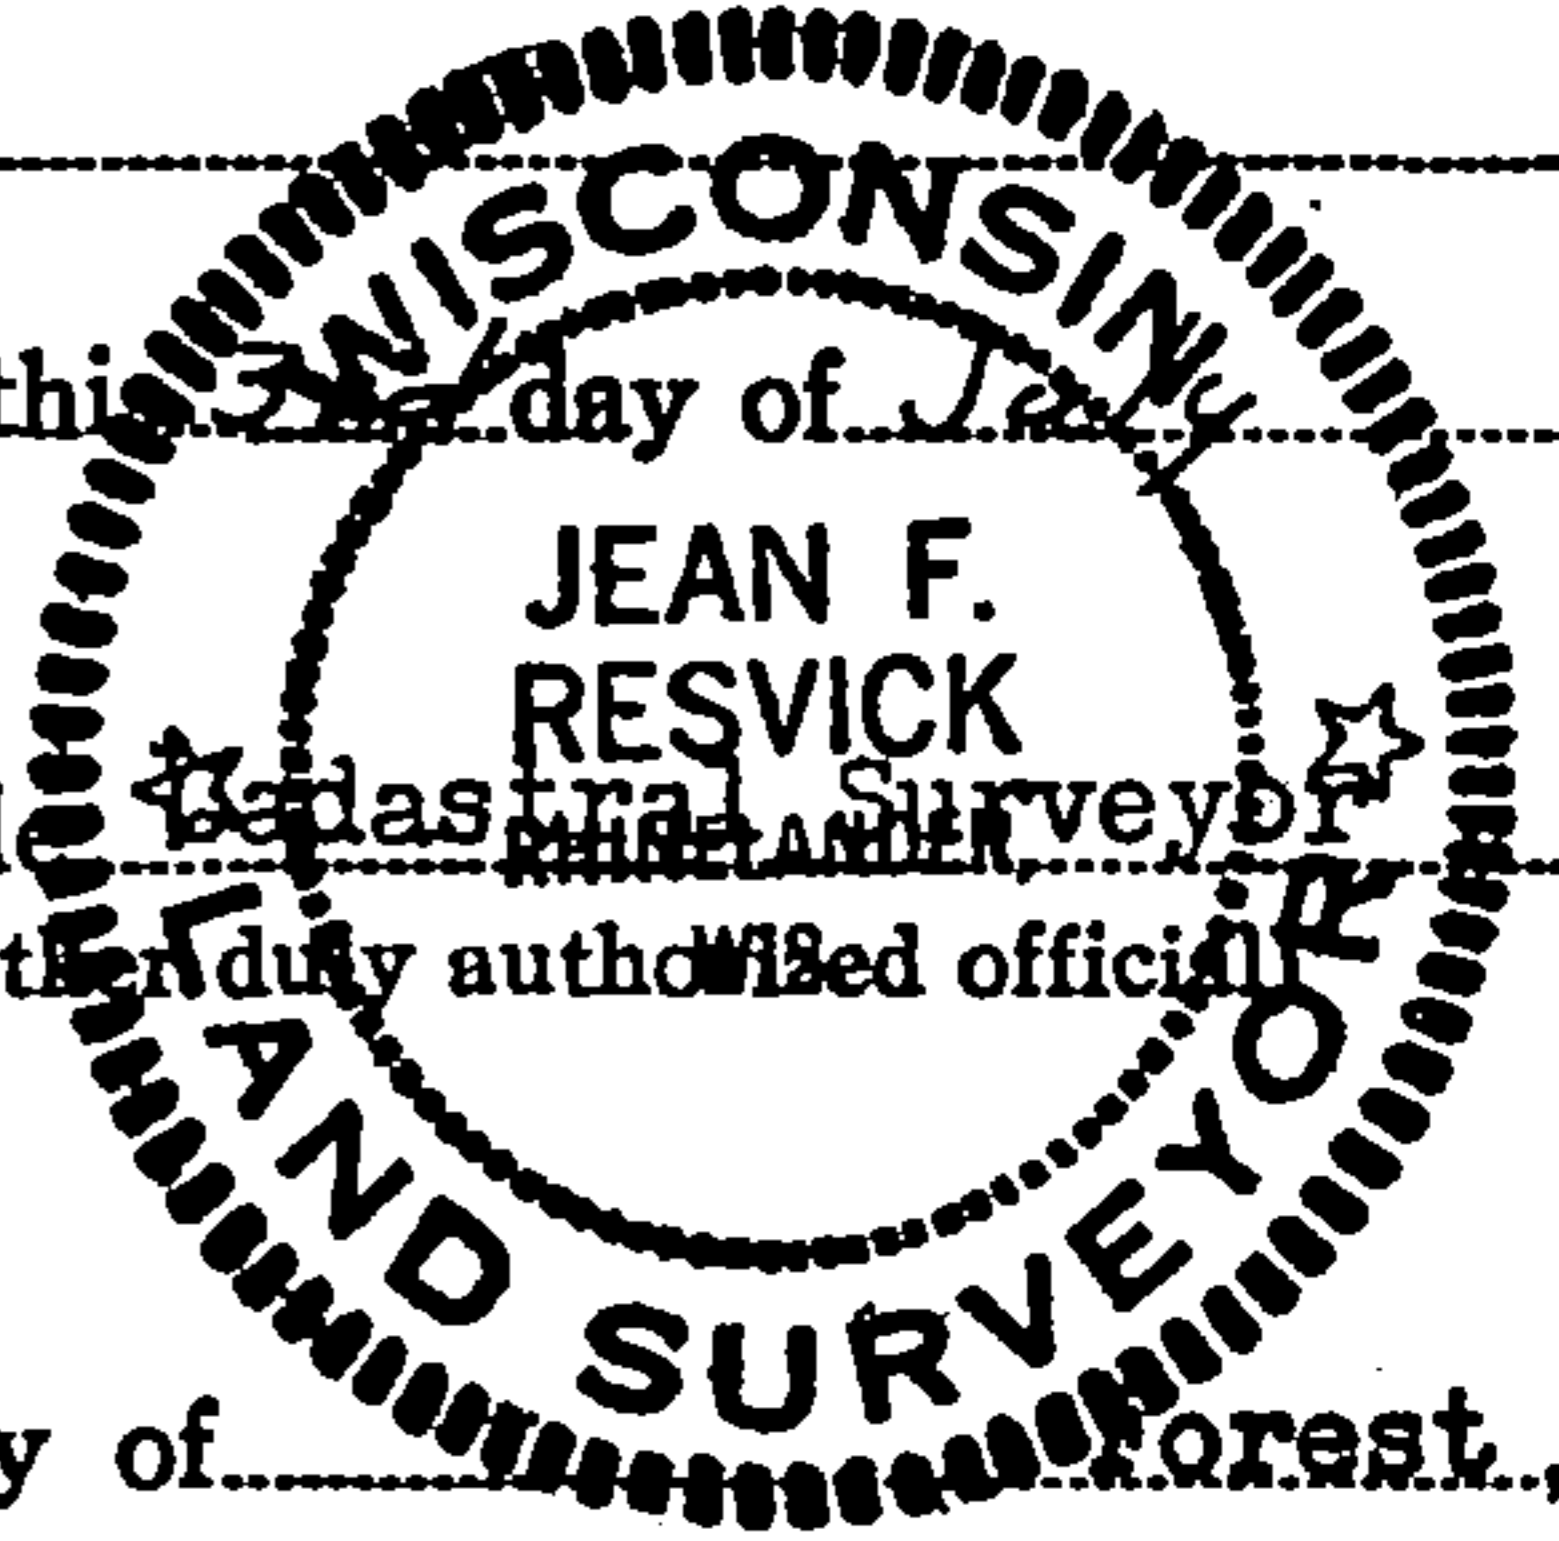

J 25

June 14, 1965
Goodman, Wisconsin

West between Sections 1 and 12, Township 37
North, Range 16 East in Forest County, Wisconsin.

Intersected quarter line in center line of
blacktop town road at 2621.0 feet. Set East 1/16
corner at 1310.5. (Iron pipe) Power line pole
South 42° West 10 feet.

Set points on true line going west at 100,
200, 500, 700 and 800 feet.

Vernon Wickstrom

Vernon Wickstrom
Surveyor

VW/cw


Register

U. S. PUBLIC LAND SURVEY MONUMENT RECORD

INSTRUCTIONS: This record shall show the location of the corner and shall include all of the following nine elements (a through i).

- (a) Identify the corner by reference to the U.S. public land survey system.
- = Corner monument restored.

Section corner common to Sections 12, 7, 13, and 18, T.37N., R15-16E.

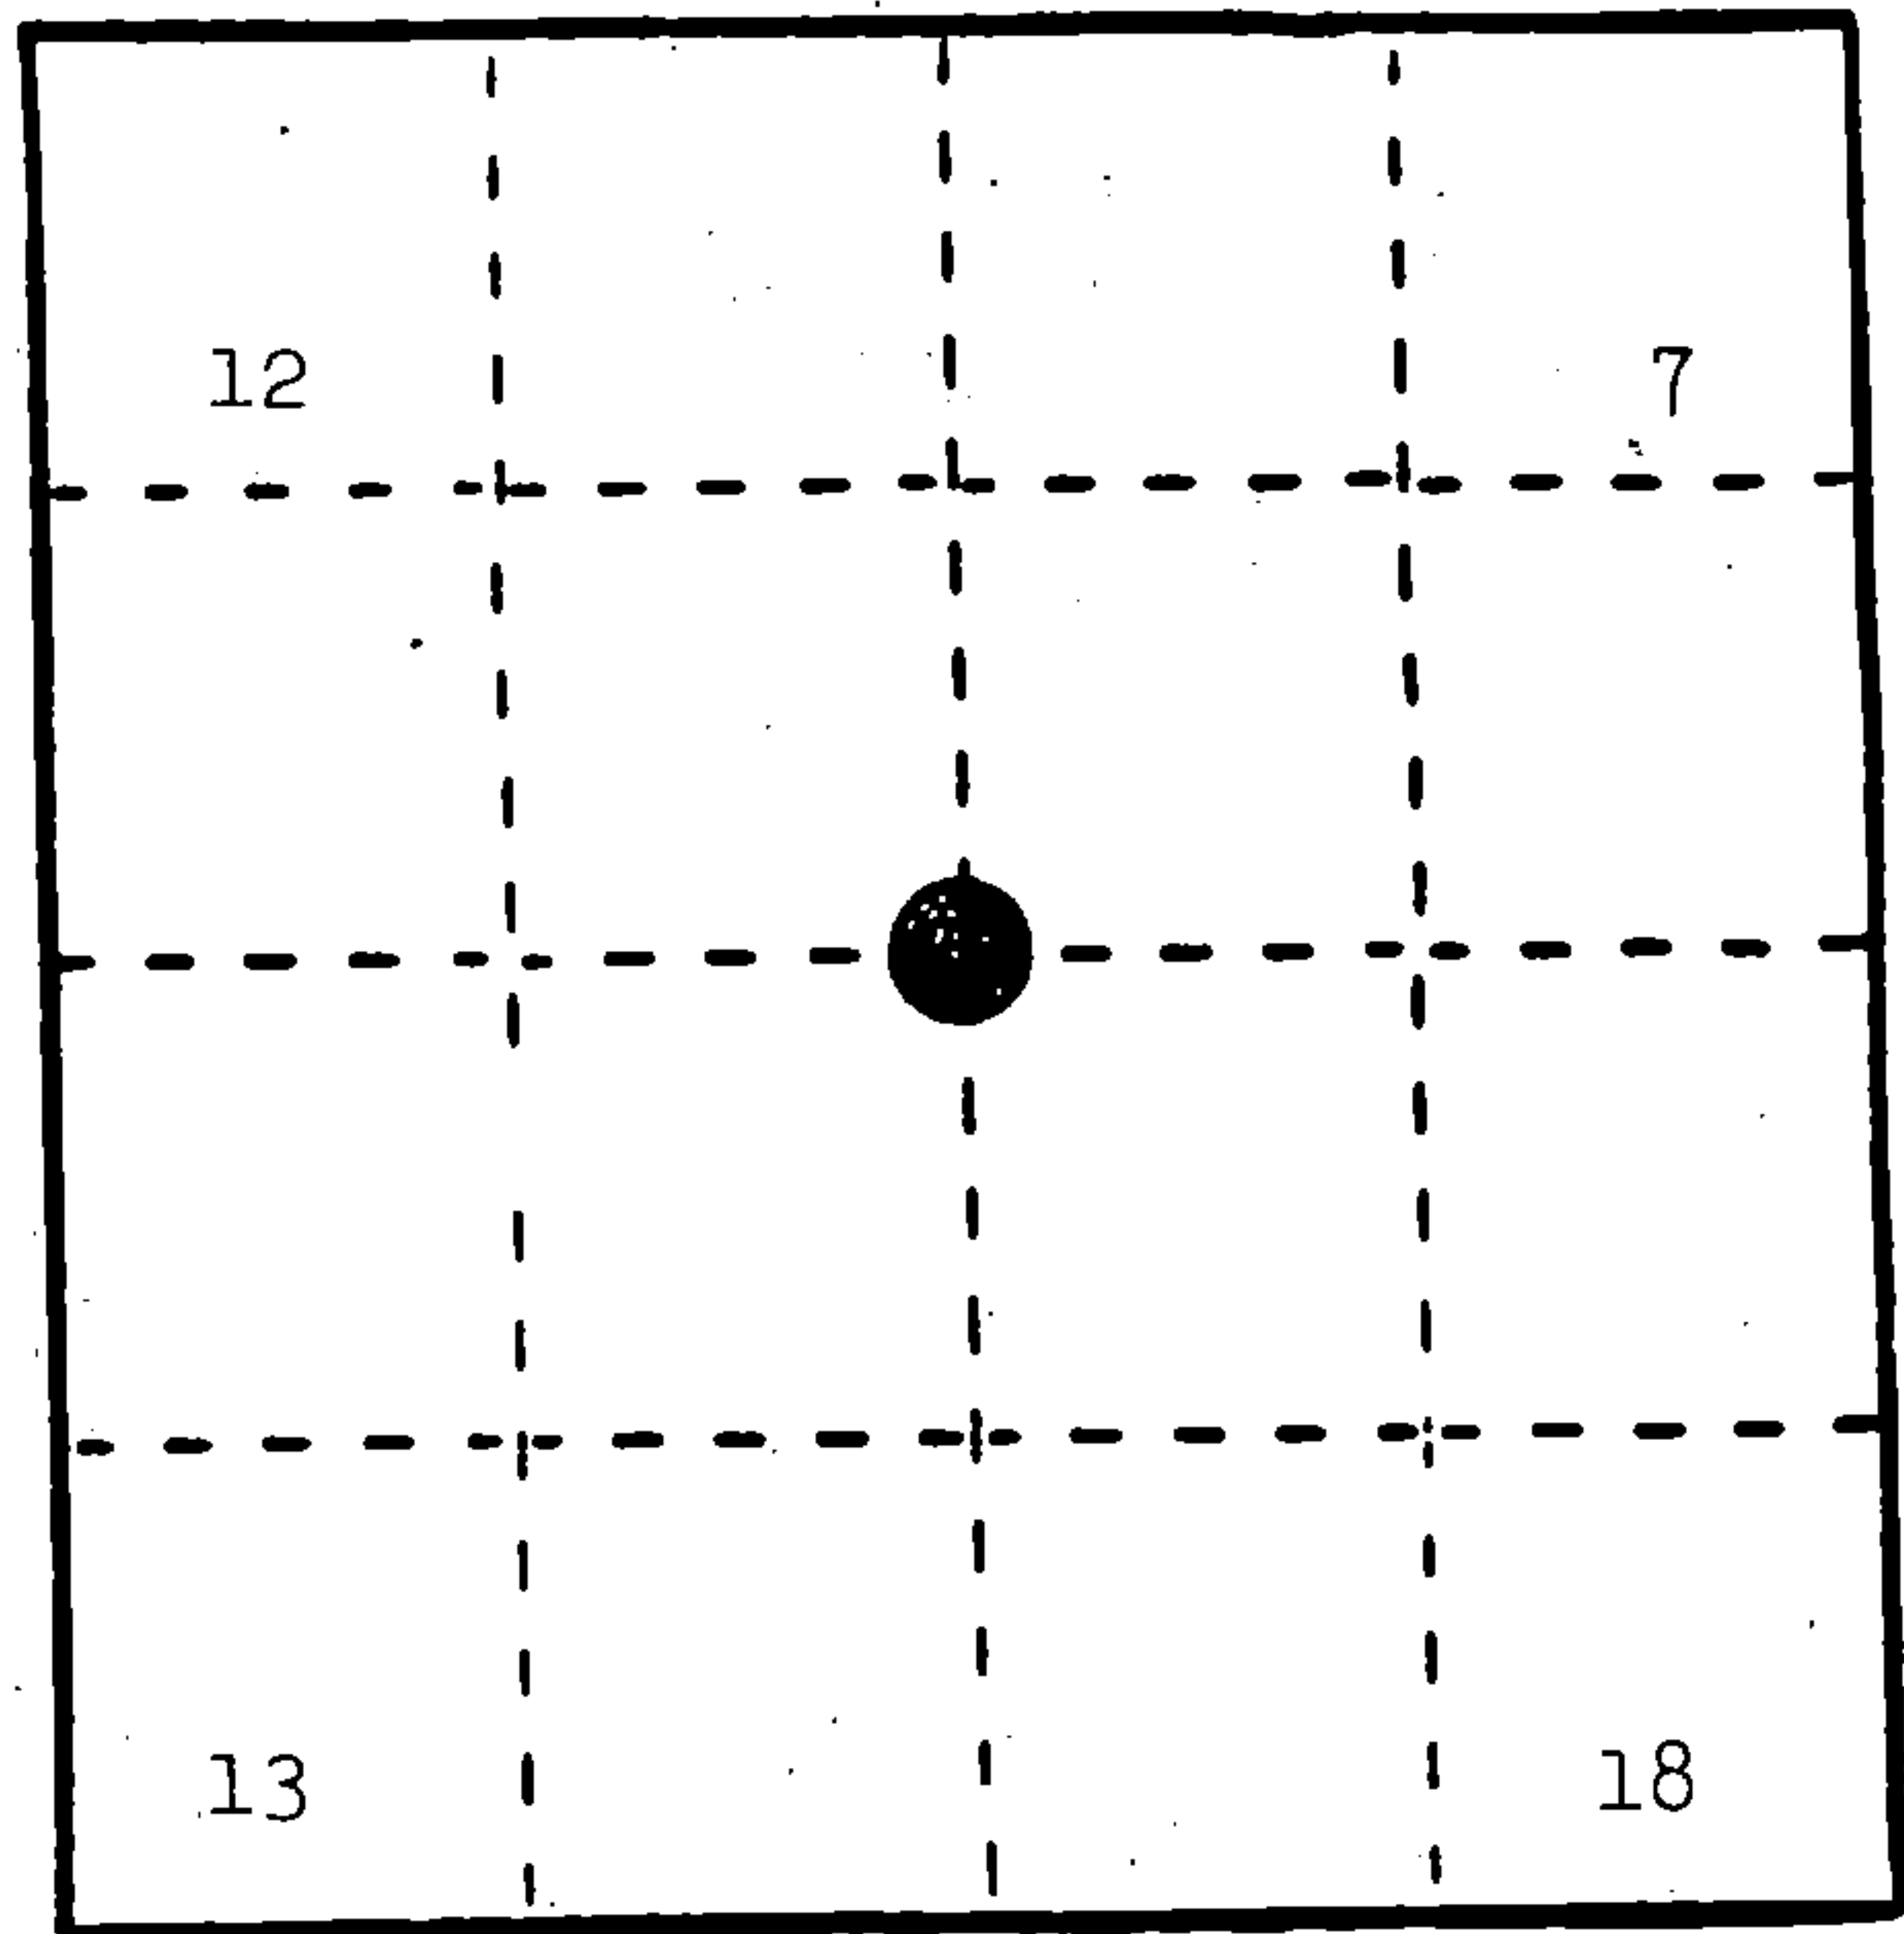

REGISTER'S OFFICE
Forest County, Wis.

Received for record this 17th day
of March A.D., 1986 at
10:40 o'clock A.M. and recorded
in Vol. CORNER RESTORATIONS
page J-25
Paul A. Schramm
Register of Deeds

- (b) Describe any record evidence, monument evidence, occupational evidence, testimonial evidence or any other material evidence you considered, and whether the monument was found or placed.

In 1857, Artemas Curtis set wood post with the following BTs: Yellow Birch, 30", S.60°W., 37 links; Yellow Birch, 22", N.61°W., 37 links; Sugar, 18", N.21°E., 43 links; Sugar, 12", S.48°E., 69 links.

August 1, 1934, L. M. Gilson found a post in good condition, which he believed to be a genuine corner. He also placed a metal location poster on an 8" Maple from which the corner bears south, 30 feet.


June, 1965, J. Resvick found 6" x 6" scribed post from which the following bear: stump hole, S.60°W., 24.4 feet; Sugar stump hole, N.21°E., 28.4 feet; Sugar stump, S.48°E., 45.5 feet with blaze. He replaced 6" x 6" post with 6" diameter concrete monument 4 feet long set 42 inches in the ground with brass cap and the following BTs: Elm, 7", N.74°E., 11.31 feet; Sugar, 11", S.37°E., 15.37 feet; Elm, 8", S.74°W., 16.88 feet; Elm, 8", N.54°W., 35.83 feet.

October 17, 1985; found Elm BT's by Resvick all dead. Made new BT's as below (d)

- (c) In the plan view drawing below, provide reference ties to at least 4 witness monuments, or, if the location is within a municipality, to at least 2 witness monuments. (Witness monuments shall be made of concrete, natural stone, iron or other equally durable material.) Describe witness monuments.

- (d) Show a plan view drawing depicting the relevant monuments and reference ties which is sufficient in detail to enable accurate relocation of the corner monument if the corner monument is disturbed. Indicate north.

1. Sugar, 5", N.65!E., 29.64 feet
2. Sugar, 13", S.35°E., 15.36 feet
3. Sugar, 10", S.36°W., 46.11 feet
4. Sugar, 9", N.33°W., 53.35 feet
5. Steel Sign Post, 7'; East, 2.1 feet
6. 6" diameter concrete monument with stamped brass cap to identify the corner.

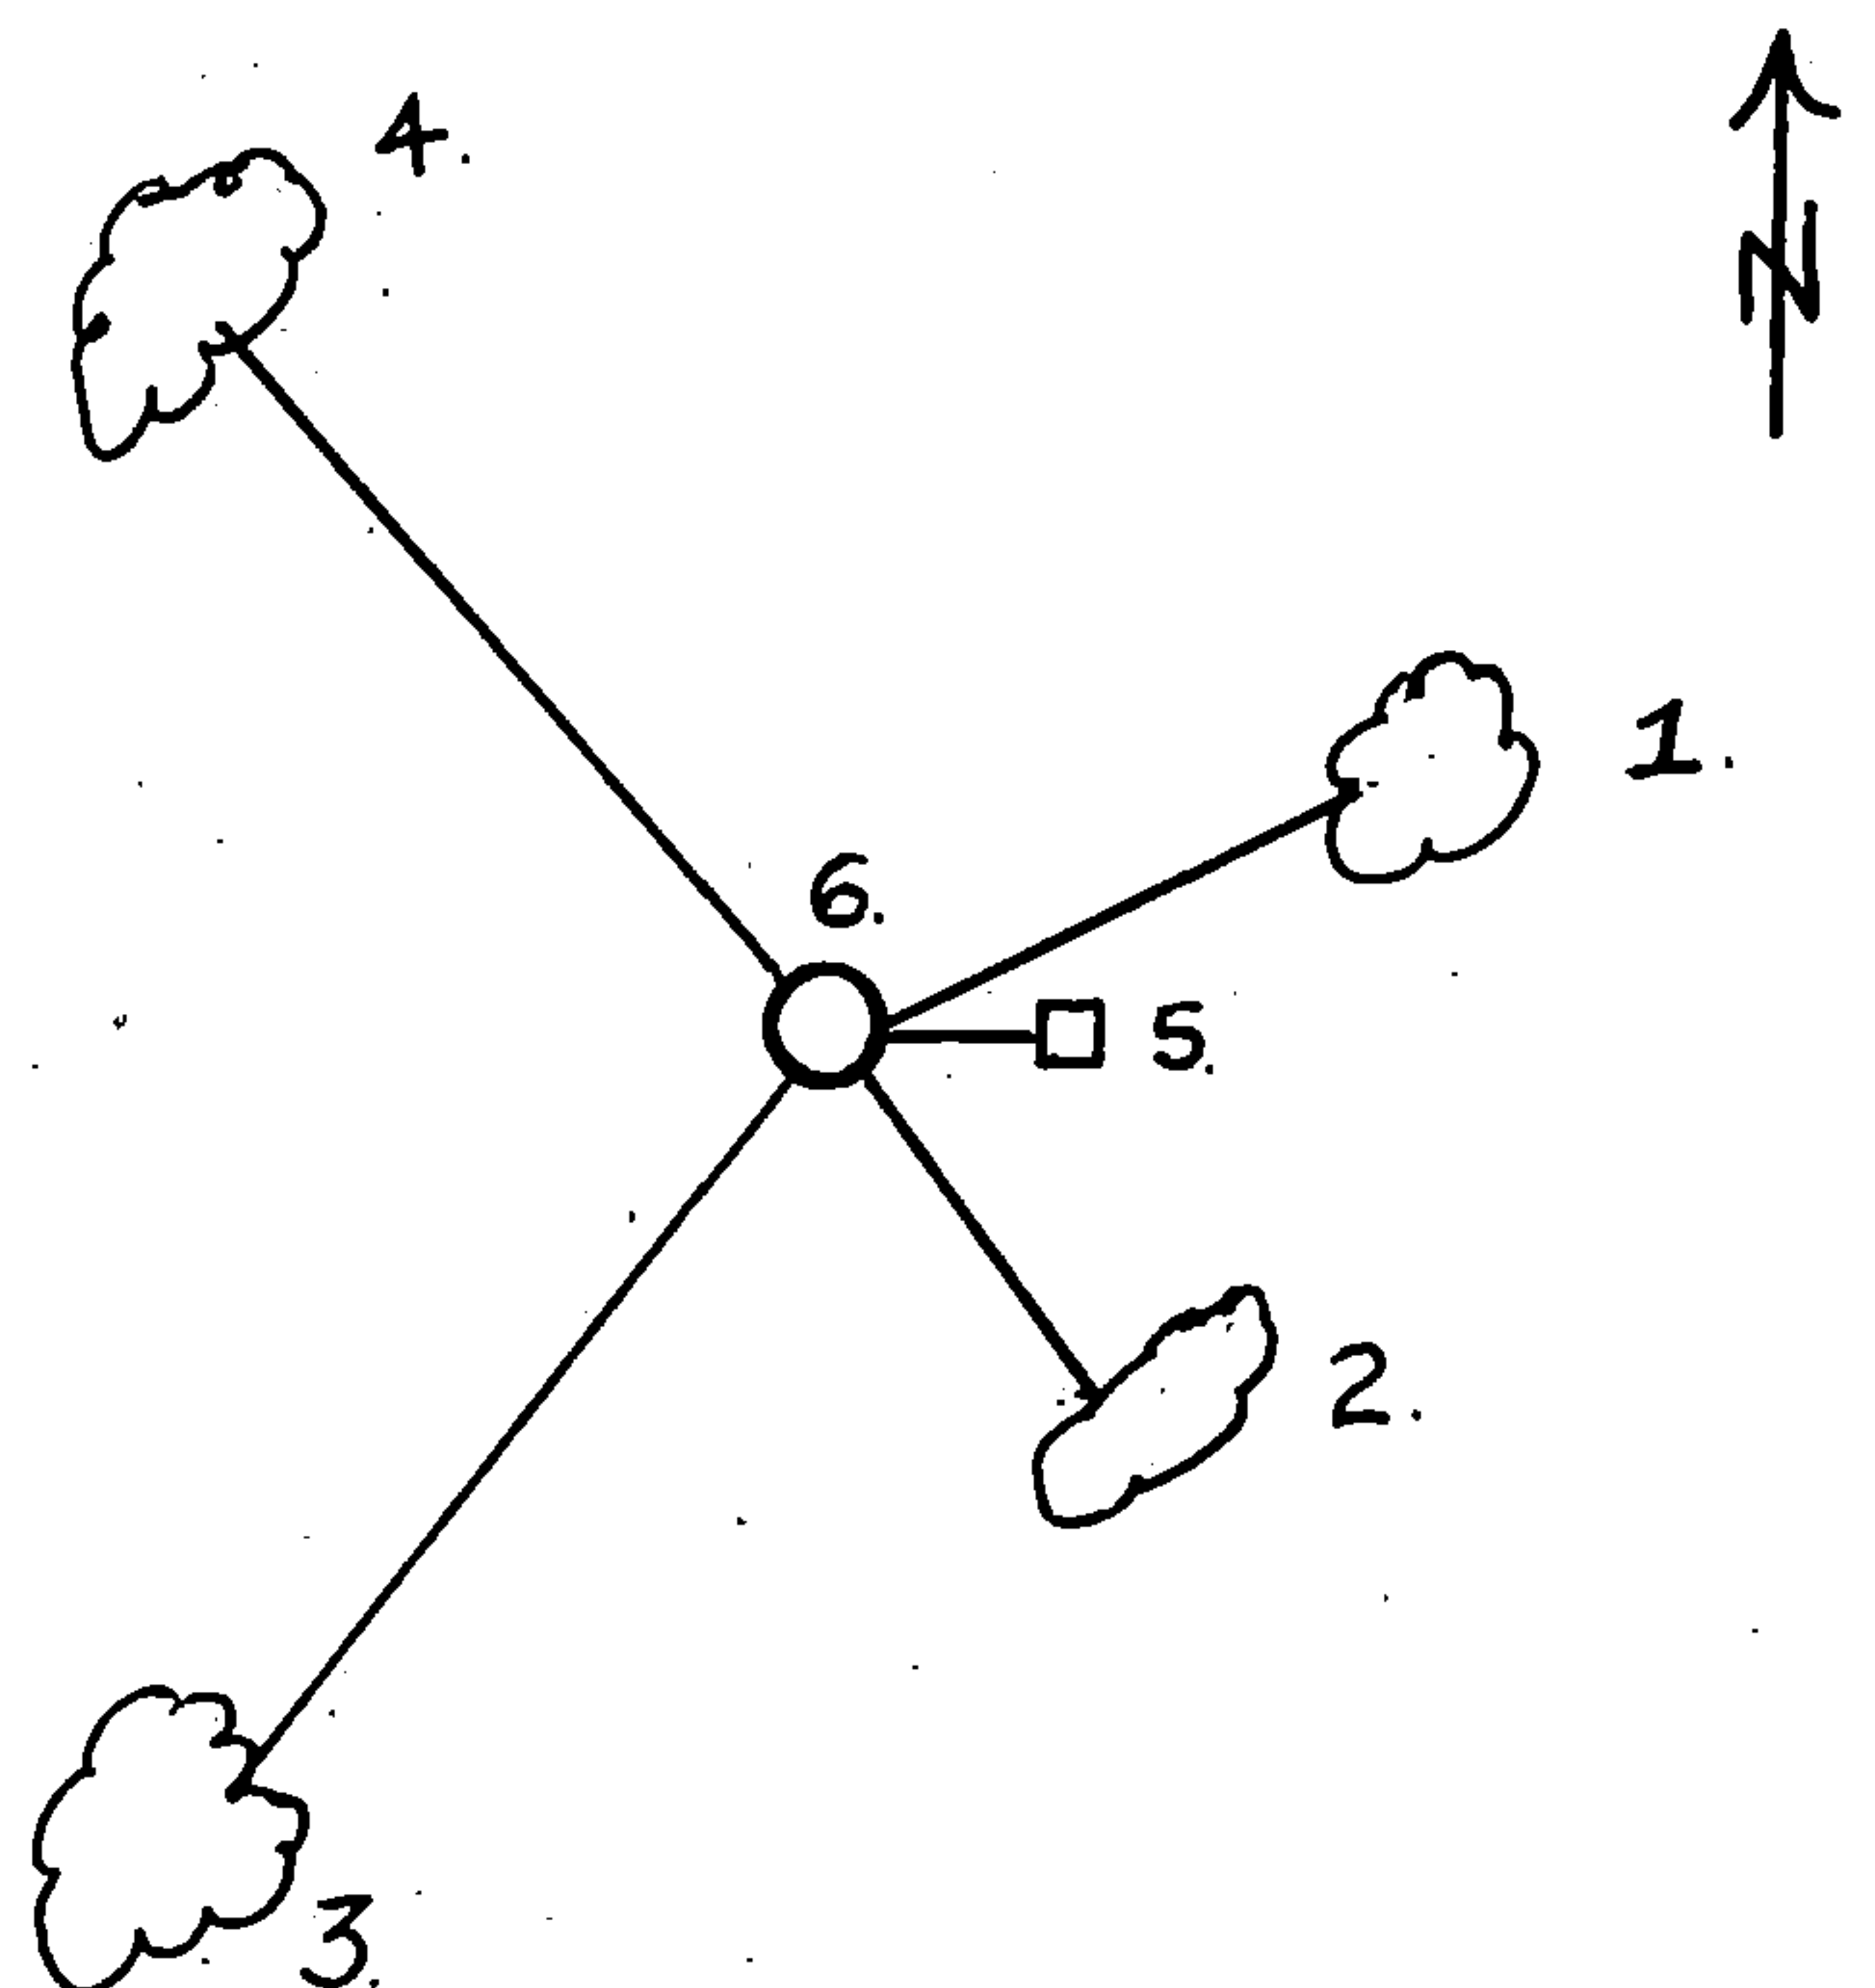

J 25

(e) Describe any material discrepancy between the location of the corner as restored or reestablished and the location of that corner as previously restored or reestablished by distance and direction. Show the discrepancy on the plan view drawing under (d), above. Show the distances between the corner as previously restored or reestablished and (1) the corner as restored or reestablished, and (2) to at least 2 of the witness monuments shown on the drawing in (d), above.

(f) Was the corner restored through acceptance of (1) an obliterated evidence location, or, (2) a found perpetuated location?

(2) a found perpetuated location.

(g&h) Was the corner reestablished through lost corner proportionate methods? If so, show the method, including the directions and distances to other public land survey corners used as evidence or used for proportioning in determining the corner location?

No.

Affix Land Surveyor Seal



(i) I, Milo E. Stefan
(type or print name) certify that the corner location shown on this record was determined by me or under my direction and control and that this U.S. Public Land Survey Monument Record is correct and complete to the best of my knowledge and belief.

Milo E. Stefan
Signature

1/3/86
Date