


# U. S. PUBLIC LAND SURVEY MONUMENT RECORD

## INSTRUCTIONS:

This record shall show the location of the corner and shall include all of the following nine elements (a through i).

- (a) Identify the corner by reference to the U.S. public land survey system.  
○ = Corner monument restored.

Corner Common to Sections 17, 18, 19, and 20, T.37N., R.15E., Forest County, Wisconsin.

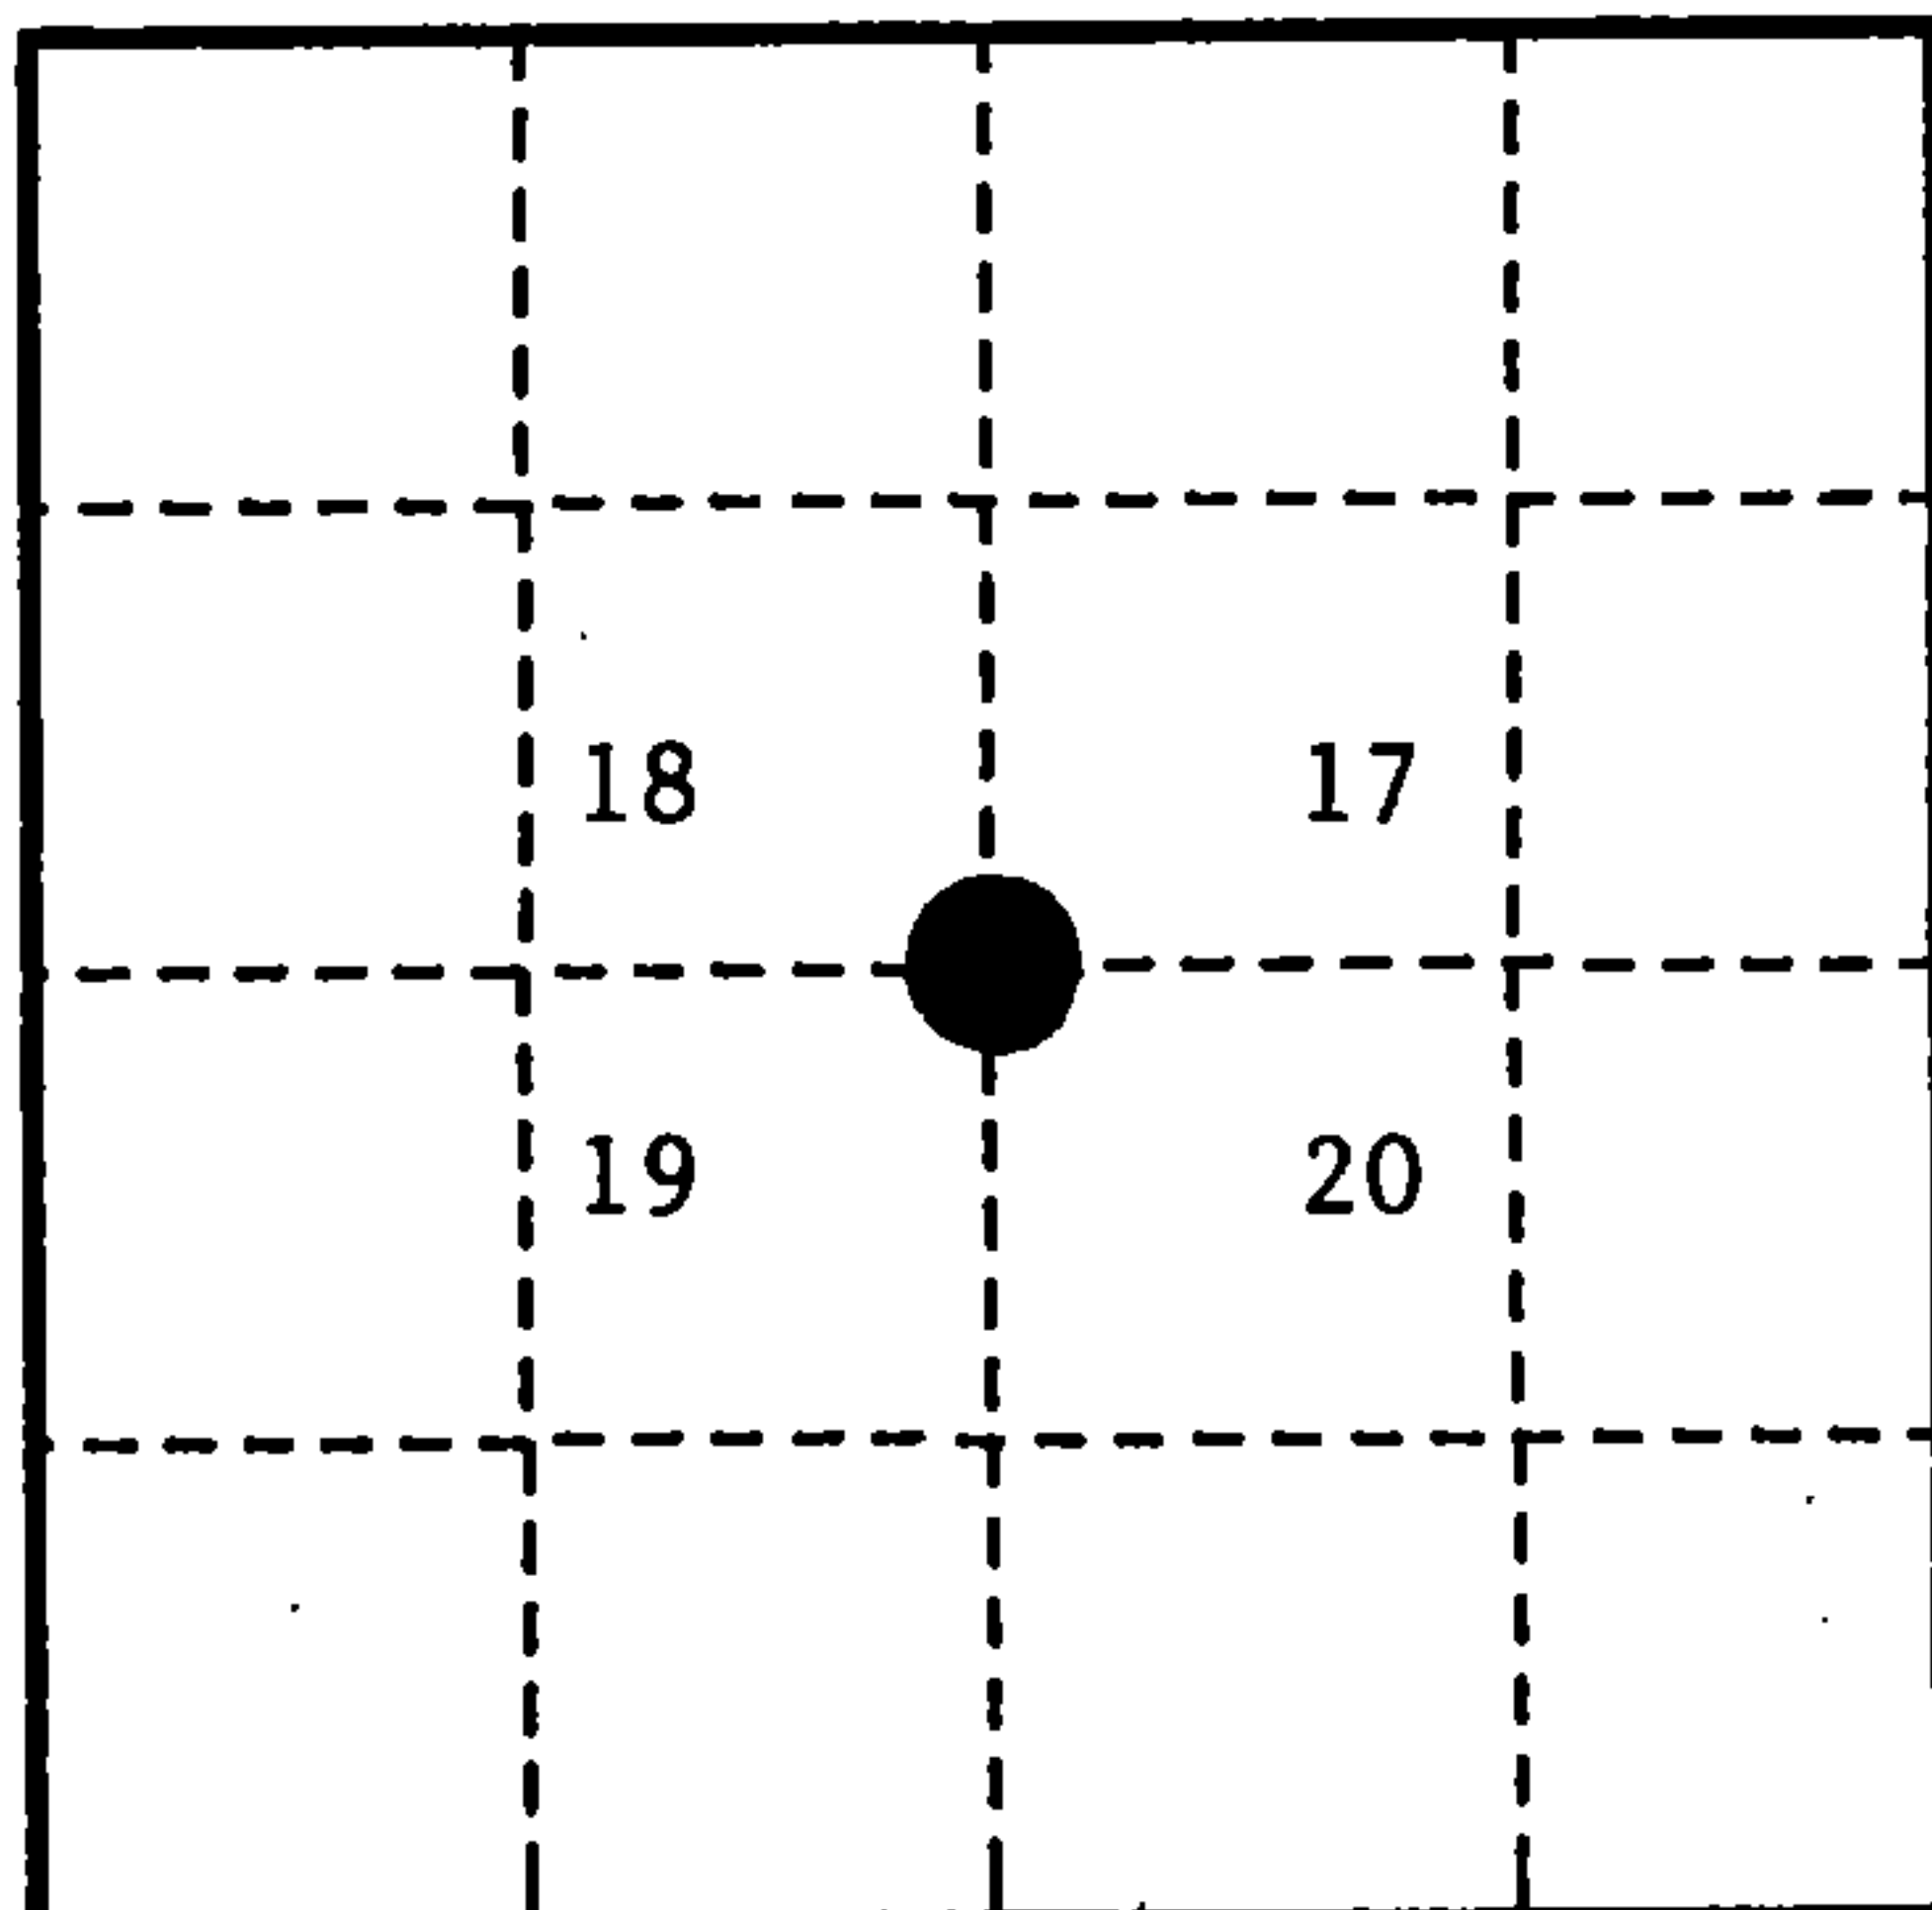

- (b) Describe any record evidence, monument evidence, occupational evidence, testimonial evidence or any other material evidence you considered, and whether the monument was found or placed.

In 1865, James Nowlin set a wood post and made the following references: Hemlock, 12", N.49°E., 25 links (16.50'); Sugar Maple, 12", S.45°W., no distance recorded.


In 1977, Jean Resvick, R.L.S. utilized 1934 state highway surveys to restore this corner. Set a brass capped monument 0.40' below road centerline and made references: Spruce, 8", N.38°E., 46.35'; Scotch Pine, 14", S.8°E., 28.58'; Scotch Pine, 11", S.28°W., 39.89' and Red Pine, 15", N.12°W., 26.31'.

In 1991, Alan Harrison found corner as set and referenced by Resvick.

- (c) In the plan view drawing below, provide reference ties to at least 4 witness monuments, or, if the location is within a municipality, to at least 2 witness monuments. (witness monuments shall be made of concrete, natural stone, iron or other equally durable material.)

- (d) Show a plan view drawing depicting the relevant monuments and reference ties which is sufficient in detail to enable accurate relocation of the corner monument if the corner monument is disturbed. Indicate north.

1. Brass capped monument in road.
2. Spruce, 8", N.38°E., 46.36 feet
3. Scotch Pine, 16", S.8°E., 28.42 feet
4. Scotch Pine, 13", S.28°W., 39.96 feet
5. Red Pine, 18", N.12°W., 26.29 feet
6. Steel Sign Post, North, 22.28 feet

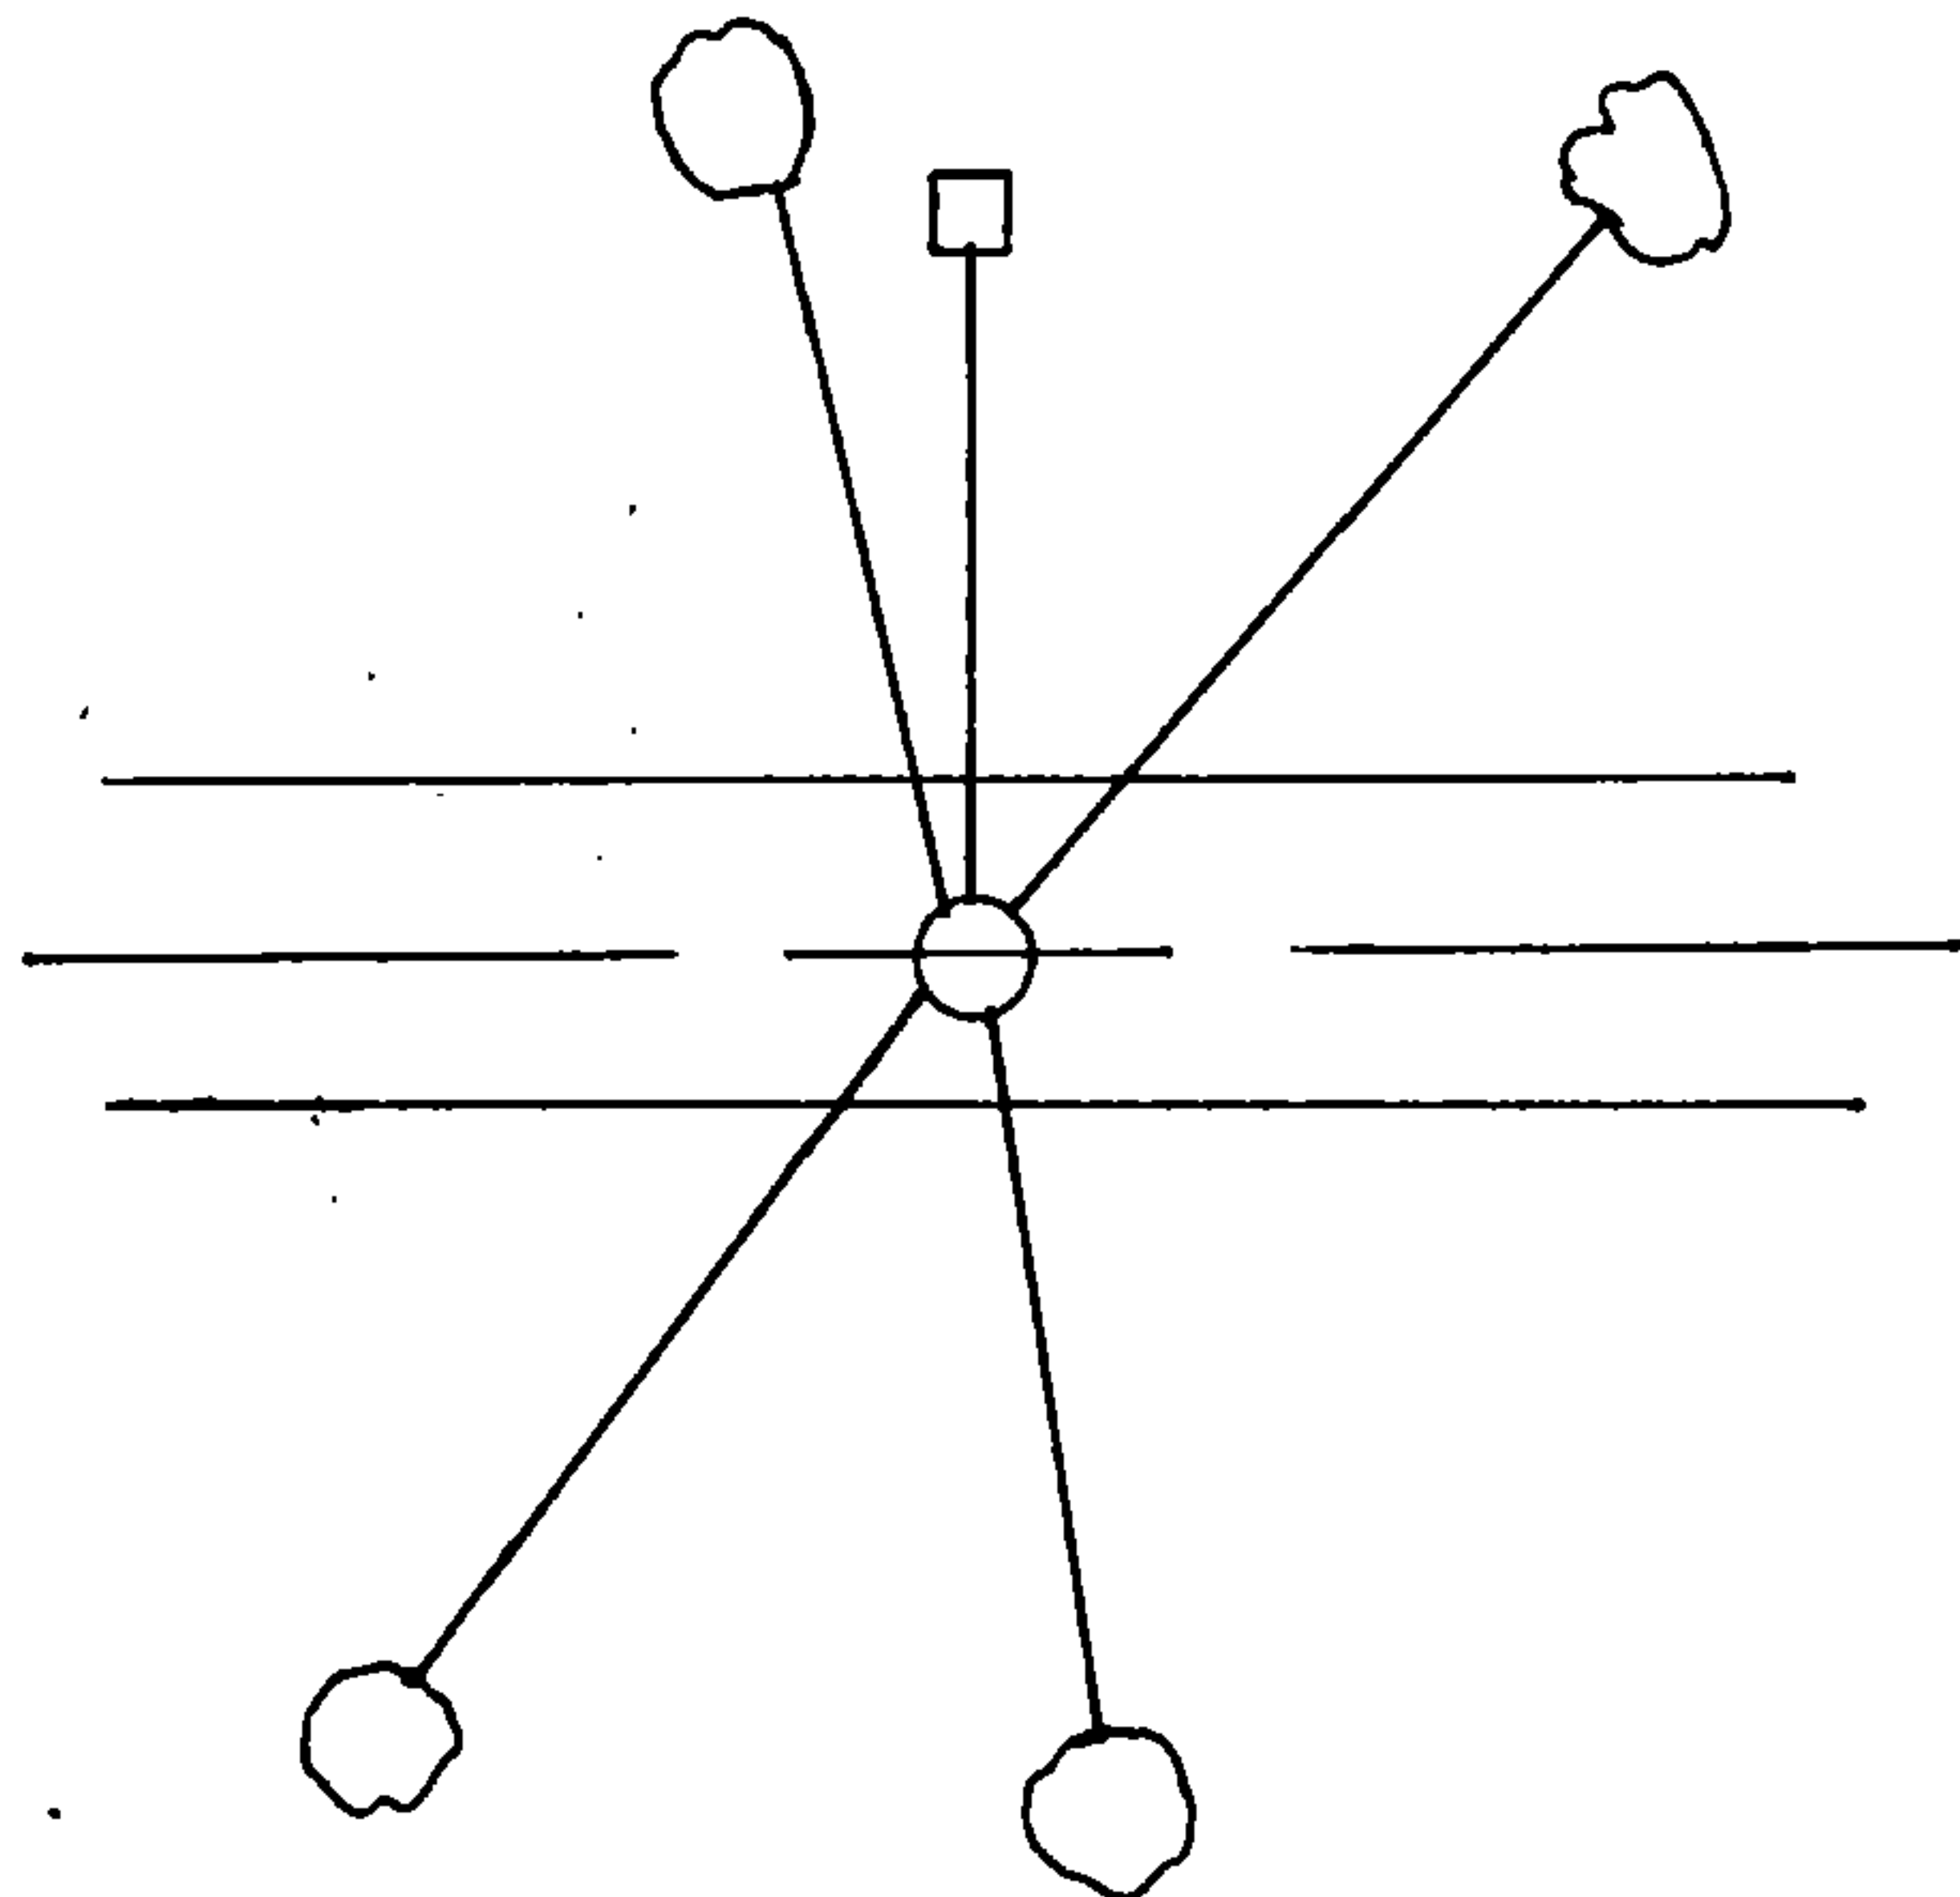

REGISTER'S OFFICE  
Forest County, Wis.

Received for record this 13th day  
of May A.D., 1992 at  
11:30 o'clock A.M. and recorded  
in Vol. COPIER RESTORATIONS  
page N-5

*Paul H. Schenck*  
Register of Deeds

(e) Describe any material discrepancy between the location of the corner as restored or reestablished and the location of that corner as previously restored or reestablished by distance and direction. Show the discrepancy on the plan view drawing under (d). above. Show the distances between the corner as previously restored or reestablished and (1) the corner as restored or reestablished, and (2) to at least 2 of the witness monuments shown on the drawing in (d), above.

None

(f) Was the corner restored through acceptance of (1) an obliterated evidence location, or, (2) a found perpetuated location ?

(2) a found perpetuated location

(g & h) Was the corner reestablished through lost corner proportionate methods? If so, show the method, including the directions and distances to other public land survey corners used as evidence or used for proportioning in determining the corner location?

No

(1) I, Alan D. Harrison

(type or print name) certify that the corner location shown on this record was determined by me or under my direction and control and that this U.S. Public Land Survey Monument Record is correct and complete to the best of my knowledge and belief.

Alan D. Harrison

Signature

4/9/92

Date

CERTIFICATE READY FOR FILING:

Sue Vap

District Ranger

