

# CERTIFIED LAND CORNER RESTORATION



Index No. R-3

**R 3**

State of Wisconsin }  
County of Forest } ss.

I Daniel K. Pleoger, do hereby  
certify that on the 6th day  
of May, 1981, I found  
evidence of the Quarter  
corner of Sections 19 and 30  
Township 37, North, Range  
15 East, Fourth Principal Meridian,  
as described hereon; and that from this evidence  
I established a new monument and accessories  
as described hereon to perpetuate the original  
location of this corner.

Resident witnesses:

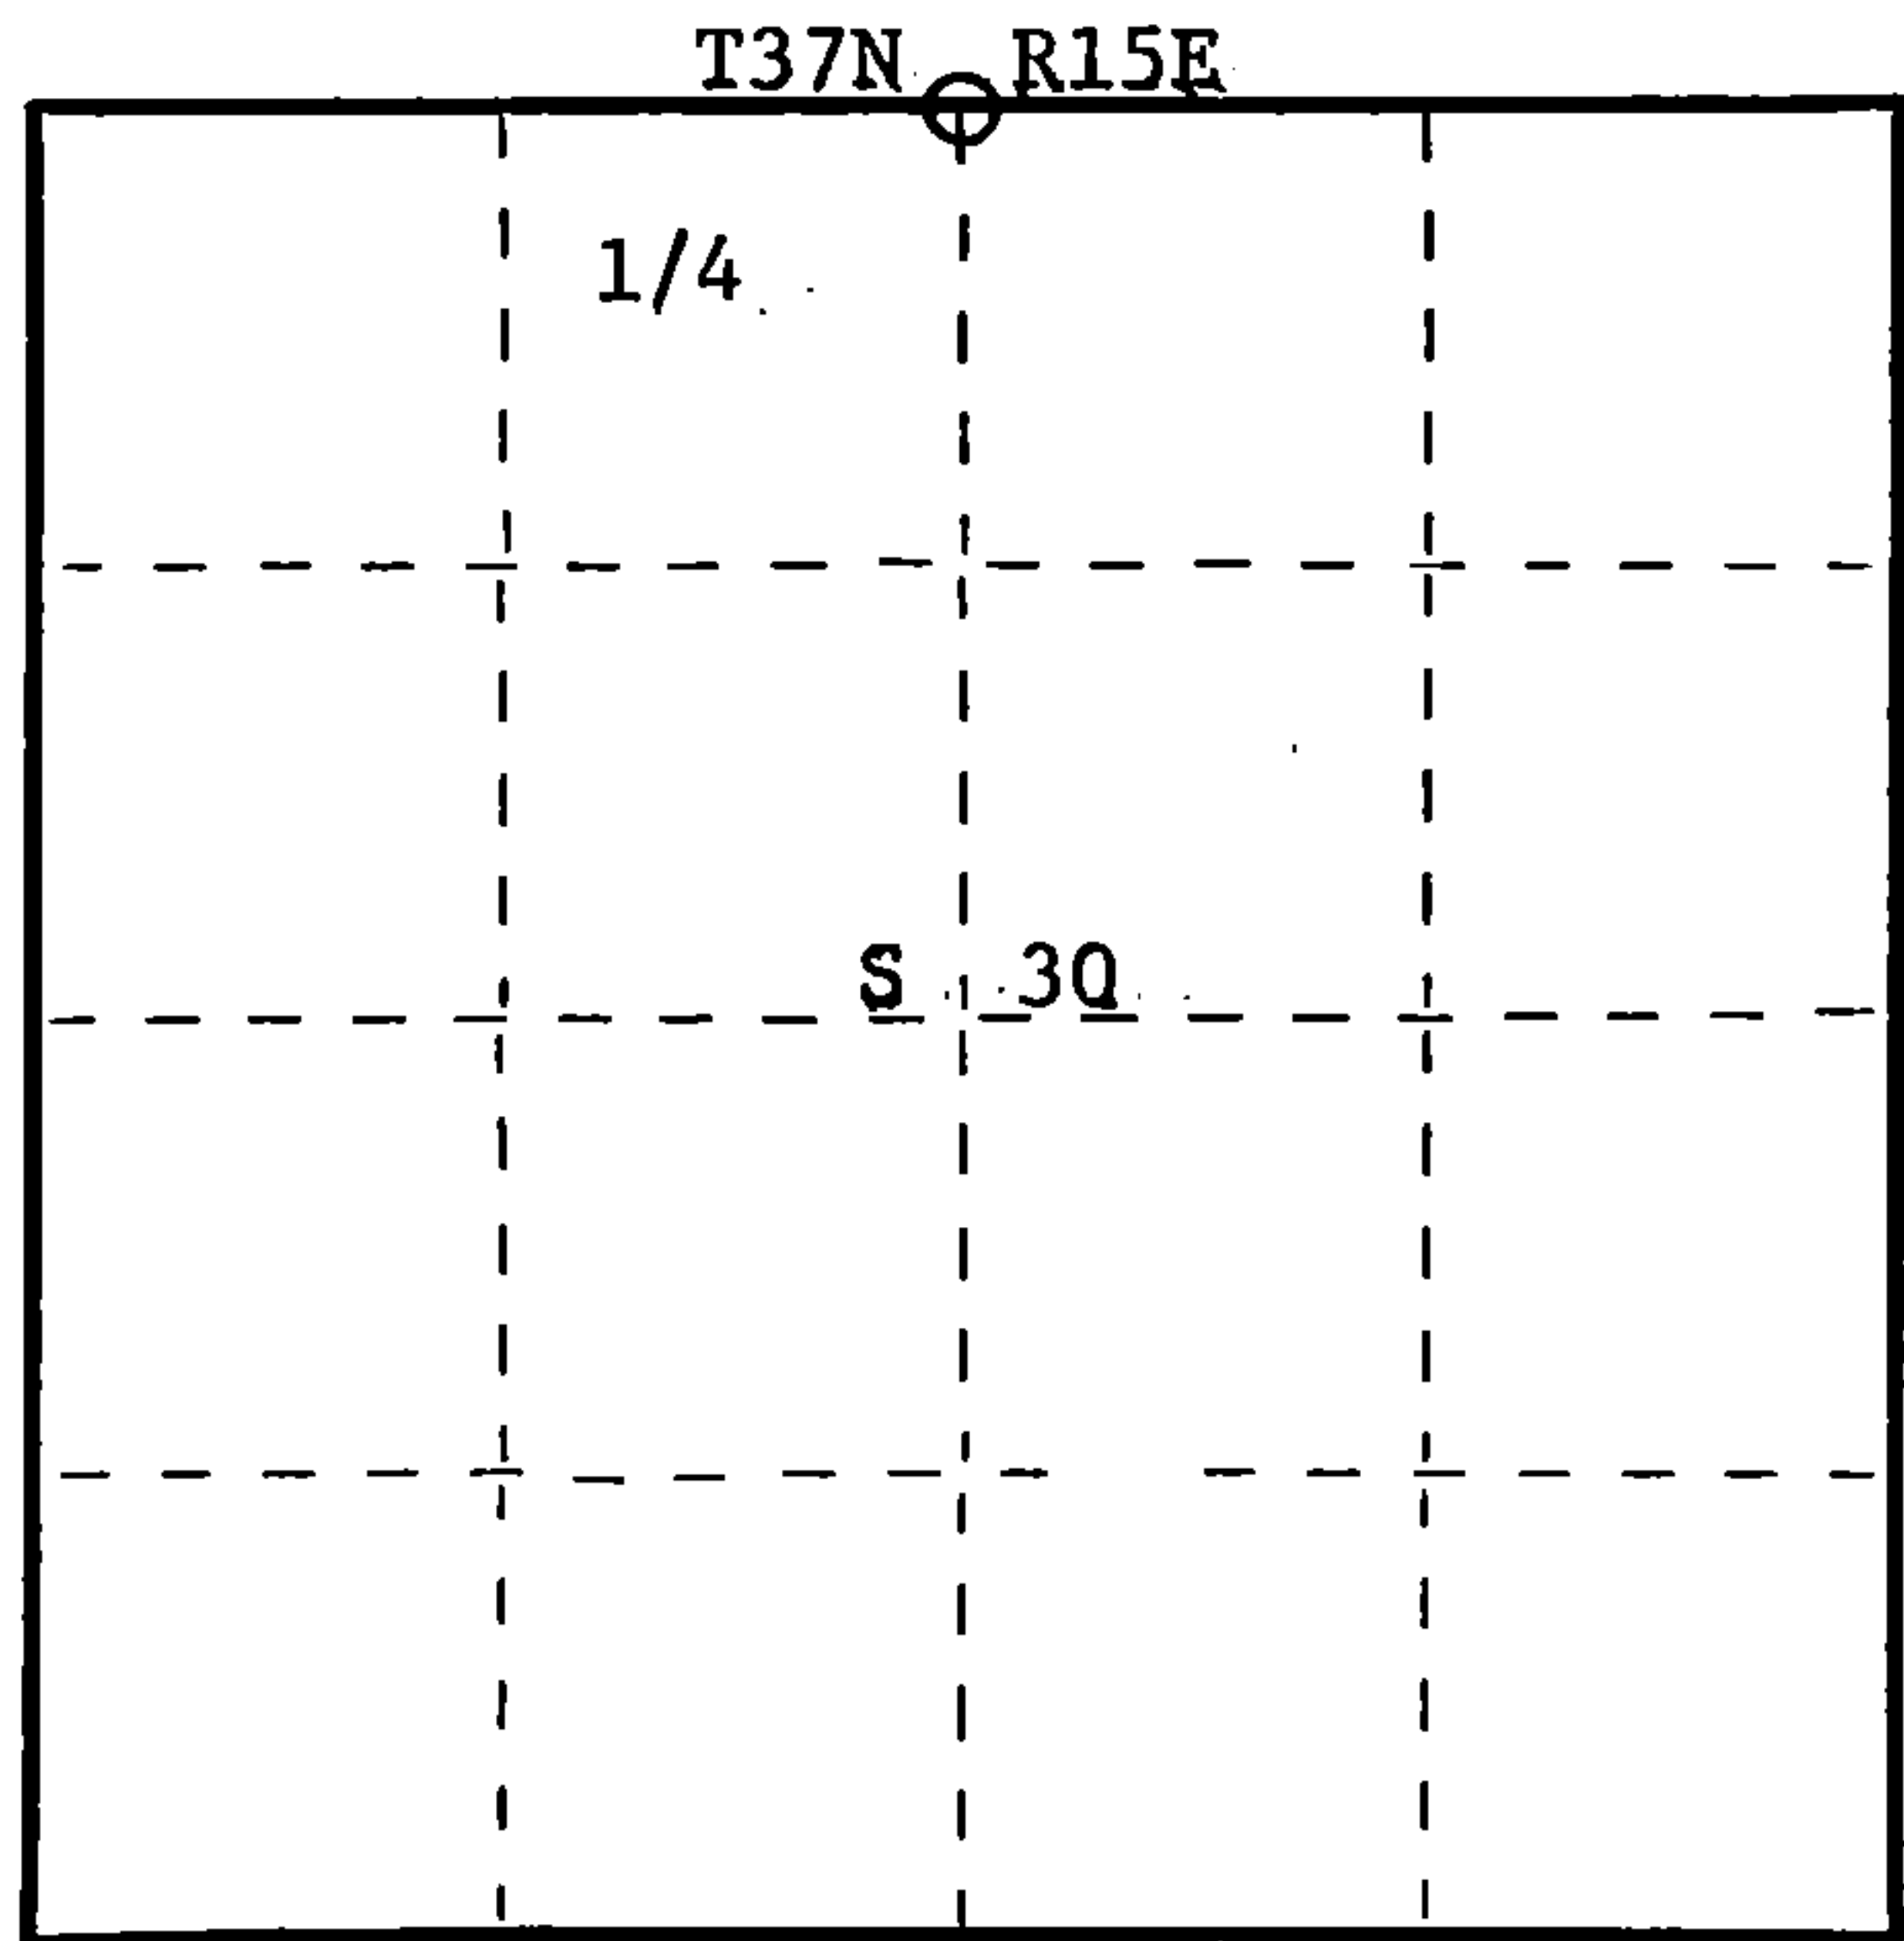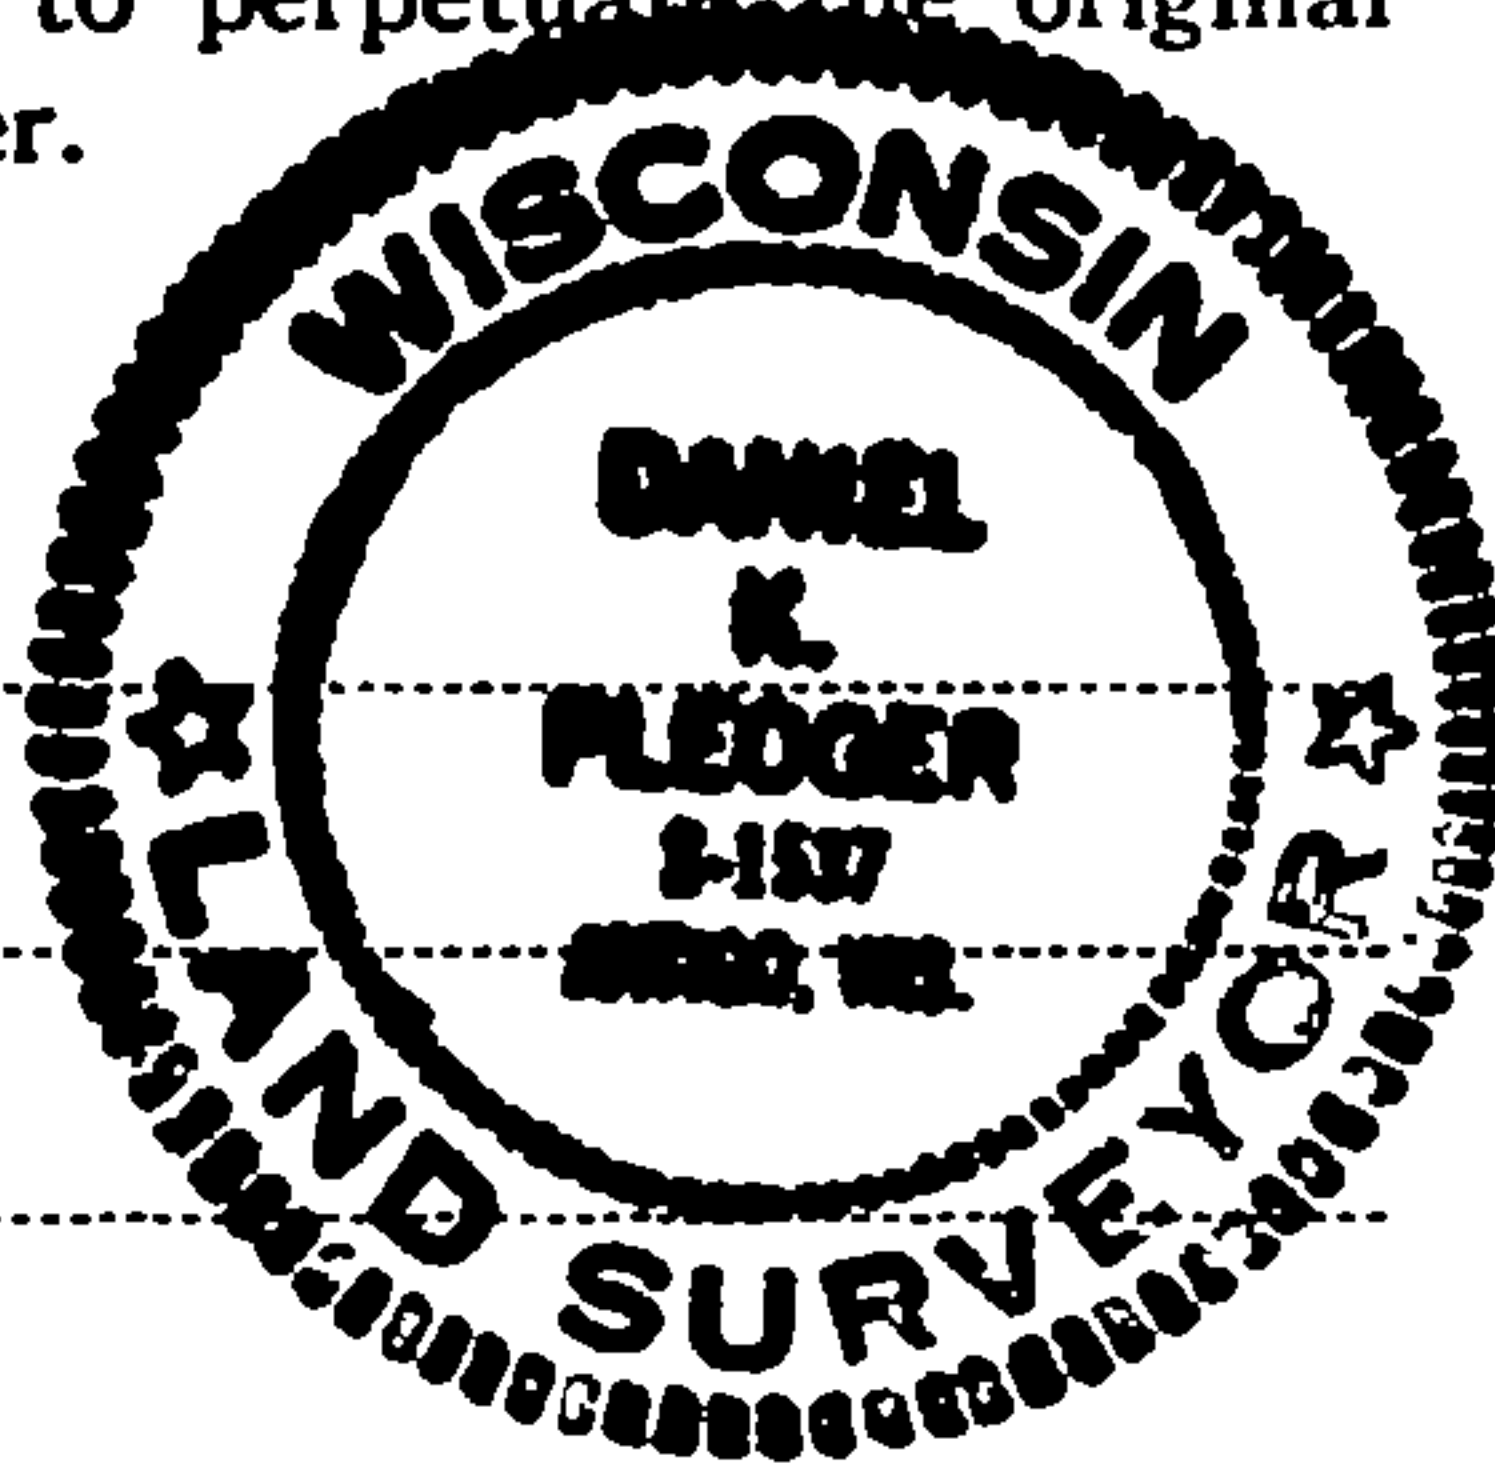

○ = Corner monument restored.

History of original corner establishment:

Original corner established by James L. Nowlin government deputy surveyor, in 1857  
from which Aspen 6" bears S33°W 30 links and Aspen 4" bears N4°E 20 links.

Description of corner evidence found:

Recovered an old 3" squared cedar stake badly rotted.  
Very old blazed lines running east and west. This position has been witnessed  
for many years by C.P.I. and D.N.R. foresters.  
No evidence of OBT's.

Description of monument and accessories I established to perpetuate the original location of this corner.

Set a 2-1/2" aluminum Federal A-1 Monument with alloy cap - stamped:  
Monument projects 12" above ground.

Marked NBT's:

Sugar 6" S71°W 10.10 feet  
Sugar 6" N14°W 14.48 feet  
Sugar 6" N60°E 18.04 feet  
scribed 1/4 B.T.

T37N R15E  
1/4 S+19  
S+30  
S1537-1981

Dated at Rhineland, Wis., this 23rd day of June, 1981.

Signature Daniel K. Pleoger Title Registered Land Surveyor Registration No. 1537  
(County Surveyor, Registered Land Surveyor, or other duly authorized official)

Office of Register of Deeds, County of Forest, I hereby certify that the within  
instrument was filed in this office for record on the 1st day of July, 1981  
at 8:30 o'clock A. M.

Eugene Stutzman  
(Register of Deeds)  
By \_\_\_\_\_ Deputy

DOCUMENT NO.  
**120054**