


CERTIFIED LAND CORNER RESTORATION

Index No. R-Z R 2


State of Wisconsin }
County of Forest } ss.

I Daniel K. Pledger, do hereby certify that on the 7th day of May, 19 81, I found established the W 1/16 corner of Sections 19 and 30 Township 37 North, Range 15 East, Fourth Principal Meridian, as described hereon; and that from this evidence I established a new monument and accessories as described hereon to perpetuate the original location of this corner.

Resident witnesses:

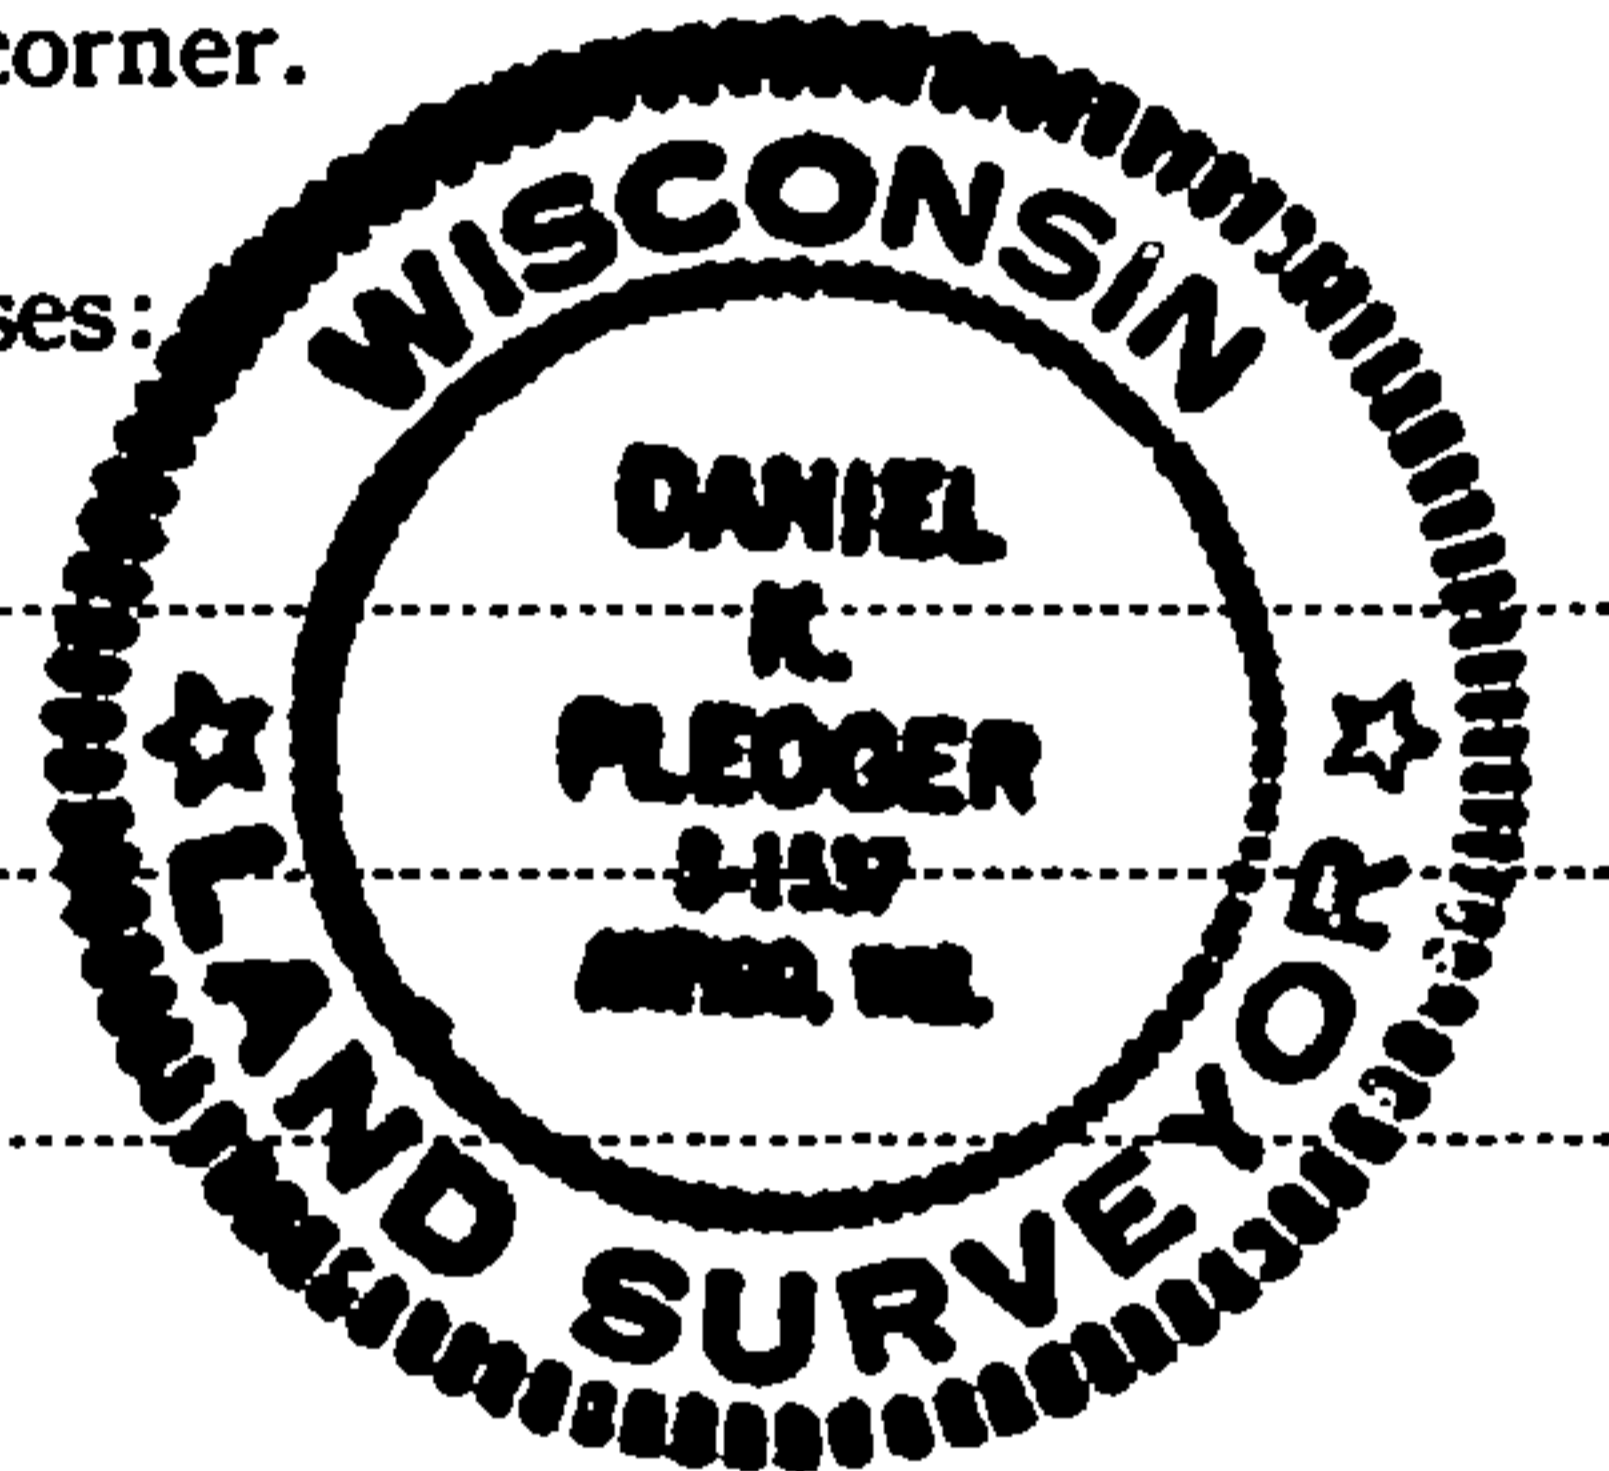

T37N R15E

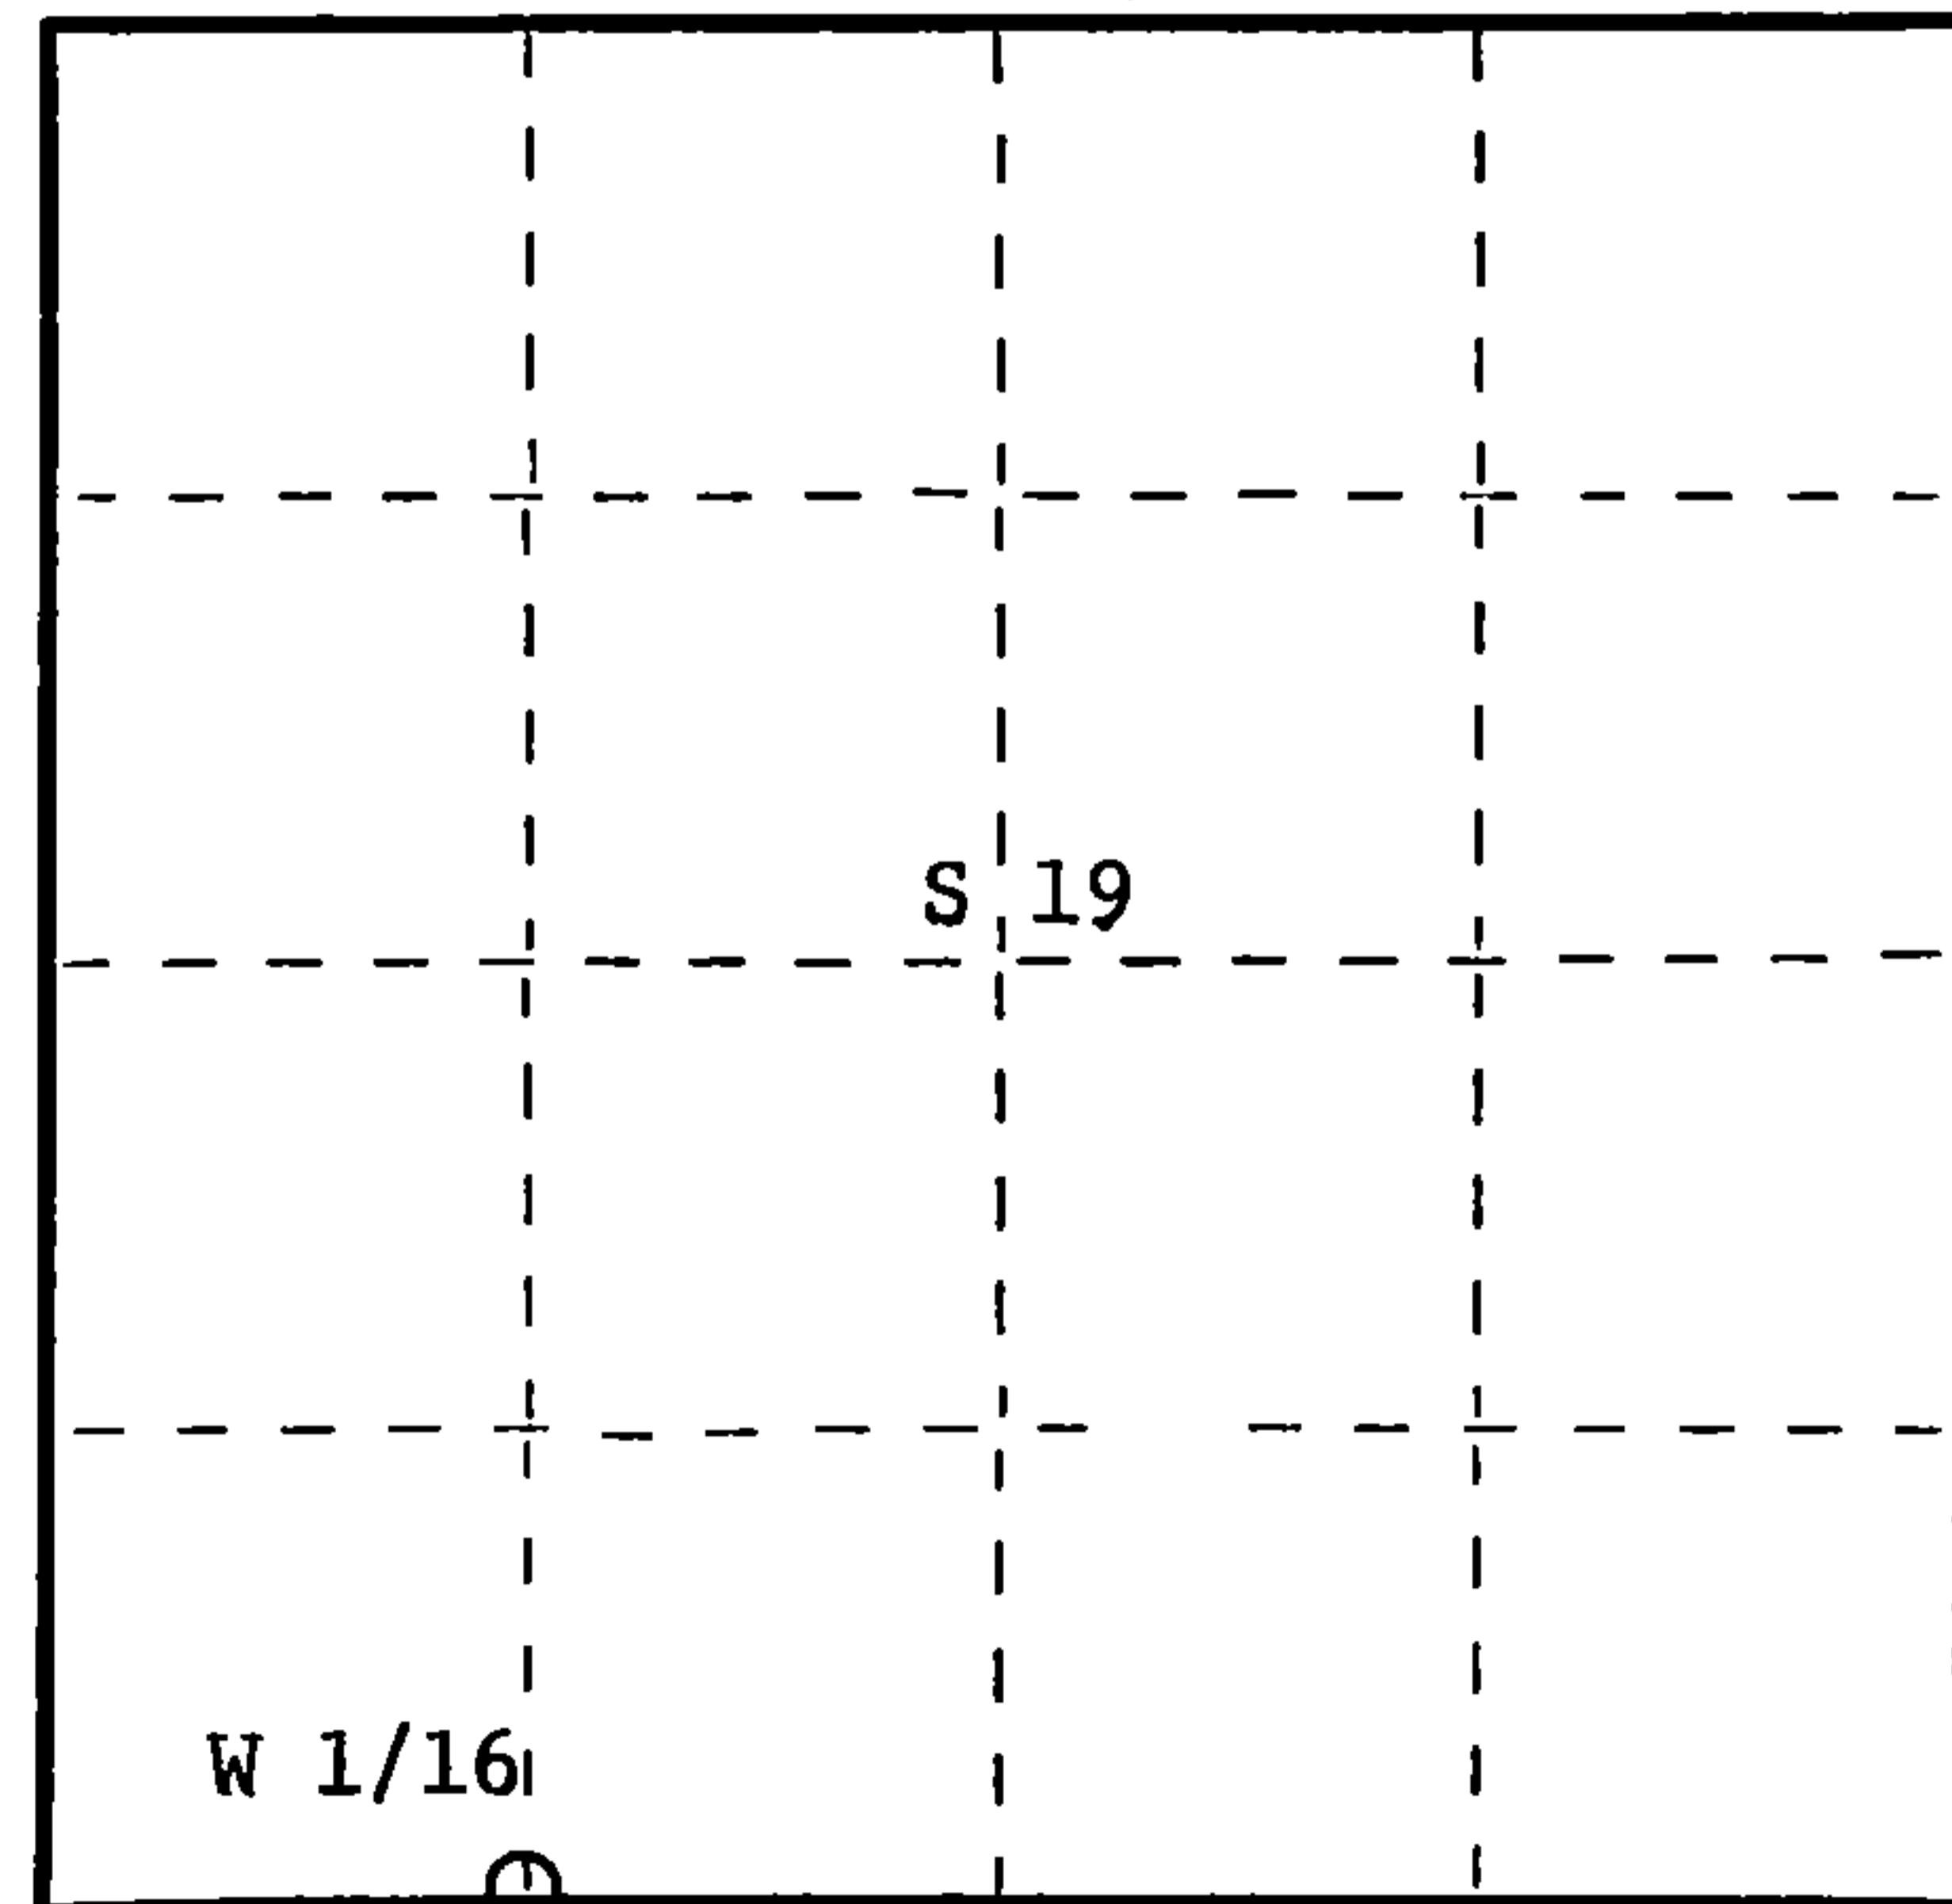

○ = Corner monument restored.

History of original corner establishment:

No evidence of any previous corner.

Description of corner evidence found:

Total distance from section corner 24-25-19-30 T37N-R14&15E to 1/4 corner between 19 and 30 is 2429.752 feet at bearing N81-20-40E.

Set W 1/16 1179.491 feet of 1/4 corner and 1250.261 feet of section corner.

Description of monument and accessories I established to perpetuate the original location of this corner.

Set a 1-1/2" iron pipe with a 2" brass cap - stamped:
Monument projects 18" above ground.

Marked NBT's:

Sugar 12" N84° W 13.87 feet
Twin Sugar 6" S8° E 29.65 feet
both scribed 1/16 B.T.

S1537
T37N R15E
W 1/16 S 19
S 30
CPI - 1981

Dated at Rhinelander, Wis., this 7th day of July, 19 81

Signature Daniel K. Pledger Title Registered Land Surveyor Registration No. 1537
(County Surveyor, Registered Land Surveyor, or other duly authorized official)

Office of Register of Deeds, County of Forest, I hereby certify that the within instrument was filed in this office for record on the 4th day of August, 19 81 at 11:00 o'clock A. M.

Eugene Stutzmy (Register of Deeds)

By Deputy

DOCUMENT NO. 120258

FORM 985 H. C. MILLER CO., MILWAUKEE

43715190030