

CERTIFIED LAND CORNER RESTORATION

Index No. P-2 P 2


State of Wisconsin } ss.
County of Forest

I Daniel K. Pledger, do hereby certify that on the 6th day of May, 1981, I found established corner for the WC 1/16 corner of Section 19 Township 37 North, Range 15 East, Fourth Principal Meridian, as described hereon; and that from this evidence I established a new monument and accessories as described hereon to perpetuate the original location of this corner.

Resident witnesses:



FORM 985 R. C. MILLER CO., MILWAUKEE

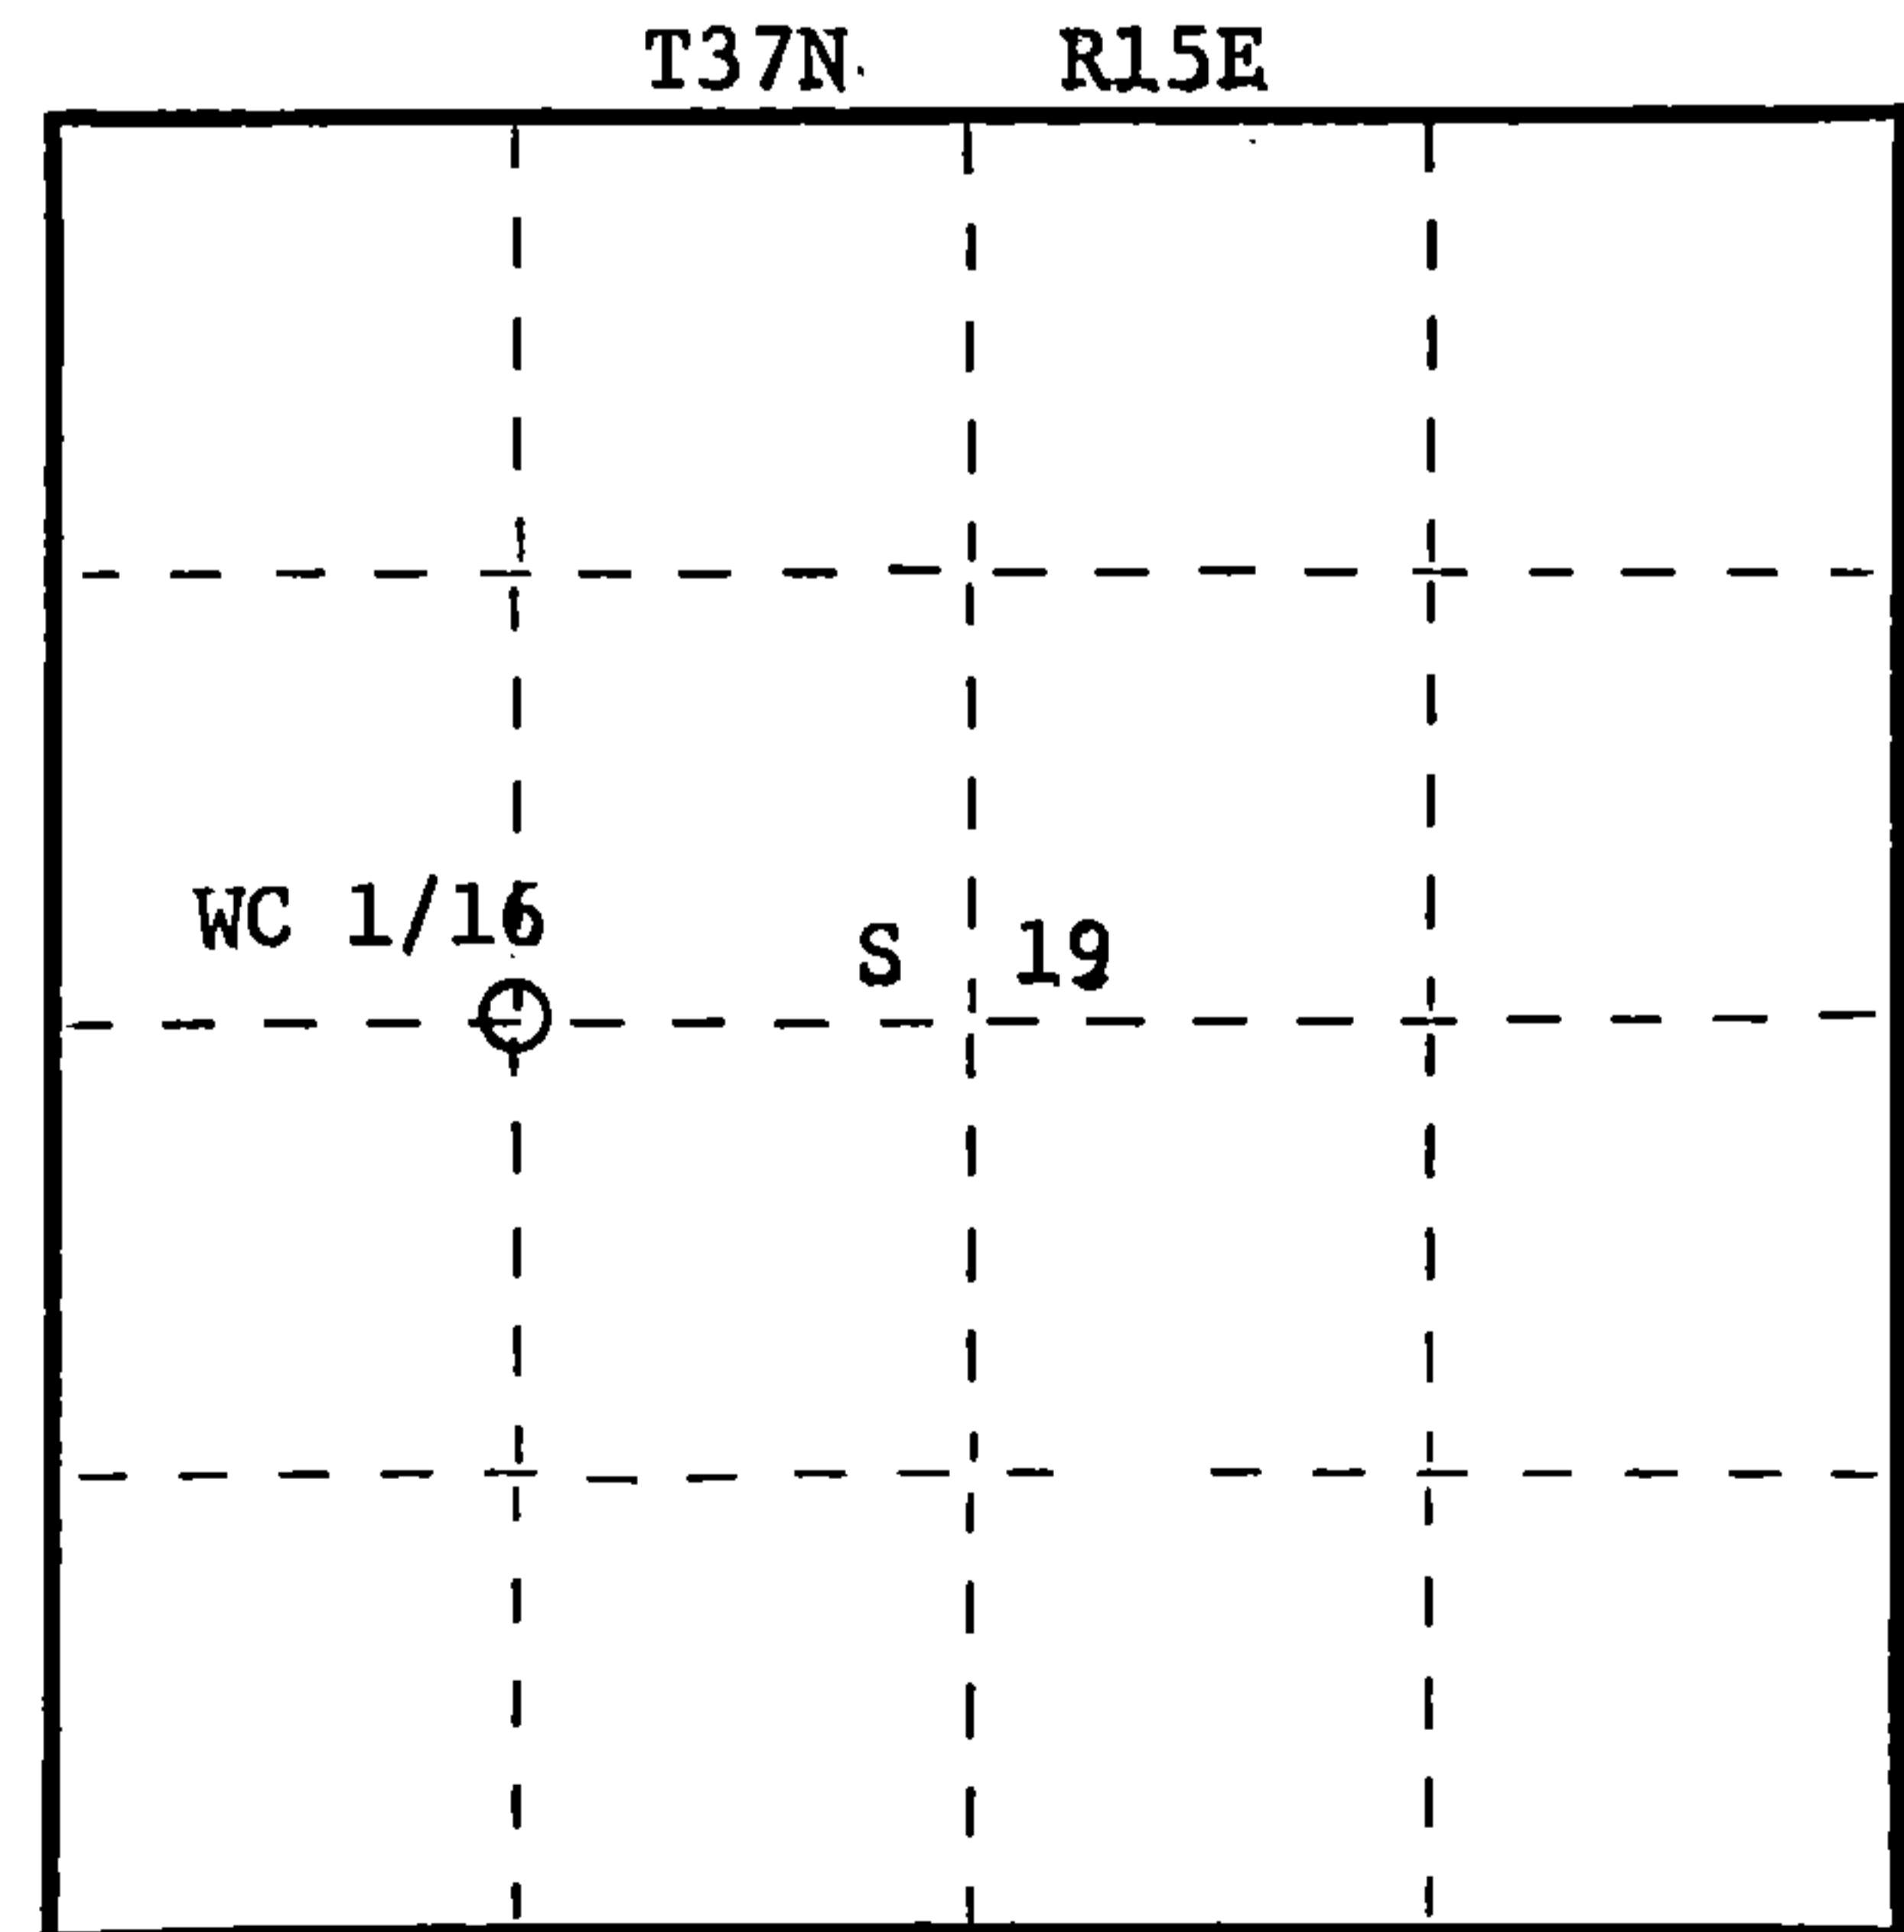

○ = Corner monument restored.

History of original corner establishment:

No evidence of any previous corner.

Description of corner evidence found:

Total distance from 1/4 corner between sections 19 and 24 T37N-R14&15E to C 1/4 corner section 19 is 2541.97 feet at bearing N87-17-16E.
Set WC 1/16 1312.941 feet of 1/4 corner and 1229.029 feet of C 1/4 corner.

Description of monument and accessories I established to perpetuate the original location of this corner.

Set a 1-1/2" iron pipe with 2" diameter brass cap - stamped:
Monument projects 18" above ground.

Marked NBT's:

White Spruce 10" S50°W 44.86 feet
Maple 5" S4°W 40.25 feet
both scribed 1/16 - B.T.

S1537
T37N R15E
WC 1/16 S 19
CPI-1981

Dated at Rhinelander, Wis., this 7th day of July, 1981

Signature Daniel K. Pledger Title Registered Land Surveyor Registration No. 1537
(County Surveyor, Registered Land Surveyor, or other duly authorized official)

Office of Register of Deeds, County of Forest, I hereby certify that the within instrument was filed in this office for record on the 4th day of August, 1981 at 11:00 o'clock A.M.

Eugene Staszynski
(Register of Deeds)
By Deputy

DOCUMENT NO.
120256

43715192030