


U. S. PUBLIC LAND SURVEY MONUMENT RECORD

INSTRUCTIONS: This record shall show the location of the corner and shall include all of the following nine elements (a through i).

(a) Identify the corner by reference to the U.S. public land survey system.

○ = Corner monument restored.

Quarter Corner to Sections 20 and 29, T37N, R15E

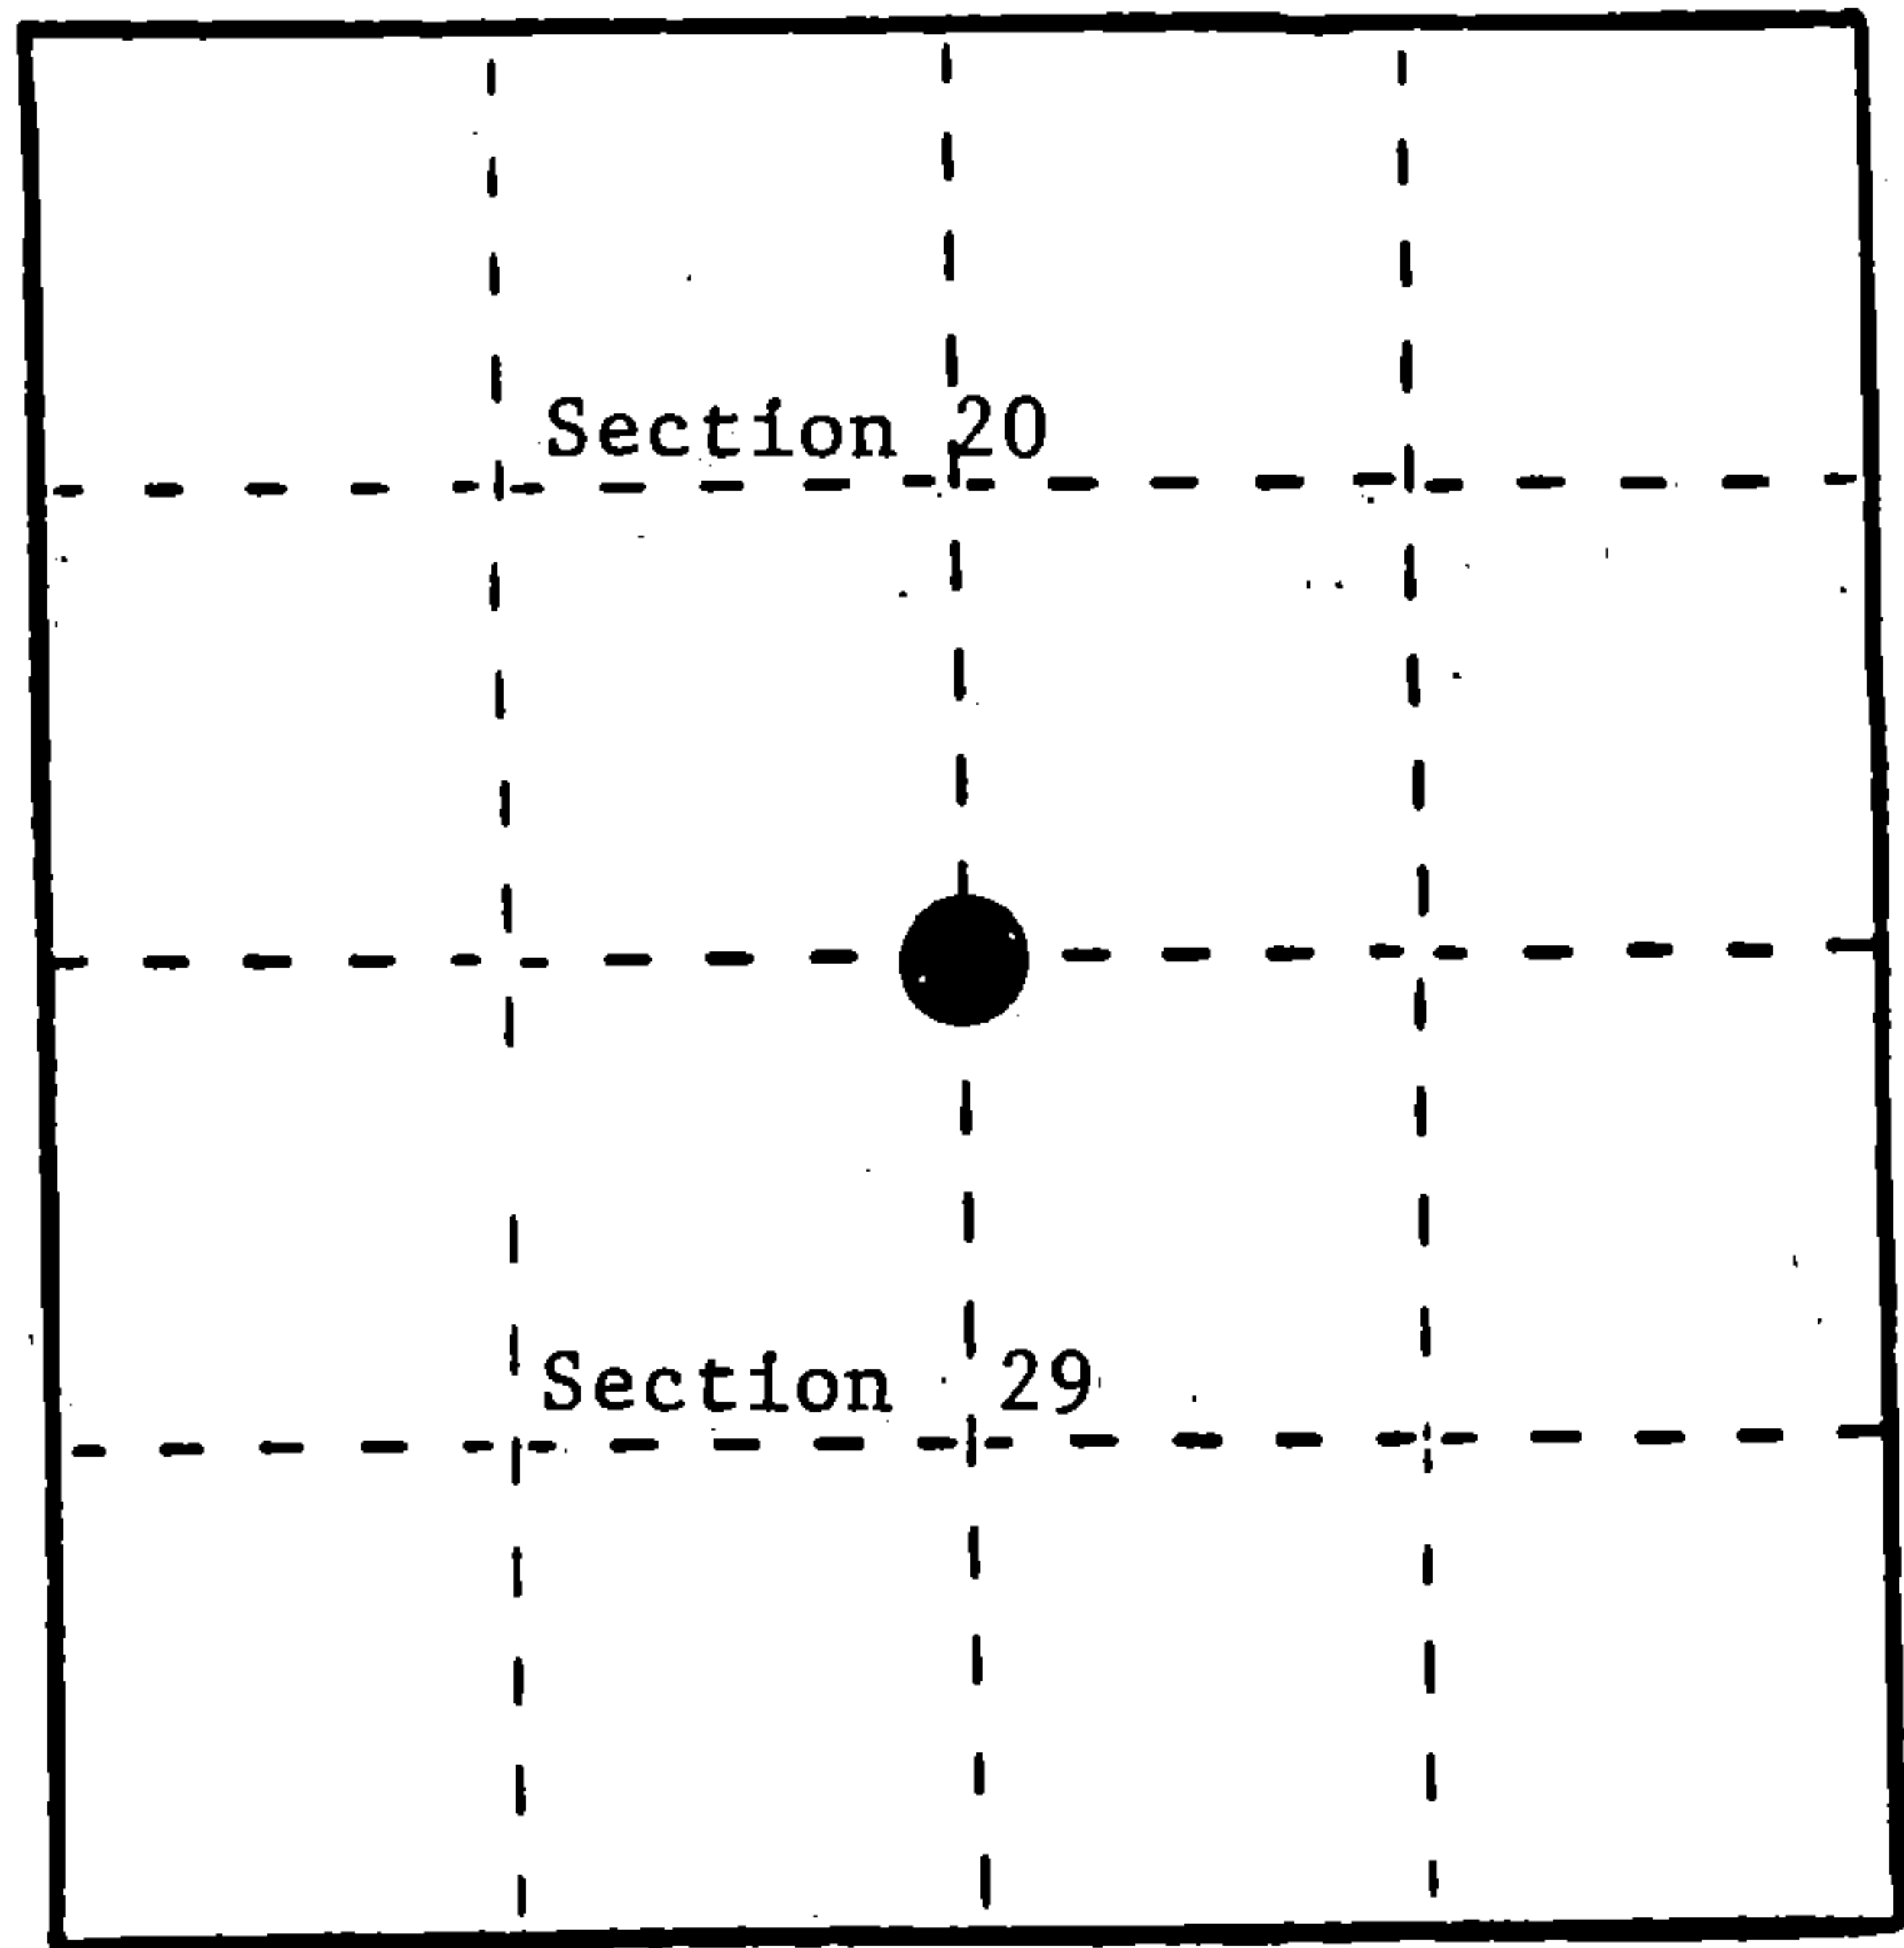

REGISTER'S OFFICE
Forest County, Wis.
Received for record this 30th day
of June A. D., 1988 at
2:40 o'clock P. M. and
recorded in Vol. CORNER RESTORATIONS
on page R-7
Paul Aschenbrenner
REGISTER

(b) Describe any record evidence, monument evidence, occupational evidence, testimonial evidence or any other material evidence you considered, and whether the monument was found or placed.

1865, James Nowlin set 1/4 section post with following BTs:

12" Hemlock, S65°W 20 links

12" Birch, N82°E 23 links


1976, Jean Resvick restored corner from State Highway notes and set PK nail in blacktop with two brass cap reference monuments.

6/29/1988 Milo E. Stefan found reference monuments in excellent condition and PK nail in blacktop. I replaced PK nail with a railroad spike and made two new BTs and painted and posted to Forest Service standards.

(c) In the plan view drawing below, provide reference ties to at least 4 witness monuments, or, if the location is within a municipality, to at least 2 witness monuments. (Witness monuments shall be made of concrete, natural stone, iron or other equally durable material.) Describe witness monuments.

(d) Show a plan view drawing depicting the relevant monuments and reference ties which is sufficient in detail to enable accurate relocation of the corner monument if the corner monument is disturbed. Indicate north.

1. Railroad spike
2. Reference monument, brass cap.
N42°-26'W, 70.0 feet.
Ties:
2a. 10" Aspen S37°W 11.1 feet
2b. 13" Red Pine N43°W 7.2 feet
2c. Steel sign post West .5 feet
3. Reference monument, brass cap.
S38°-01'W, 80.0 feet.
Ties:
3a. 10" Oak, S50°W, 22.1 feet
3b. 8" Oak, N77°W, 33.0 feet
3c. Steel sign post, West .5 feet
4. 16" Red Pine, N28°E, 91.40 feet
5. 12" Red Pine, S81°E, 72.54 feet

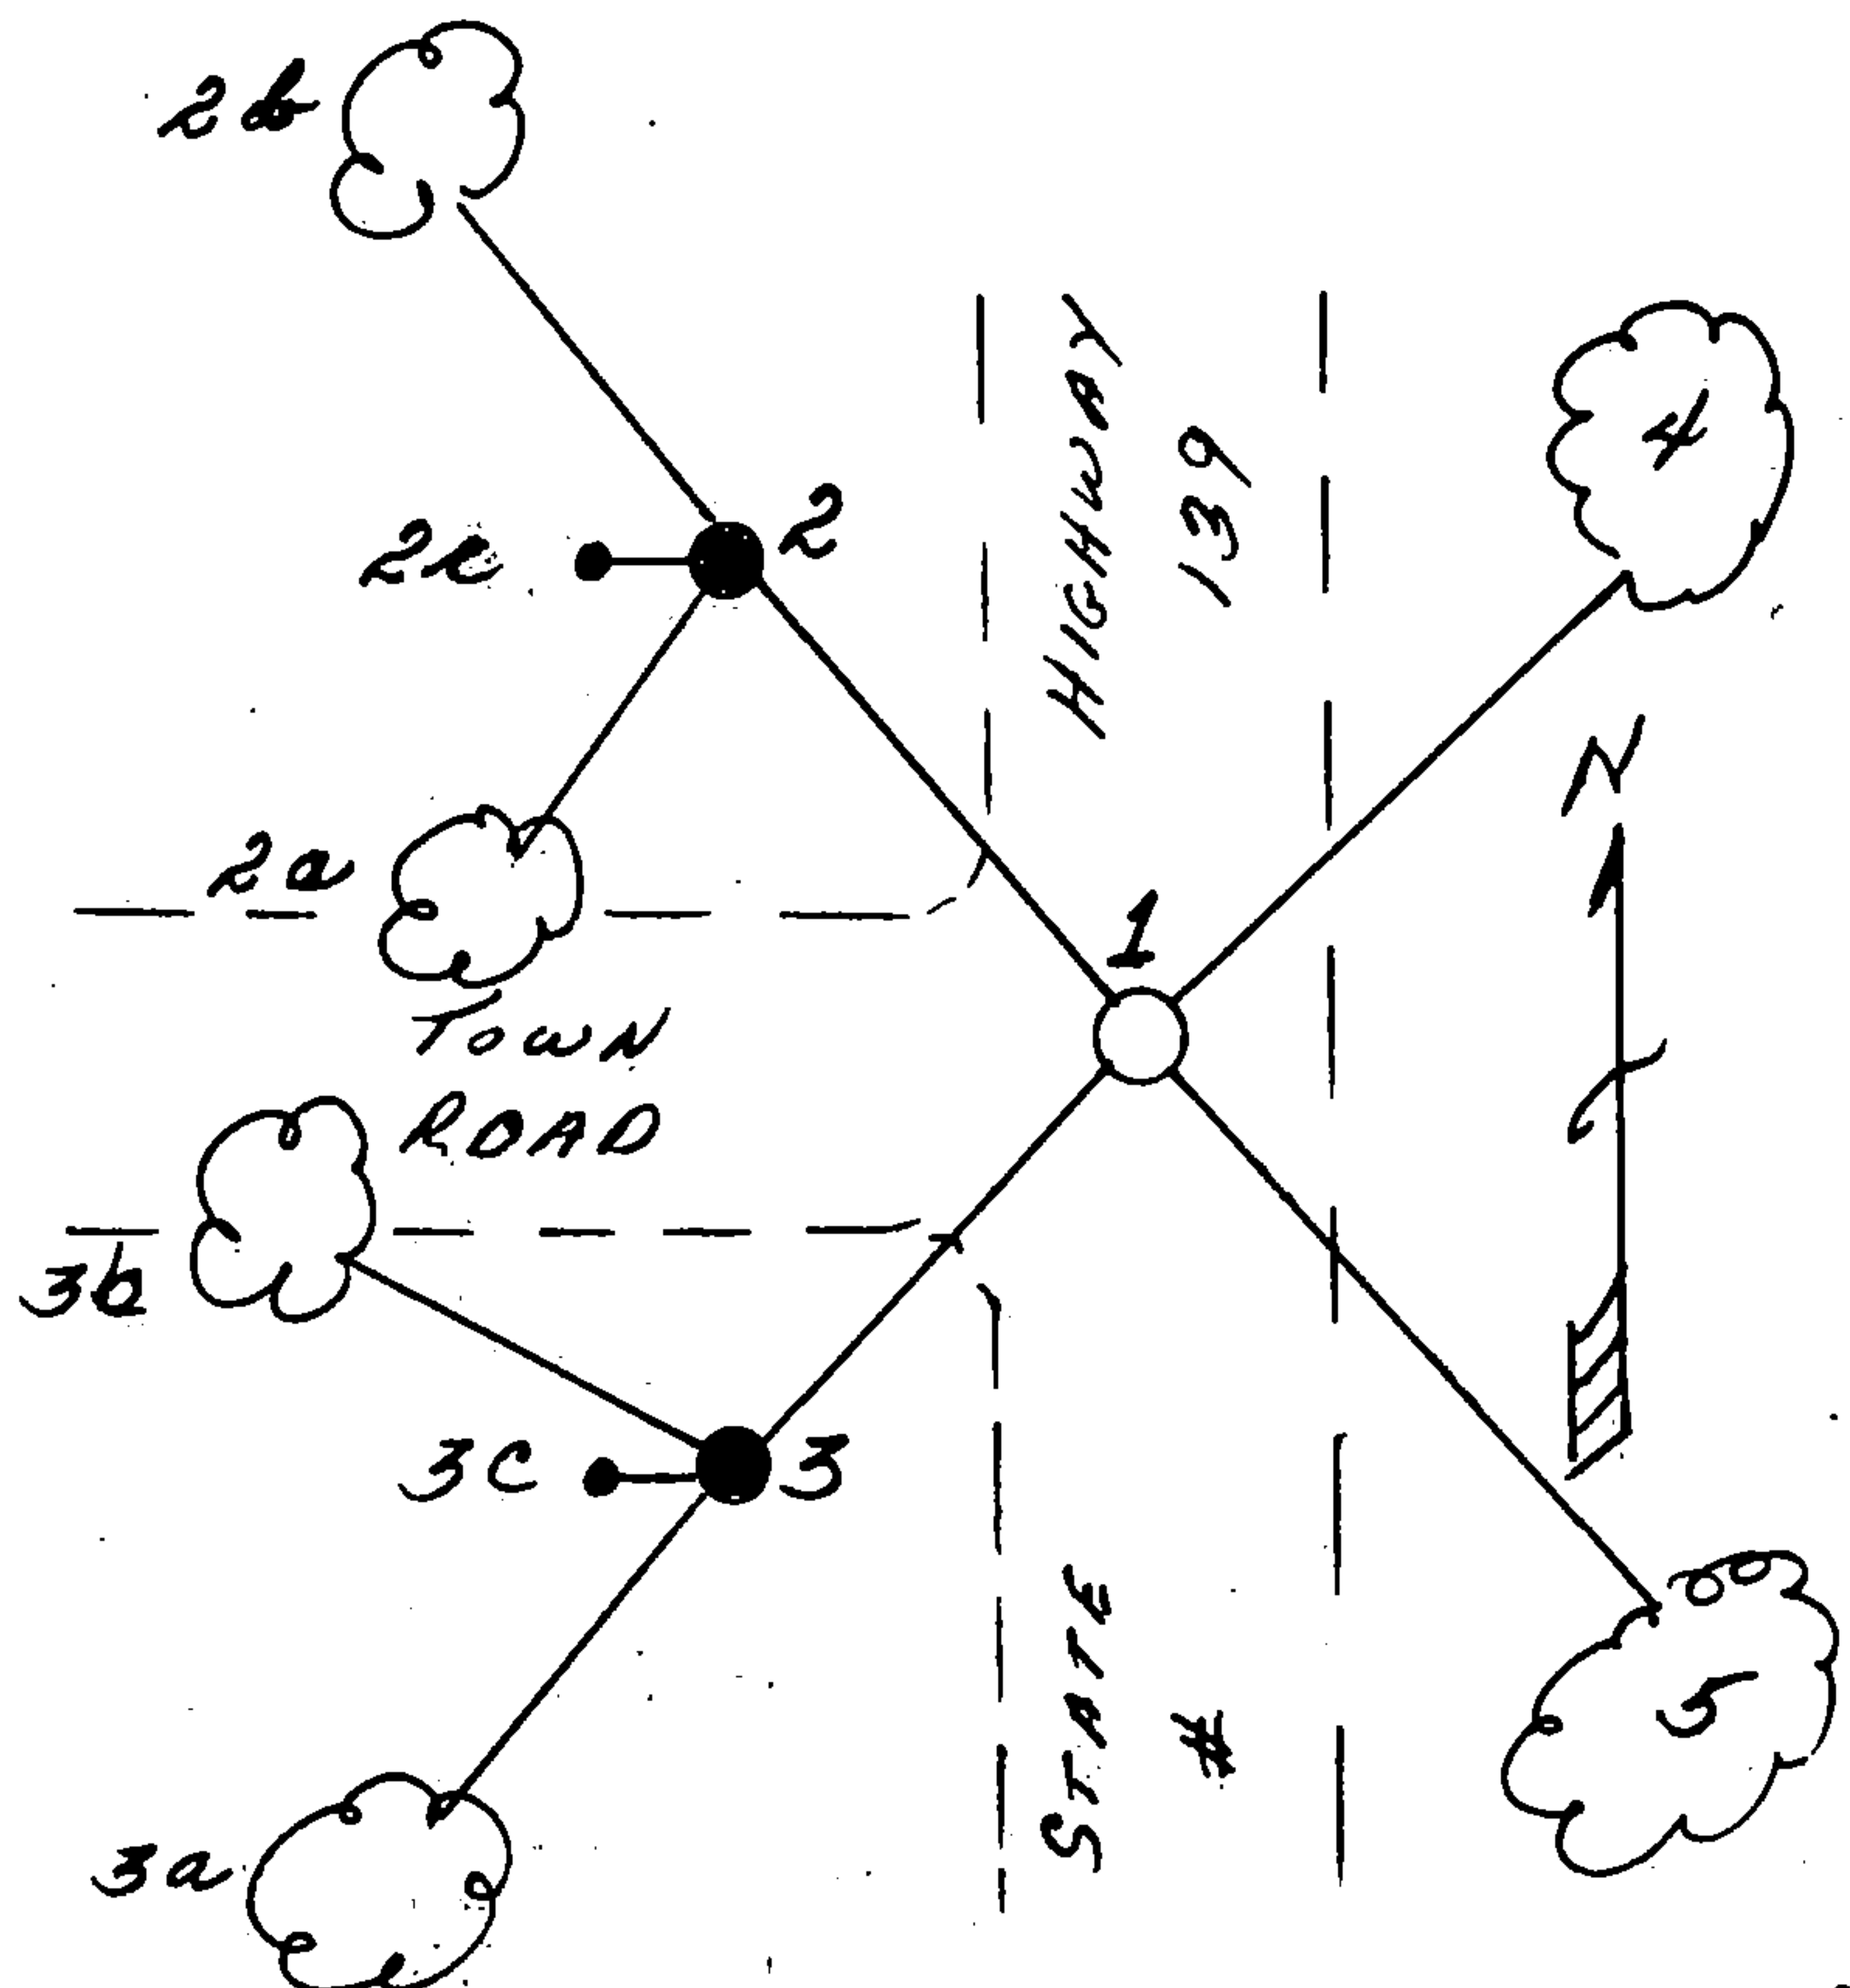

(e) Describe any material discrepancy between the location of the corner as restored or reestablished and the location of that corner as previously restored or reestablished by distance and direction. Show the discrepancy on the plan view drawing under (d), above. Show the distances between the corner as previously restored or reestablished and (1) the corner as restored or reestablished, and (2) to at least 2 of the witness monuments shown on the drawing in (d), above.

(f) Was the corner restored through acceptance of (1) an obliterated evidence location, or, (2) a found perpetuated location?

2) A found perpetuated location.

(g&h) Was the corner reestablished through lost corner proportionate methods? If so, show the method, including the directions and distances to other public land survey corners used as evidence or used for proportioning in determining the corner location?

No.

(i) I, Milo E. Stefan
(type or print name) certify that the corner location shown on this record was determined by me or under my direction and control and that this U.S. Public Land Survey Monument Record is correct and complete to the best of my knowledge and belief.

Milo E. Stefan
Signature

6/30/88
Date



Certificate ready for filing: _____

District Ranger